



260+00

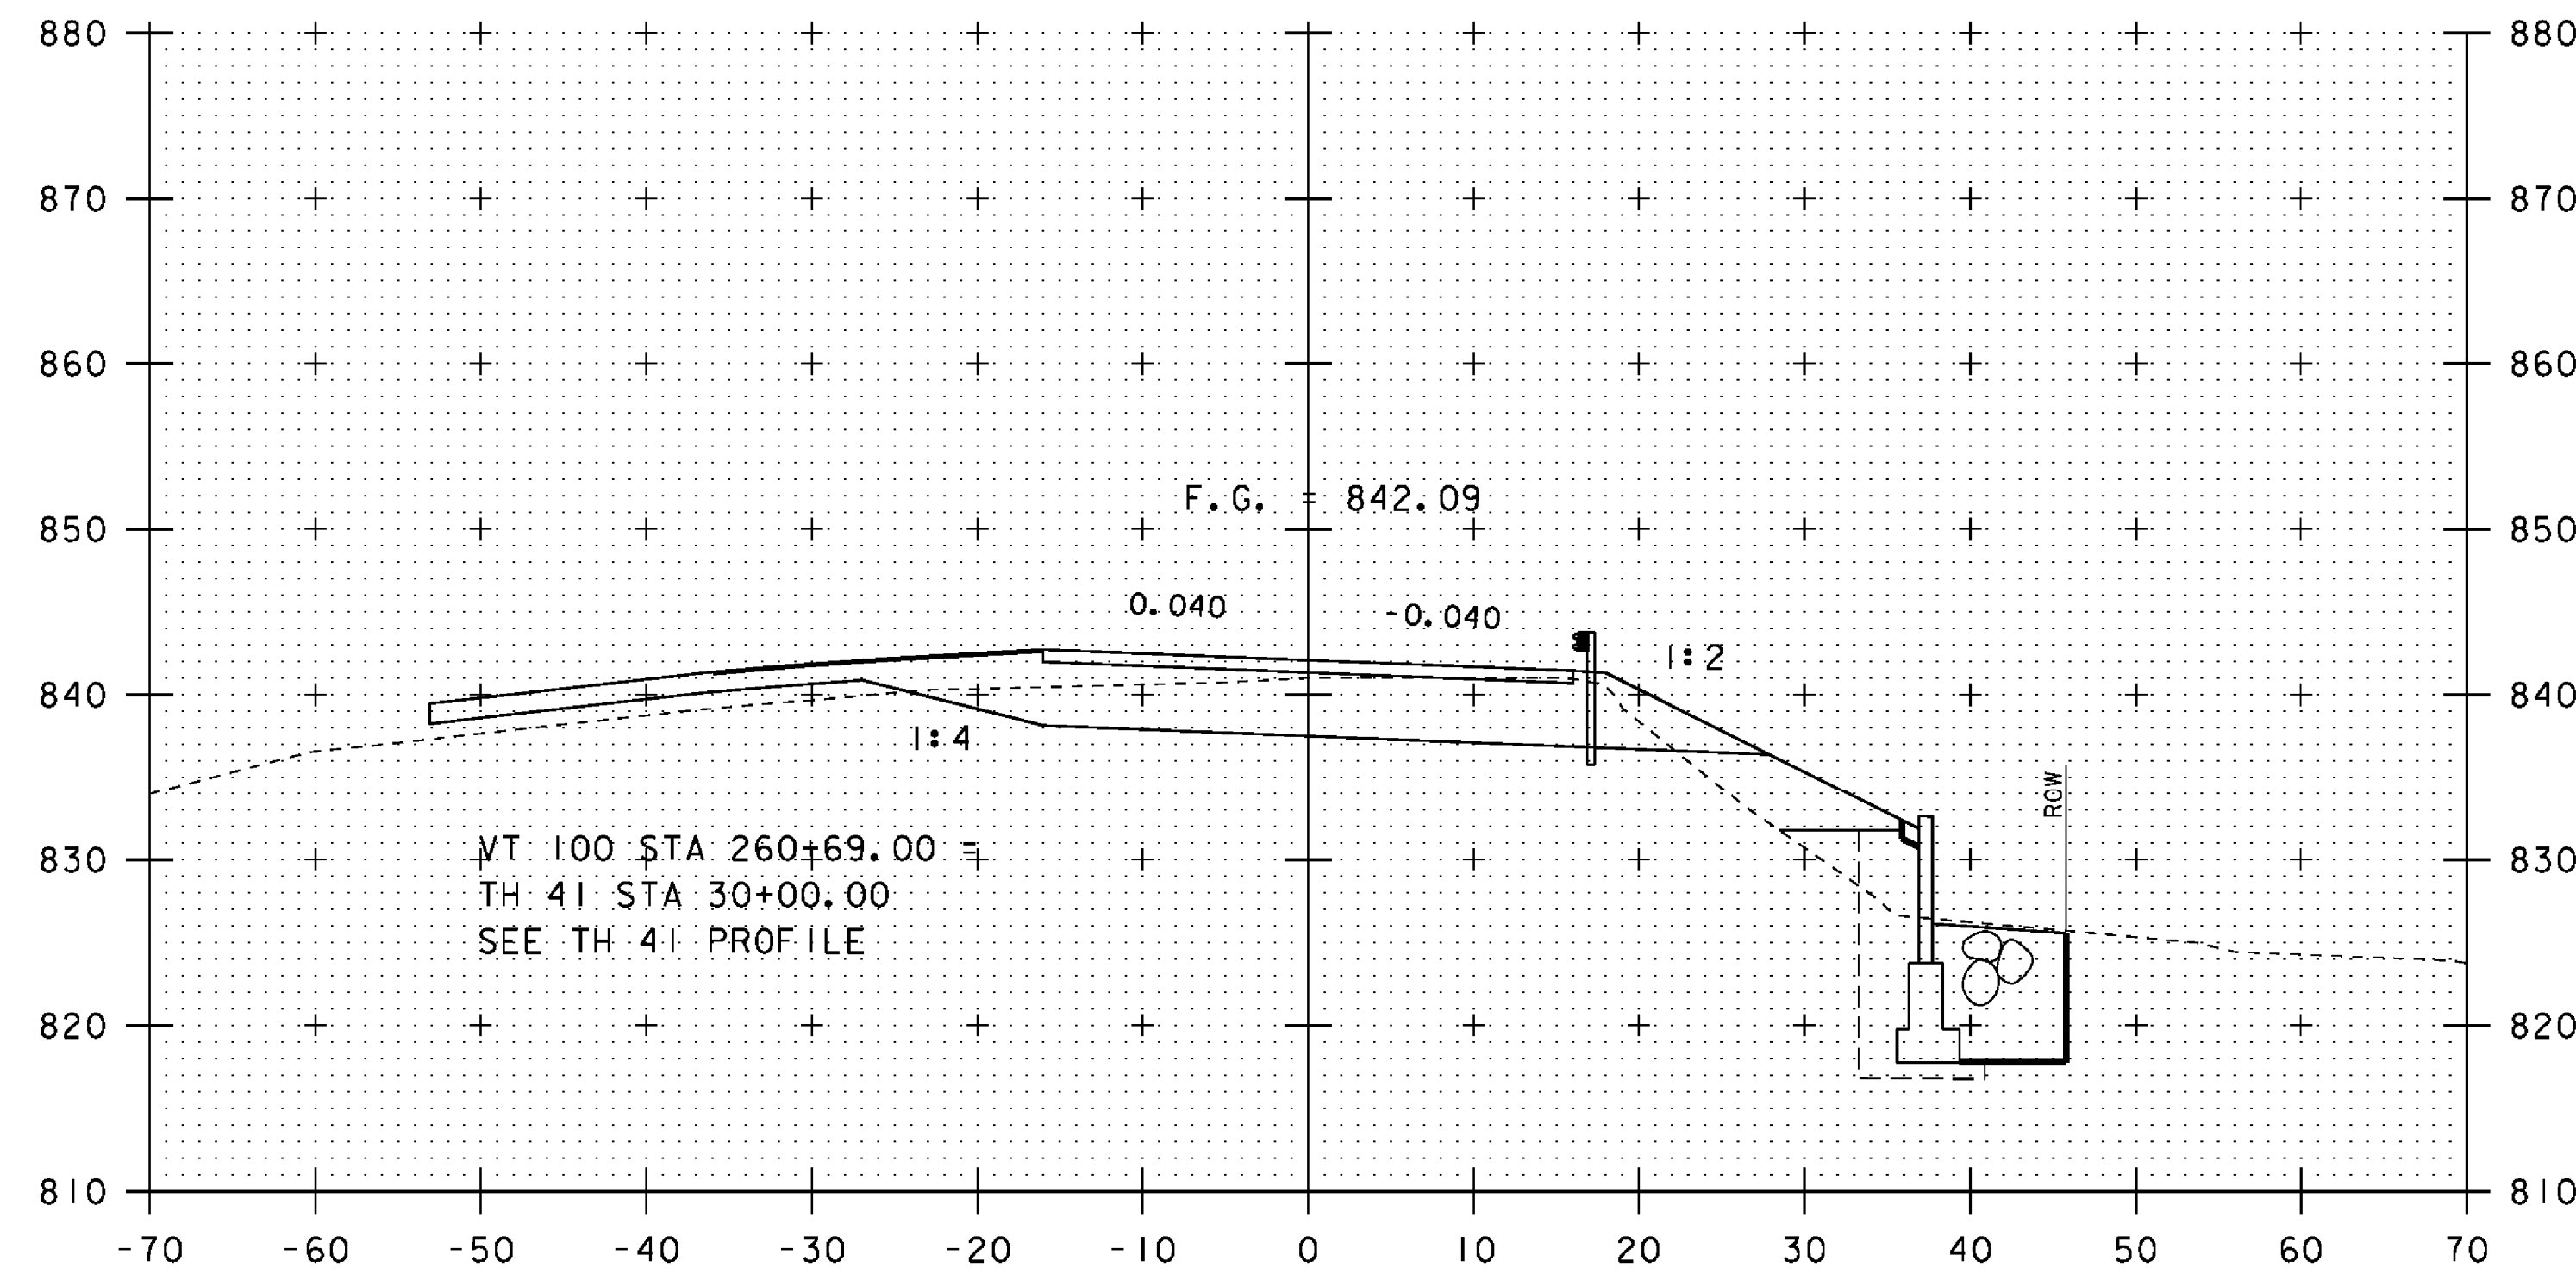


260+50

END BRIDGE
STA 260+35.05

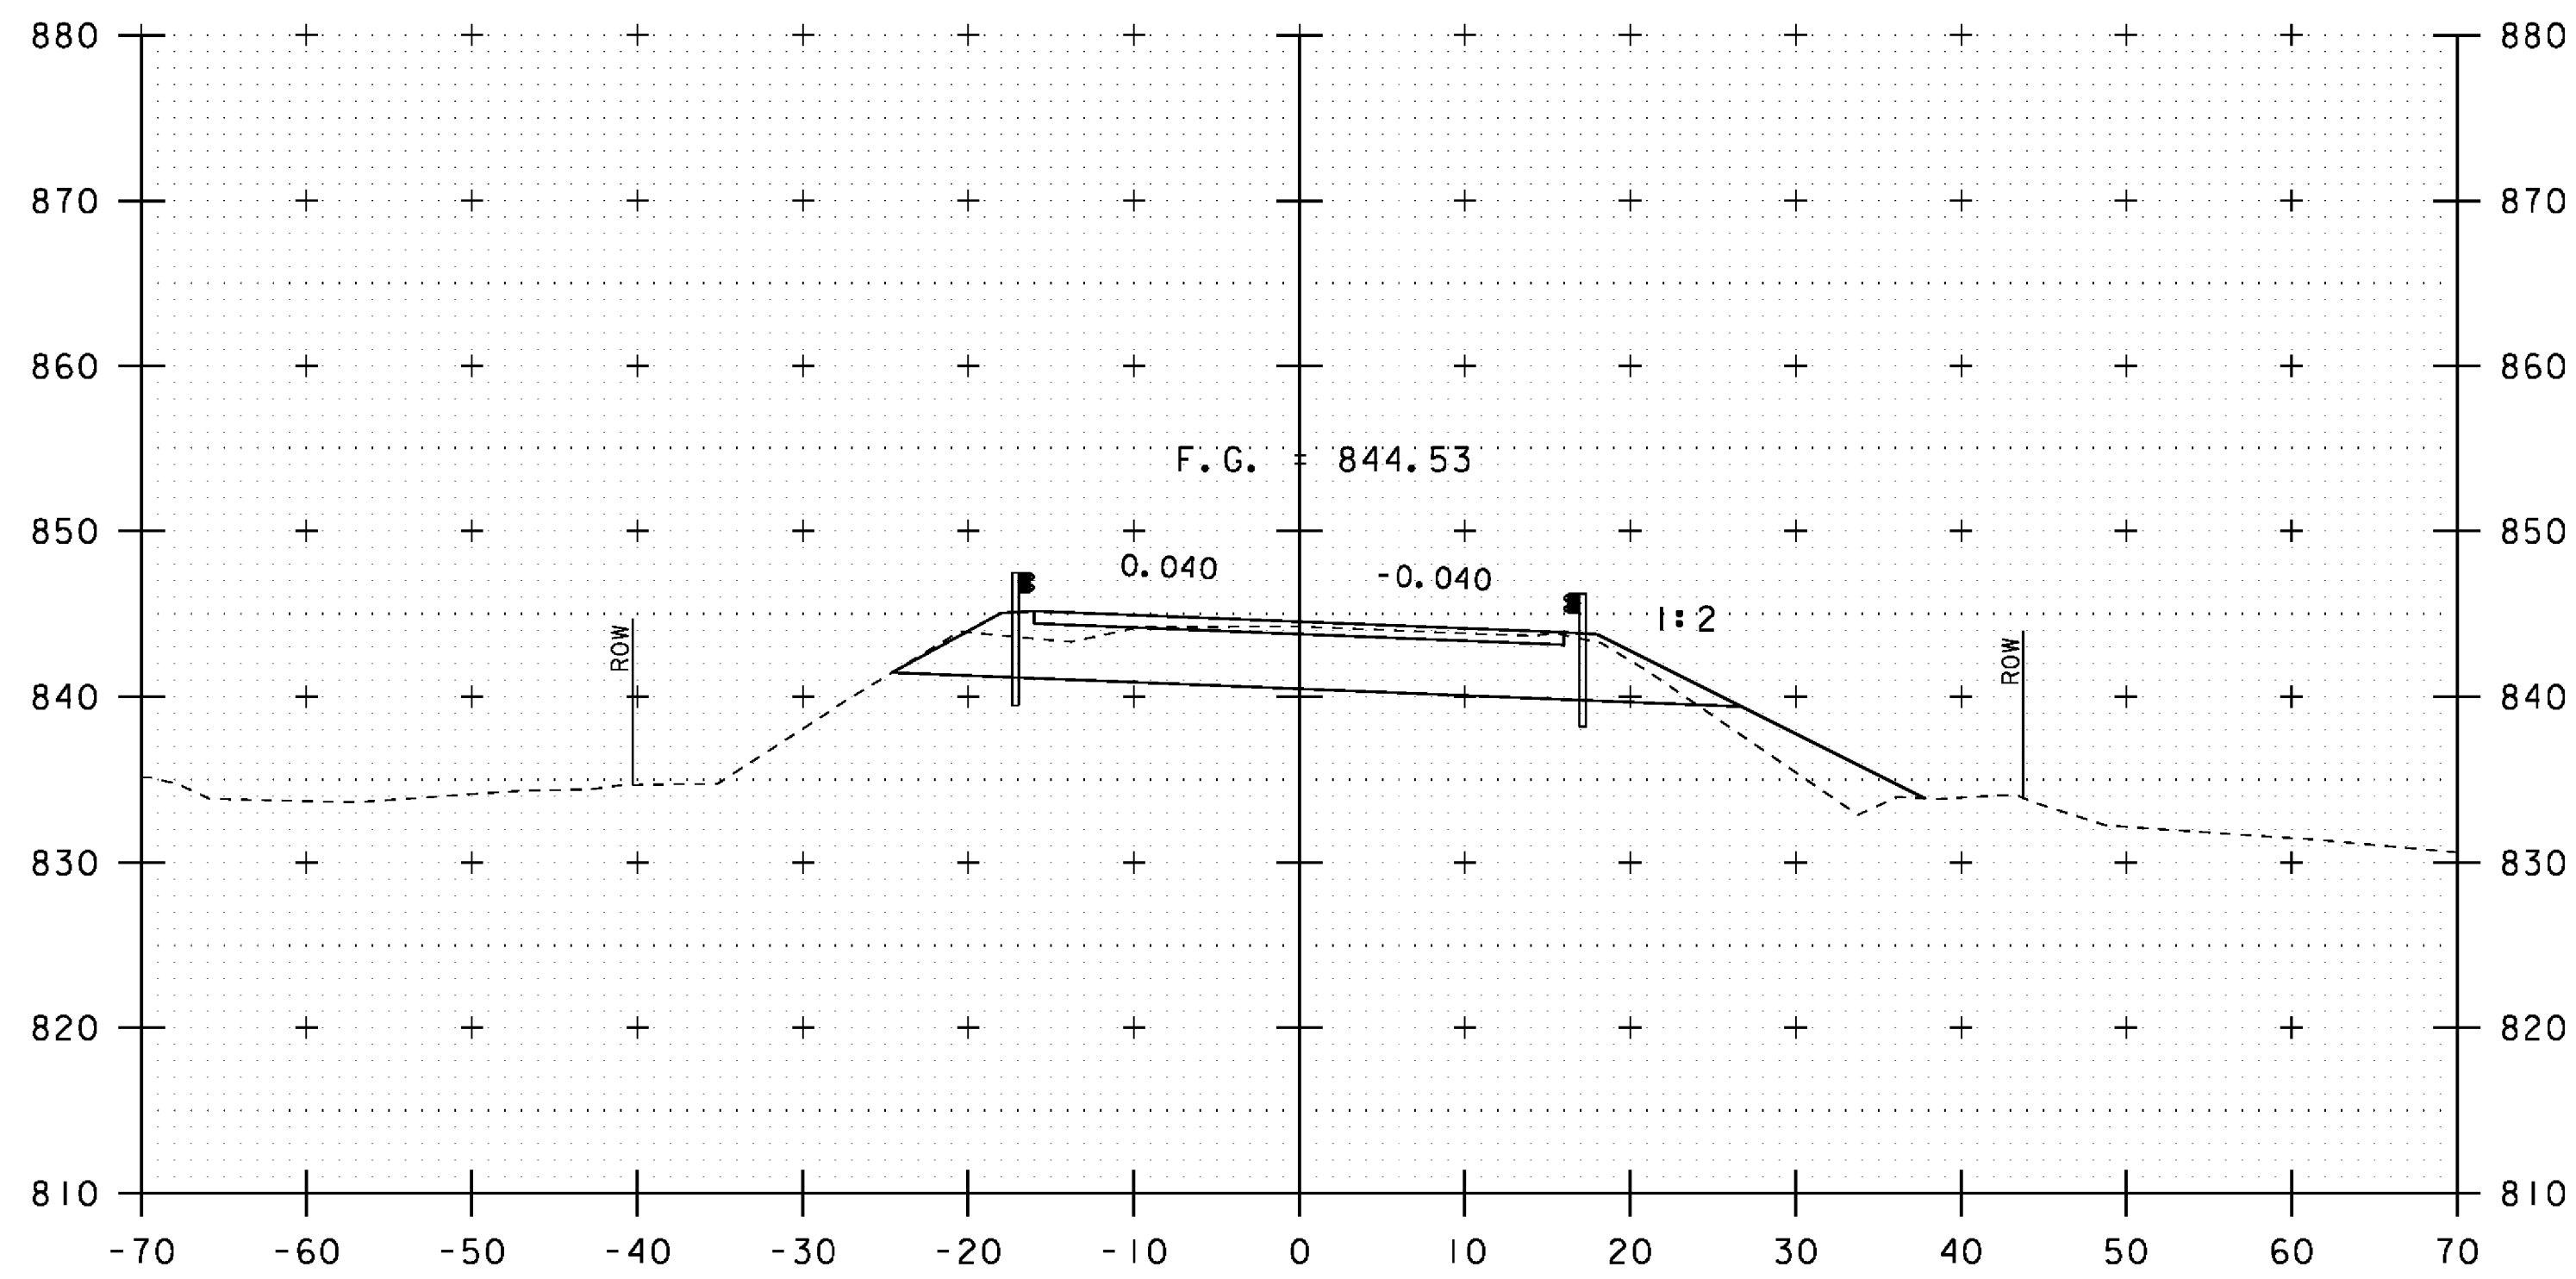


259+75

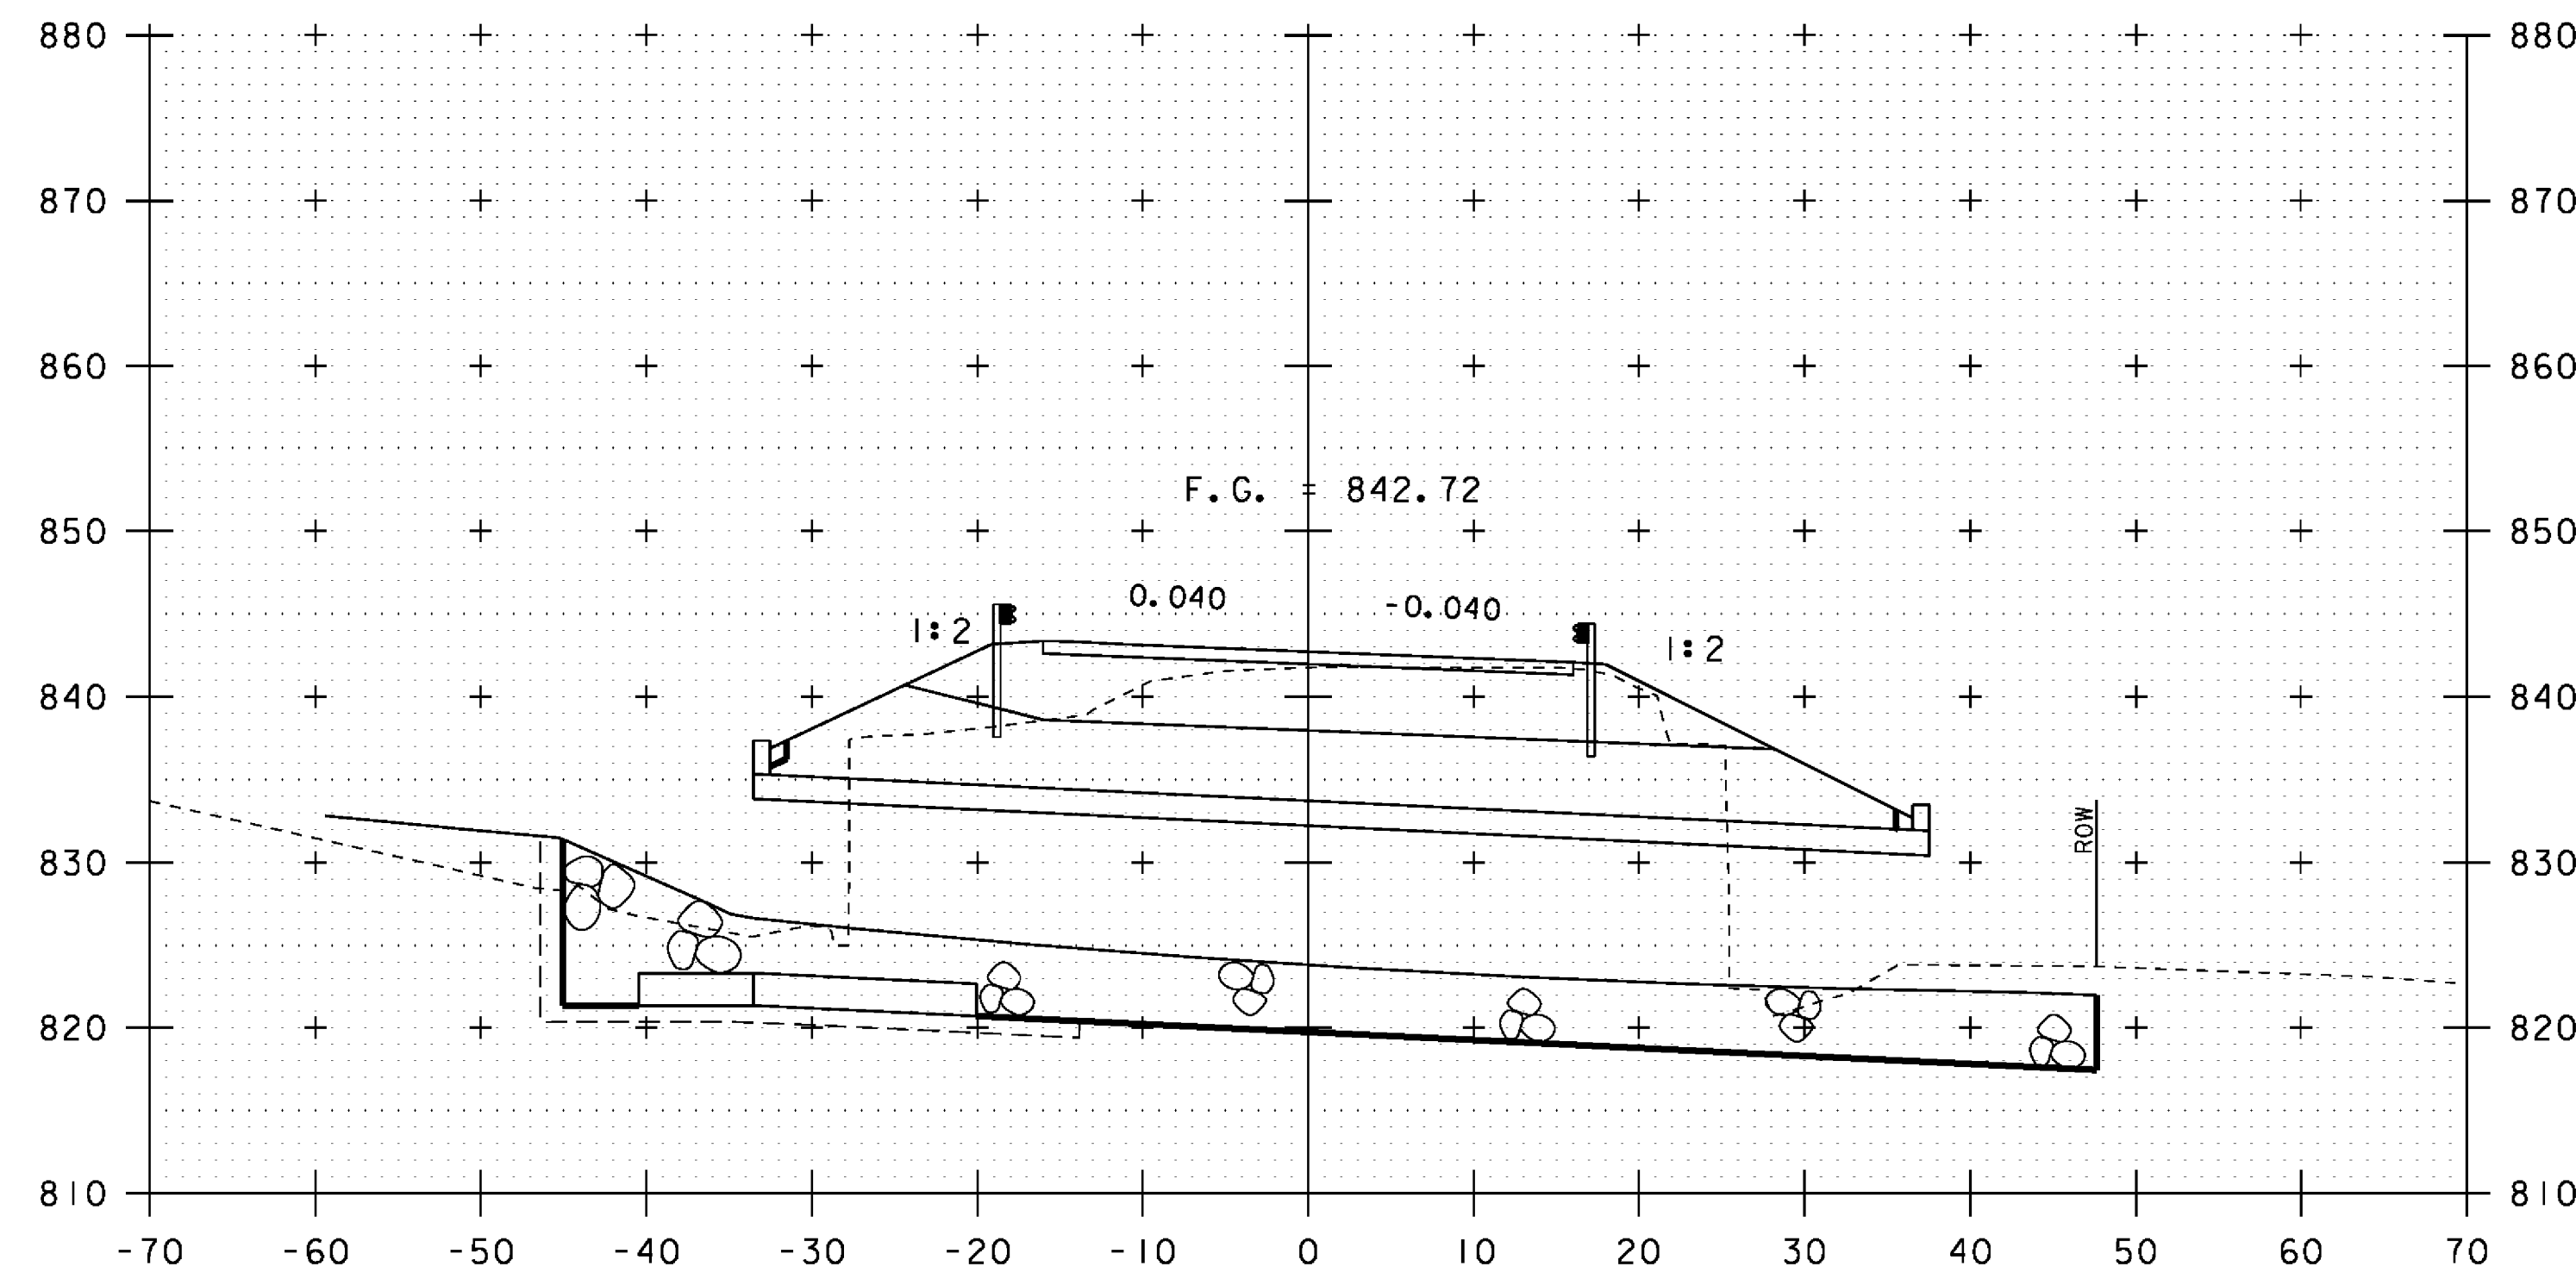

260+25

BEGIN BRIDGE
STA 260+08.63

NOTE: REVISED SHEET
FOR POST IRENE

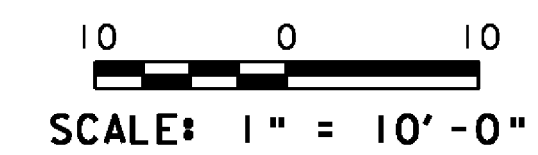

STA. 259+75 TO STA. 260+50

PROJECT NAME: PITTSFIELD-STOCKBRIDGE
PROJECT NUMBER: STP 022-1(22)S

FILE NAME: s00b122xsl.dgn
PROJECT LEADER: C. P. WILLIAMS
DESIGNED BY: G. ROY
VT 100 CROSS SECTIONS (3)

PLOT DATE: 26-OCT-2011
DRAWN BY: G. ROY
CHECKED BY: R. YOUNG
SHEET 36 OF 41