



260+00

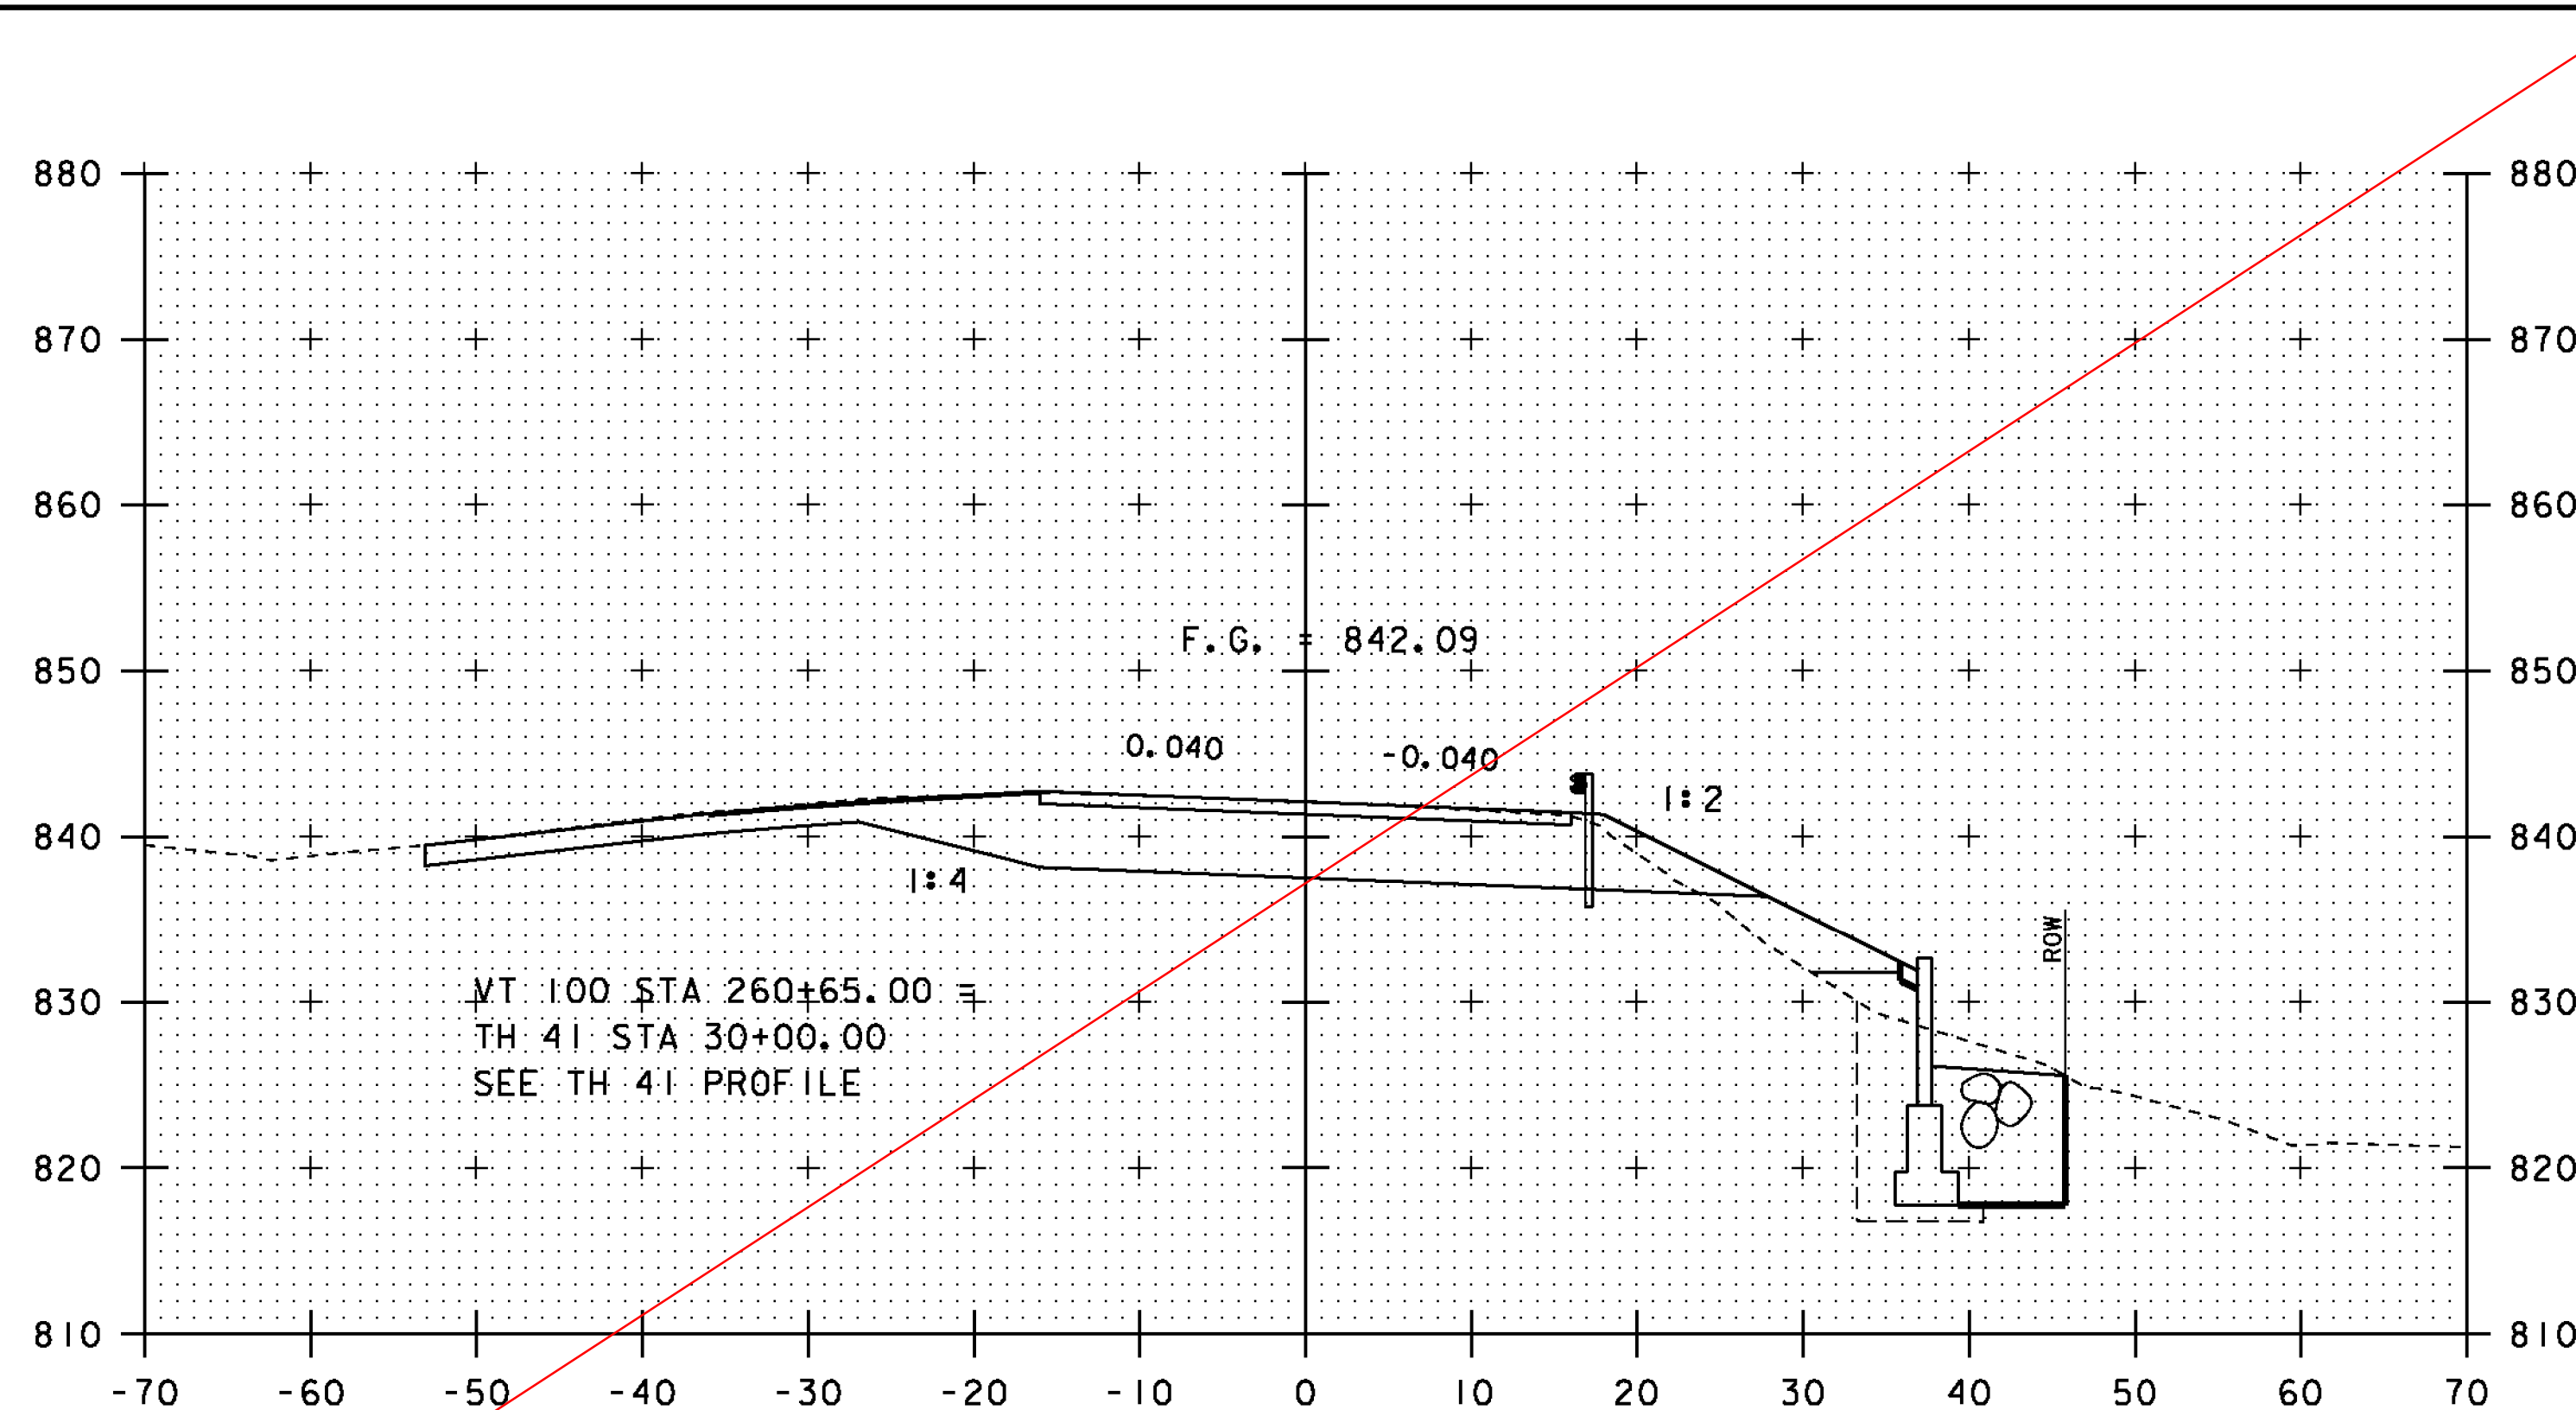


260+50

END BRIDGE
STA 260+35.05

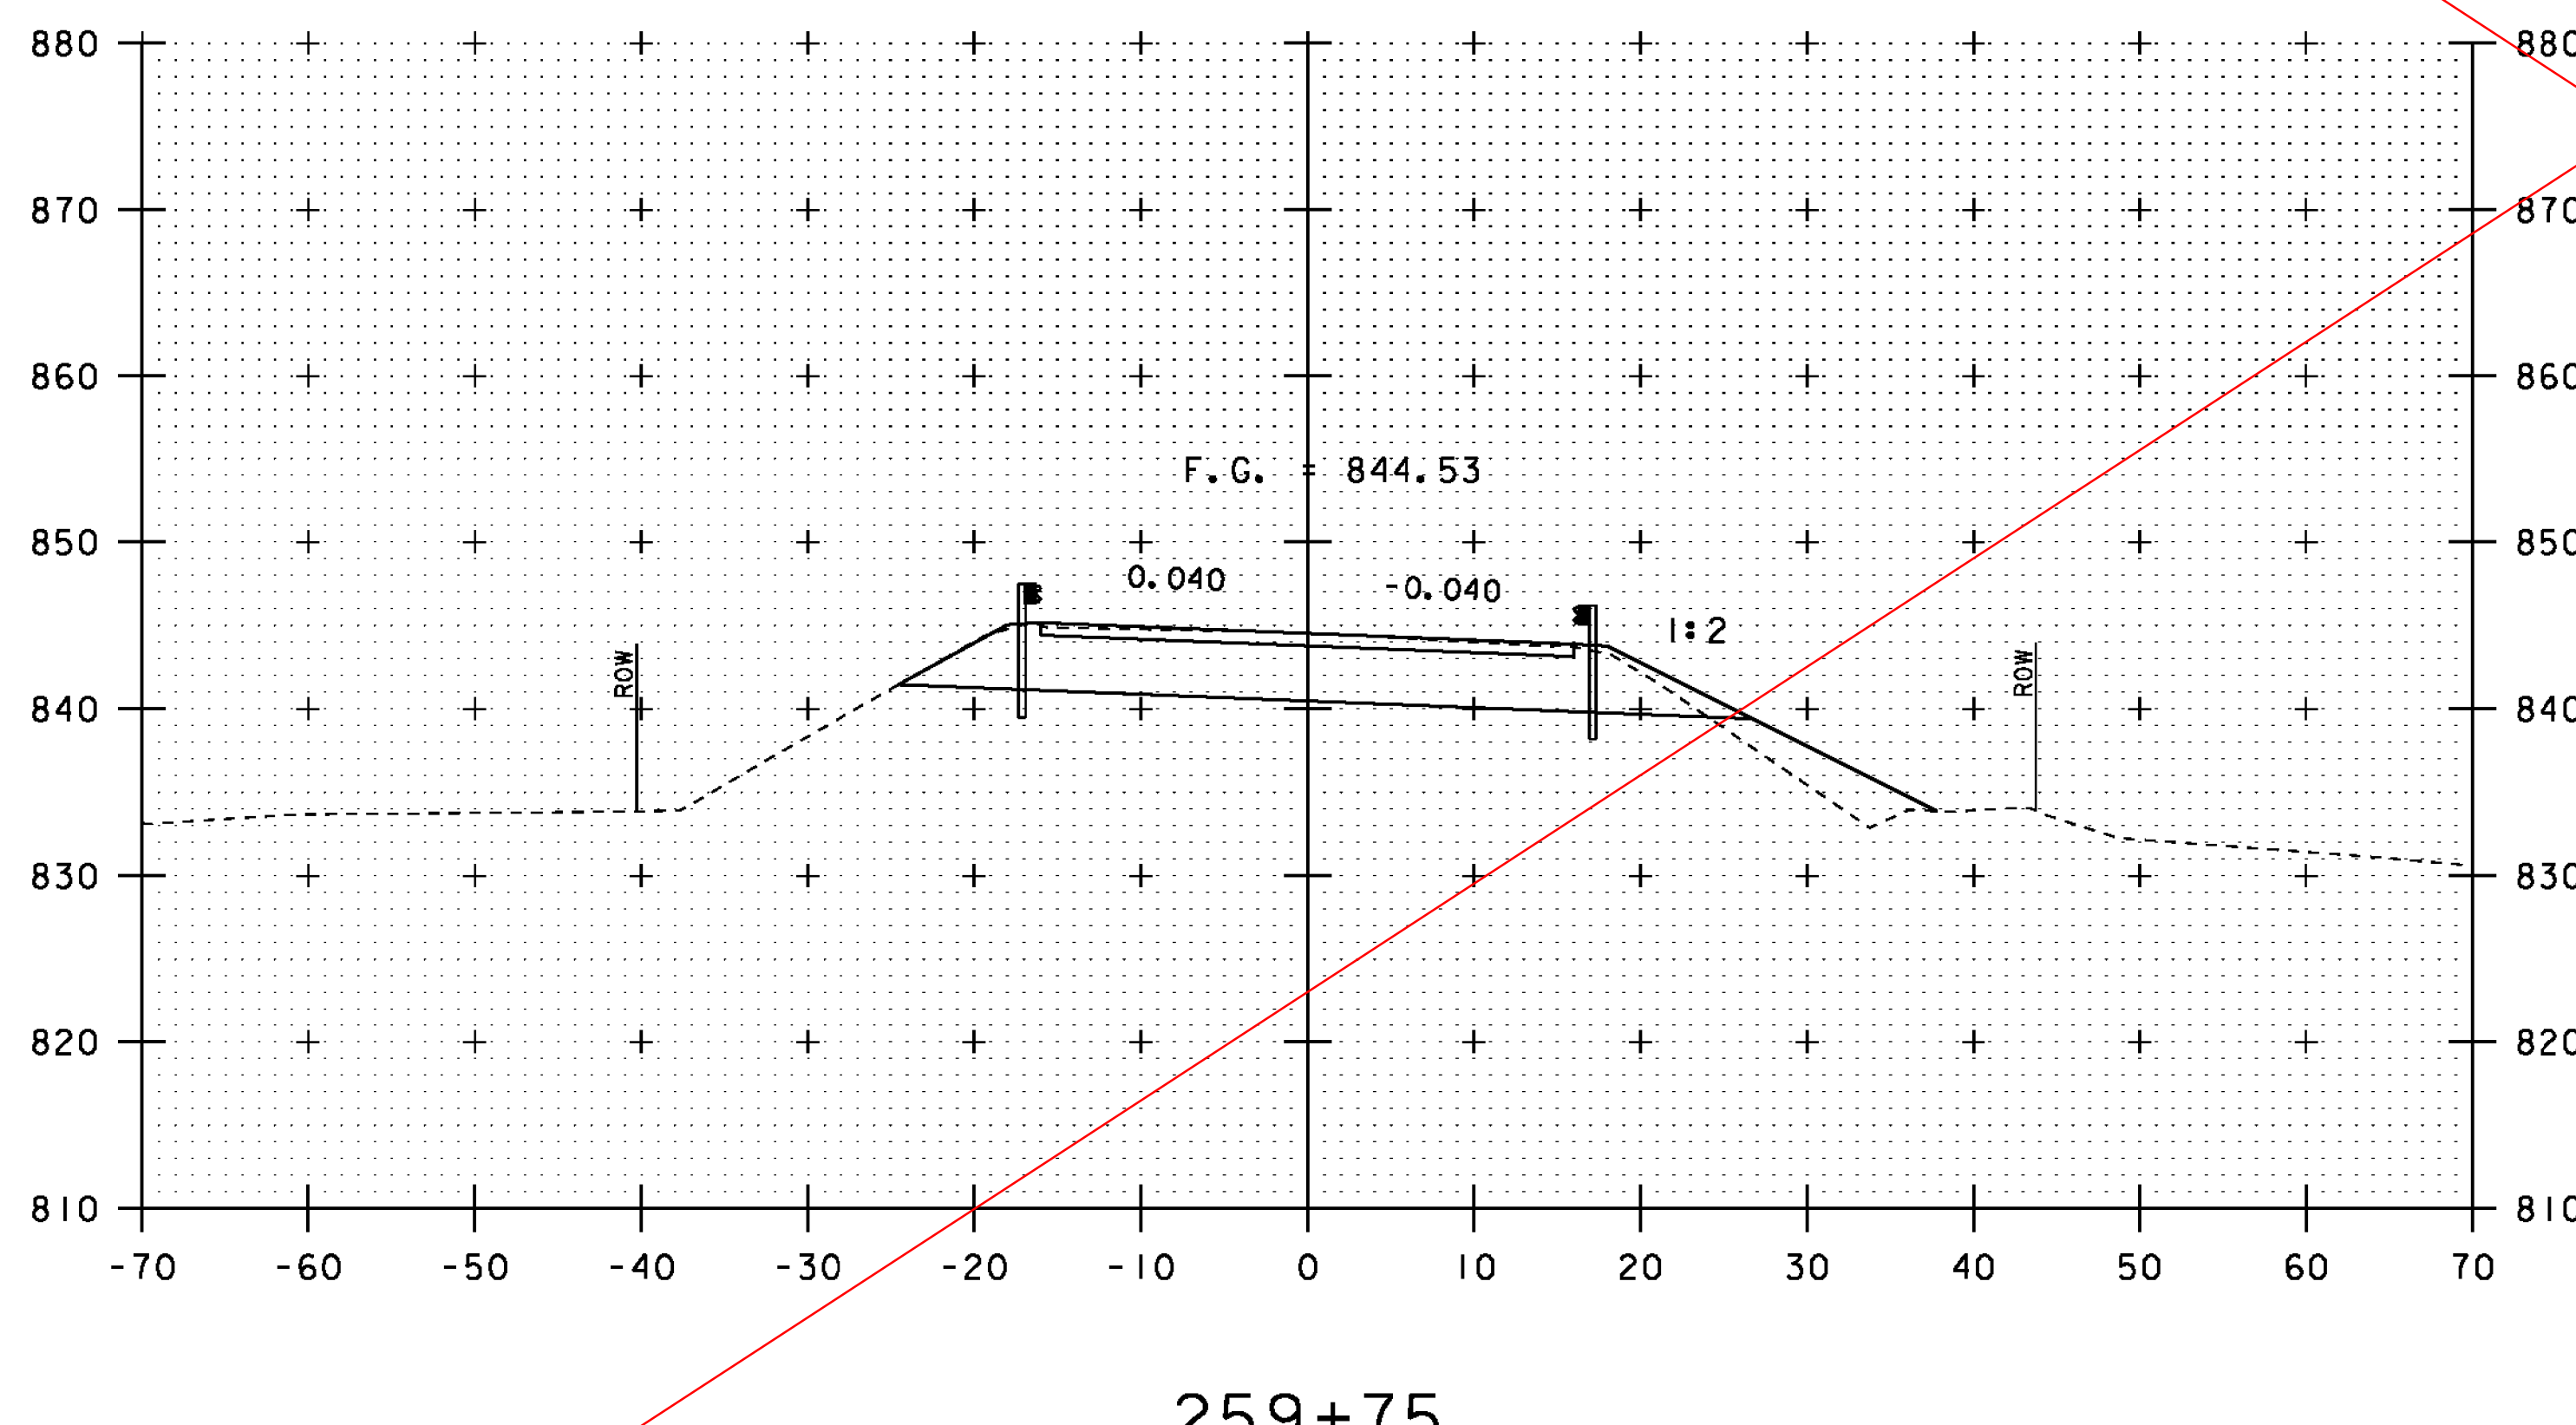


259+75

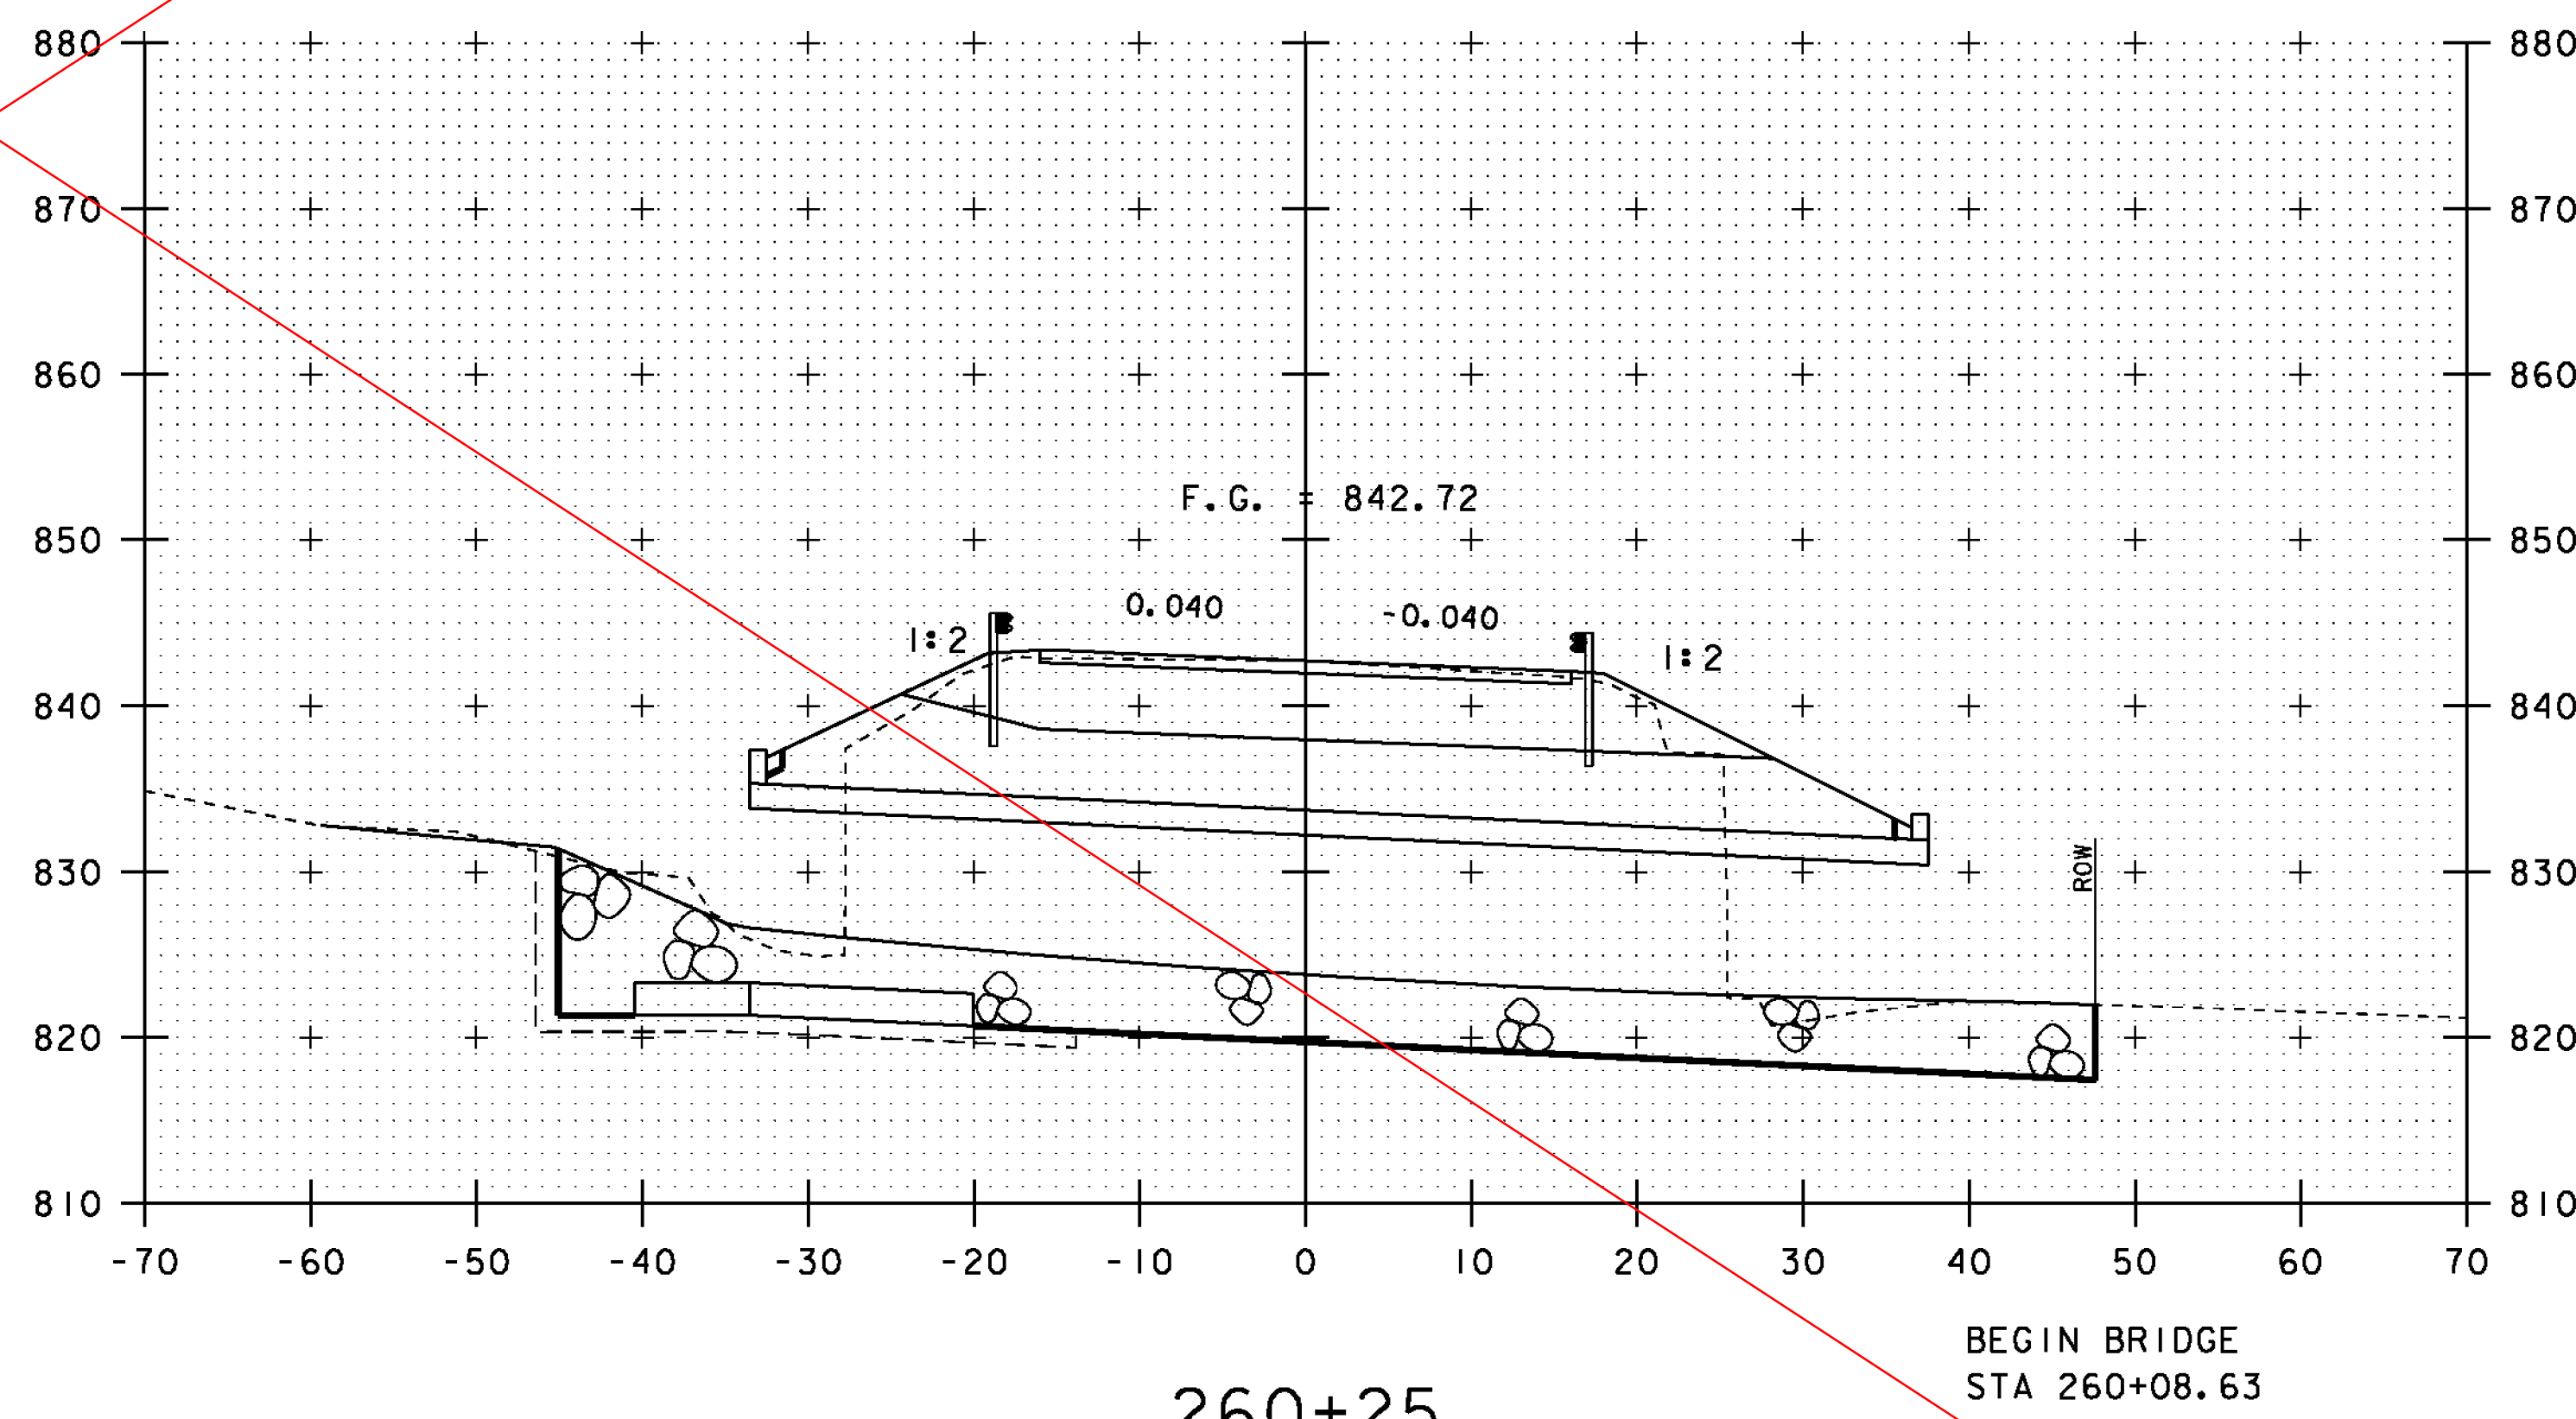

260+25

BEGIN BRIDGE
STA 260+08.63

NOTE: SEE REVISED SHEET
DATED 26-OCT-2011
FOR POST IRENE REVISIONS

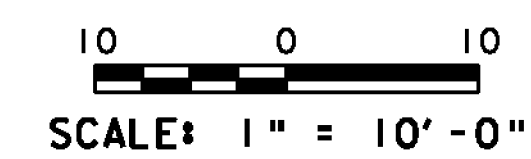

STA. 259+75 TO STA. 260+50

PROJECT NAME:	PITTSFIELD-STOCKBRIDGE	PLOT DATE:	02-SEP-2011
PROJECT NUMBER:	STP 022-1(22)S	DRAWN BY:	G. ROY
FILE NAME:	s00b122xsl.dgn	CHECKED BY:	R. YOUNG
PROJECT LEADER:	C. P. WILLIAMS	SHEET	36 OF 41
DESIGNED BY:	G. ROY		
VT 100 CROSS SECTIONS (3)			