



261+00

END PROJECT
BEGIN APPROACH
STA 261+00.00

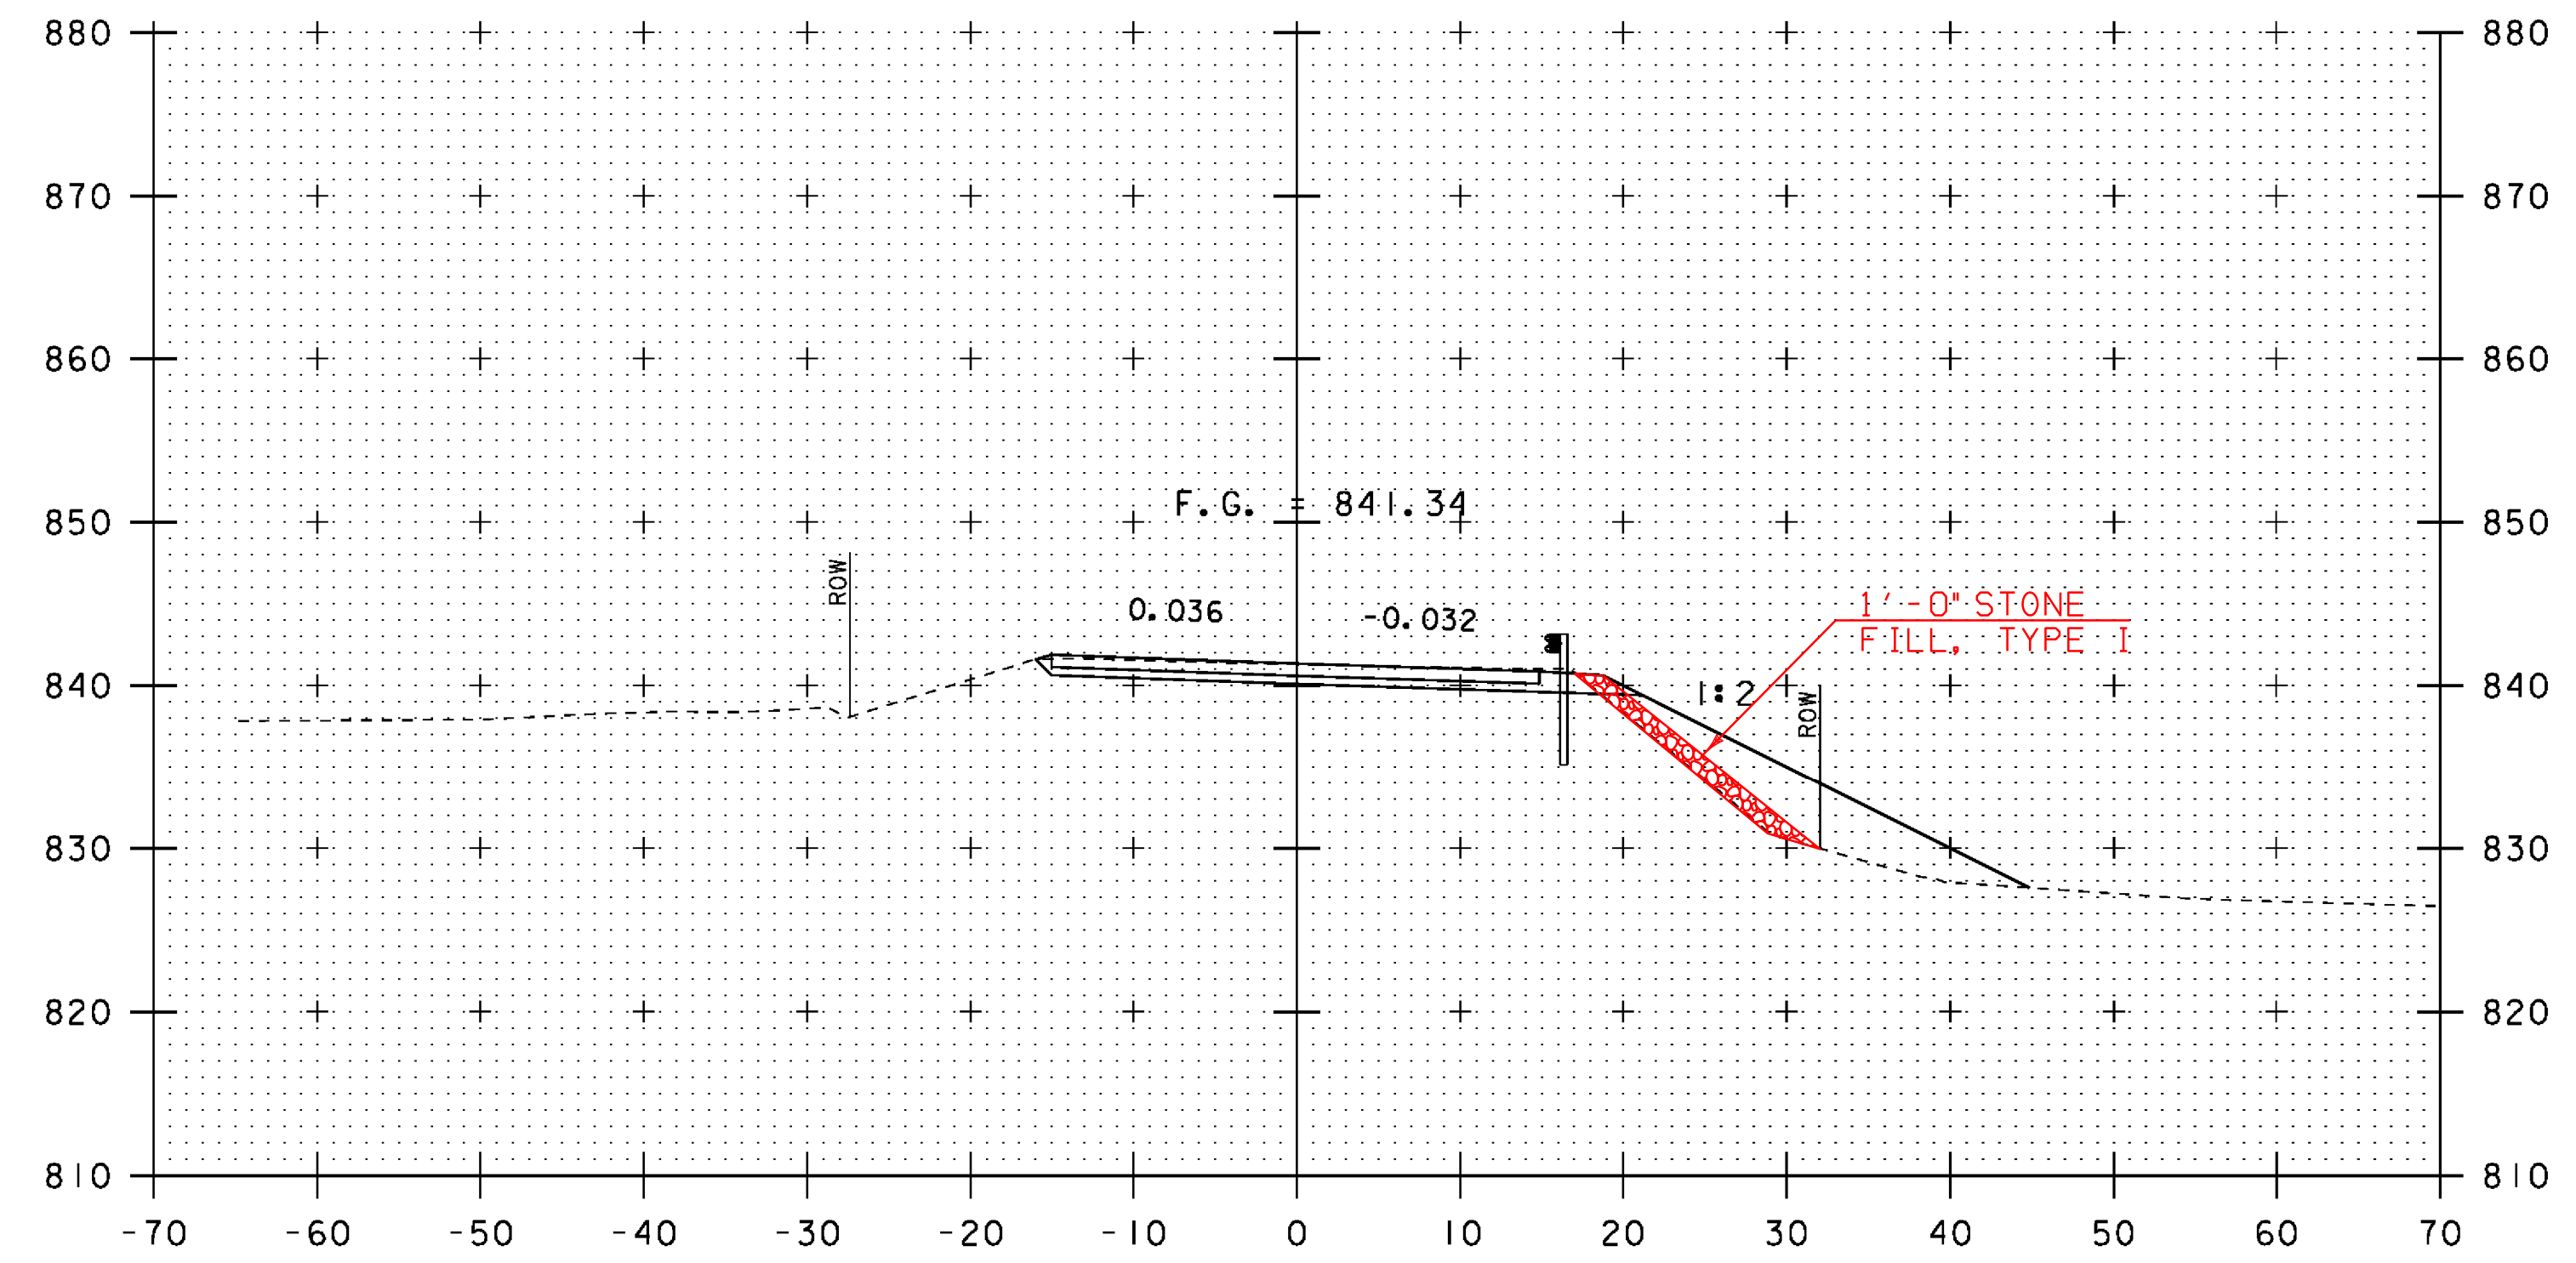


261+50

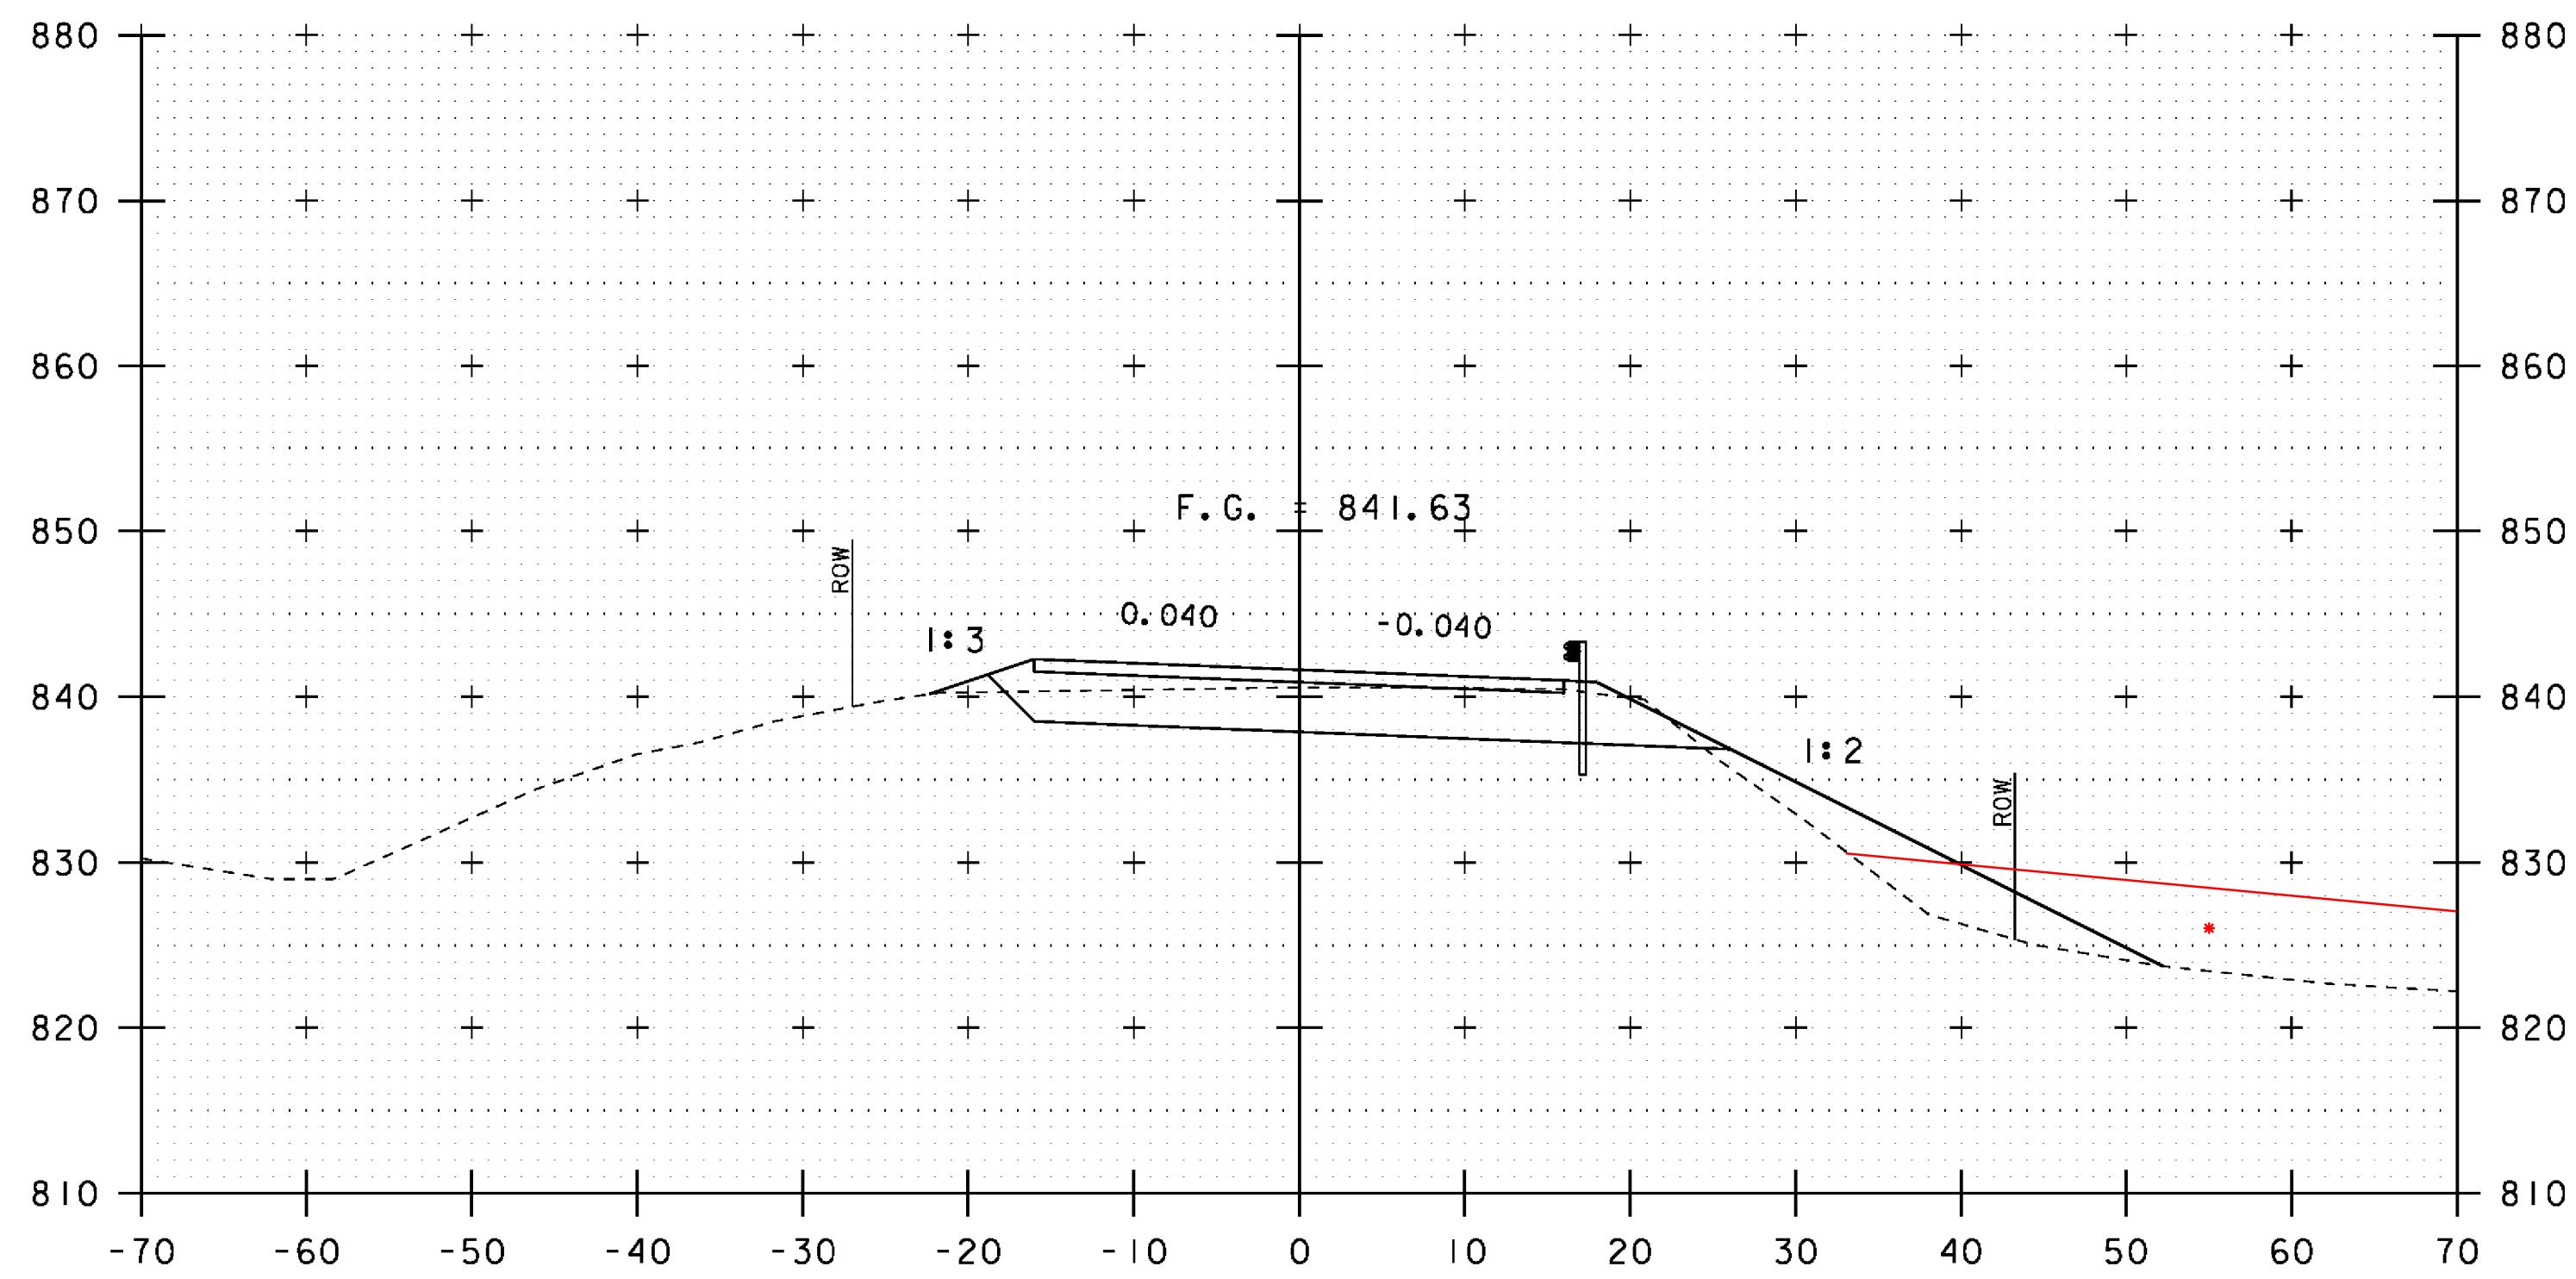


260+75

• MATERIAL FROM STAGING LEFT IN PLACE
TO RE-ESTABLISH RIPARIAN AREA

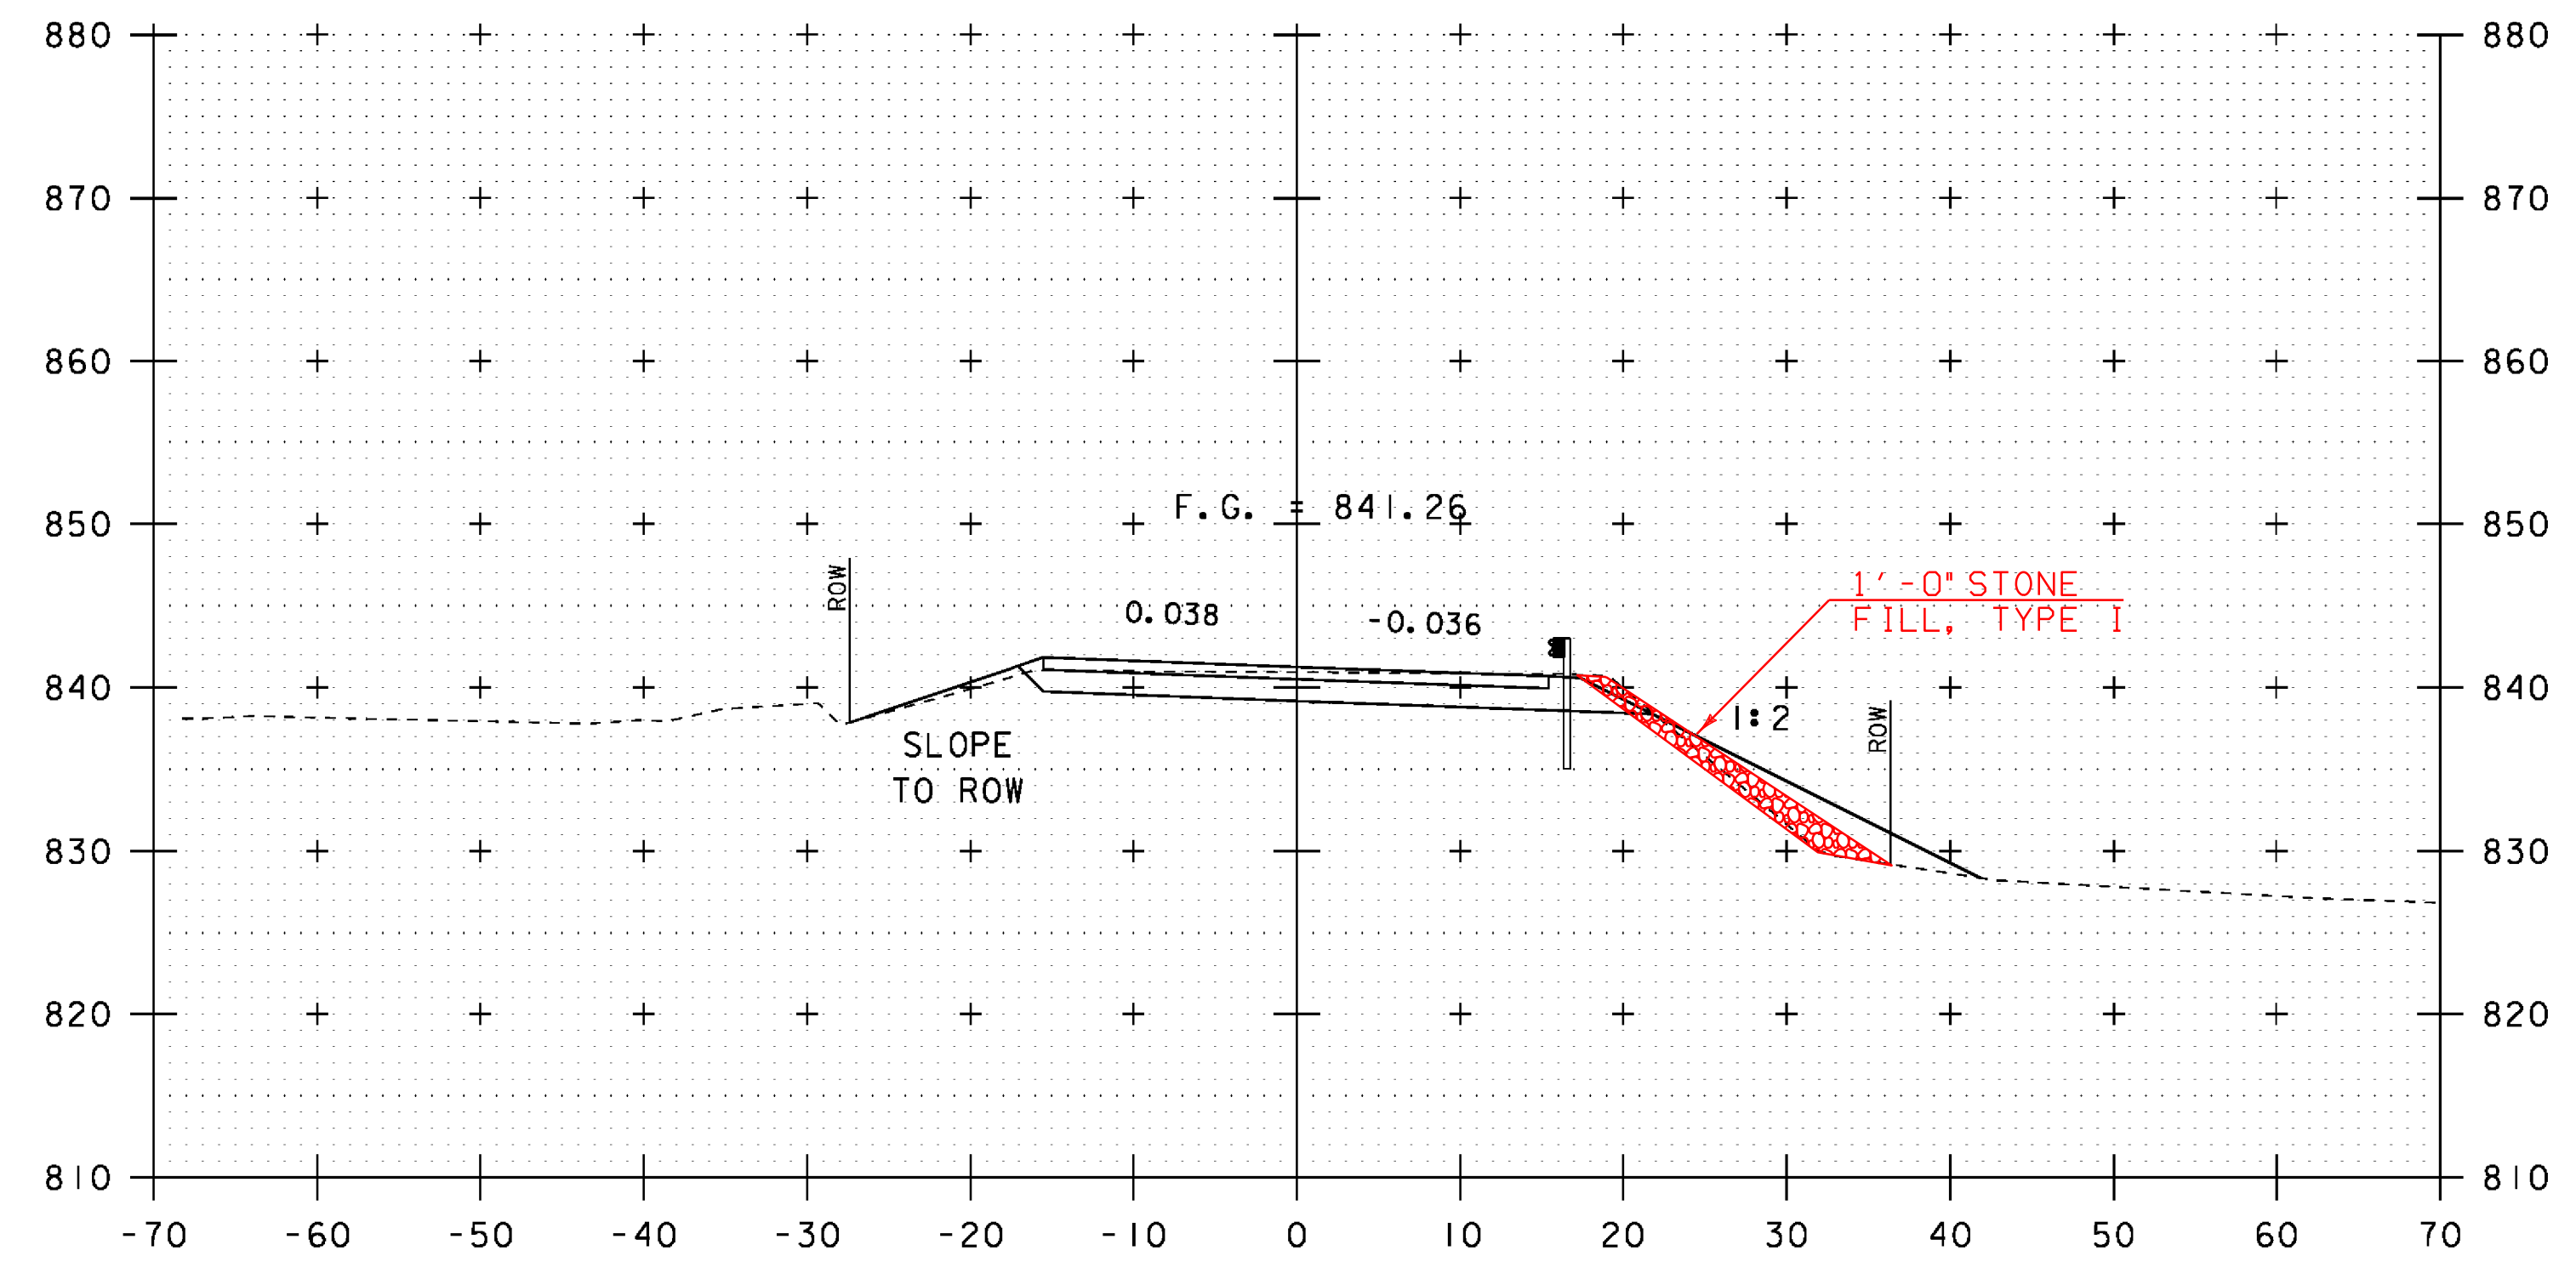

261+25

NOTE: REVISED SHEET
FOR POST IRENE

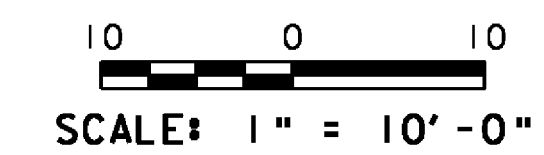

STA. 260+75 TO STA. 261+50

PROJECT NAME: PITTSFIELD-STOCKBRIDGE

PROJECT NUMBER: STP 022-1(22)S

FILE NAME: s00b122xsl.dgn

PROJECT LEADER: C. P. WILLIAMS

DESIGNED BY: G. ROY

VT 100 CROSS SECTIONS (4)

PLOT DATE: 26-OCT-2011

DRAWN BY: G. ROY

CHECKED BY: R. YOUNG

SHEET 37 OF 41