




262+00 STONE FILL, TYPE I  
ENDS AT 261+96 RT  
11' WIDE

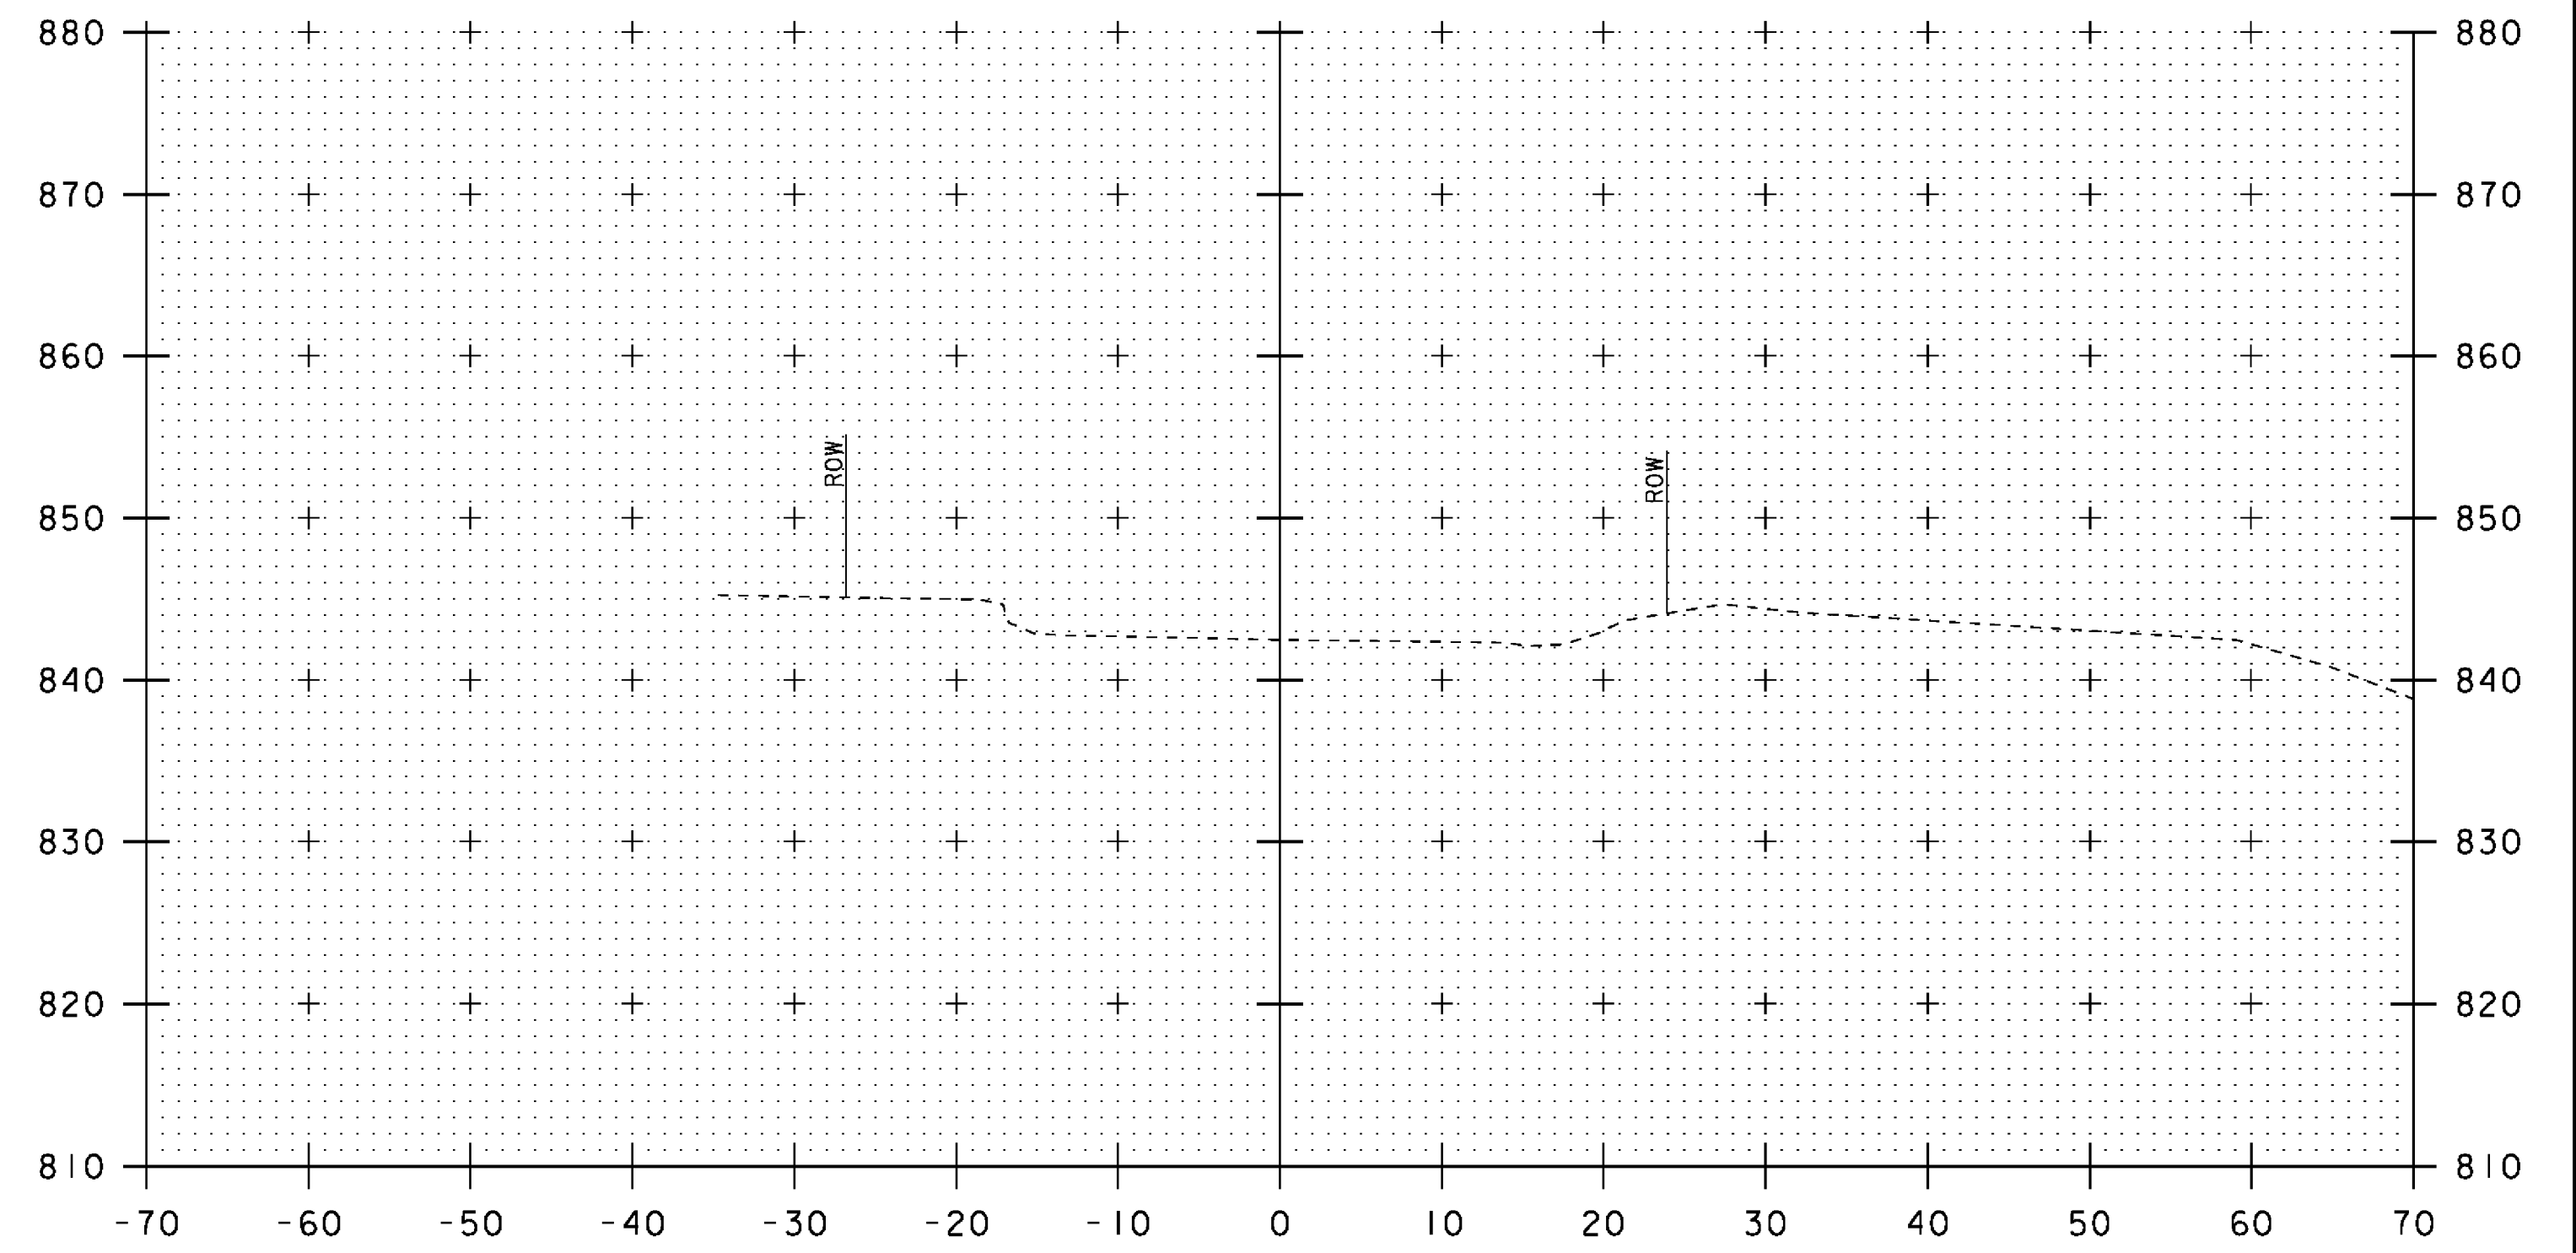

262+50

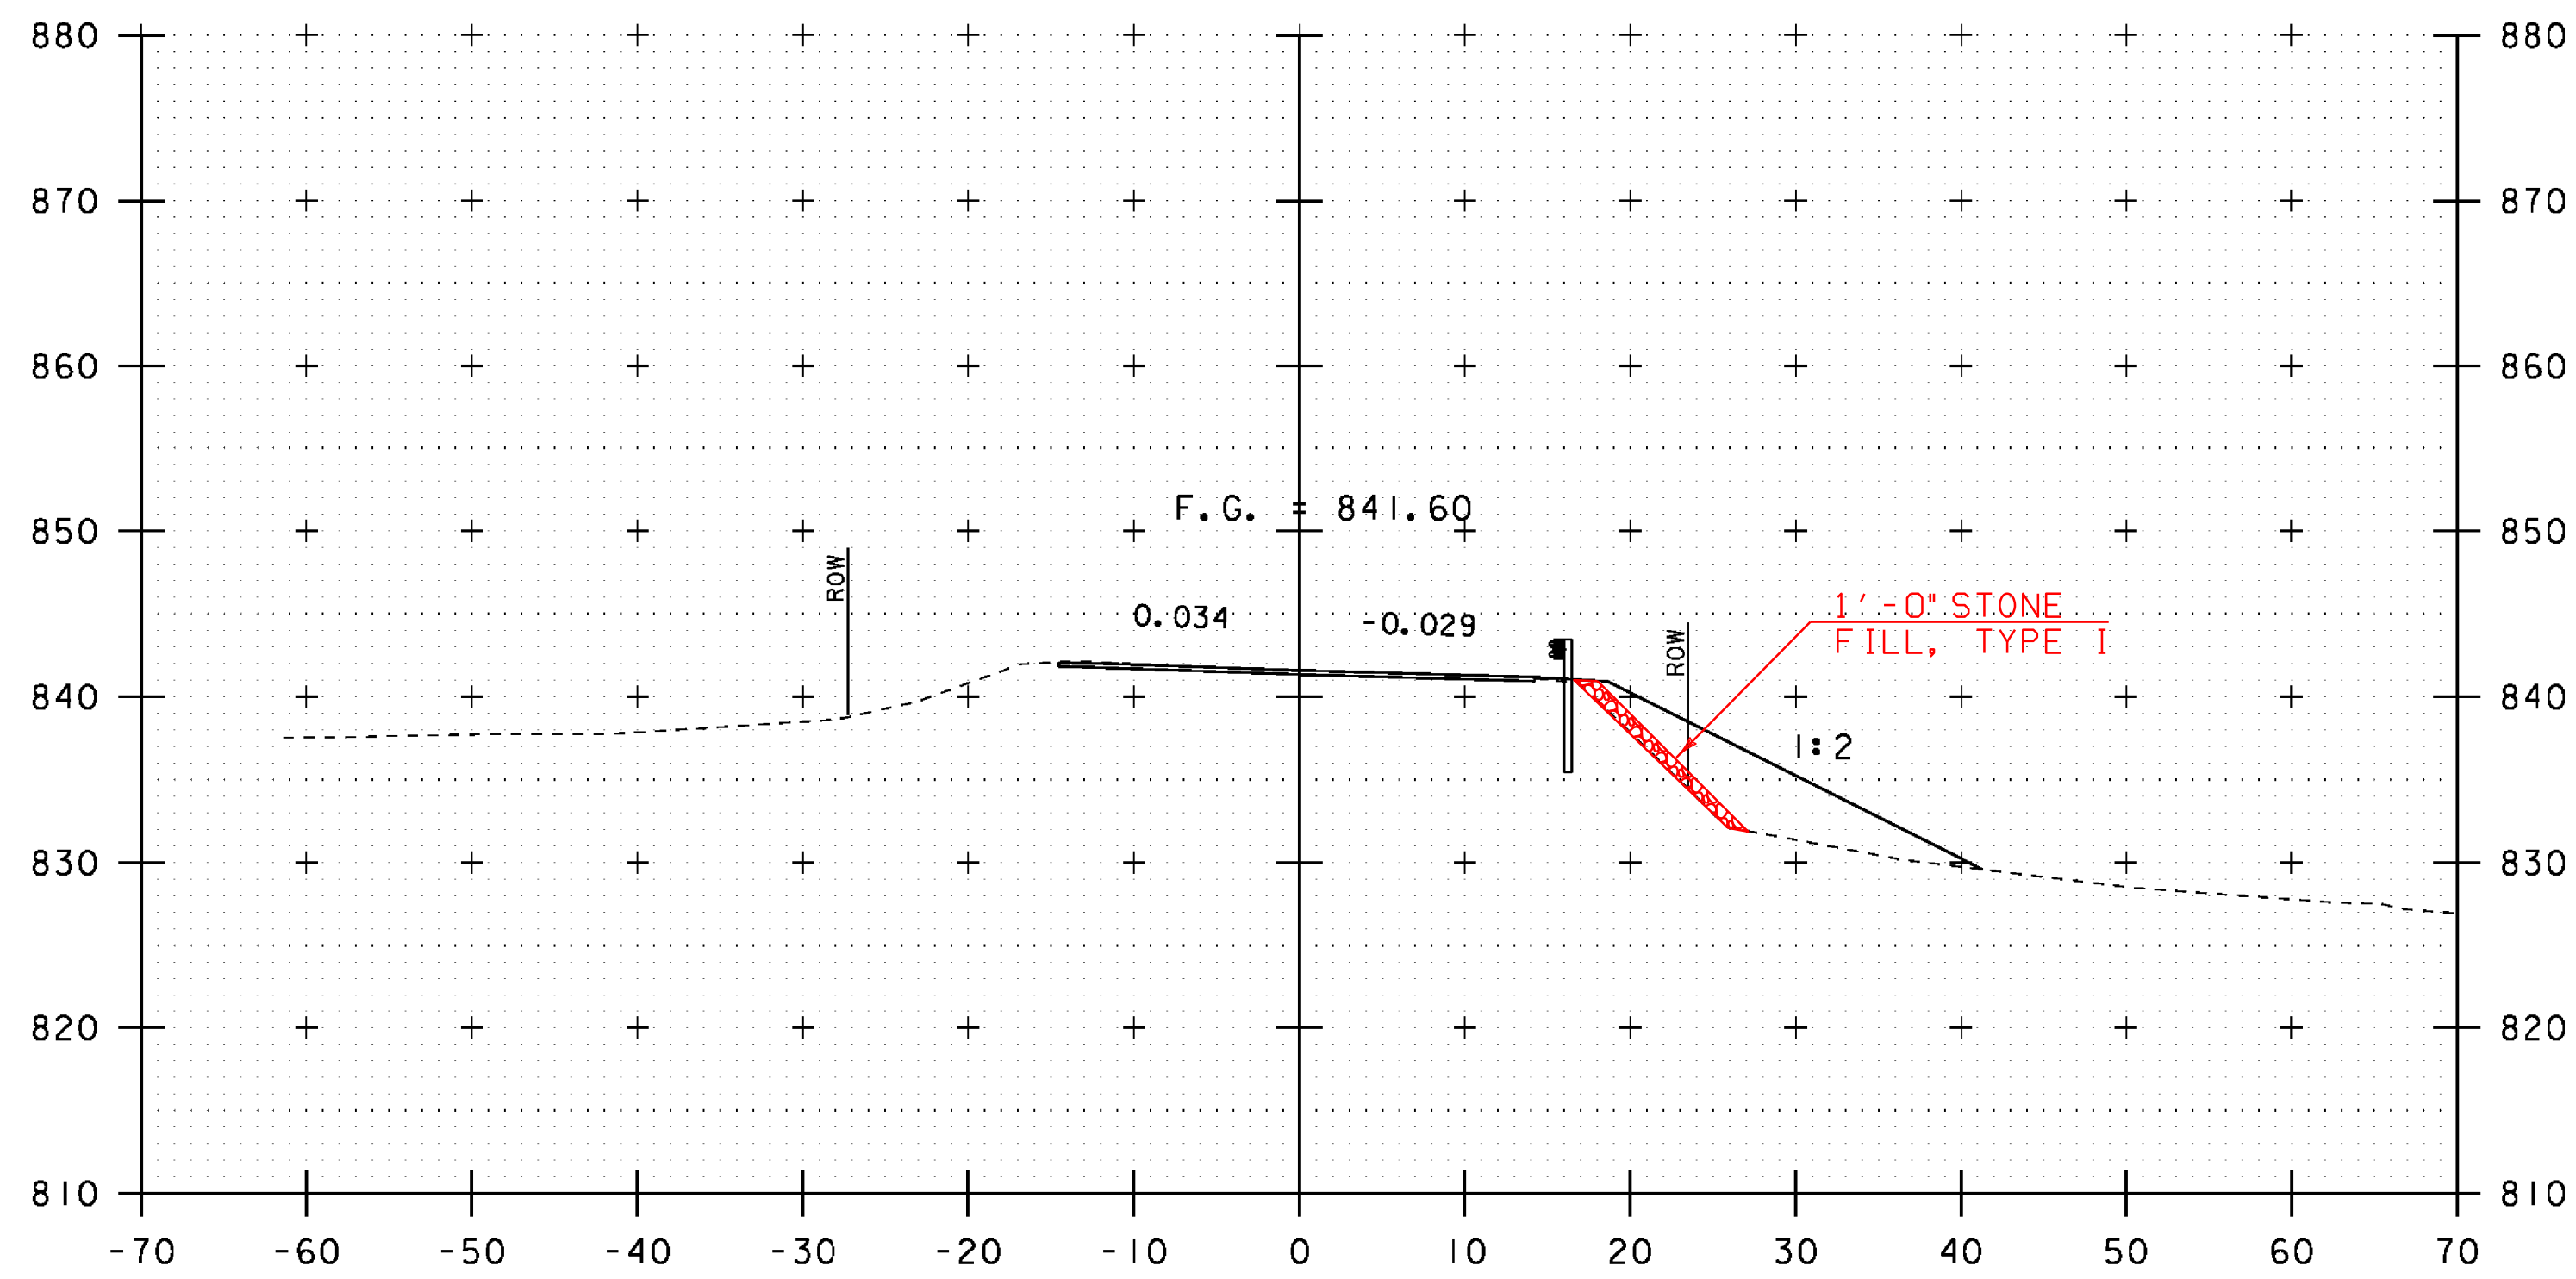


261+75

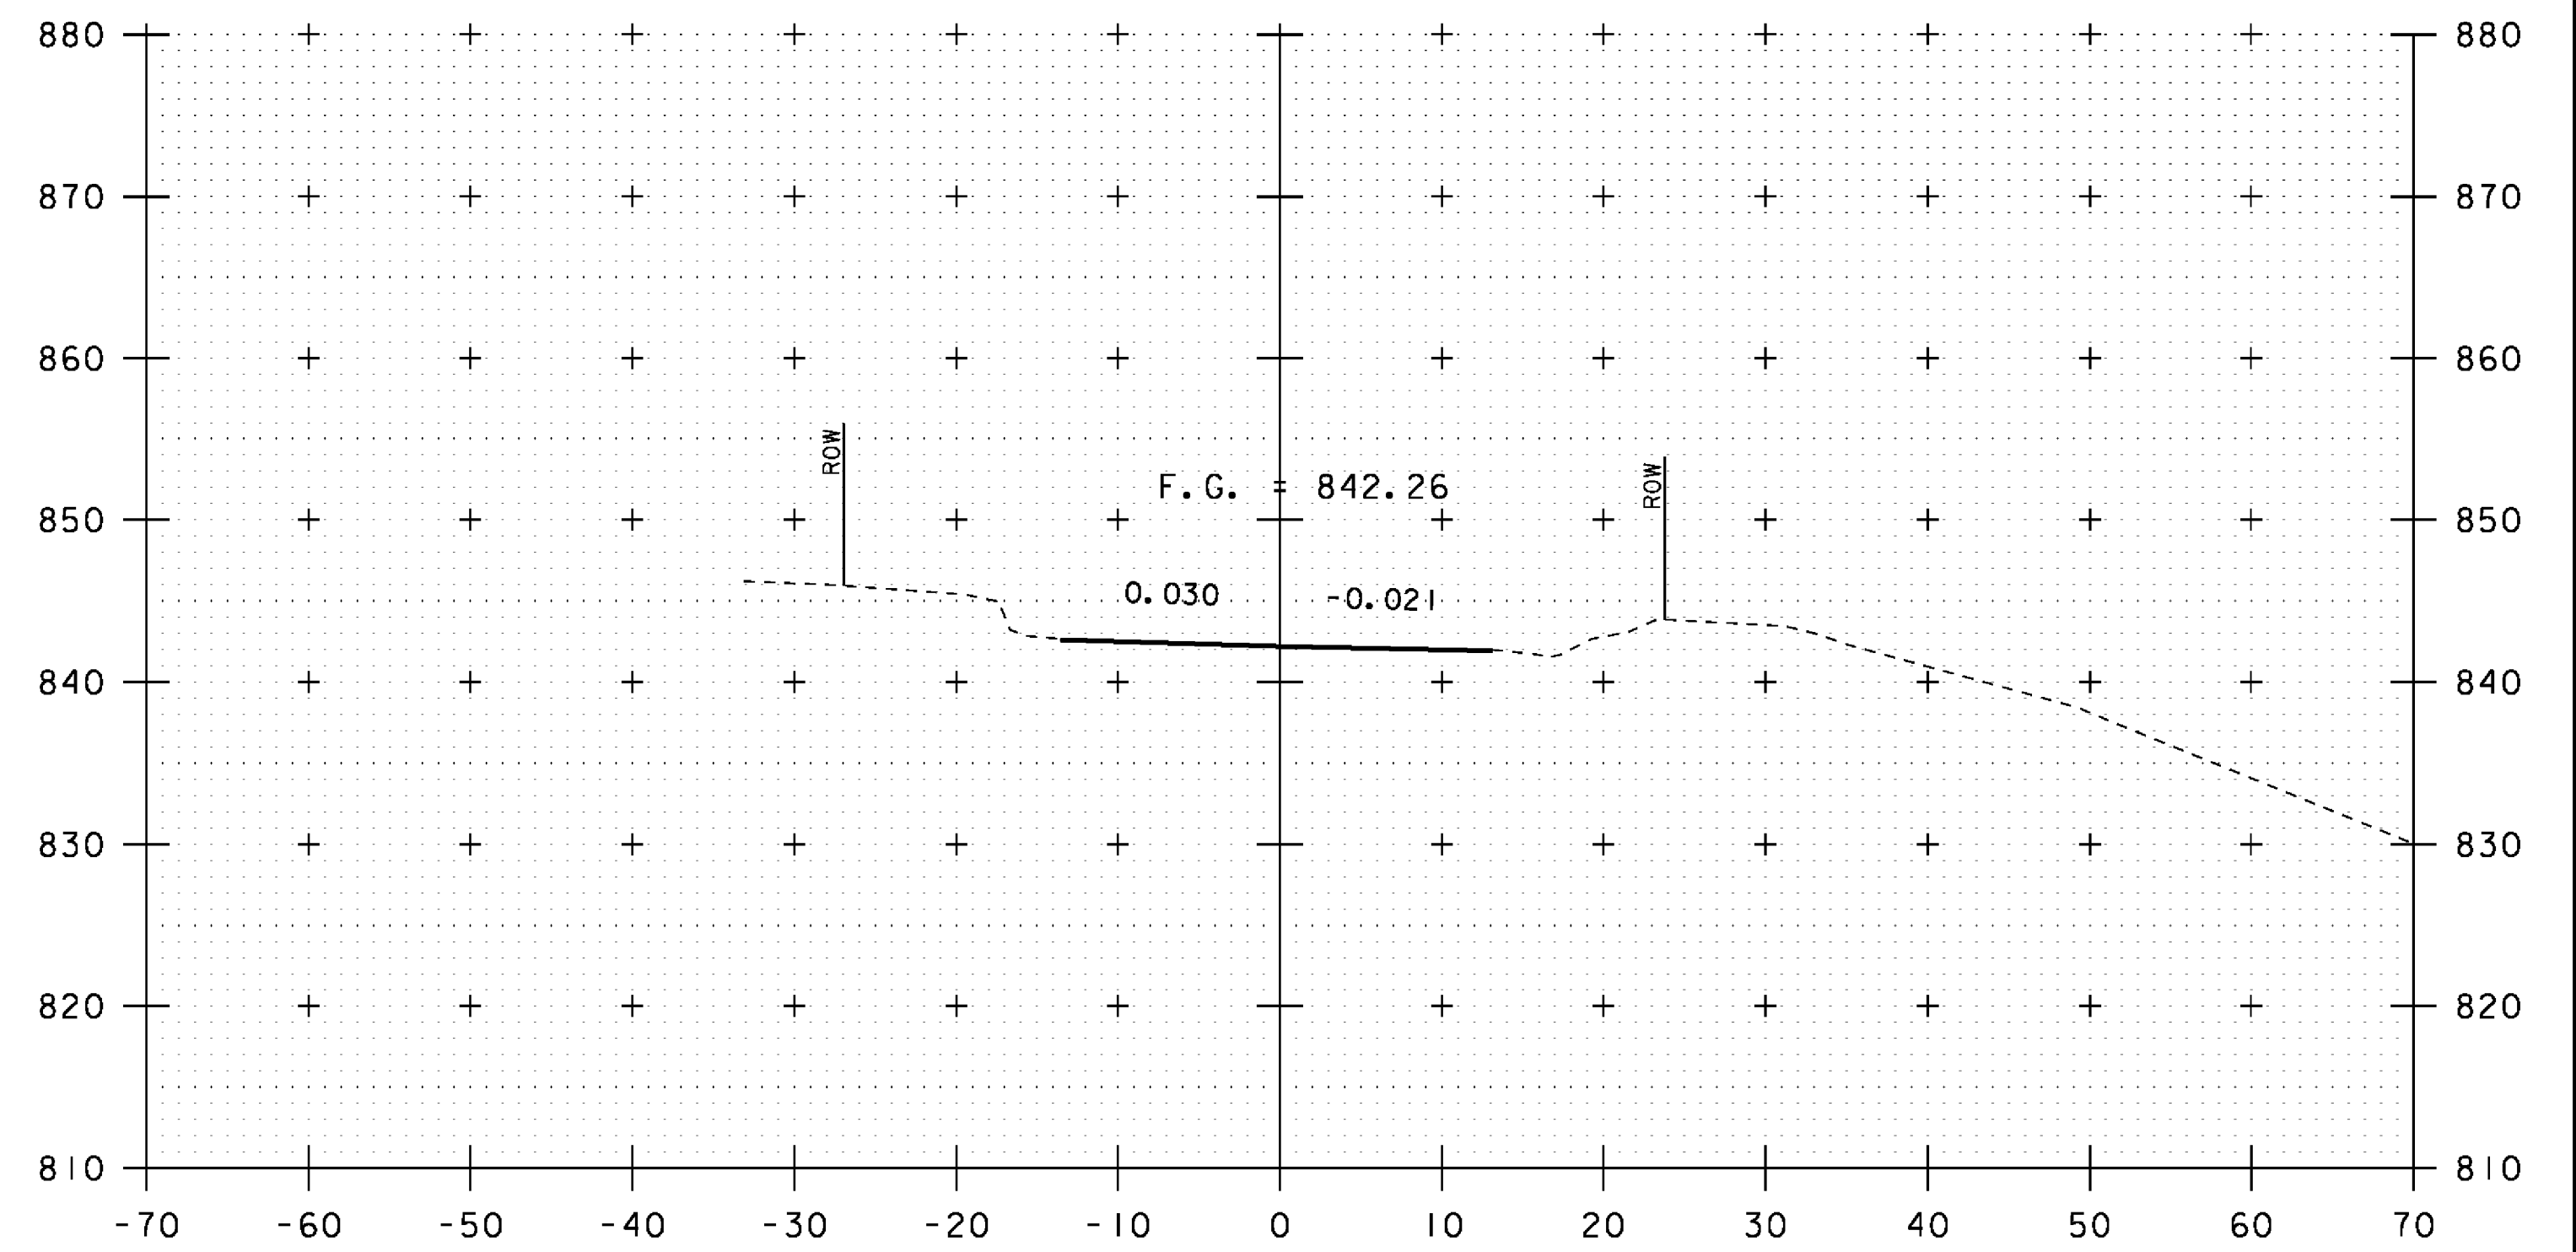

262+25

END APPROACH  
MATCH EXISTING  
STA 262+25.00

NOTE: REVISED SHEET  
FOR POST IRENE

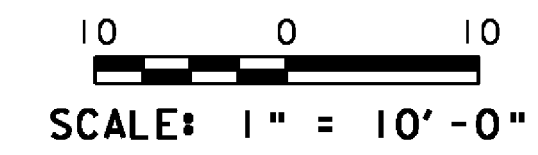

STA. 261+75 TO STA. 262+50

PROJECT NAME: PITTSFIELD-STOCKBRIDGE  
PROJECT NUMBER: STP 022-1(22)S

FILE NAME: s00b122xsl.dgn  
PROJECT LEADER: C. P. WILLIAMS  
DESIGNED BY: G. ROY  
VT 100 CROSS SECTIONS (5)

PLOT DATE: 26-OCT-2011  
DRAWN BY: G. ROY  
CHECKED BY: R. YOUNG  
SHEET 38 OF 41