



262+00


STA 261+95.0 RT
 END GEOTEXTILE UNDER STONE FILL
 STONE FILL, TYPE I
 GRUBBING MATERIAL

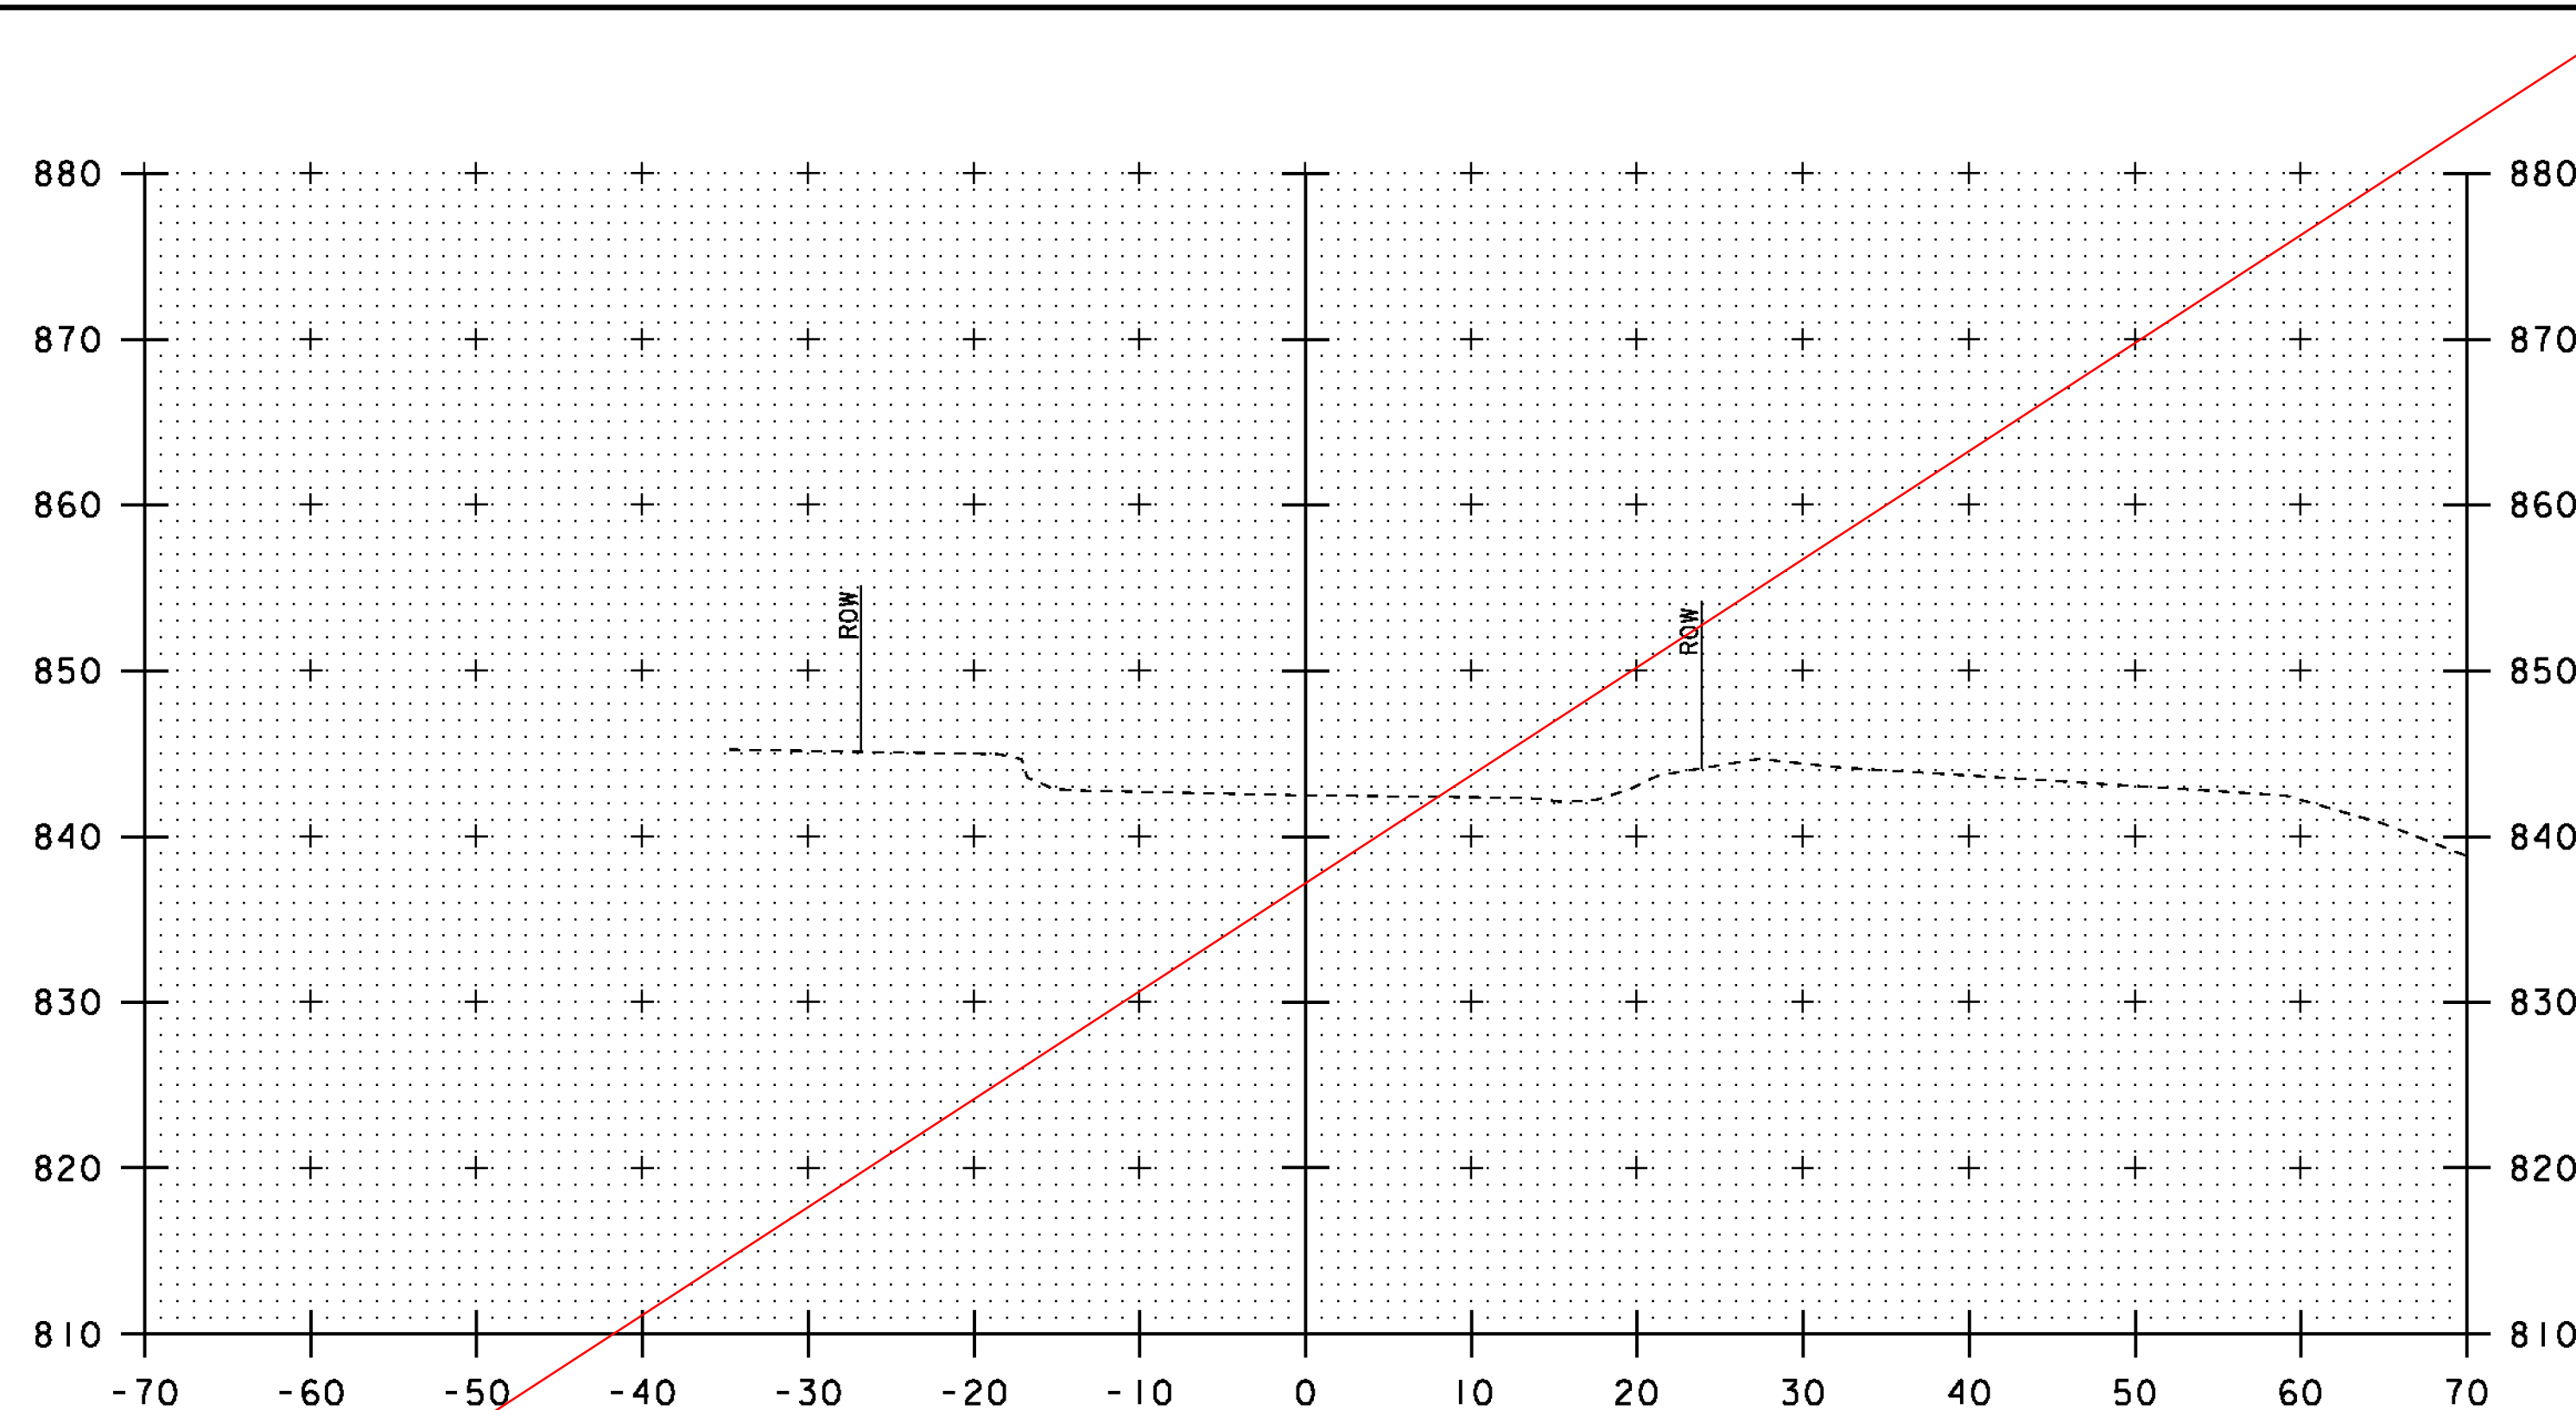

262+50

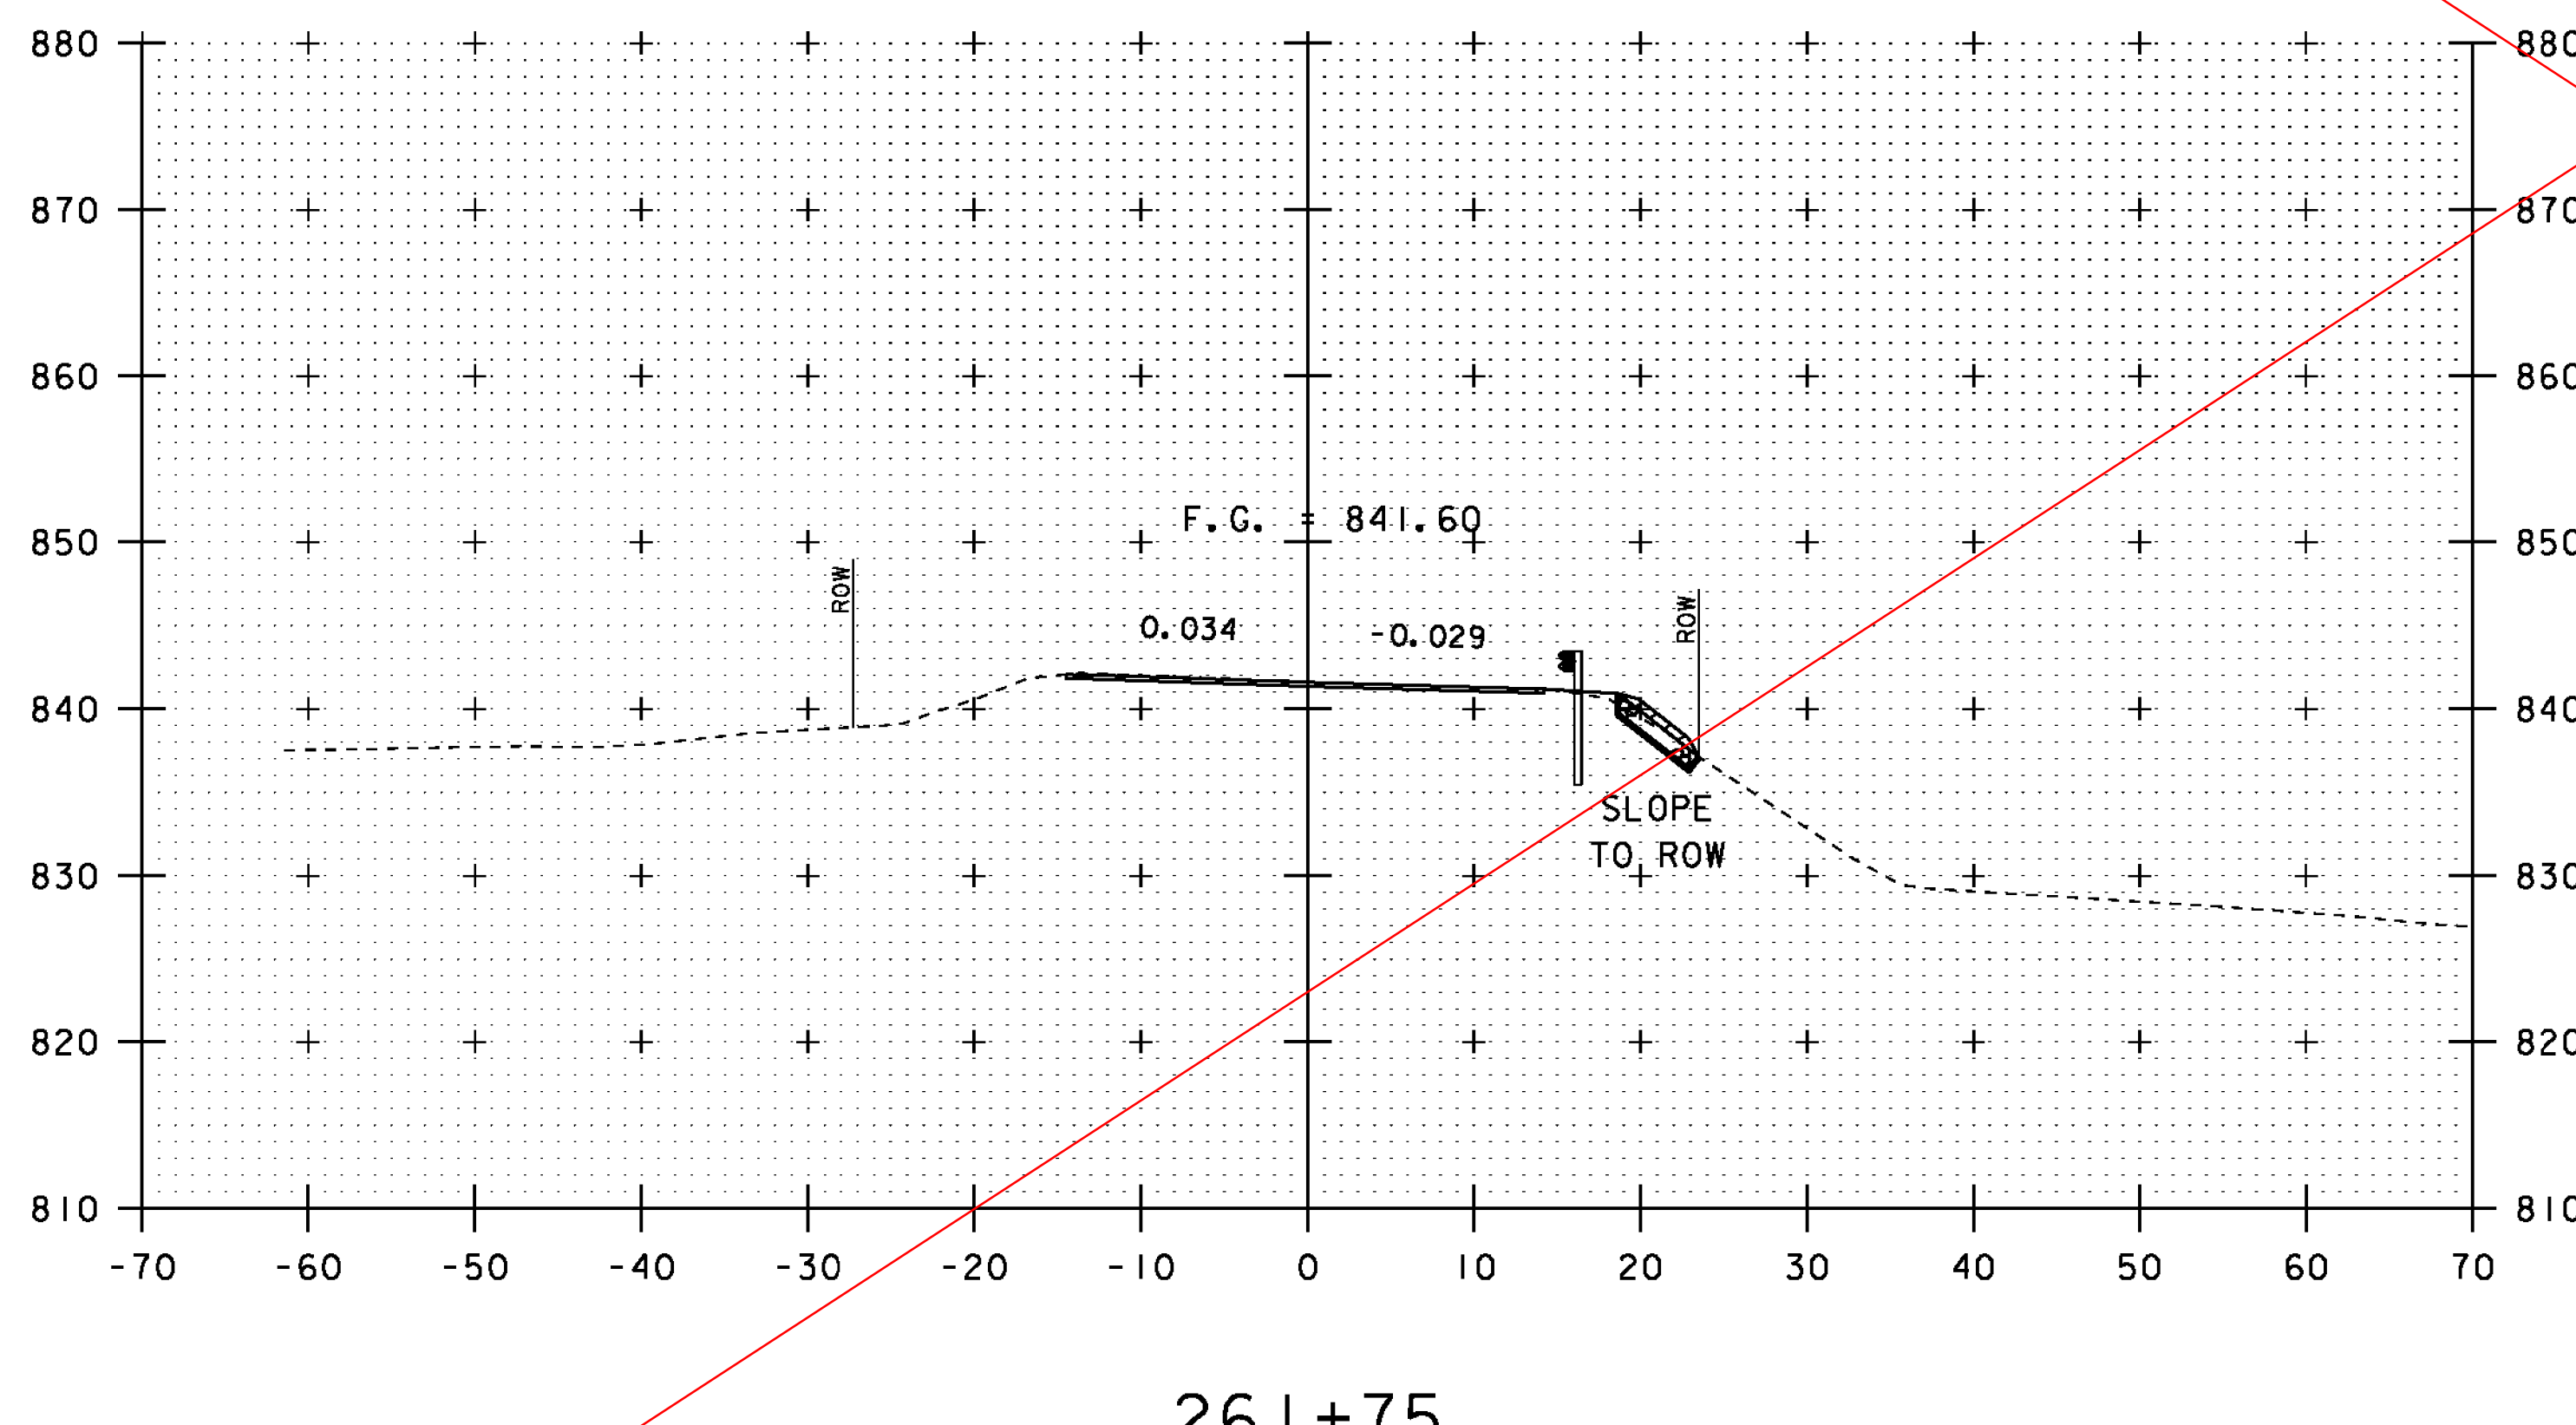


261+75

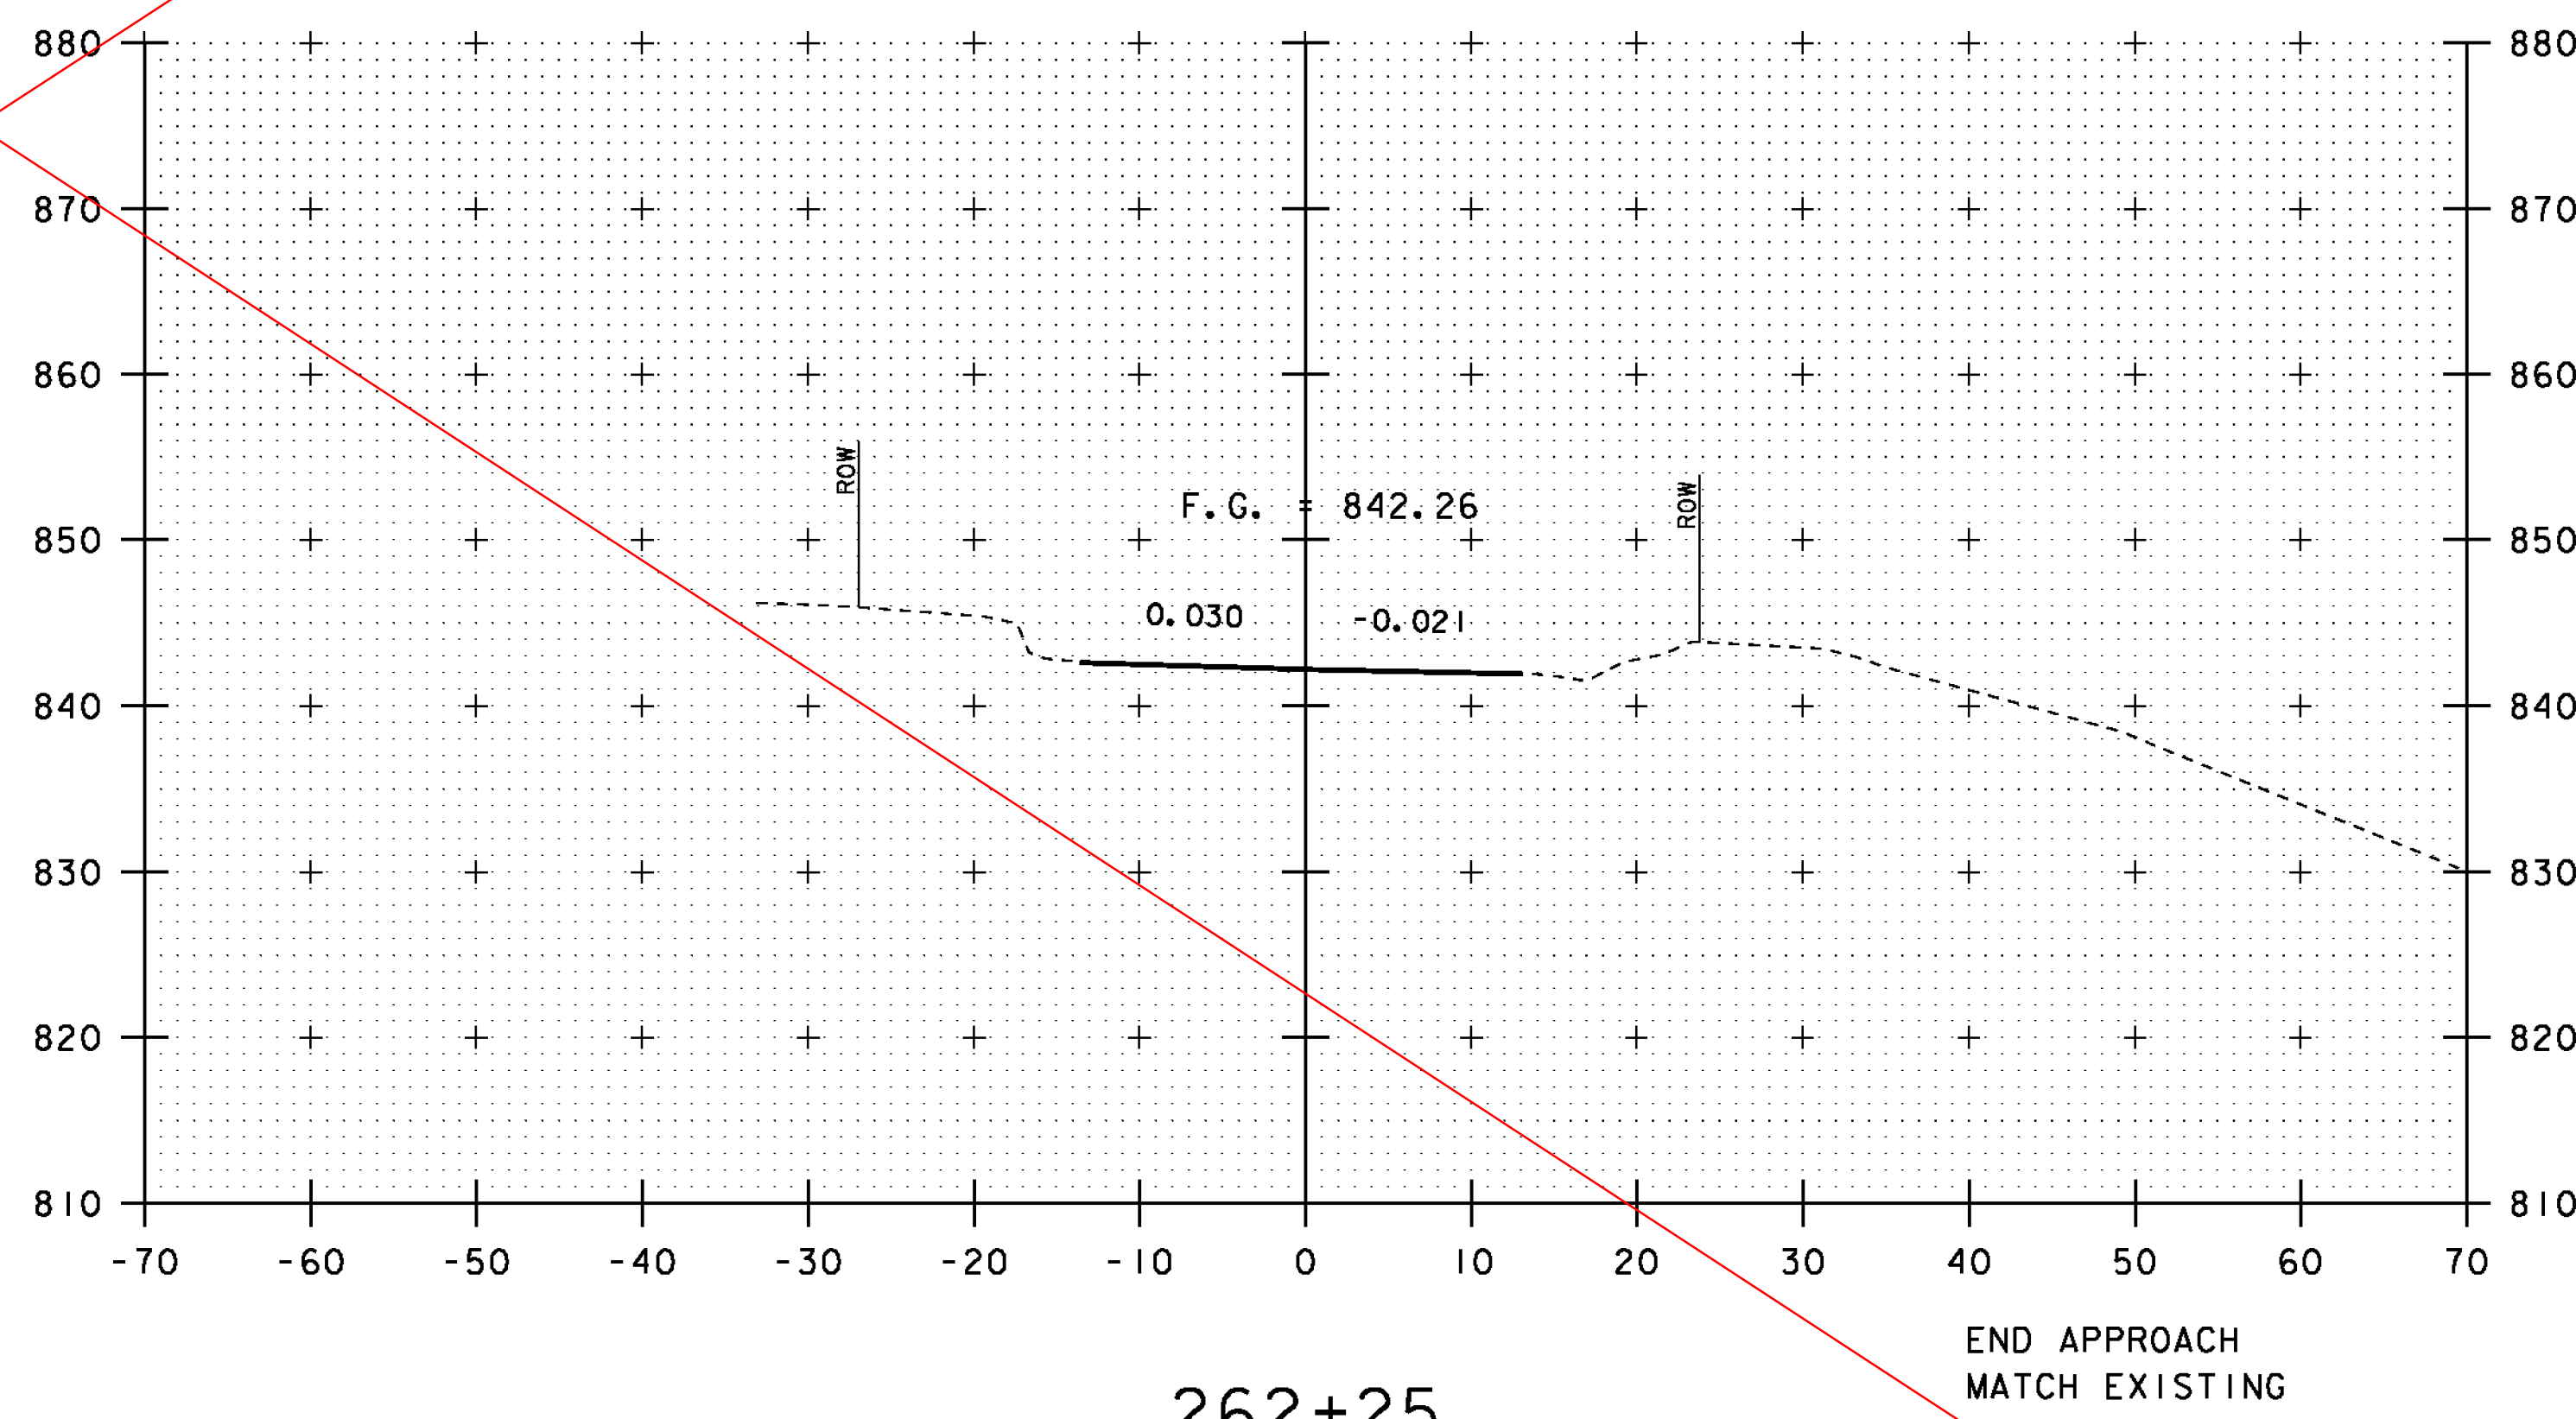

262+25

END APPROACH
 MATCH EXISTING
 STA 262+25.00

NOTE: SEE REVISED SHEET
 DATED 26-OCT-2011
 FOR POST IRENE REVISIONS

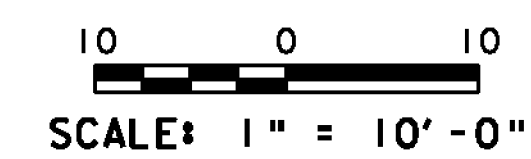

STA. 261+75 TO STA. 262+50

PROJECT NAME: PITTSFIELD-STOCKBRIDGE	PLOT DATE: 02-SEP-2011
PROJECT NUMBER: STP 022-1(22)S	DRAWN BY: G. ROY
FILE NAME: s00b122xsl.dgn	CHECKED BY: R. YOUNG
PROJECT LEADER: C. P. WILLIAMS	SHEET 38 OF 41
DESIGNED BY: G. ROY	
VT 100 CROSS SECTIONS (5)	