




10+70

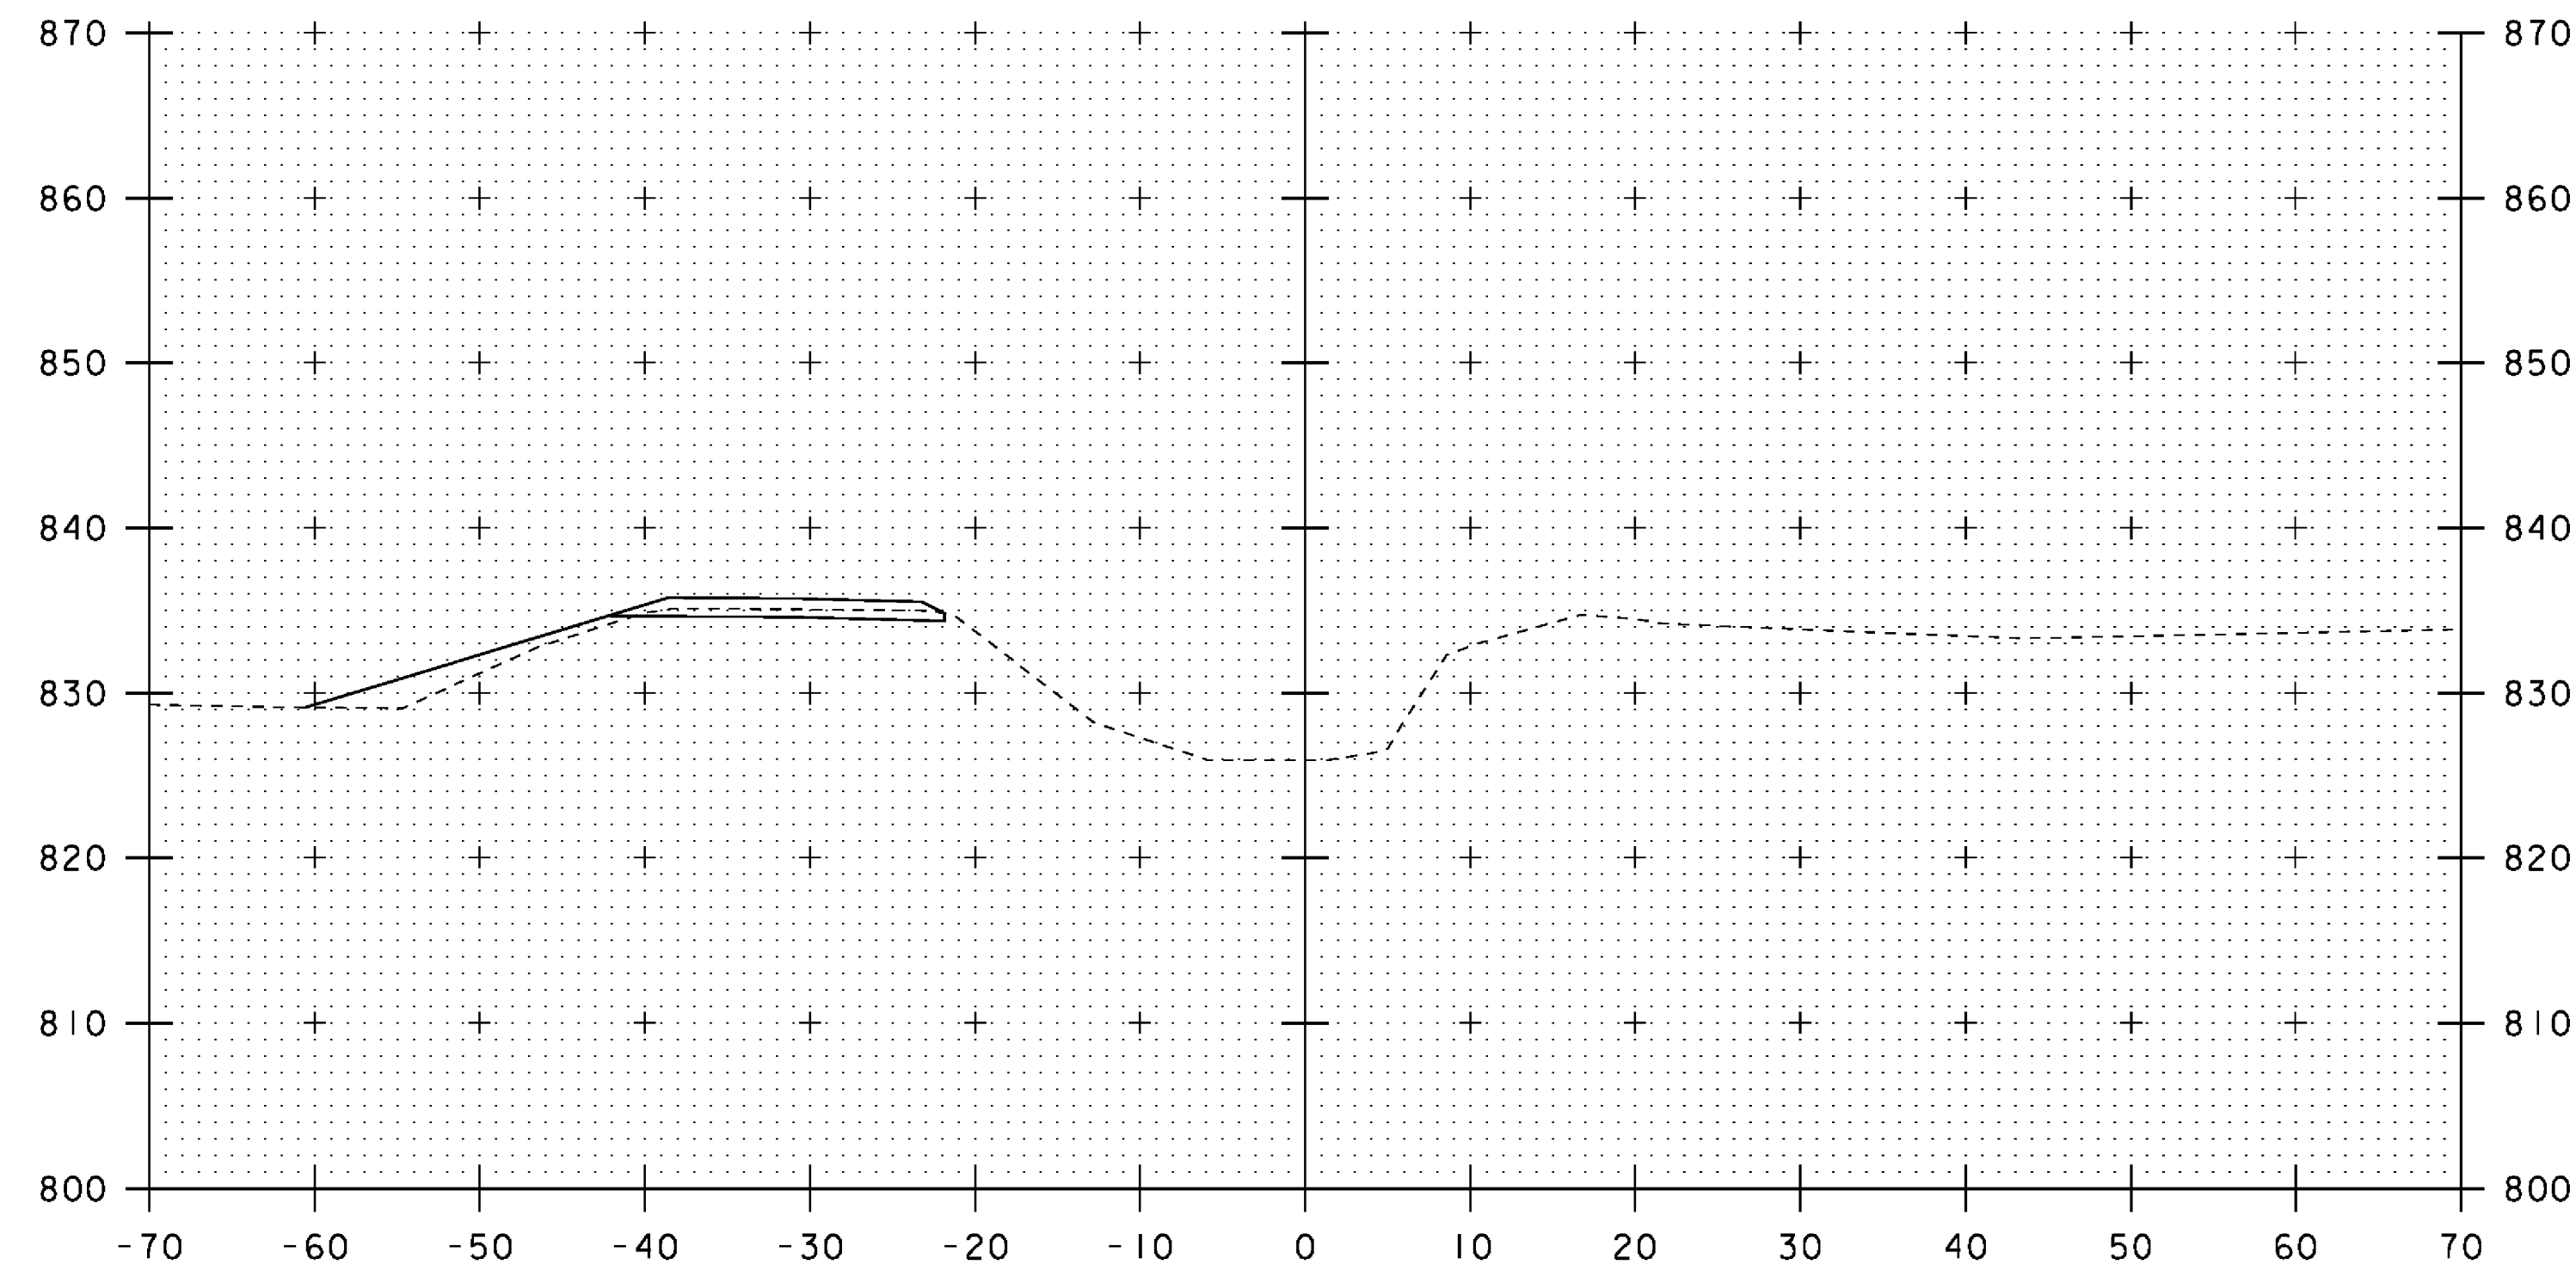


10+90

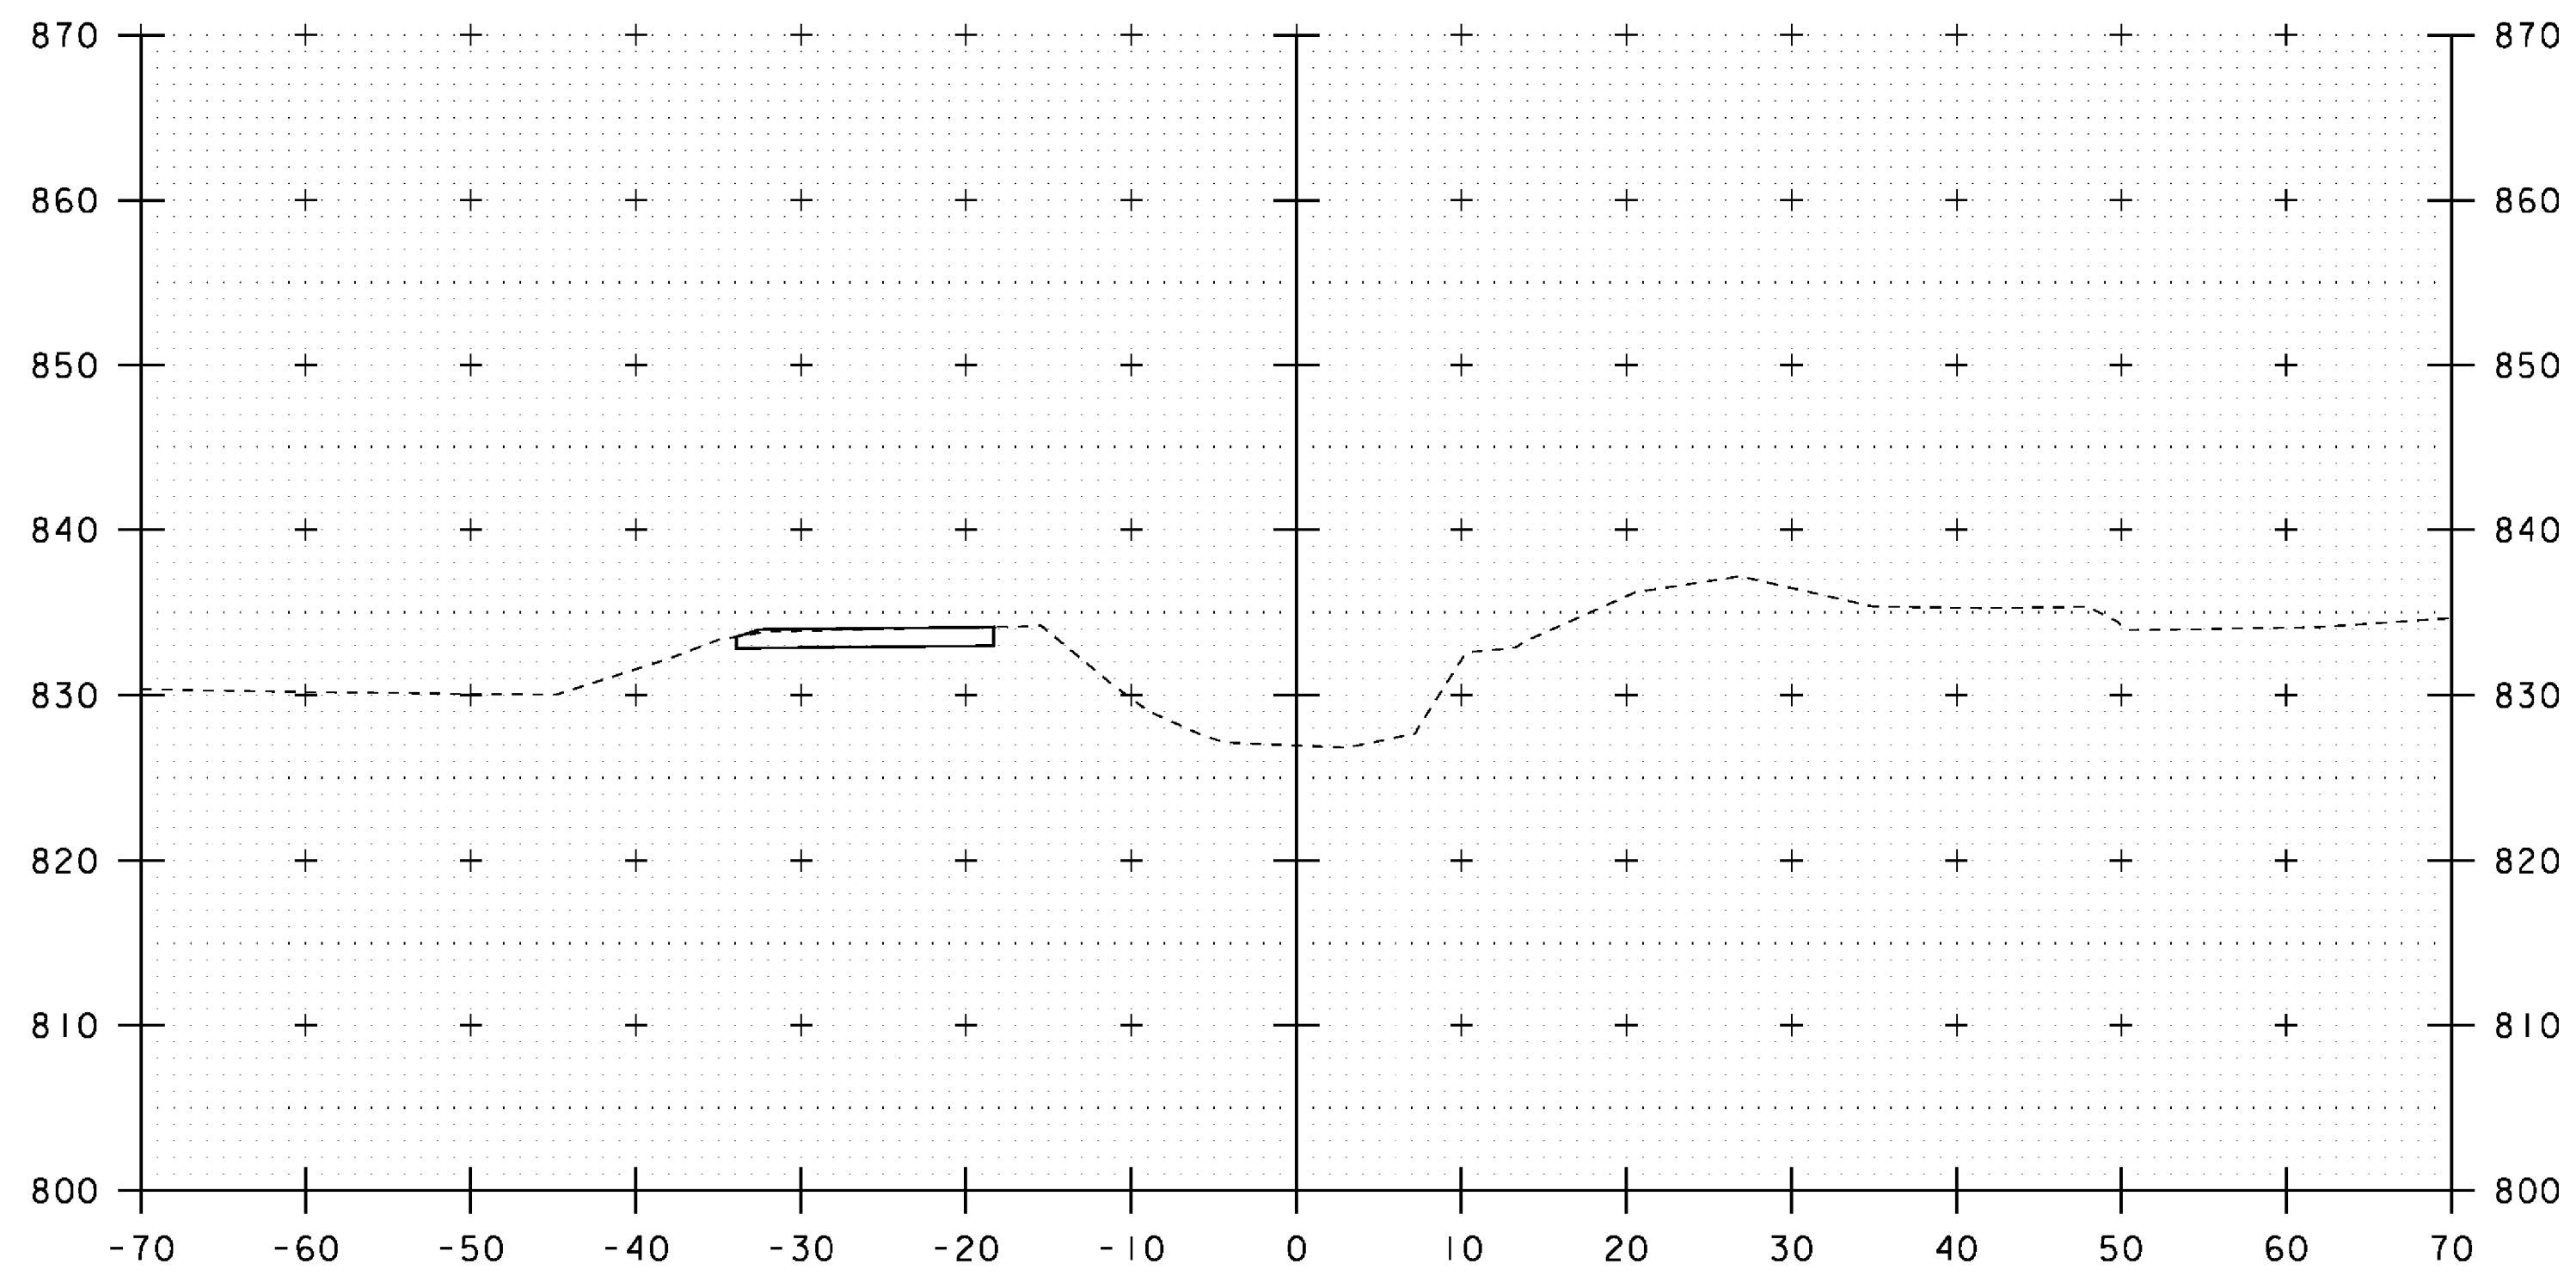

10+60

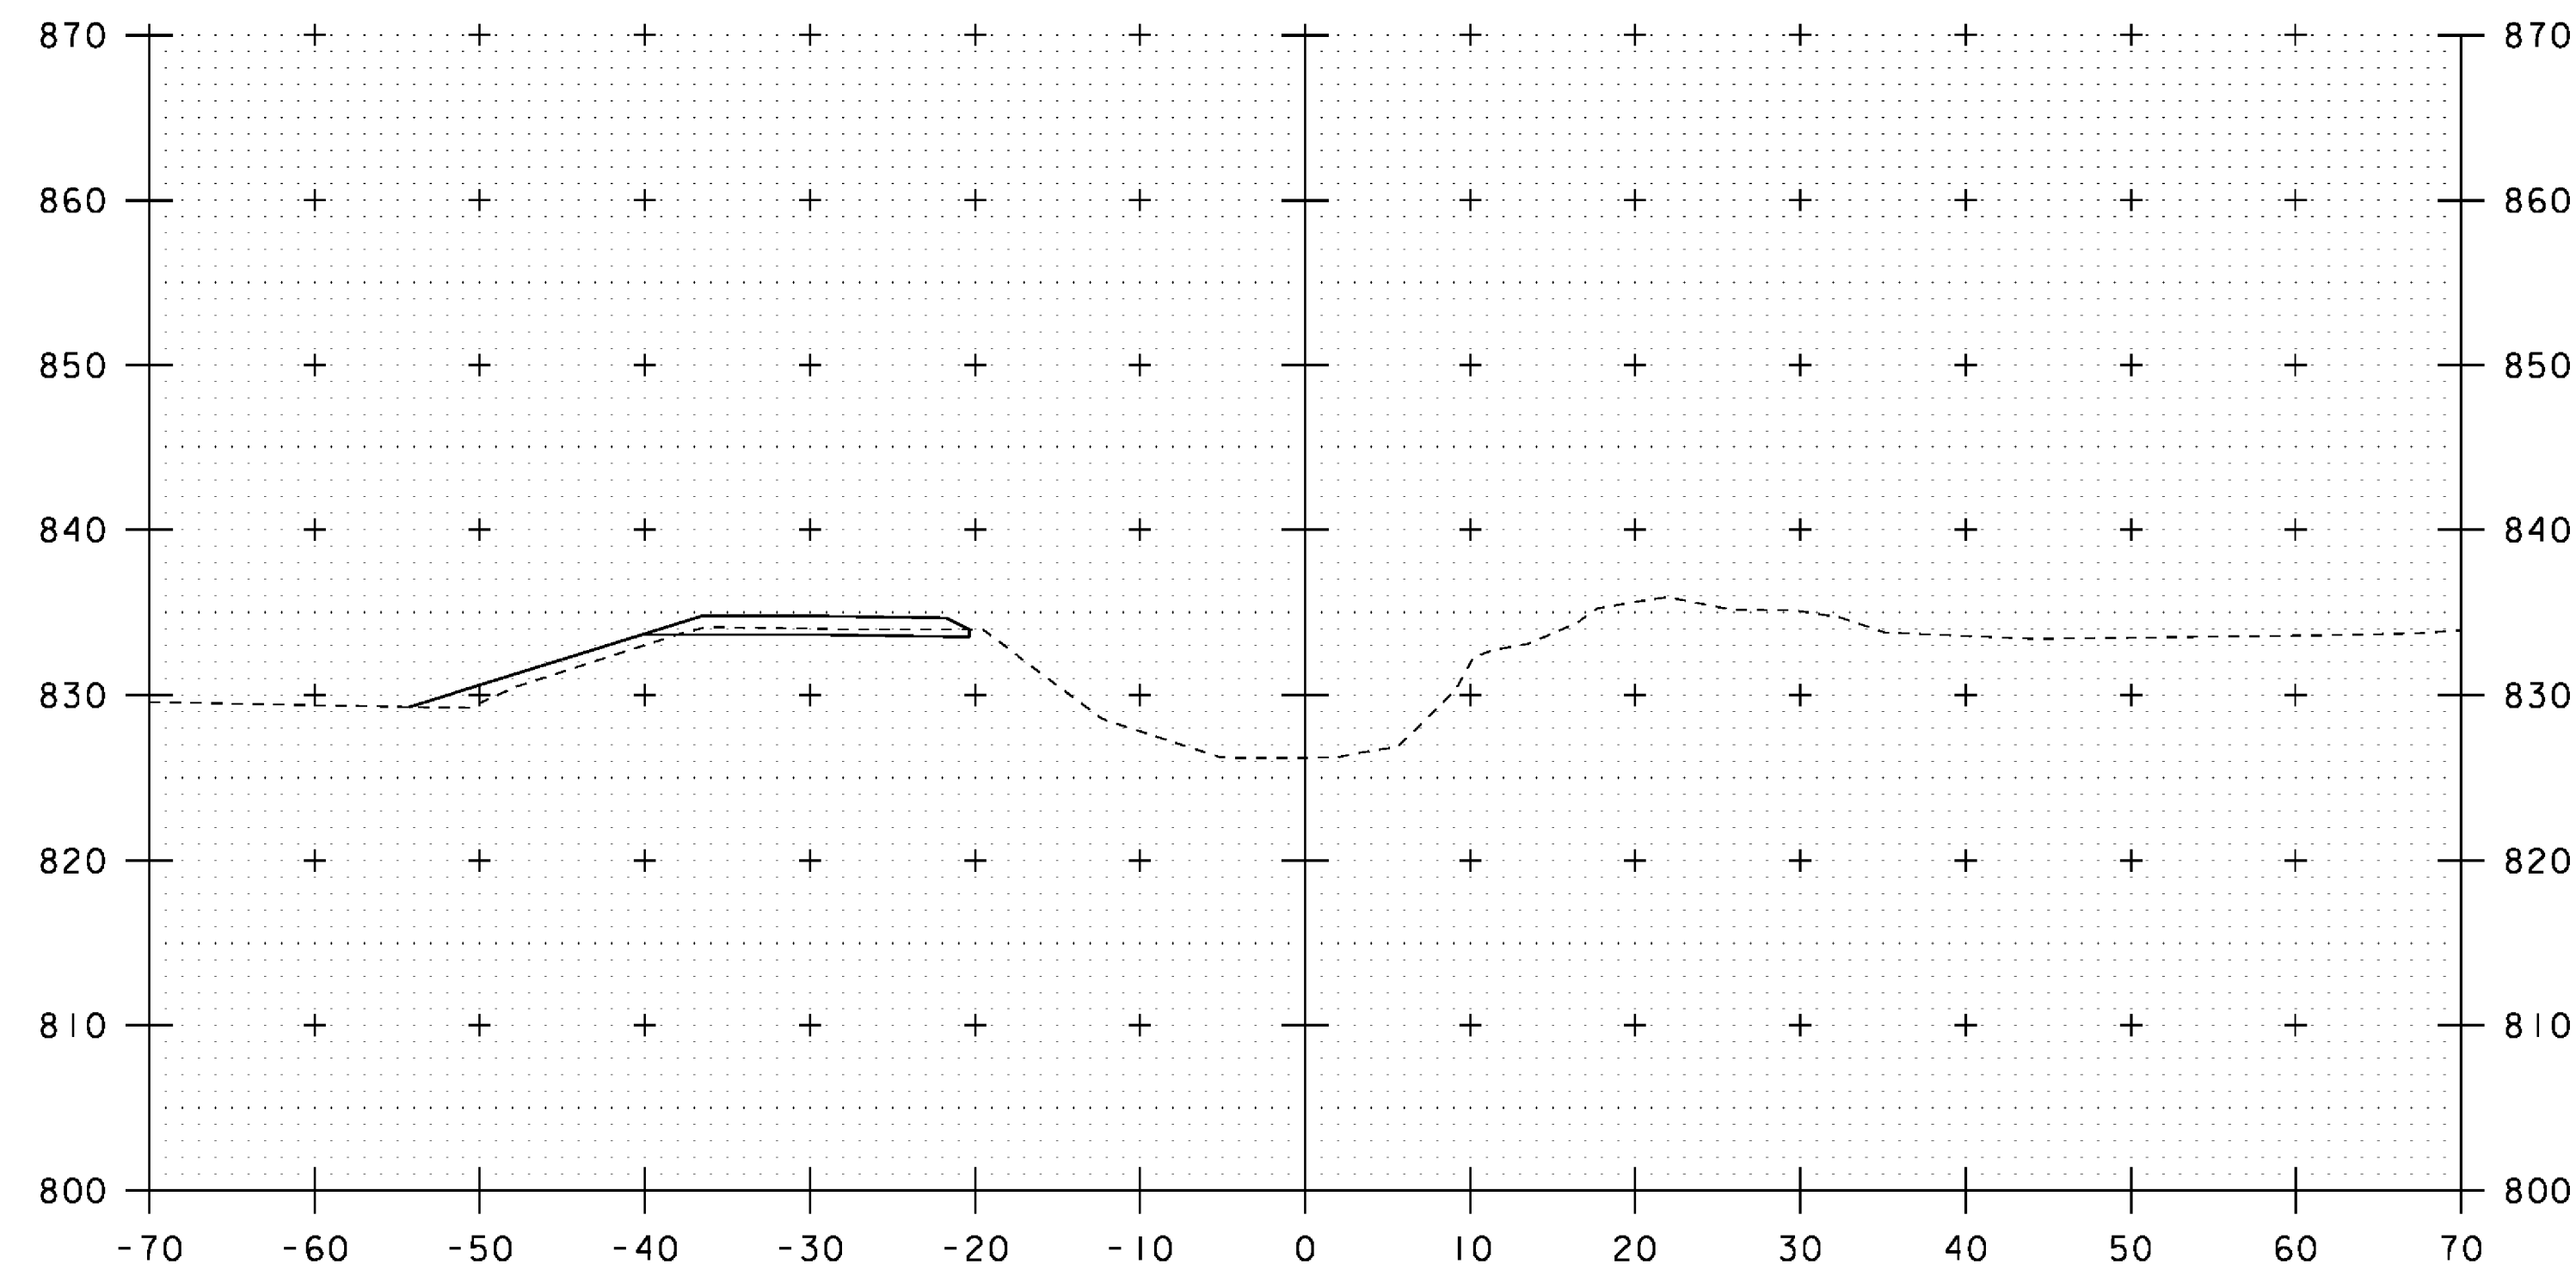

10+80 NOTE: REVISED SHEET FOR POST IRENE

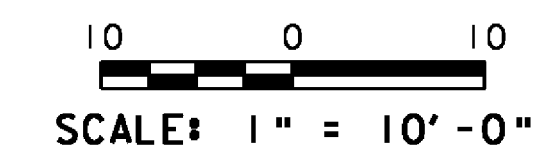

STA. 10+60 TO STA. 10+90

PROJECT NAME: PITTSFIELD-STOCKBRIDGE	PLOT DATE: 27-OCT-2011
PROJECT NUMBER: STP 022-1(22)S	DRAWN BY: G. ROY
FILE NAME: s00b122xsl.dgn	CHECKED BY: R. YOUNG
PROJECT LEADER: C. P. WILLIAMS	SHEET 38A OF 41
DESIGNED BY: G. ROY	
CHANNEL CROSS SECTIONS (1A)	