


NOTE: SEE REVISED SHEET
DATED 27-OCT-2011
FOR POST IRENE REVISIONS

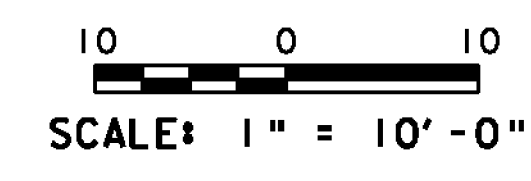

STA. 11+00 TO STA. 11+30

PROJECT NAME: PITTSFIELD-STOCKBRIDGE	PLOT DATE: 02-SEP-2011
PROJECT NUMBER: STP 022-1(22)S	DRAWN BY: G. ROY
FILE NAME: s00b122xsl.dgn	CHECKED BY: R. YOUNG
PROJECT LEADER: C. P. WILLIAMS	SHEET 39 OF 41
DESIGNED BY: G. ROY	CHANNEL CROSS SECTIONS (1)