


11+50


11+70

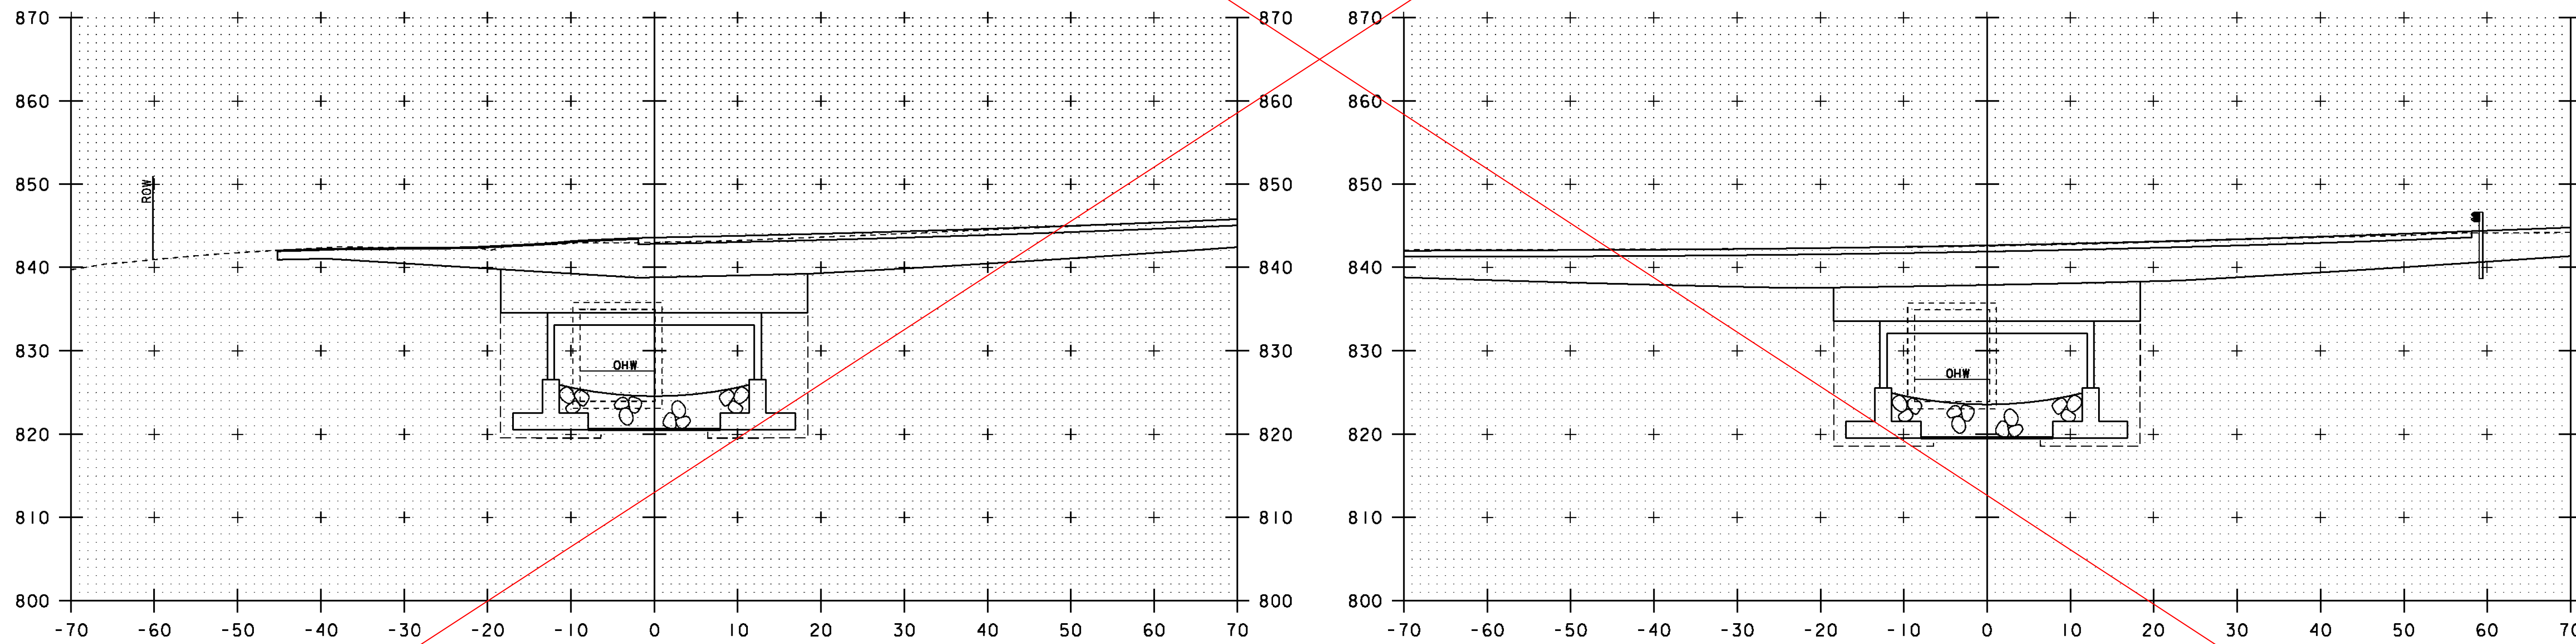

11+40

11+60

NOTE: SEE REVISED SHEET
 DATED 27-OCT-2011
 FOR POST IRENE REVISIONS

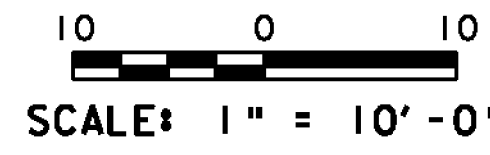

STA. 11+40 TO STA. 11+70

PROJECT NAME:	PITTSFIELD-STOCKBRIDGE	PLOT DATE:	02-SEP-2011
PROJECT NUMBER:	STP 022-1(22)S	DRAWN BY:	G. ROY
FILE NAME:	s00b122xsl.dgn	CHECKED BY:	R. YOUNG
PROJECT LEADER:	C. P. WILLIAMS	SHEET	40 OF 41
DESIGNED BY:	G. ROY	CHANNEL CROSS SECTIONS (2)	