

COLD PLANING - BIT. CONC. PAVEMENT

10+64.5 LT. - 14+00.0 LT.

REMOVING AND RESETTING CURB INSTALLED NEW GRANITE CURB PER CO #4

10+13.5 RT. - 10+28.5 RT.
 10+13.5 LT. - 10+28.5 LT.
 10+64.5 LT. - 14+00.0 LT.

PORTLAND CEMENT CONCRETE SIDEWALK, 5 INCH


10+13.5 RT. - 10+28.5 RT.
 10+13.5 LT. - 10+28.5 LT.
 10+64.5 LT. - 14+00.0 LT.

CONCRETE FACE EXISTING CONCRETE RETAINING WALL


10+72.0 LT. - 10+90.0 LT.

CONCRETE FACE EXISTING METAL BIN RETAINING WALL

10+90.0 LT. - 14+00.0 LT.

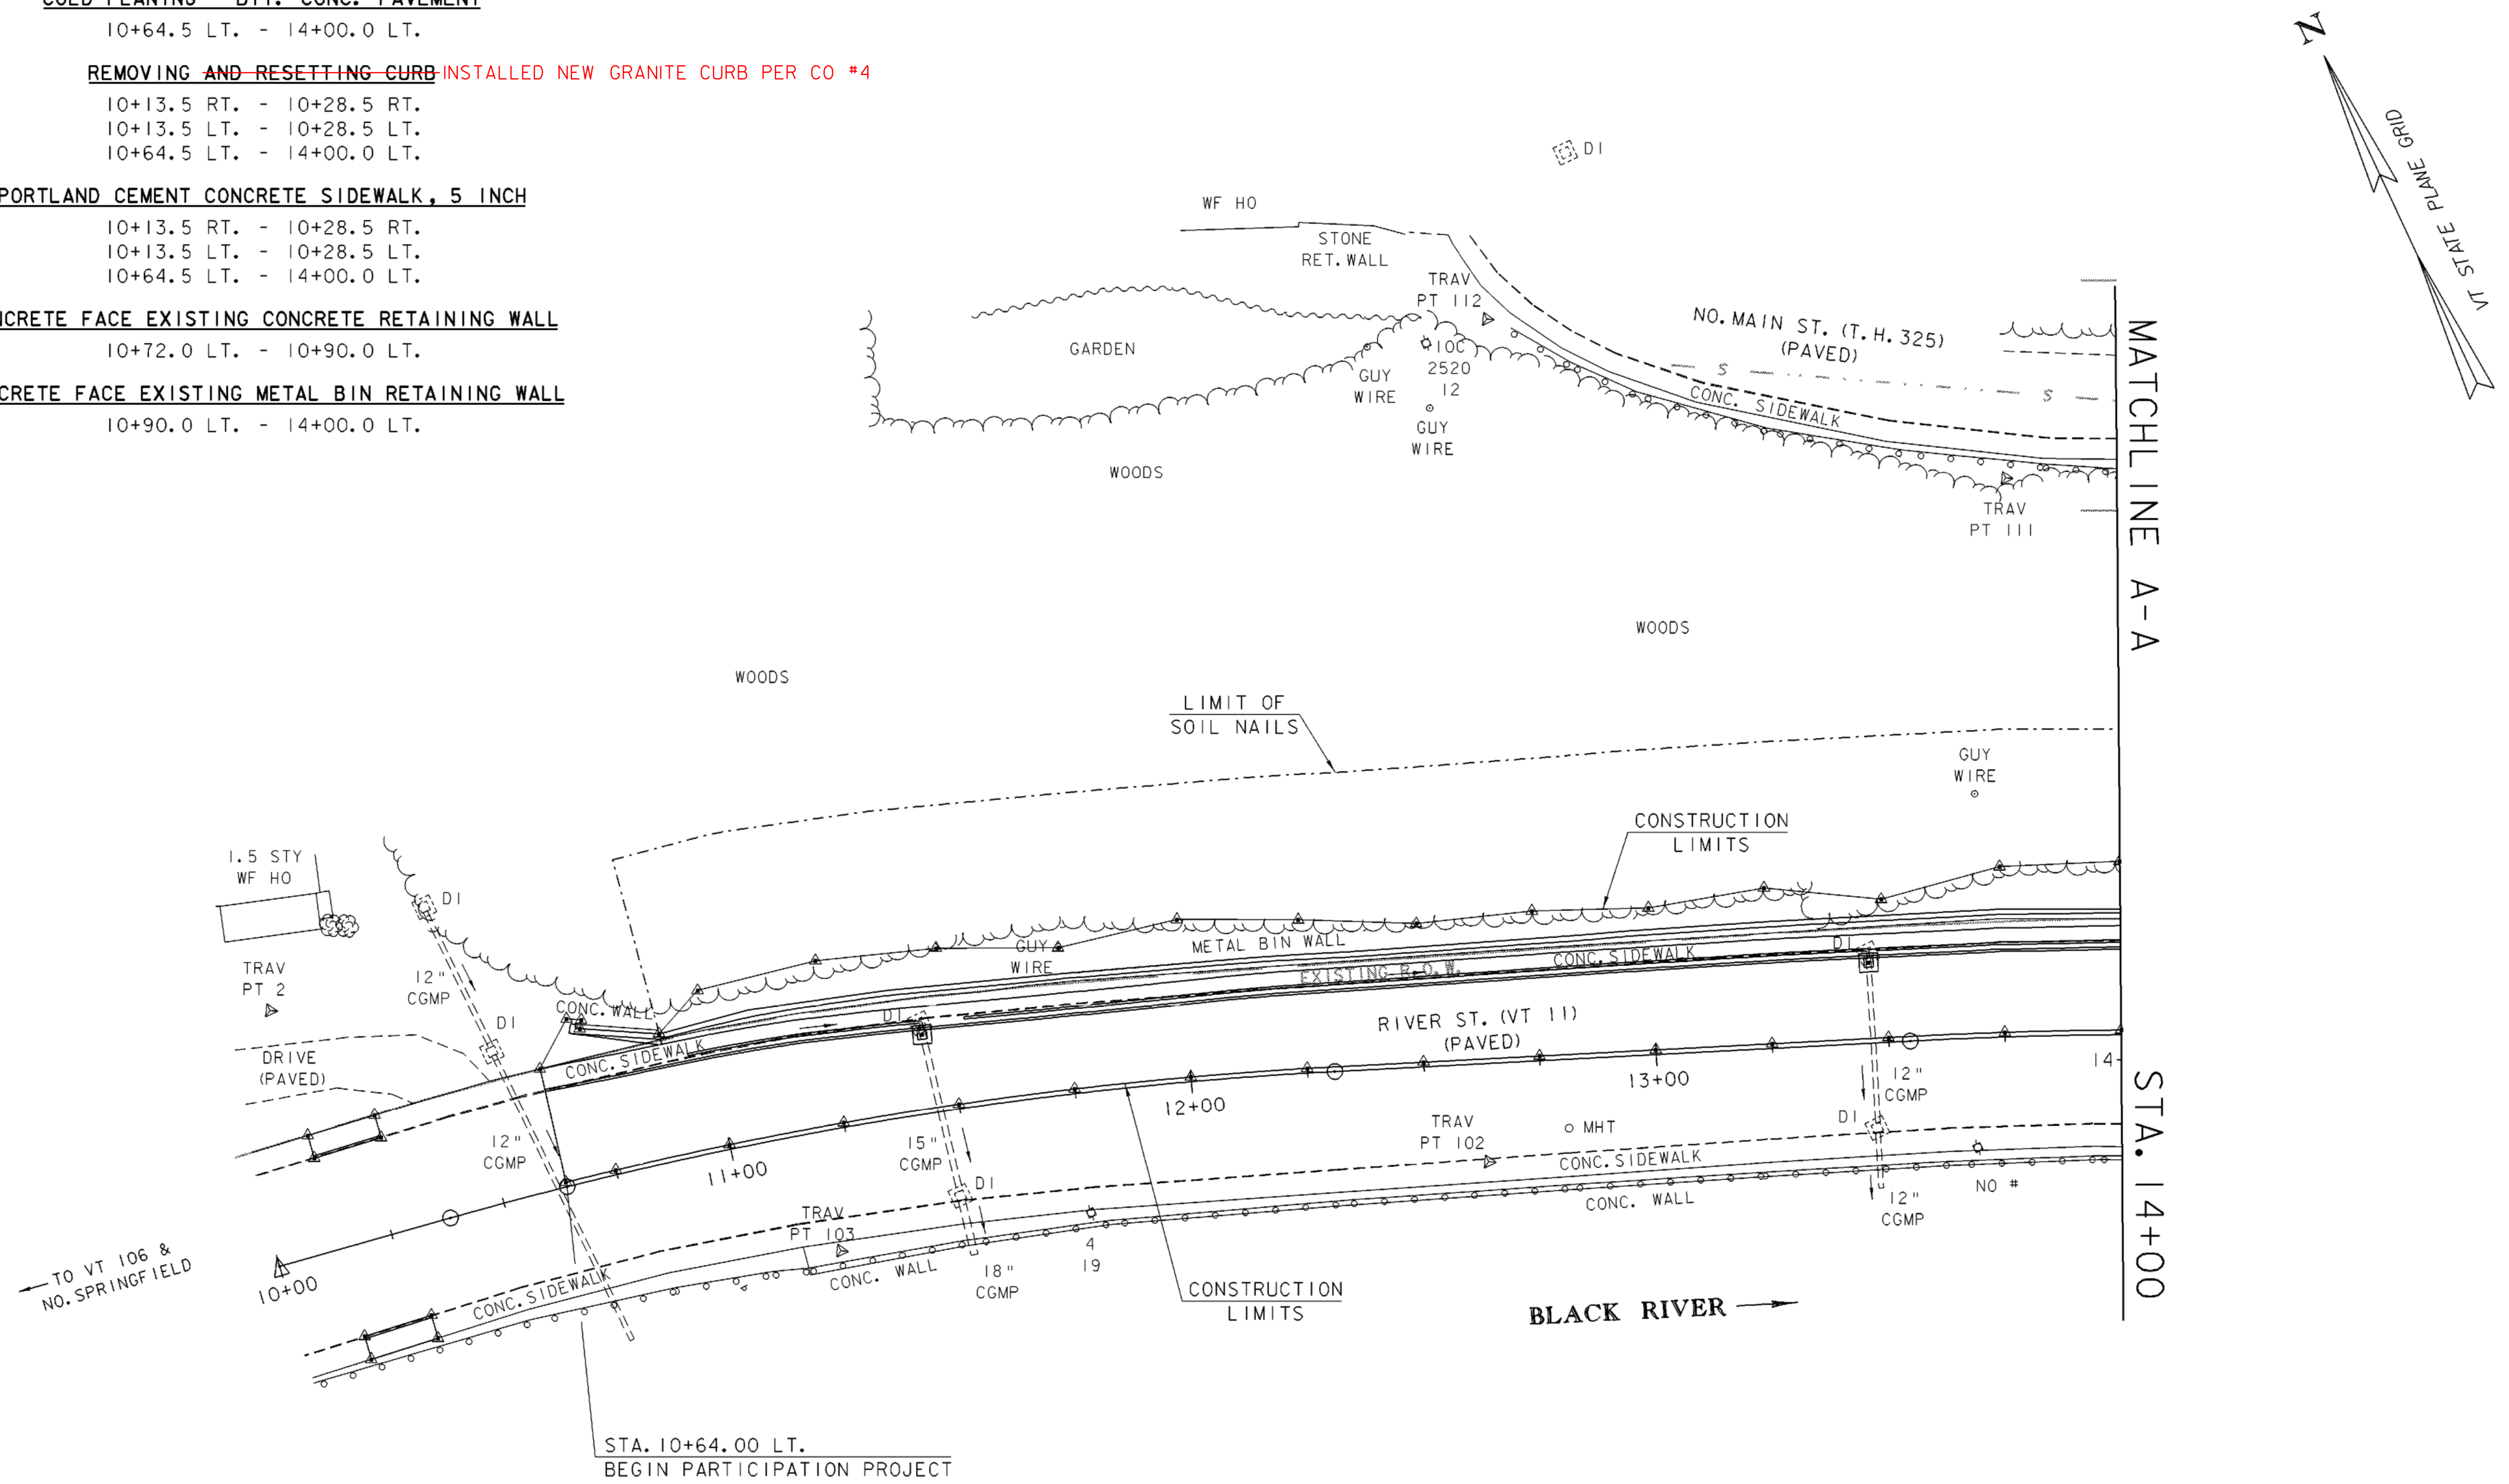

LAYOUT SHEET (1)

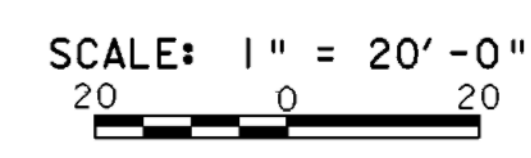

PROJECT NAME:	SPRINGFIELD	FILE NAME:	00b124\Structures\sbl24101.I	PLOT DATE:	17-AUG-2004
PROJECT NUMBER:	STP 016-2 (10)S	PROJECT MANAGER:	R. WHITCOMB	DRAWN BY:	G. ROY
		DESIGNED BY:	G. ROY	CHECKED BY:	R. WHITCOMB
				SHEET	11 OF 72