


LEGEND

- INDICATES SOIL NAIL
- ⊙ INDICATES SOIL NAIL TO BE PROOF TESTED
- ⊕ INDICATES LOCATION OF VERIFICATION TEST OF SACRIFICIAL SOIL NAIL

NOTES:

1. ALL DIMENSIONS ARE HORIZONTAL OR VERTICAL AND GIVEN TO THE FRONT FACE OF EXISTING METAL BIN WALLS UNLESS OTHERWISE NOTED ON THE PLANS.
2. INVERT ELEVATIONS ARE SHOWN FOR THE 6" DIA. PVC PIPE AT THE 4" DIA. PVC PIPE LOCATIONS.

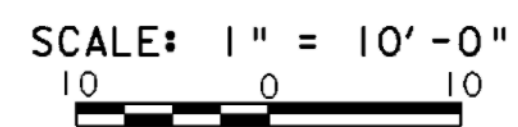

VT II BIN WALL PROFILE (1)

PROJECT NAME:	SPRINGFIELD	FILE NAME:	00b124/Structures/sb124pfl1	PLOT DATE:	17-AUG-2004
PROJECT NUMBER:	STP 016-2 (10)S	PROJECT MANAGER:	R. WHITCOMB	DRAWN BY:	G. ROY
		DESIGNED BY:	G. ROY	CHECKED BY:	R. WHITCOMB
				SHEET	13 OF 72