


HOLE NO.	DISTANCE	ELEVATION	NAIL LENGTH	TEST HOLE
49A1	482.5	451.25	30	
49A2	482.5	446.25	25	
49A3	482.5	441.25	20	
49B1	487.5	451.25	30	X
49B2	487.5	446.25	25	
49B3	487.5	441.25	20	
50A1	492.5	451.25	30	
50A2	492.5	446.25	25	
50A3	492.5	441.25	20	
50B1	497.5	451.25	30	
50B2	497.5	446.25	25	
50B3	497.5	441.25	20	
51A1	502.5	451.25	30	
51A2	502.5	446.25	25	
51A3	502.5	441.25	20	
51B1	507.5	451.25	30	
51B2	507.5	446.25	25	
51B3	507.5	441.25	20	
52A1	512.5	451.25	30	
52A2	512.5	446.25	25	
52A3	512.5	441.25	20	
52B1	517.5	451.25	30	
52B2	517.5	446.25	25	
52B3	517.5	441.25	20	
53A1	522.5	451.25	30	
53A2	522.5	446.25	25	X
53A3	522.5	441.25	20	
53B1	527.5	451.25	30	
53B2	527.5	446.25	25	
53B3	527.5	441.25	20	
54A1	532.5	451.25	30	
54A2	532.5	446.25	25	
54A3	532.5	441.25	20	
54B1	537.5	451.25	30	
54B2	537.5	446.25	25	
54B3	537.5	441.25	20	
55A1	542.5	451.25	30	
55A2	542.5	446.25	25	
55A3	542.5	441.25	20	
55B1	547.5	451.25	30	
55B2	547.5	446.25	25	
55B3	547.5	441.25	20	
56A1	552.5	450.75	30	
56A2	552.5	445.75	25	
56A3	552.5	440.75	20	
56B1	557.5	450.75	30	
56B2	557.5	445.75	25	
56B3	557.5	440.75	20	X
57A1	562.5	450.75	30	
57A2	562.5	445.75	25	
57A3	562.5	440.75	20	
57B1	567.5	450.75	30	
57B2	567.5	445.75	25	
57B3	567.5	440.75	20	
58A1	572.5	450.75	30	
58A2	572.5	445.75	25	
58A3	572.5	440.75	20	
58B1	577.5	450.75	30	
58B2	577.5	445.75	25	
58B3	577.5	440.75	20	

HOLE NO.	DISTANCE	ELEVATION	NAIL LENGTH	TEST HOLE
59A1	582.5	450.25	30	
59A2	582.5	445.25	25	
59A3	582.5	440.25	20	
59B1	587.5	449.75	30	X
59B2	587.5	444.75	25	
59B3	587.5	439.75	20	
60A1	592.5	448.75	30	
60A2	592.5	443.75	25	
60A3	592.5	438.75	20	
60B1	597.5	448.25	30	
60B2	597.5	443.25	25	
60B3	597.5	438.25	20	

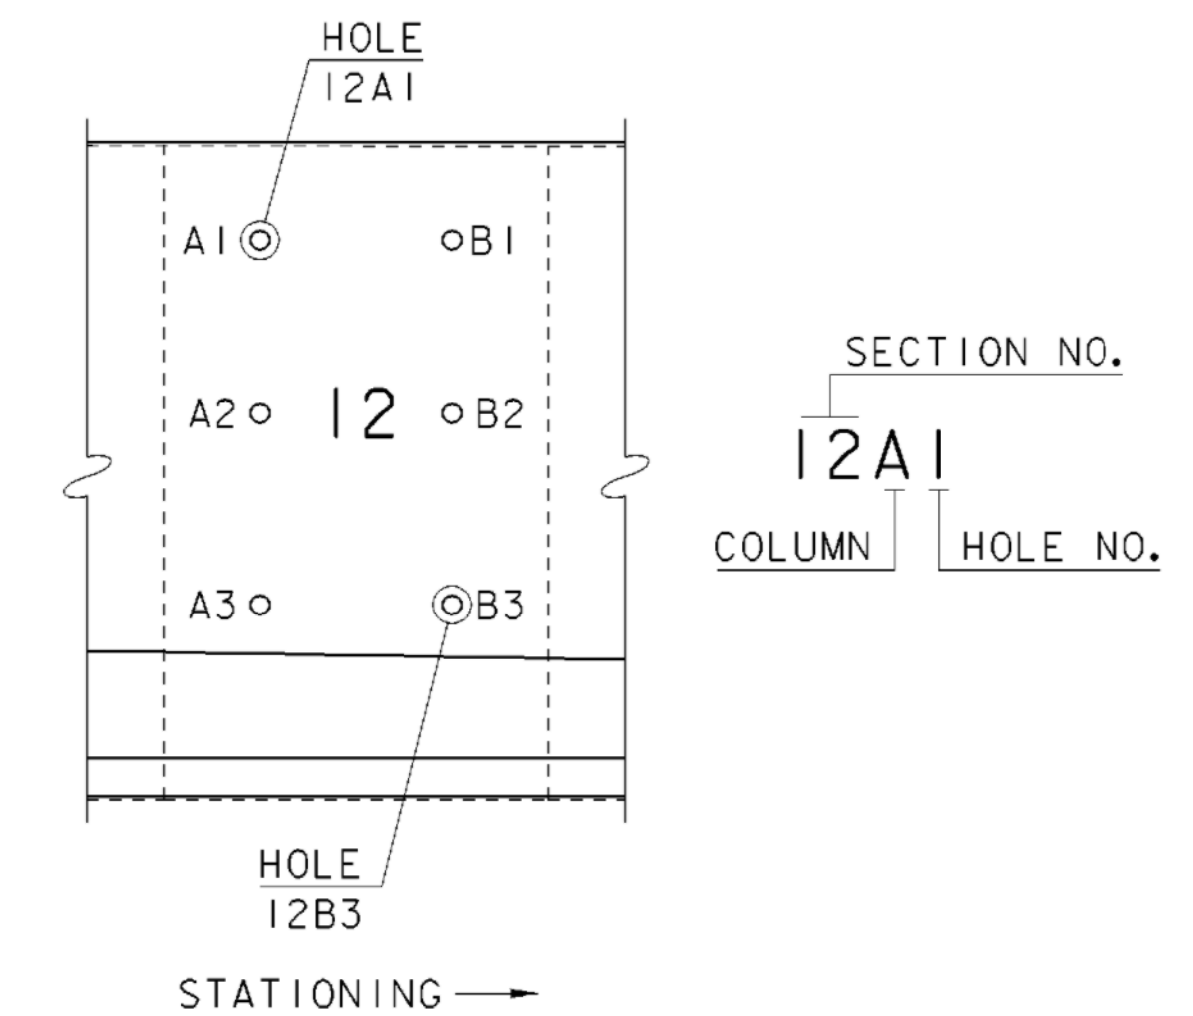

**HOLE NOMENCLATURE**

**NOTES:**

DISTANCES ARE MEASURED FROM BEGINNING OF EXISTING METAL BIN WALL AT STATION 10+90.0 LT.

ELEVATIONS GIVEN ARE AT CENTER OF SOIL NAIL AT FRONT FACE OF EXISTING METAL BIN WALL.

**HOLE STATIONS & ELEVATIONS (2)**

PROJECT NAME:	SPRINGFIELD	FILE NAME:	00b124/Structures/sb124hse2.1	PLOT DATE:	17-AUG-2004
PROJECT NUMBER:	STP 016-2 (10)S	PROJECT MANAGER:	R. WHITCOMB	DRAWN BY:	G. ROY
		DESIGNED BY:	G. ROY	CHECKED BY:	R. WHITCOMB
				SHEET	16 OF 72

SEE NOTE ON PREVIOUS PAGE REGARDING SOIL NAILS