
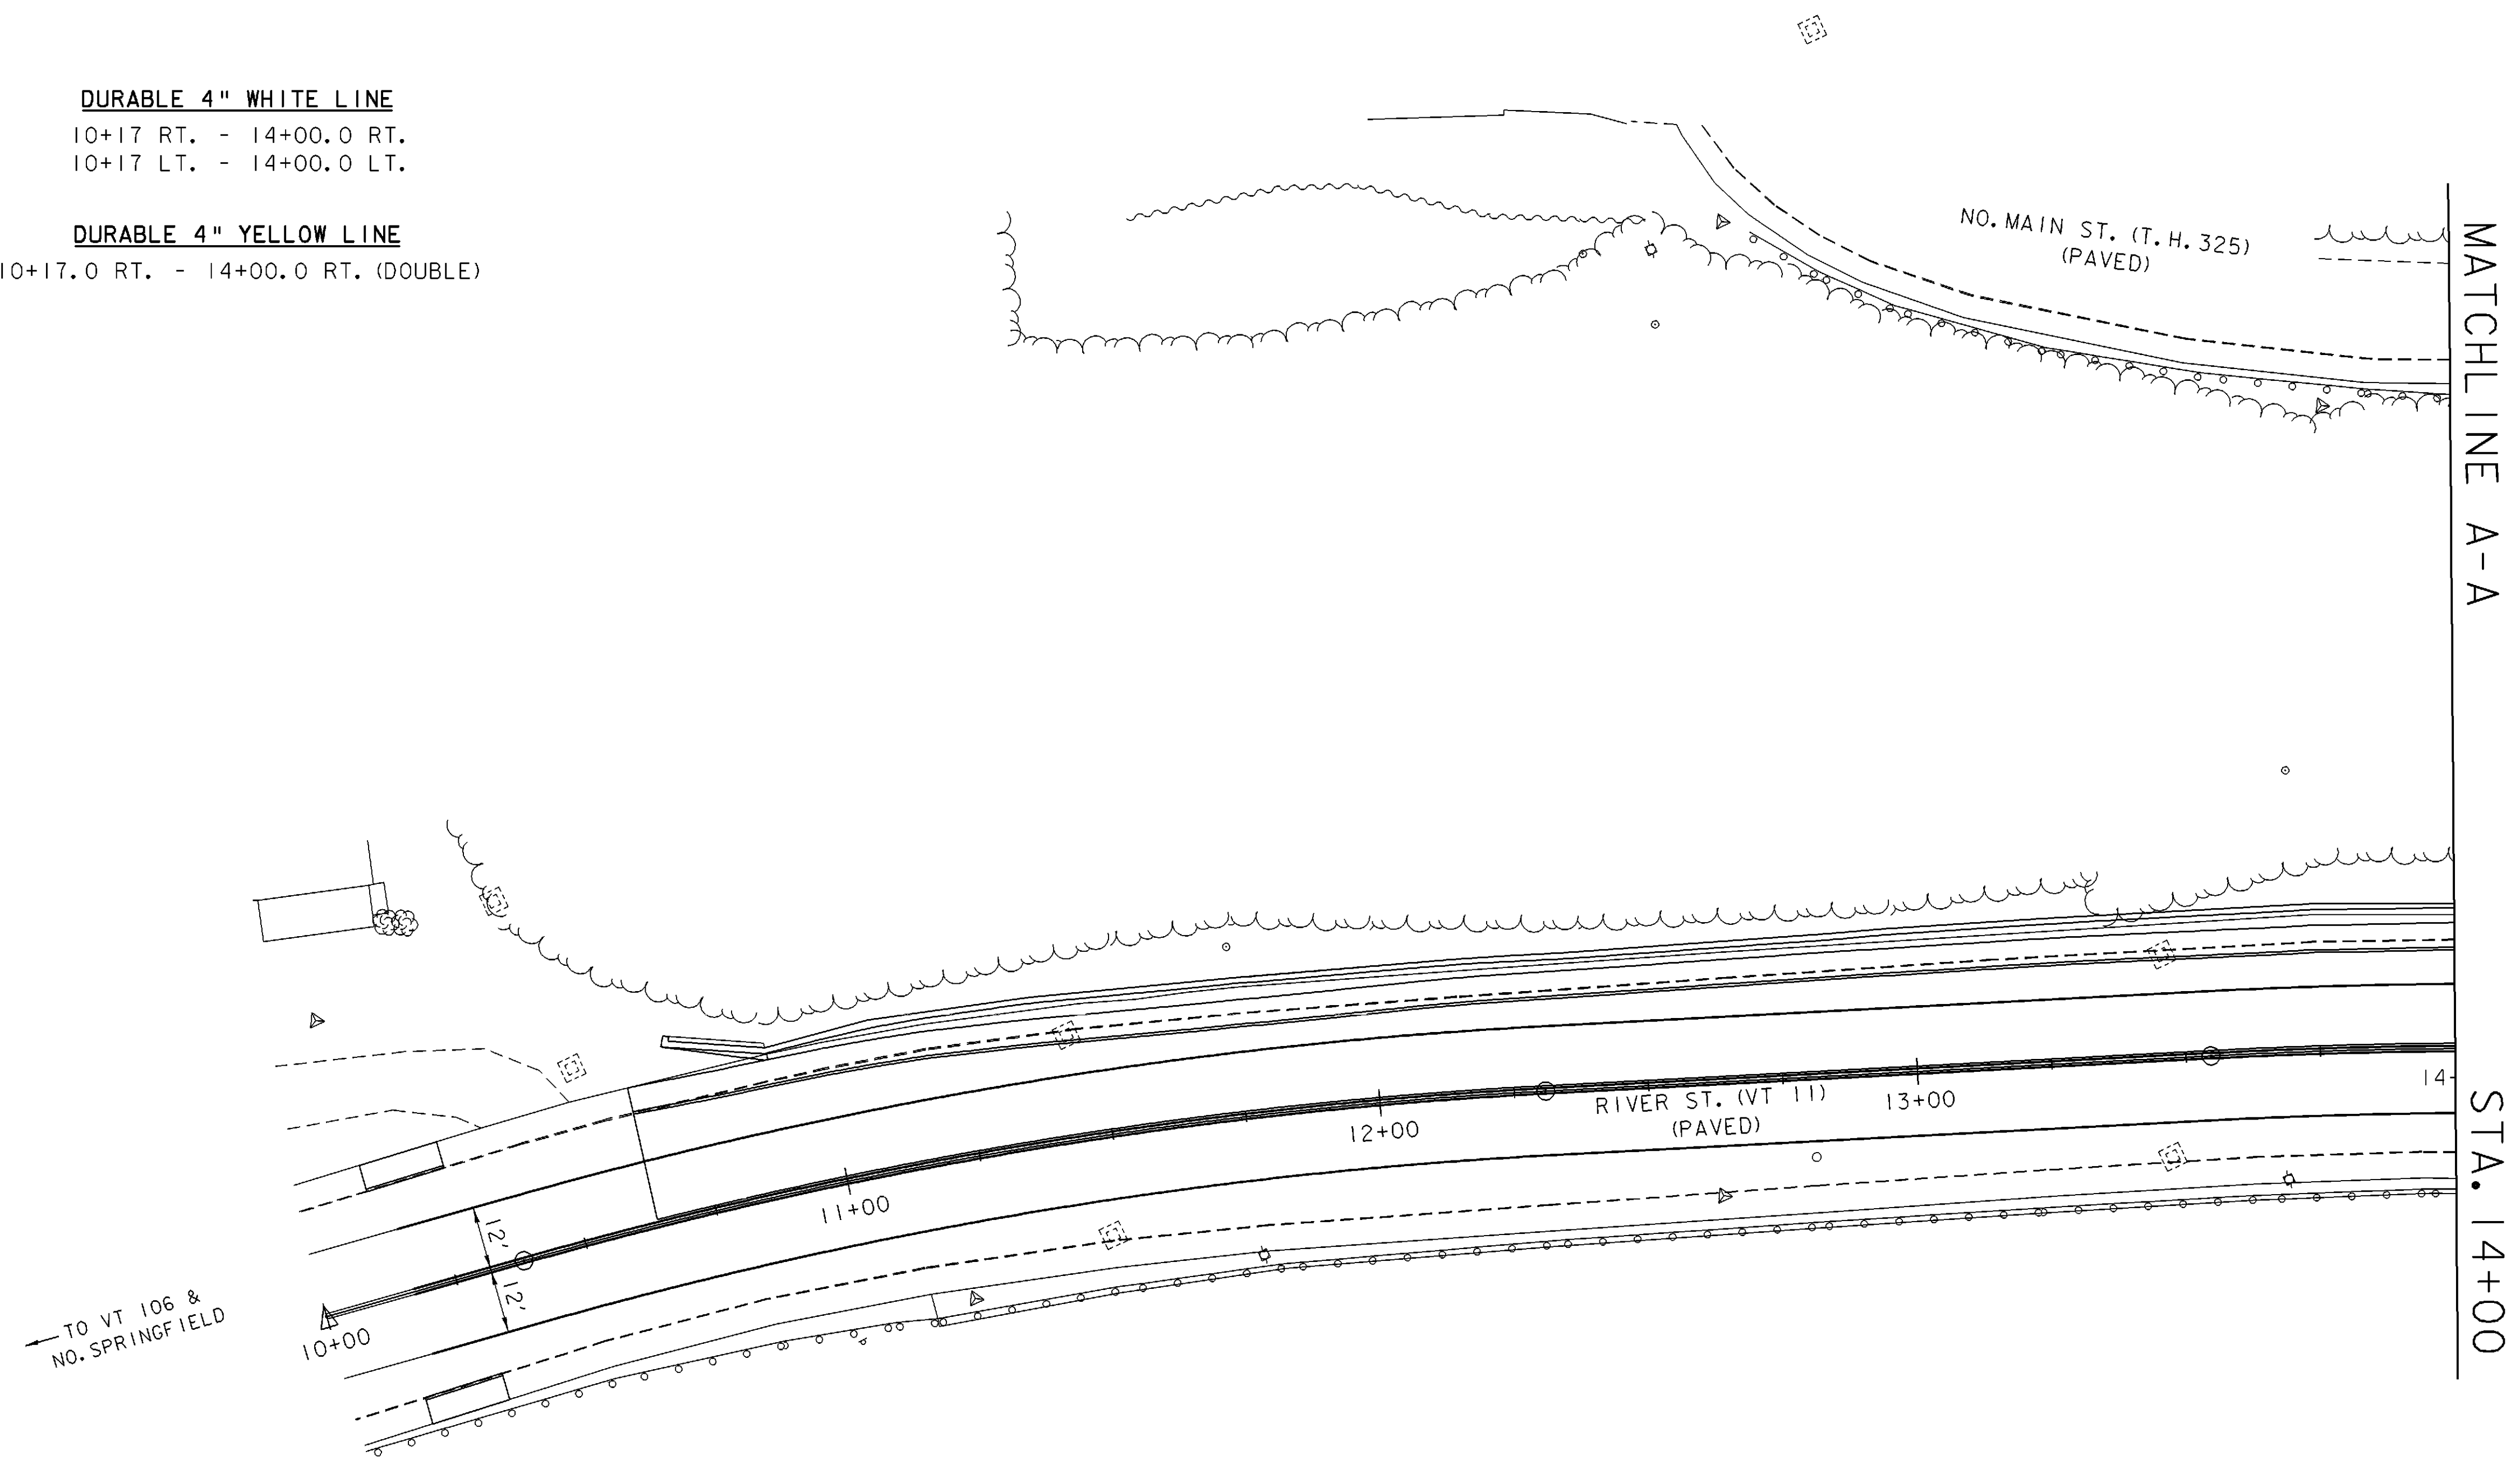


**LEGEND**  
 S — SALVAGE  
 N — NEW

**DURABLE 4" WHITE LINE**  
 10+17 RT. - 14+00.0 RT.  
 10+17 LT. - 14+00.0 LT.

**DURABLE 4" YELLOW LINE**  
 10+17.0 RT. - 14+00.0 RT. (DOUBLE)

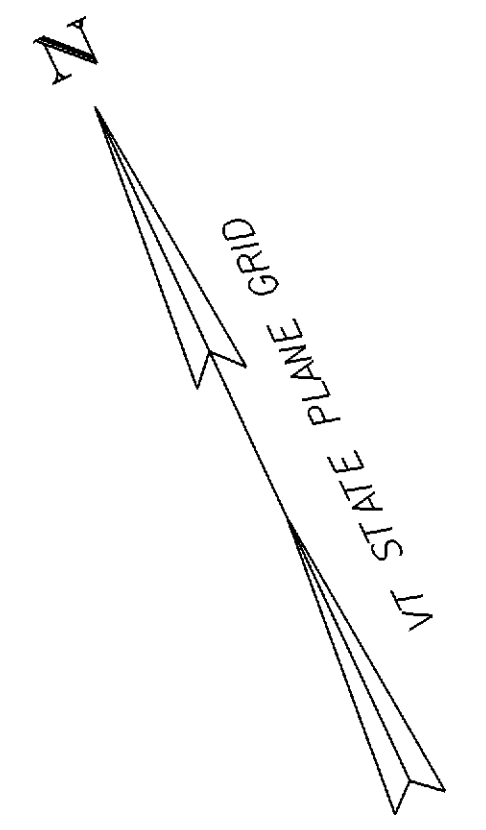

**TRAFFIC CONTROL SHEET (1)**

SCALE: 1" = 20'-0"  
 20 0 20

PROJECT NAME: SPRINGFIELD	PLOT DATE: 17-AUG-2004
PROJECT NUMBER: STP 016-2 (10)S	DRAWN BY: G. ROY
FILE NAME: 00b124\Structures\sb124+01.i	CHECKED BY: R. WHITCOMB
DESIGNED BY: G. ROY	SHEET 19 OF 72