


### DRAINAGE PROFILE ALONG T.H.325 (NORTH MAIN ST.)

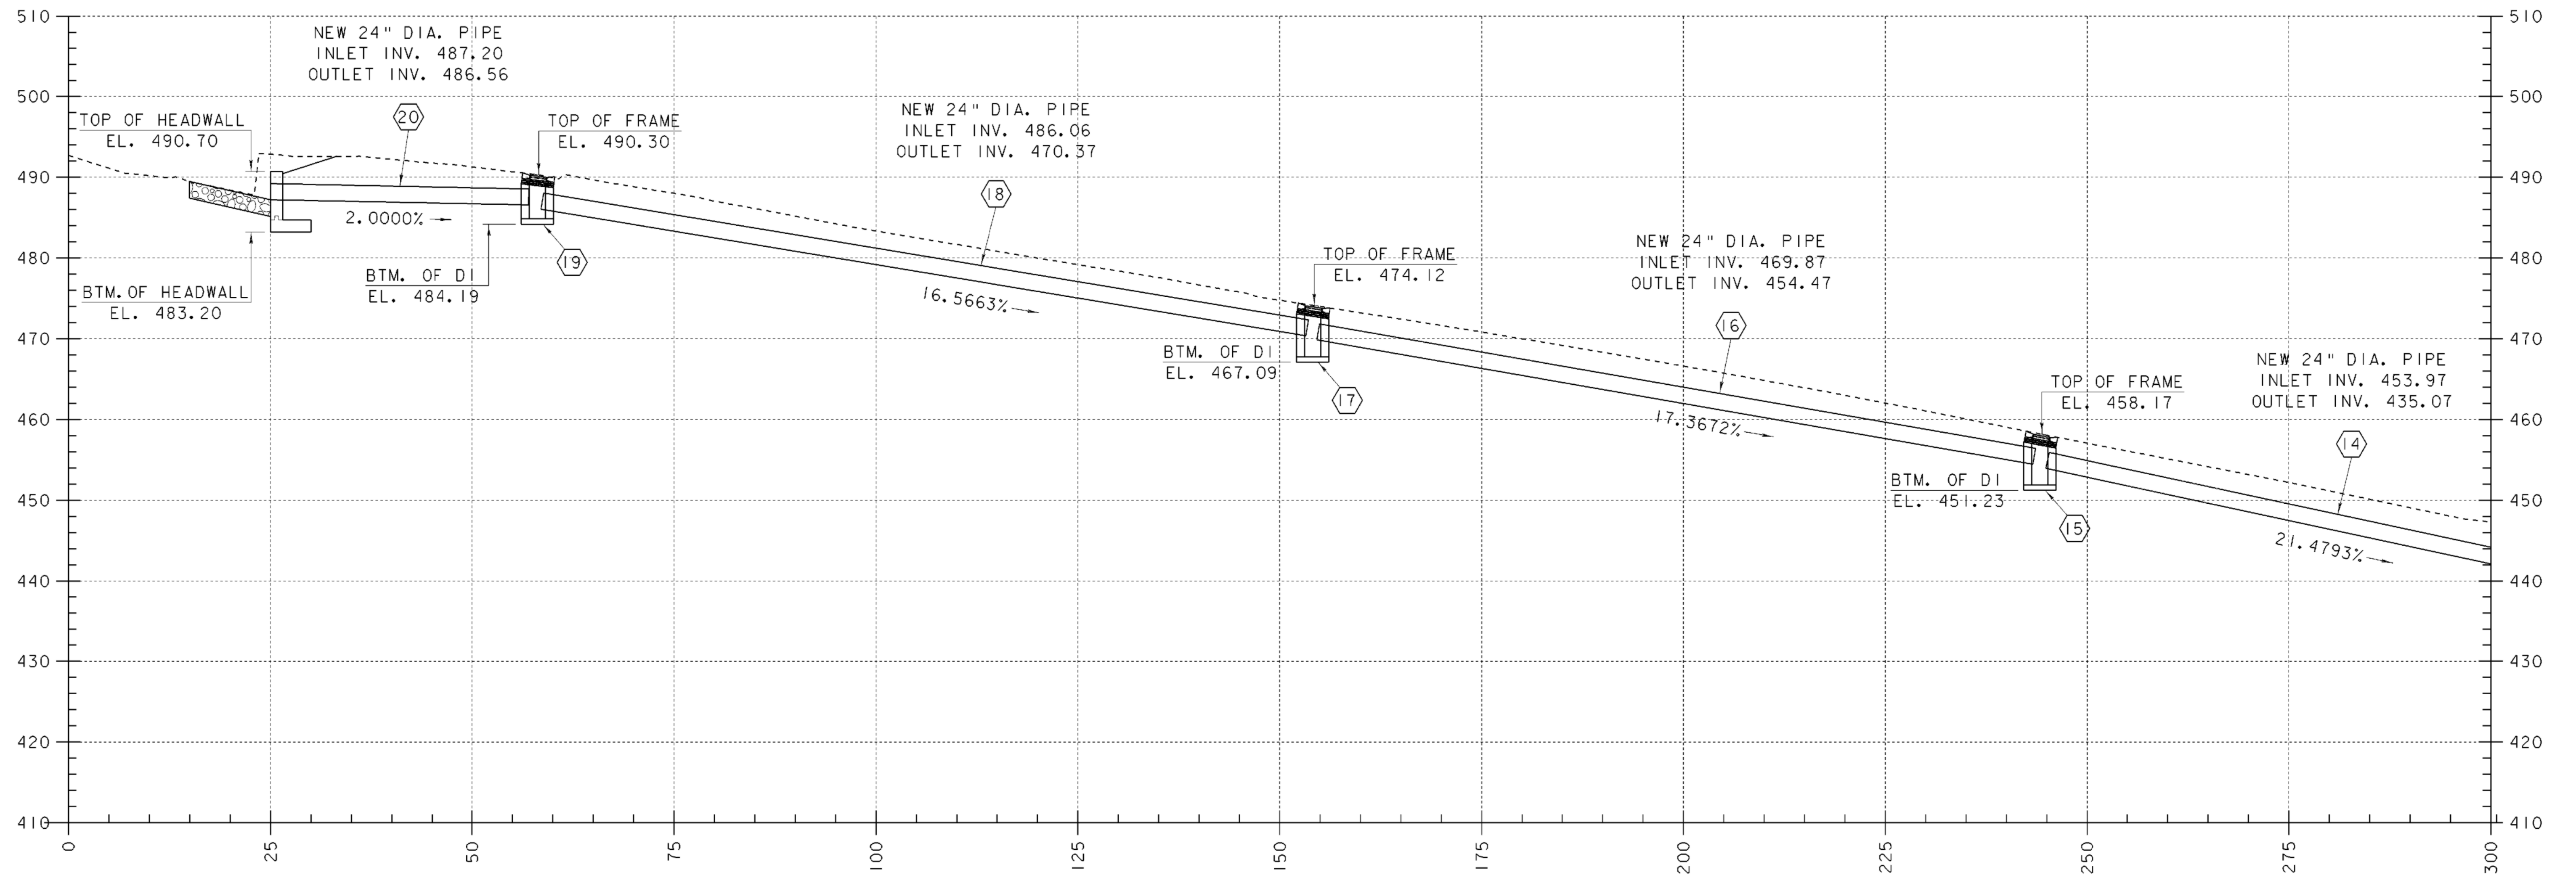

SEE AS-BUILT NOTE  
ON SHEET 21 OF 72  
SEE DRAINAGE DETAIL SHEET 25  
FOR DRAINAGE PIPE INFORMATION

### DRAINAGE PIPE PROFILES (1)

  
 SCALE: 1" = 10'-0"

PROJECT NAME: SPRINGFIELD	
PROJECT NUMBER: STP 016-2 (10)S	
FILE NAME: 00b124/Structures/sb124dpl1	PLOT DATE: 17-AUG-2004
PROJECT MANAGER: R. WHITCOMB	DRAWN BY: G. ROY
DESIGNED BY: G. ROY	CHECKED BY: R. WHITCOMB
SHEET 23 OF 72	