


SEE REVISED ELEVATIONS IN  
VALUE ENGINEERING PLAN SET.

### WALL ELEVATION (2)

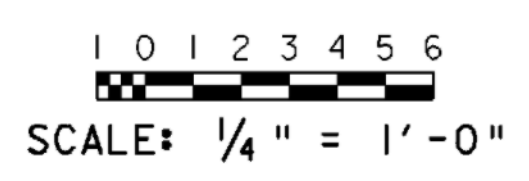

PROJECT NAME:	SPRINGFIELD	PLOT DATE:	17-AUG-2004
PROJECT NUMBER:	STP 016-2 (10)S	DRAWN BY:	G. ROY
FILE NAME:	00b124\structures\sb124we2.1	CHECKED BY:	R. WHITCOMB
DESIGNED BY:	G. ROY	SHEET	46 OF 72