


EXTEND FACING TO TOP OF EXISTING FOOTING

SEE REVISED ELEVATIONS IN VALUE ENGINEERING PLAN SET.

WALL ELEVATION (3)

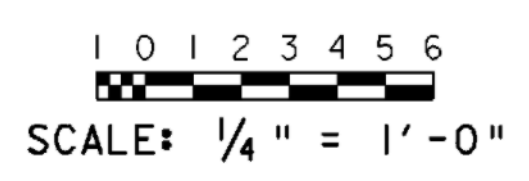

PROJECT NAME:	SPRINGFIELD	FILE NAME:	00b124\structures\sb124we3.1	PLOT DATE:	17-AUG-2004
PROJECT NUMBER:	STP 016-2 (10)S	PROJECT MANAGER:	R. WHITCOMB	DRAWN BY:	G. ROY
		DESIGNED BY:	G. ROY	CHECKED BY:	R. WHITCOMB
					SHEET 47 OF 72