


**SOIL NAIL HEAD AND BIN WALL FACING DETAIL**  
SCALE: 1/2" = 1'-0"

**NOTES:**  
BEARING PLATE IS TO BE INSTALLED DIRECTLY BEHIND REBAR AND HELD IN PLACE BY A NUT LOCATED ON EACH SIDE OF THE BEARING PLATE.

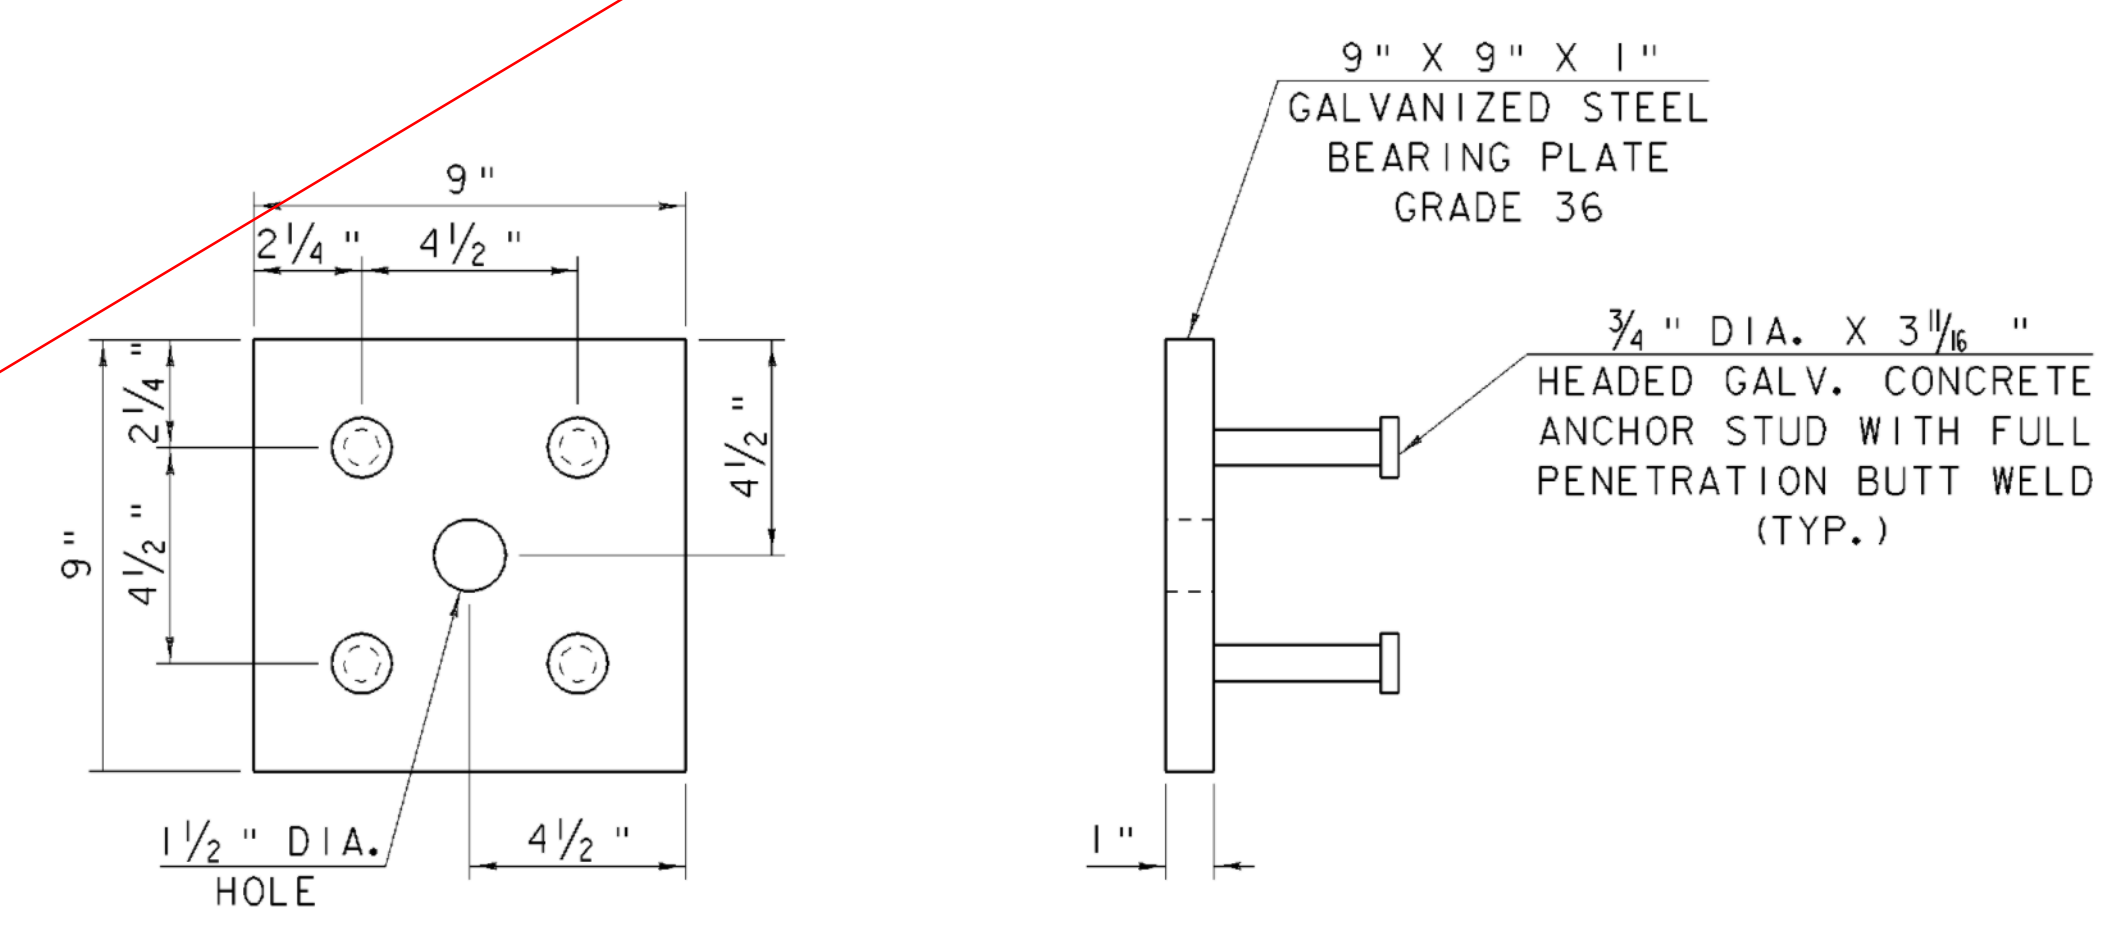

**GALVANIZED BEARING PLATE DETAIL**  
SCALE: 3" = 1'-0"

**SOIL NAIL WALL DETAILS**

PROJECT NAME:	SPRINGFIELD	PLOT DATE:	17-AUG-2004
PROJECT NUMBER:	STP 016-2 (10)S	DRAWN BY:	G. ROY
FILE NAME:	00b124\structures\sb124snwd.i	CHECKED BY:	R. WHITCOMB
DESIGNED BY:	G. ROY	SHEET	48 OF 72