



STA. 10+72.00 LT.
BEGIN PARTICIPATION PROJECT

10+75


10+72.0 LT. - 10+90.0 LT.
CONCRETE FACE EXISTING CONCRETE
RETAINING WALL

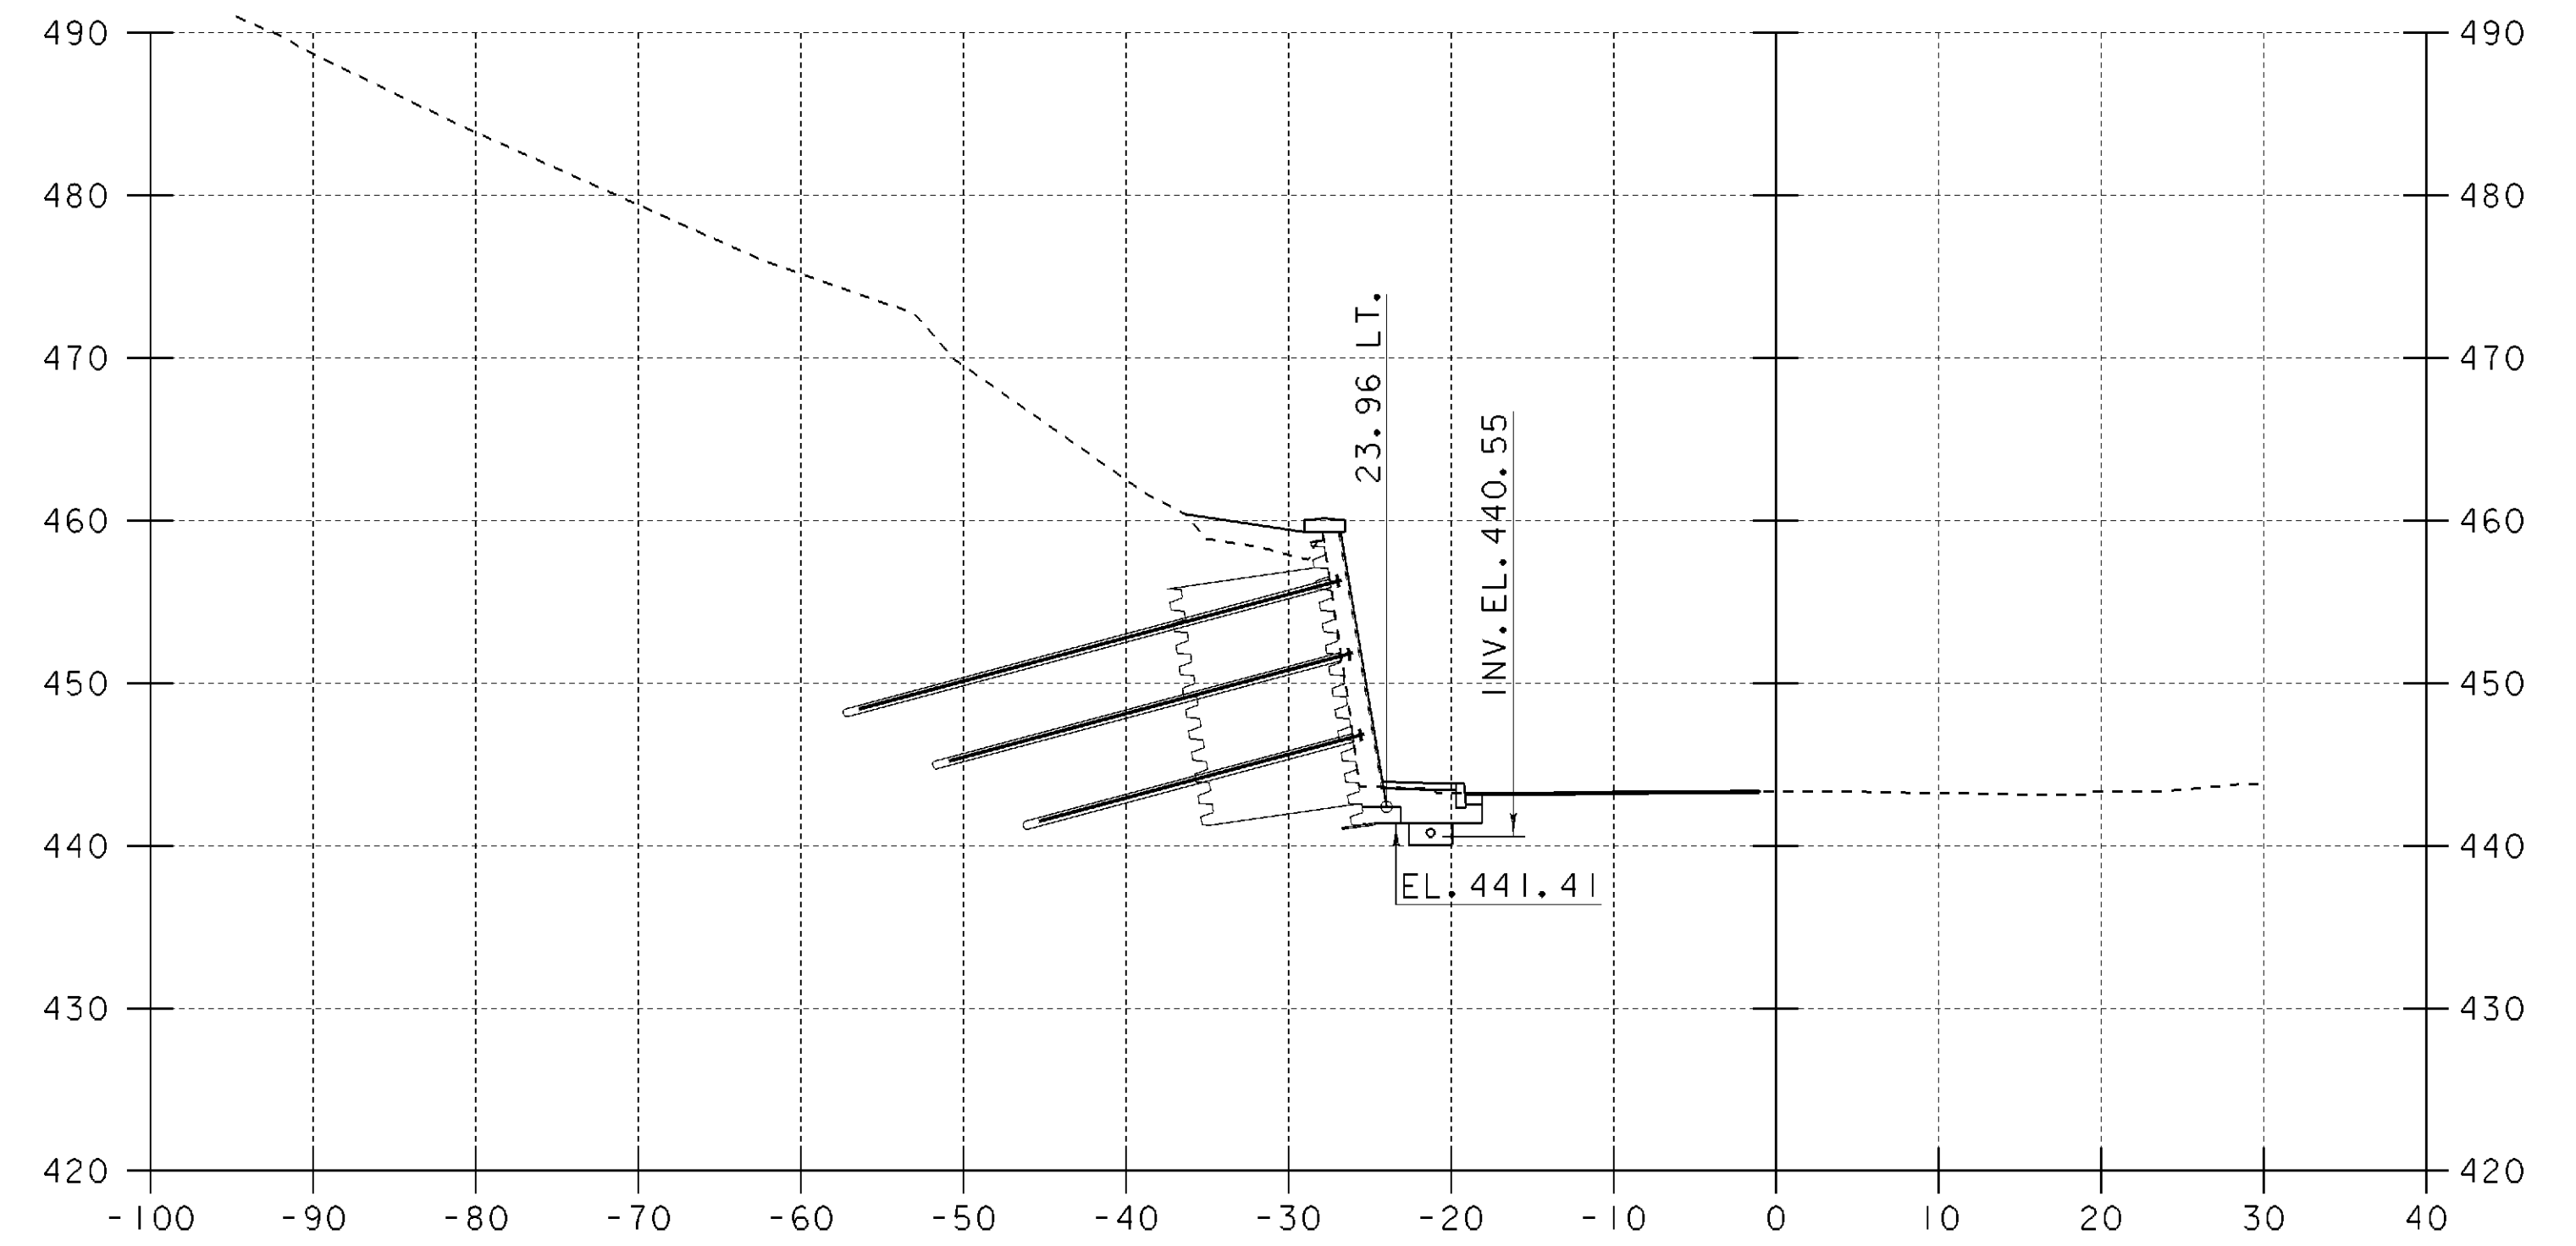

11+25

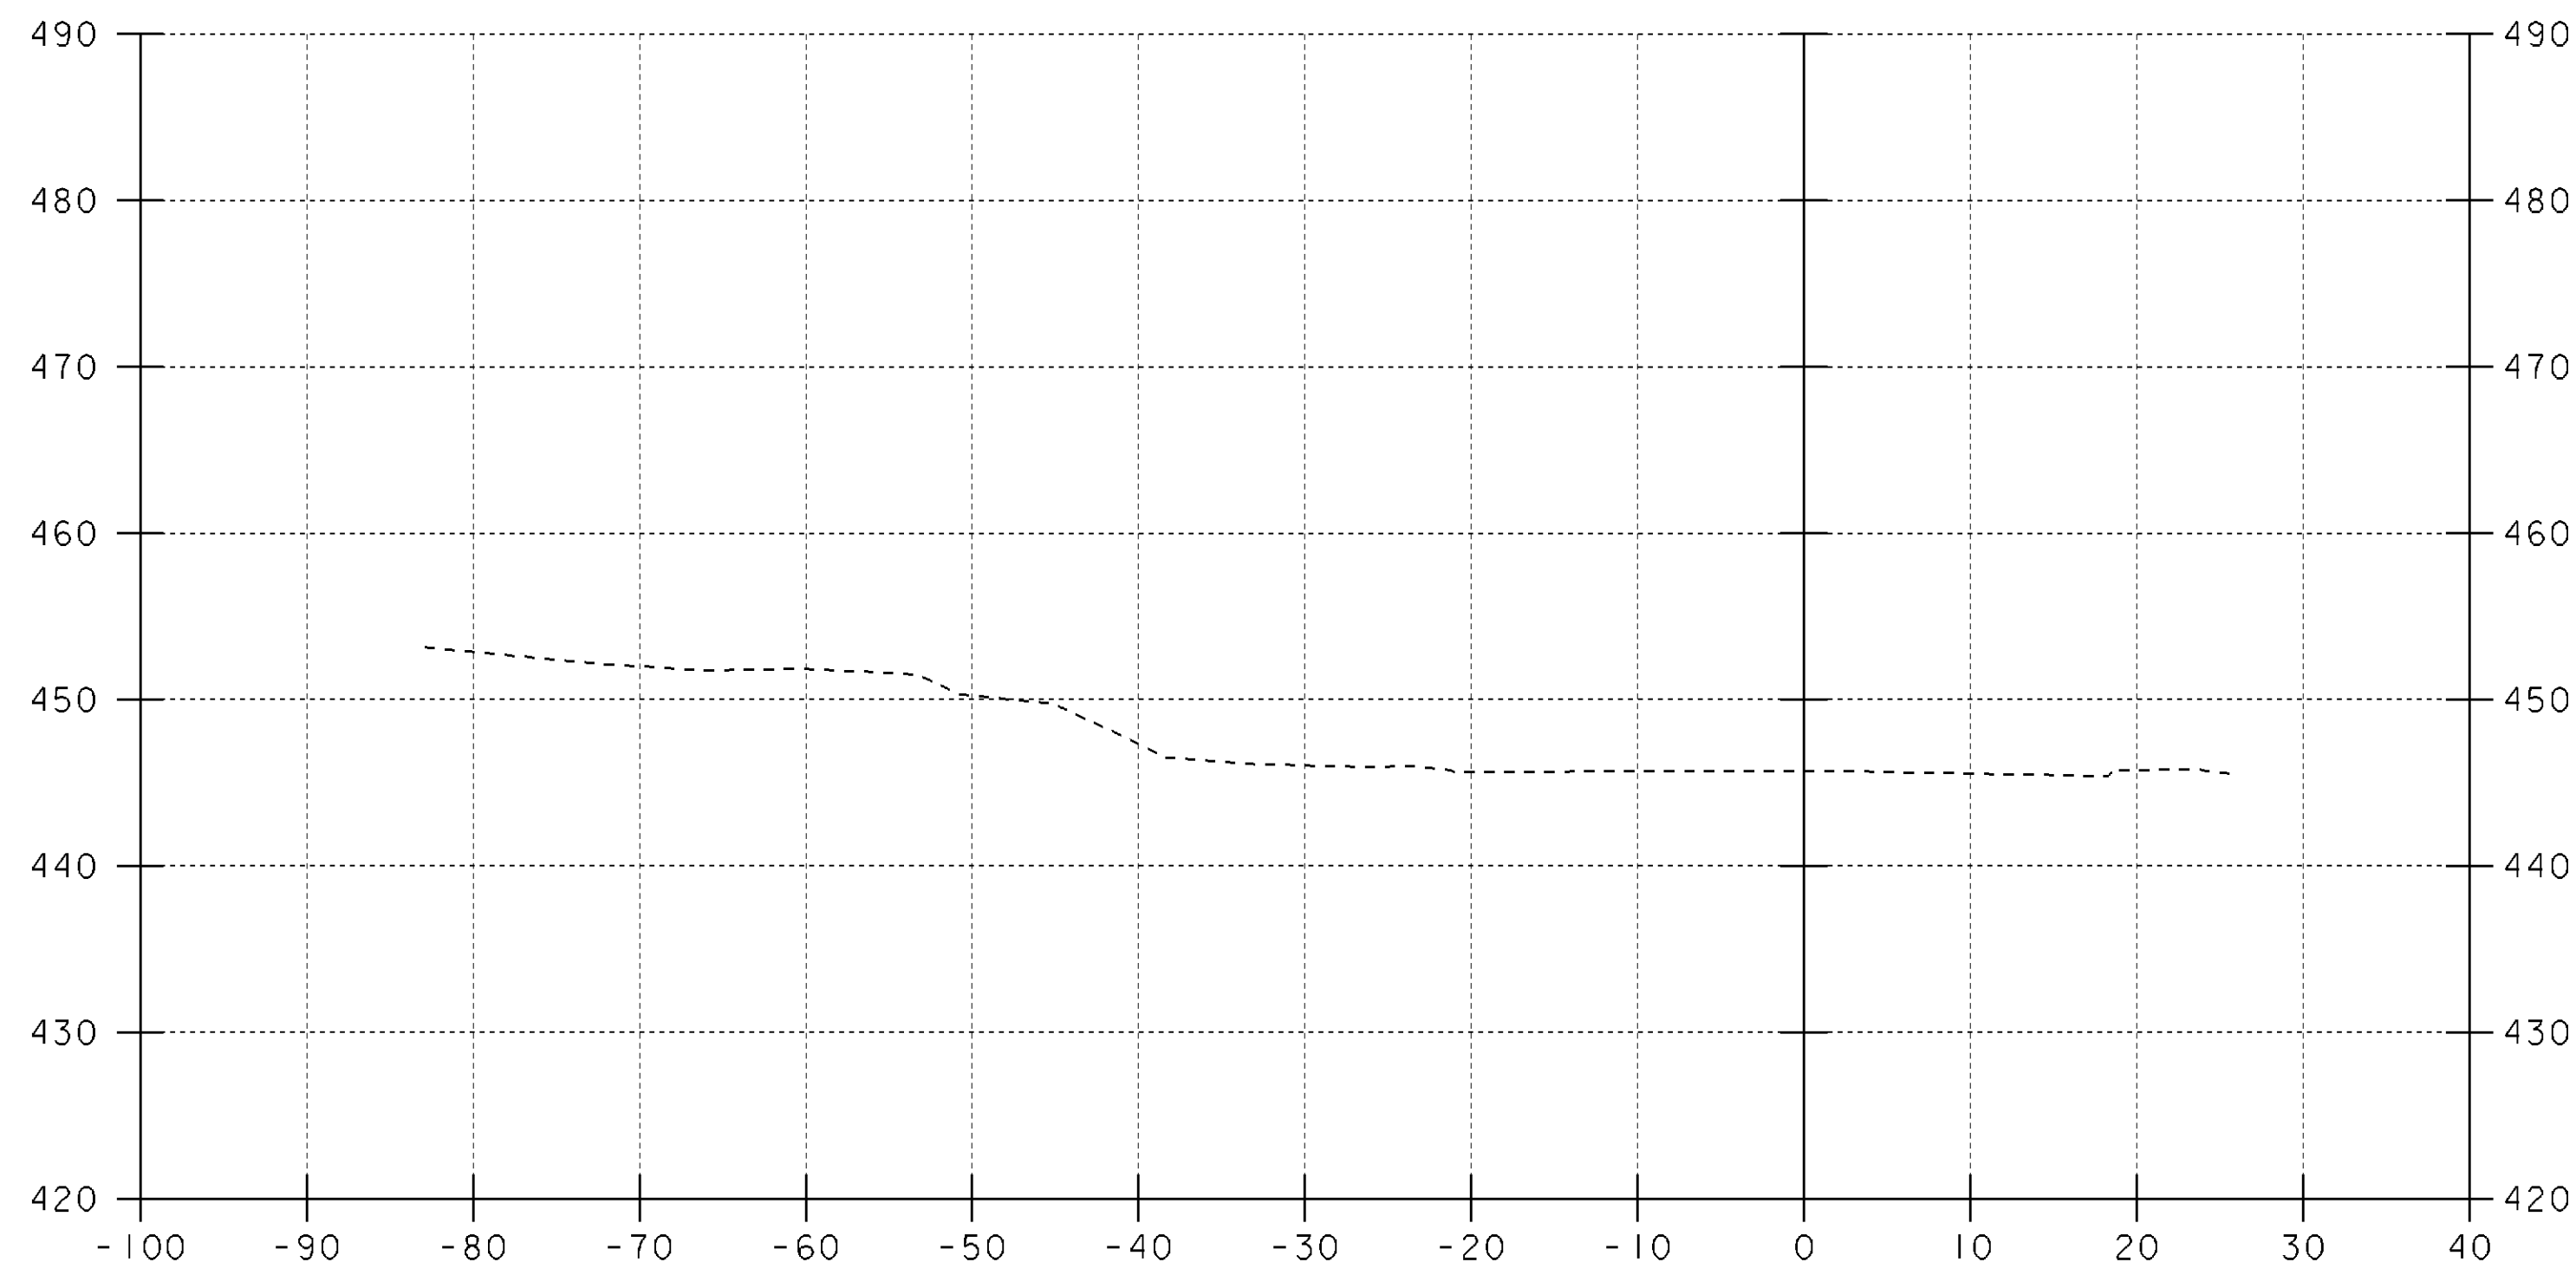

10+50

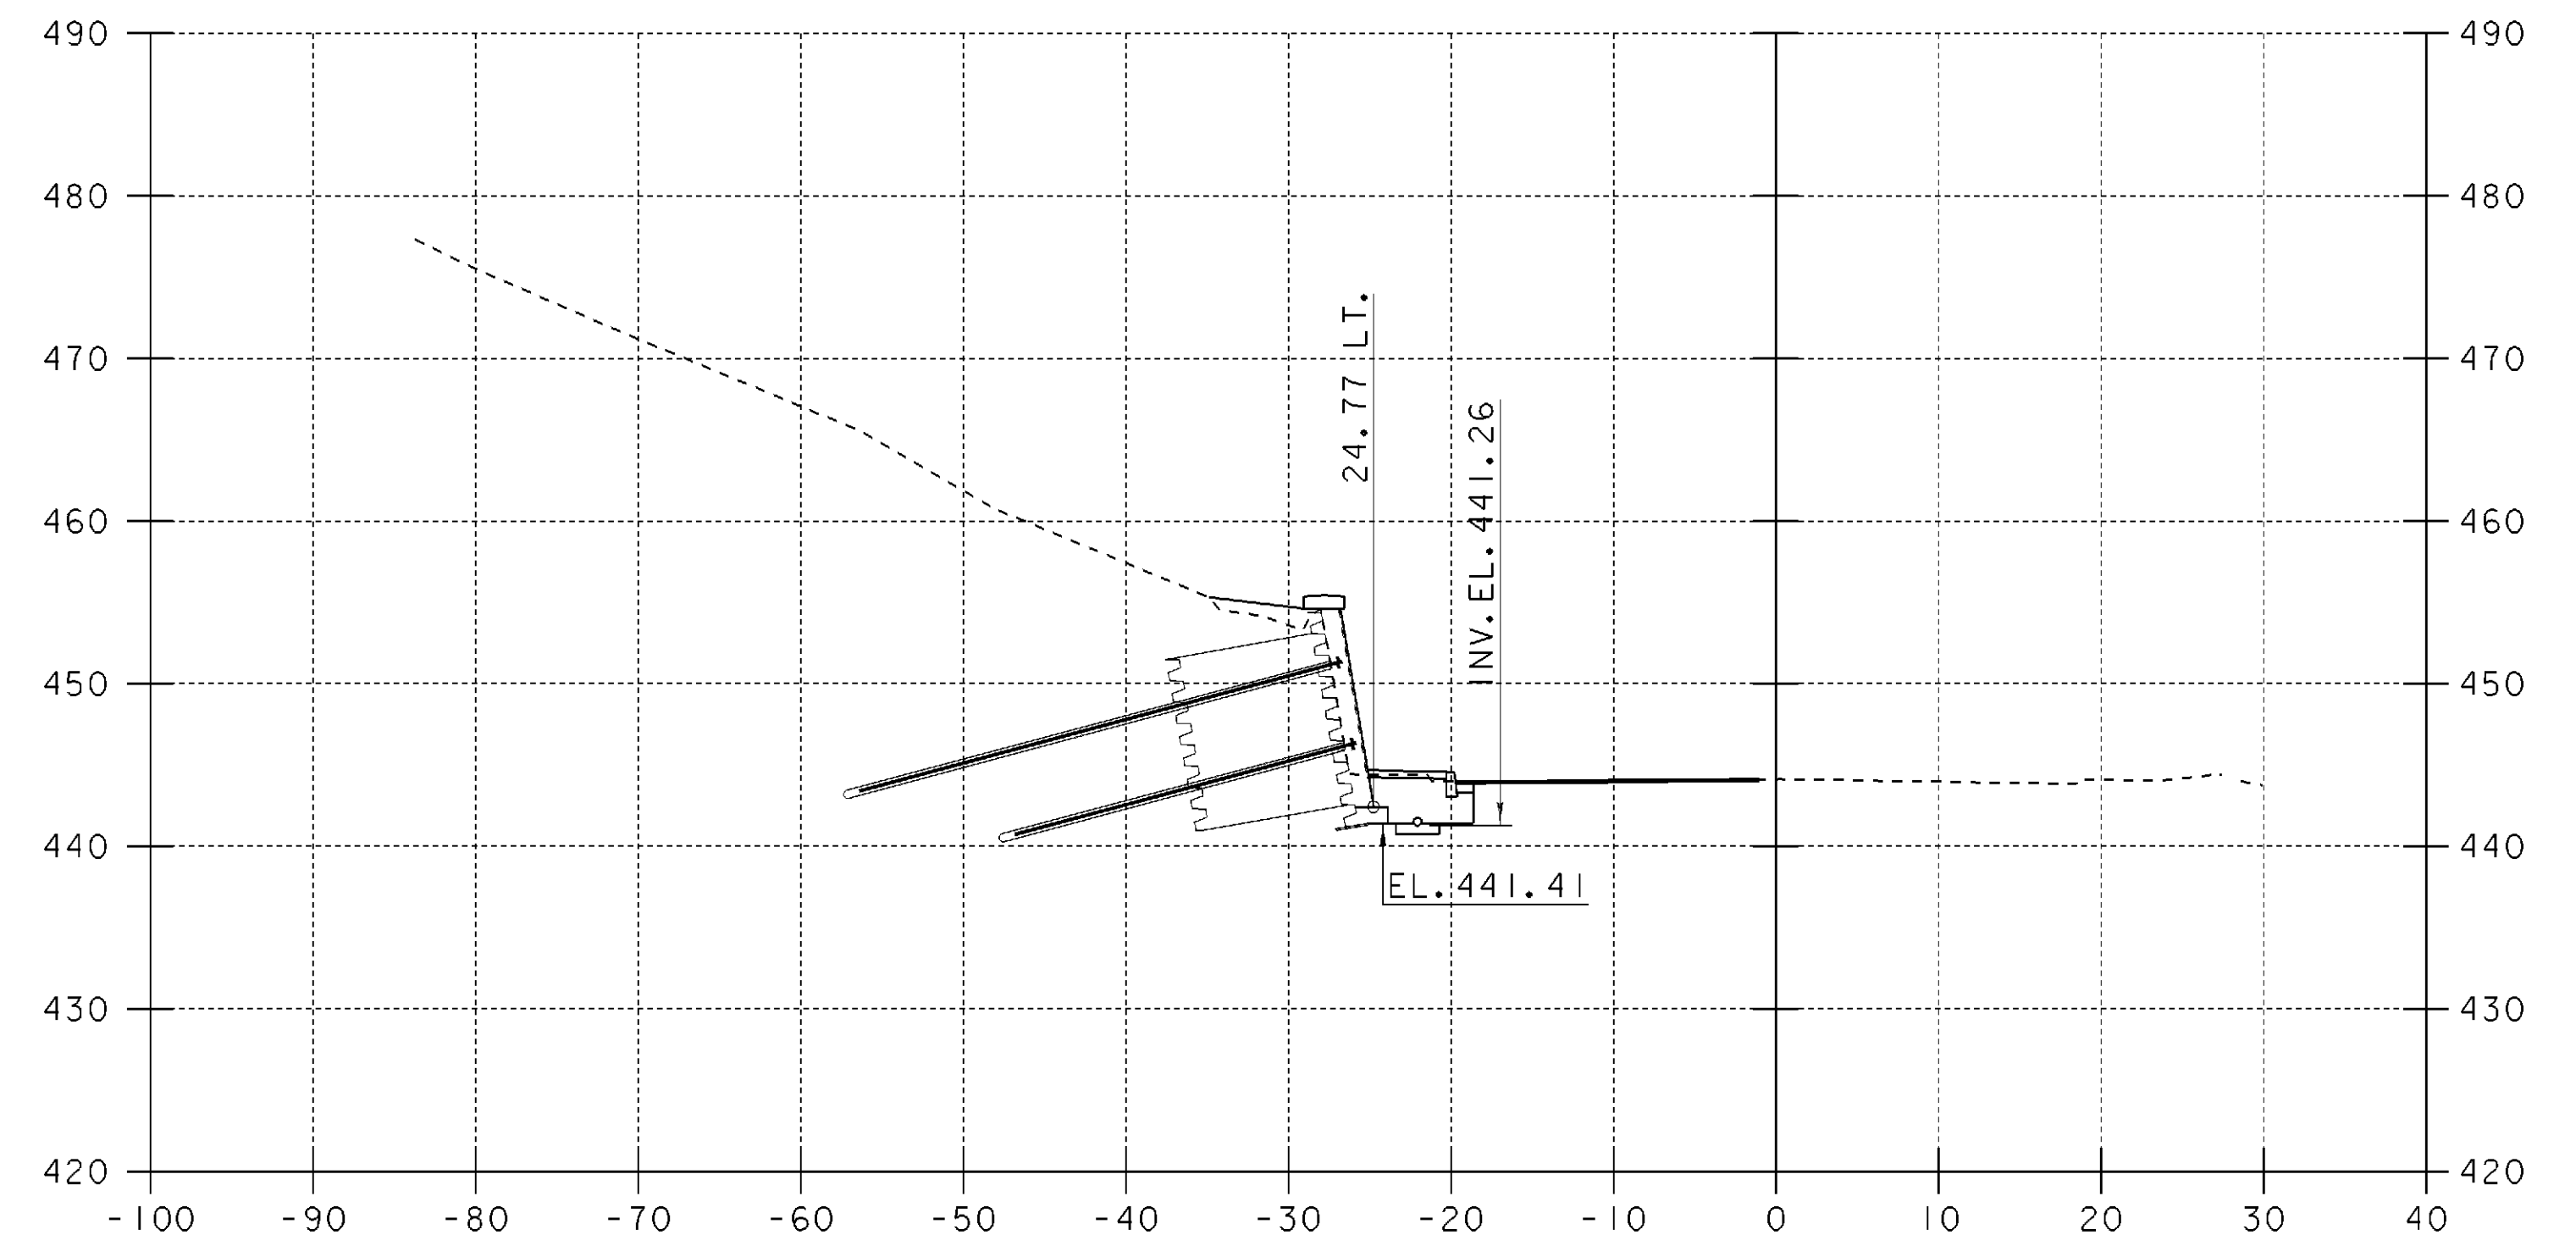

11+00

10+90.0 LT. - 16+75.0 LT.
CONCRETE FACE EXISTING METAL BIN
RETAINING WALL

VT 11 CROSS SECTIONS (1)

SCALE: 1" = 10'-0"
10 0 10

PROJECT NAME:	SPRINGFIELD	FILE NAME:	00b124/Structures/sbl24m01.I	PLOT DATE:	17-AUG-2004
PROJECT NUMBER:	STP 016-2 (10)S	PROJECT MANAGER:	R. WHITCOMB	DRAWN BY:	G. ROY
		DESIGNED BY:	G. ROY	CHECKED BY:	R. WHITCOMB
				SHEET	54 OF 72