




11+75

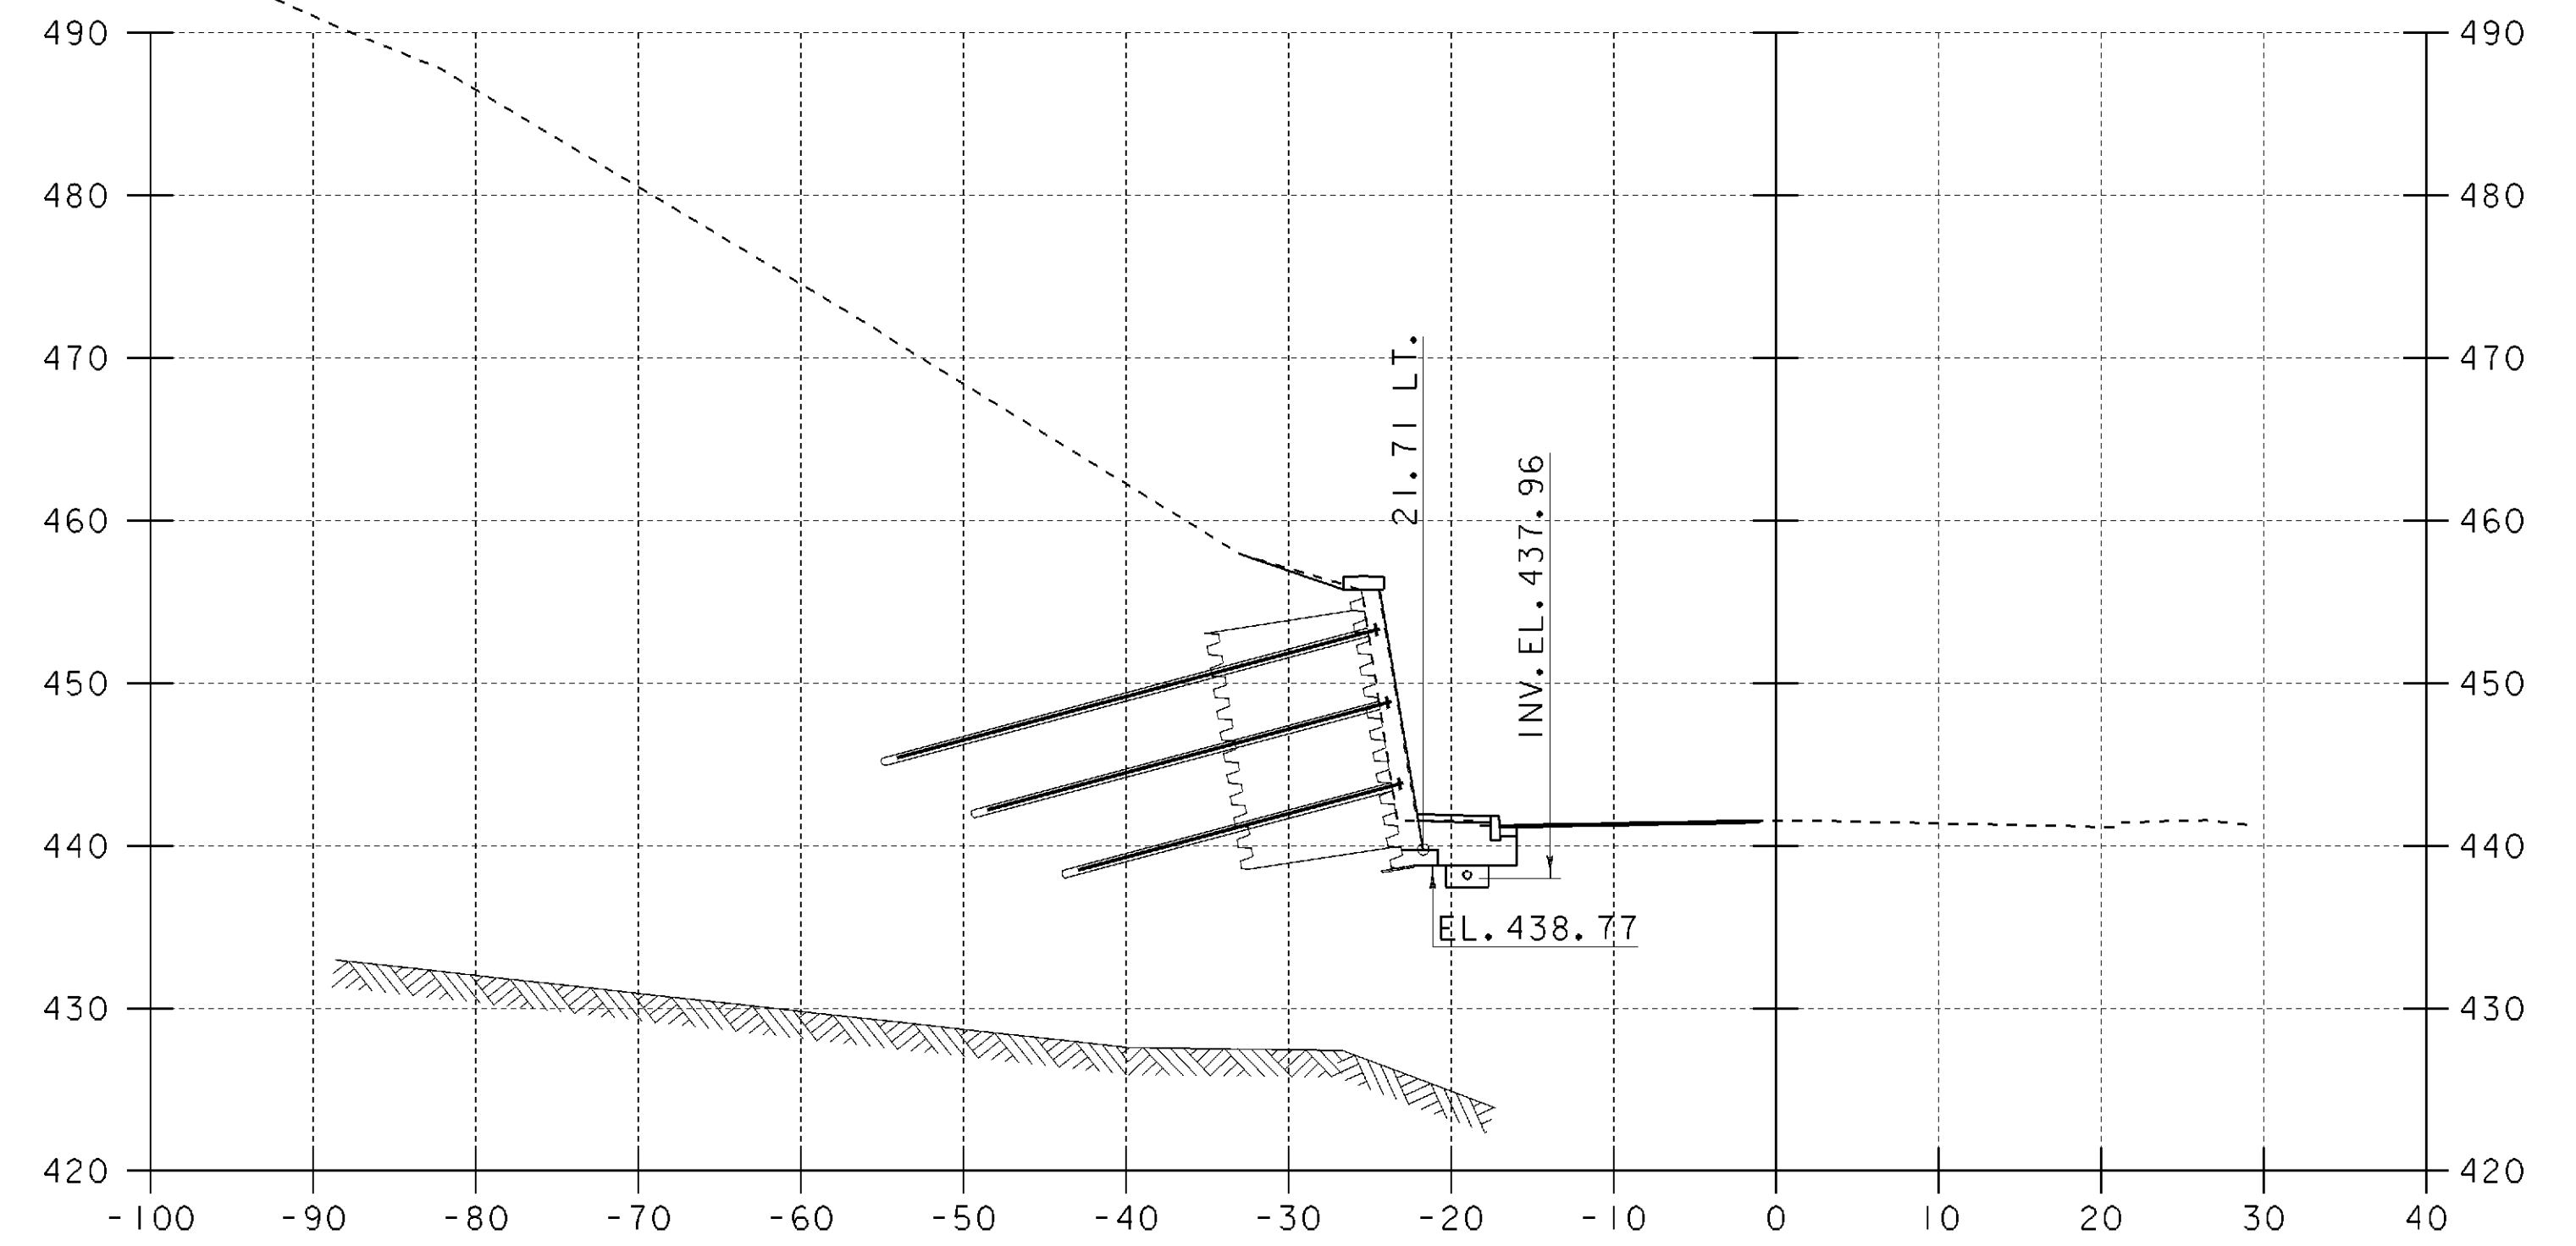

12+25

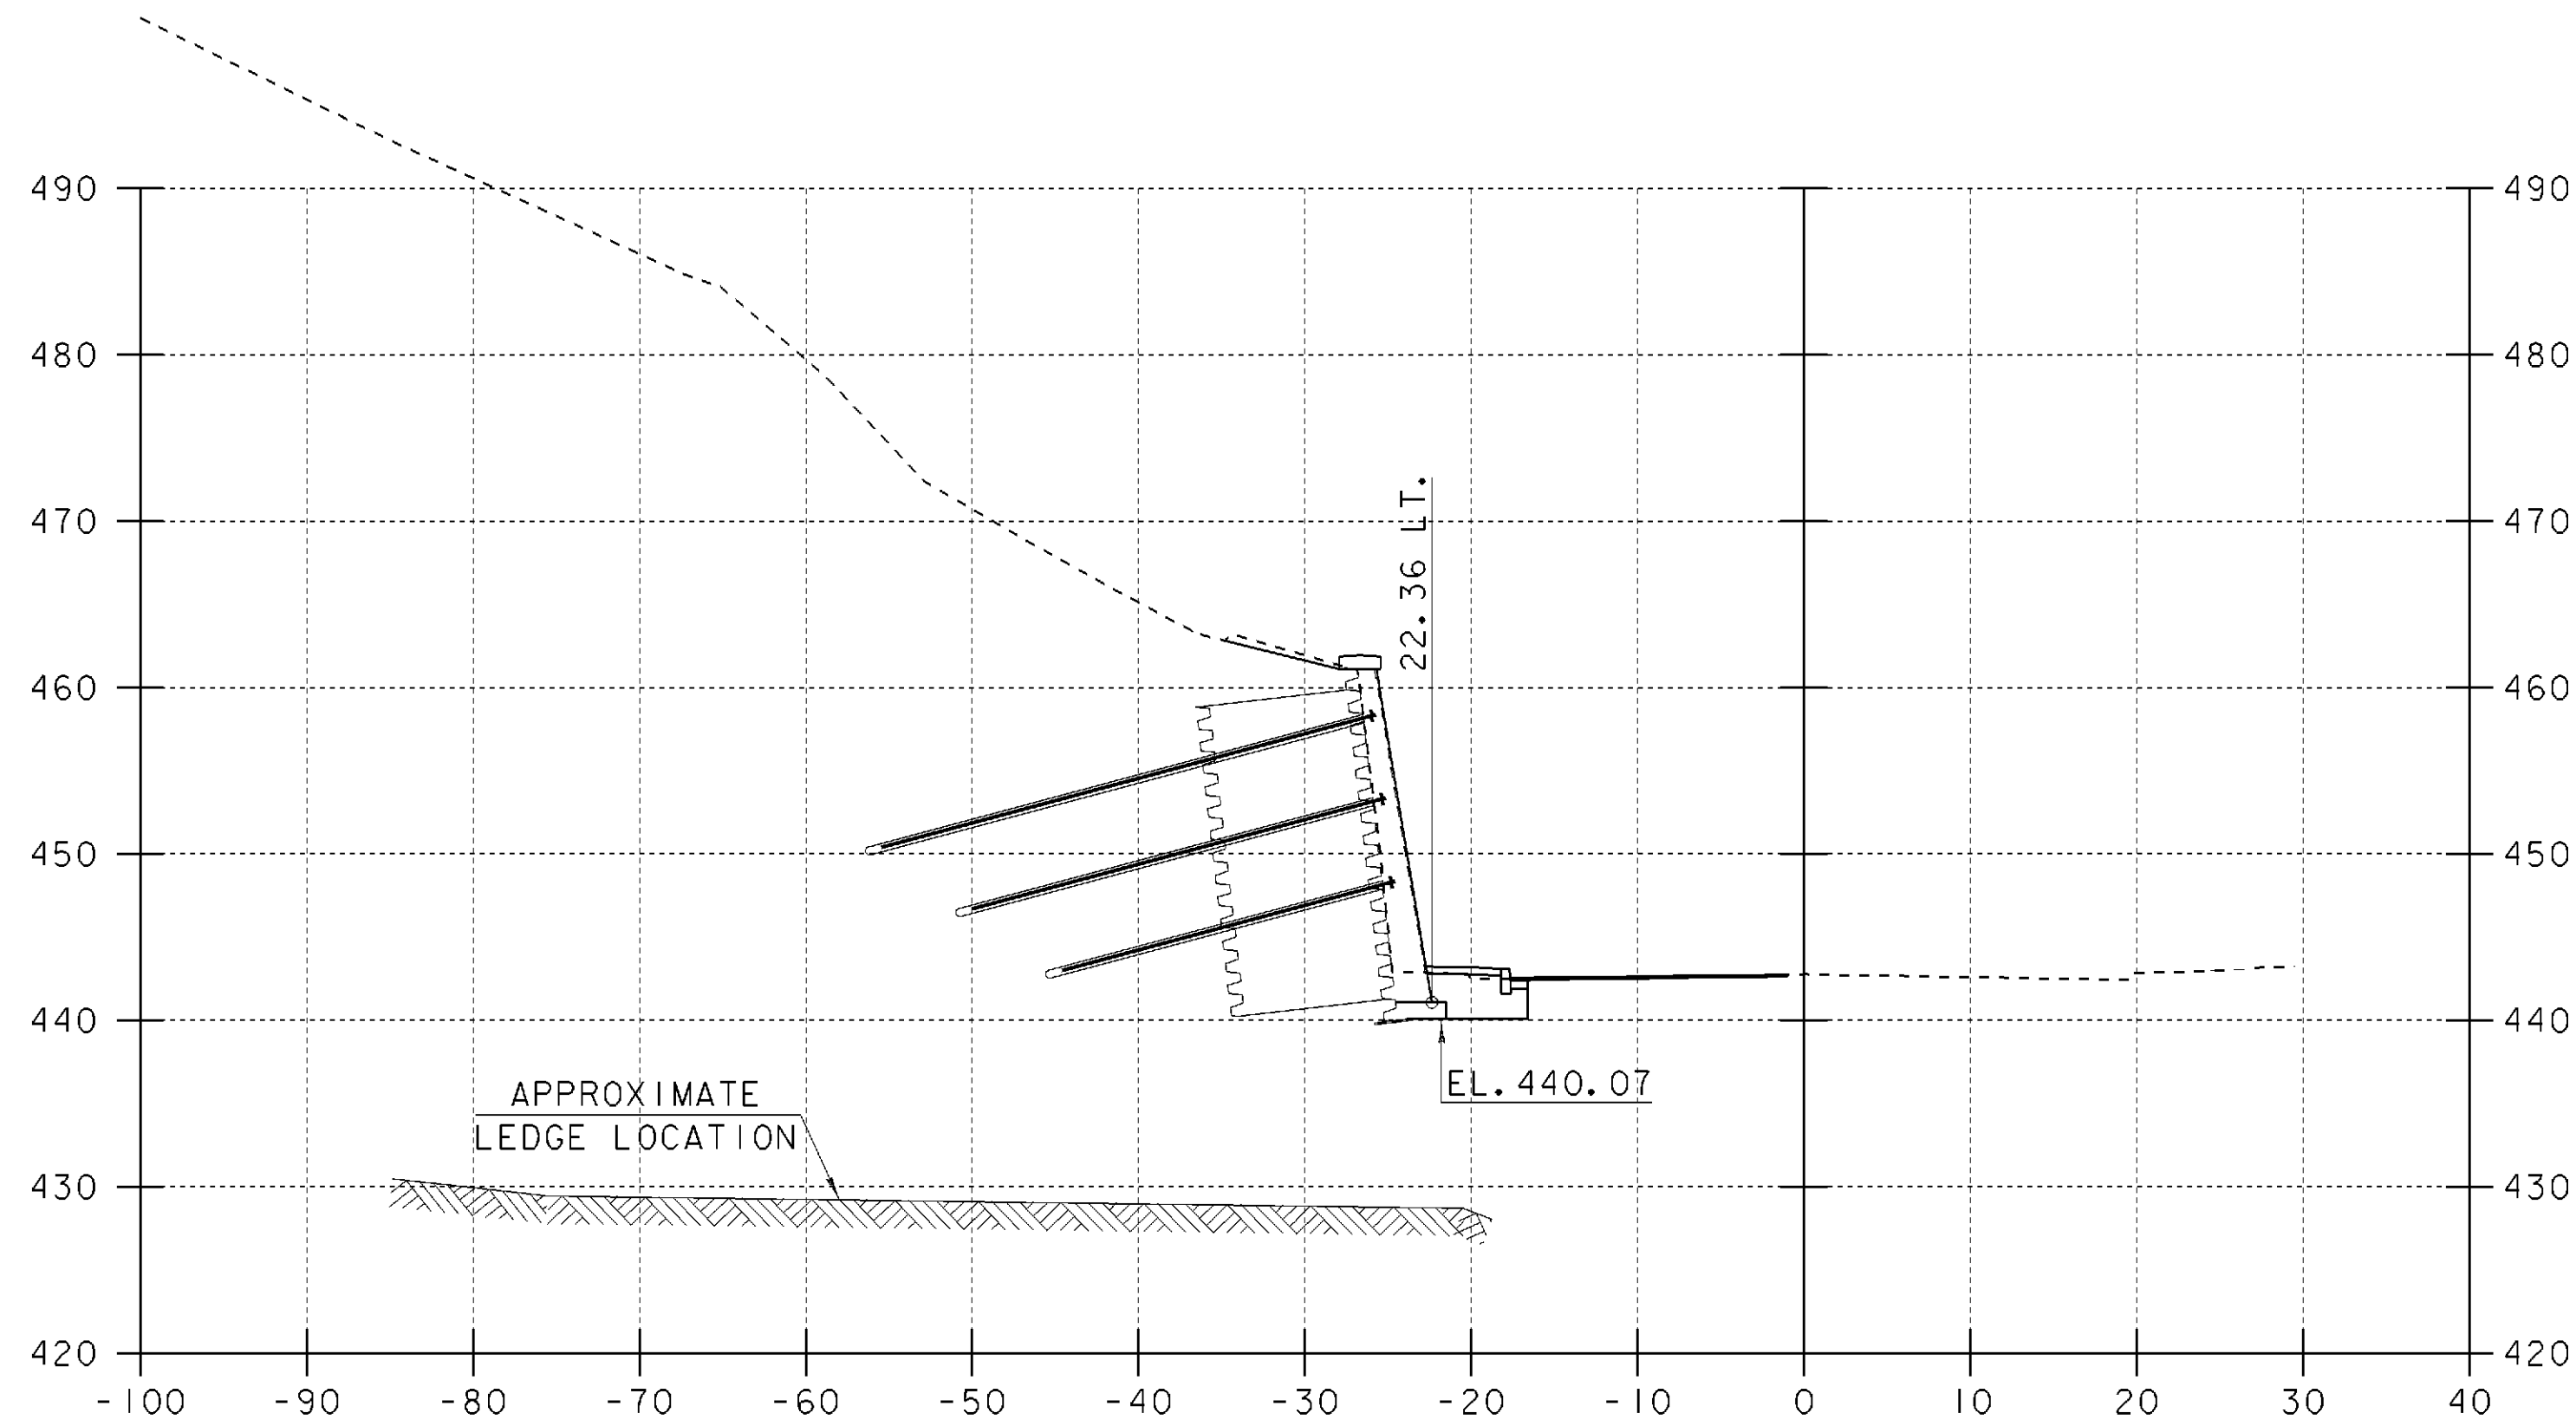

11+50

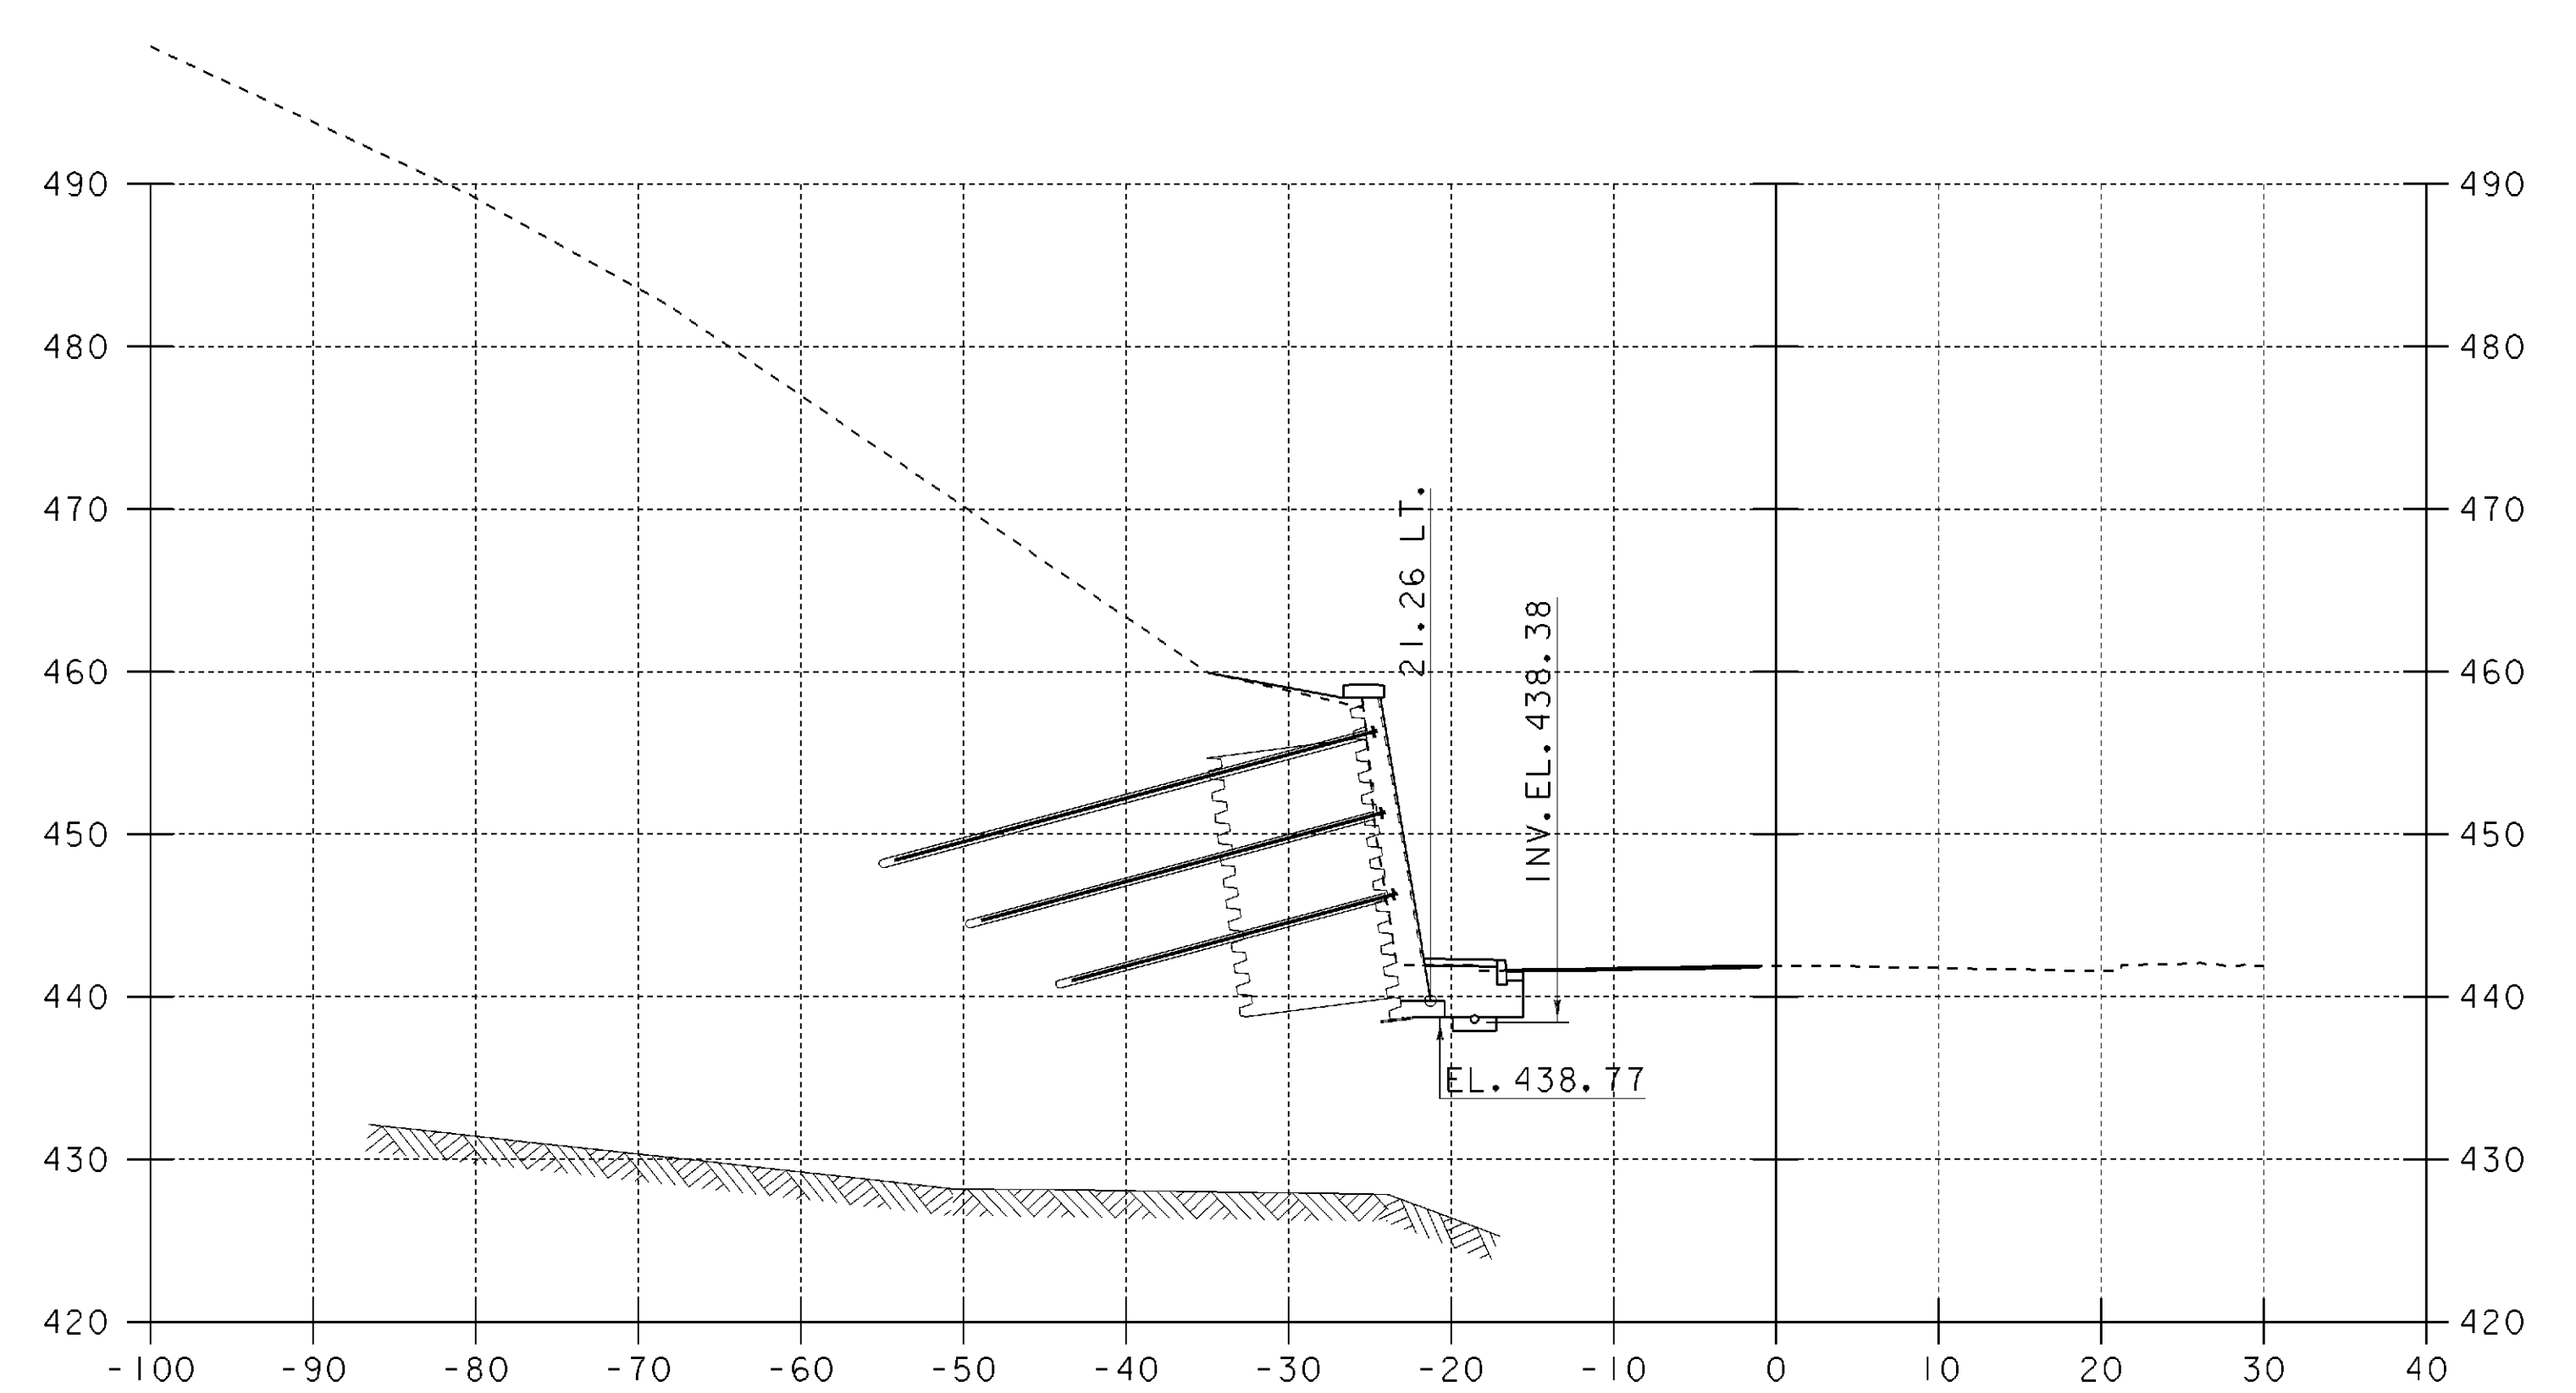

12+00

VT 11 CROSS SECTIONS (2)

PROJECT NAME:	SPRINGFIELD	FILE NAME:	00b124/Structures/sb124m02.i	PLOT DATE:	17-AUG-2004
PROJECT NUMBER:	STP 016-2 (10)S	PROJECT MANAGER:	R. WHITCOMB	DRAWN BY:	G. ROY
		DESIGNED BY:	G. ROY	CHECKED BY:	R. WHITCOMB
				SHEET	55 OF 72

SCALE: 1" = 10'-0"