


STA. 17+77.50 LT.
END PARTICIPATION PROJECT

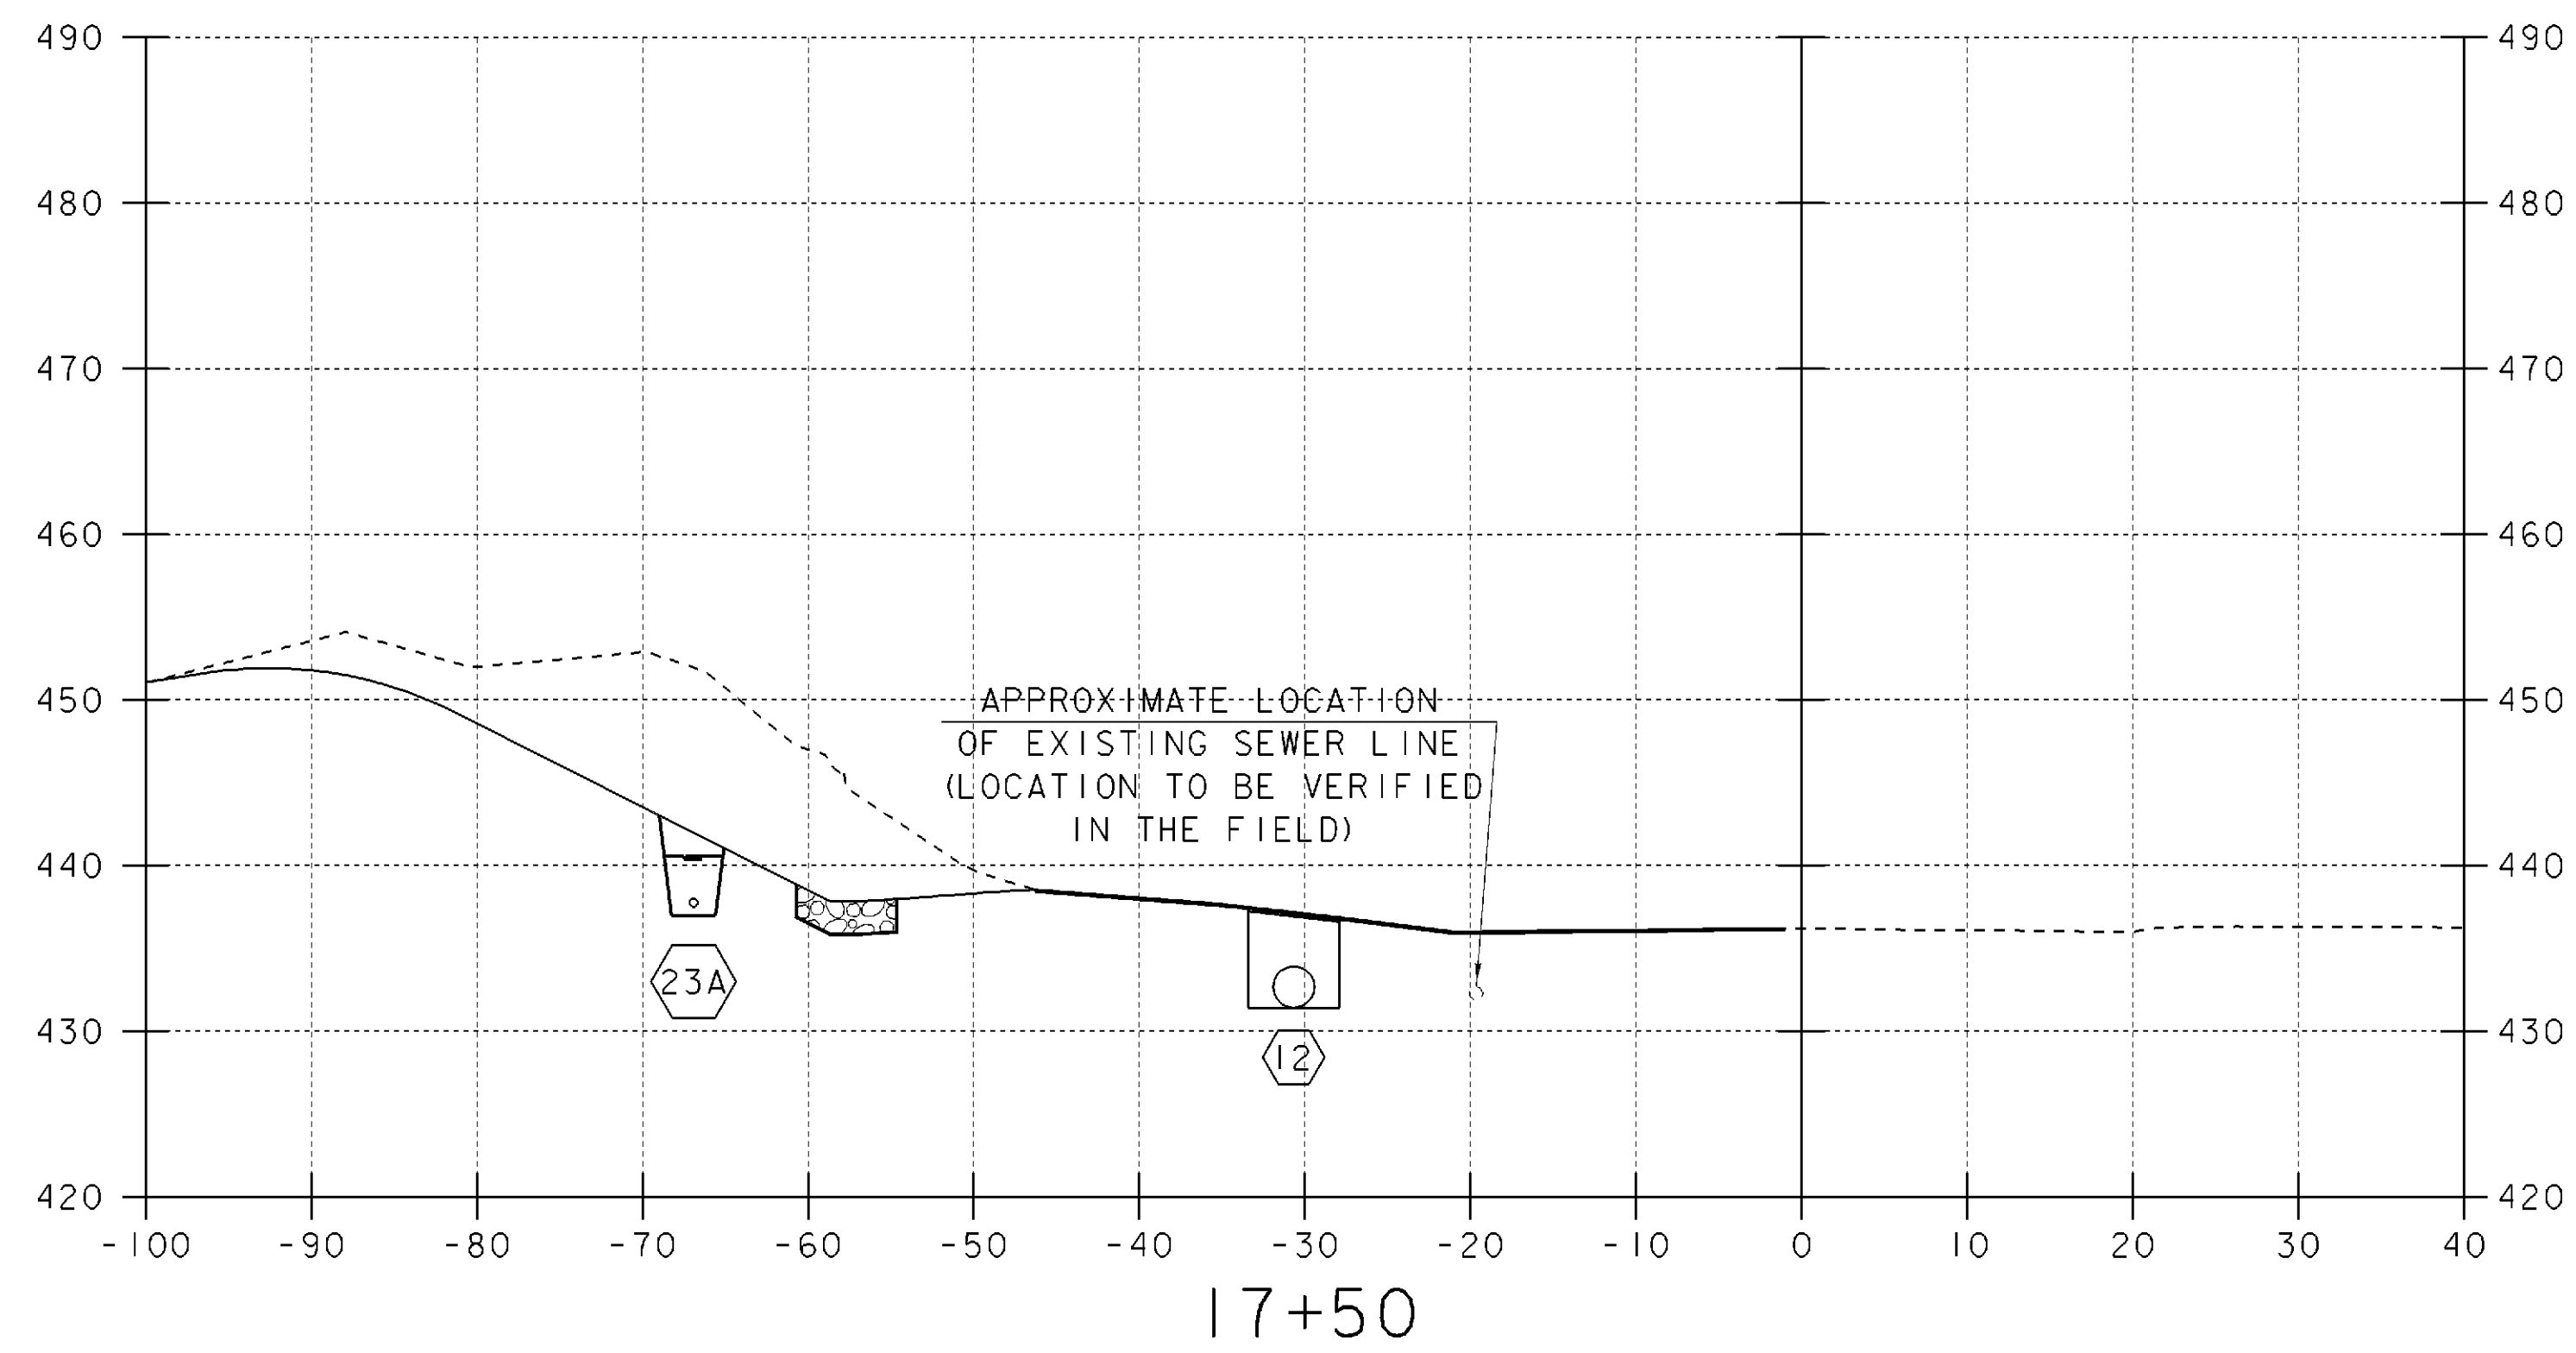

SCALE: 1" = 10'-0"
10 0 10

VT 11 CROSS SECTIONS (8)

PROJECT NAME: SPRINGFIELD	PLOT DATE: 17-AUG-2004
PROJECT NUMBER: STP 016-2 (10)S	DRAWN BY: G. ROY
FILE NAME: 00b124/Structures/sbl24m08.1	CHECKED BY: R. WHITCOMB
DESIGNED BY: G. ROY	SHEET 61 OF 72