


22+00

STA. 22+00.00 RT.  
END NON-PARTICIPATION PROJECT

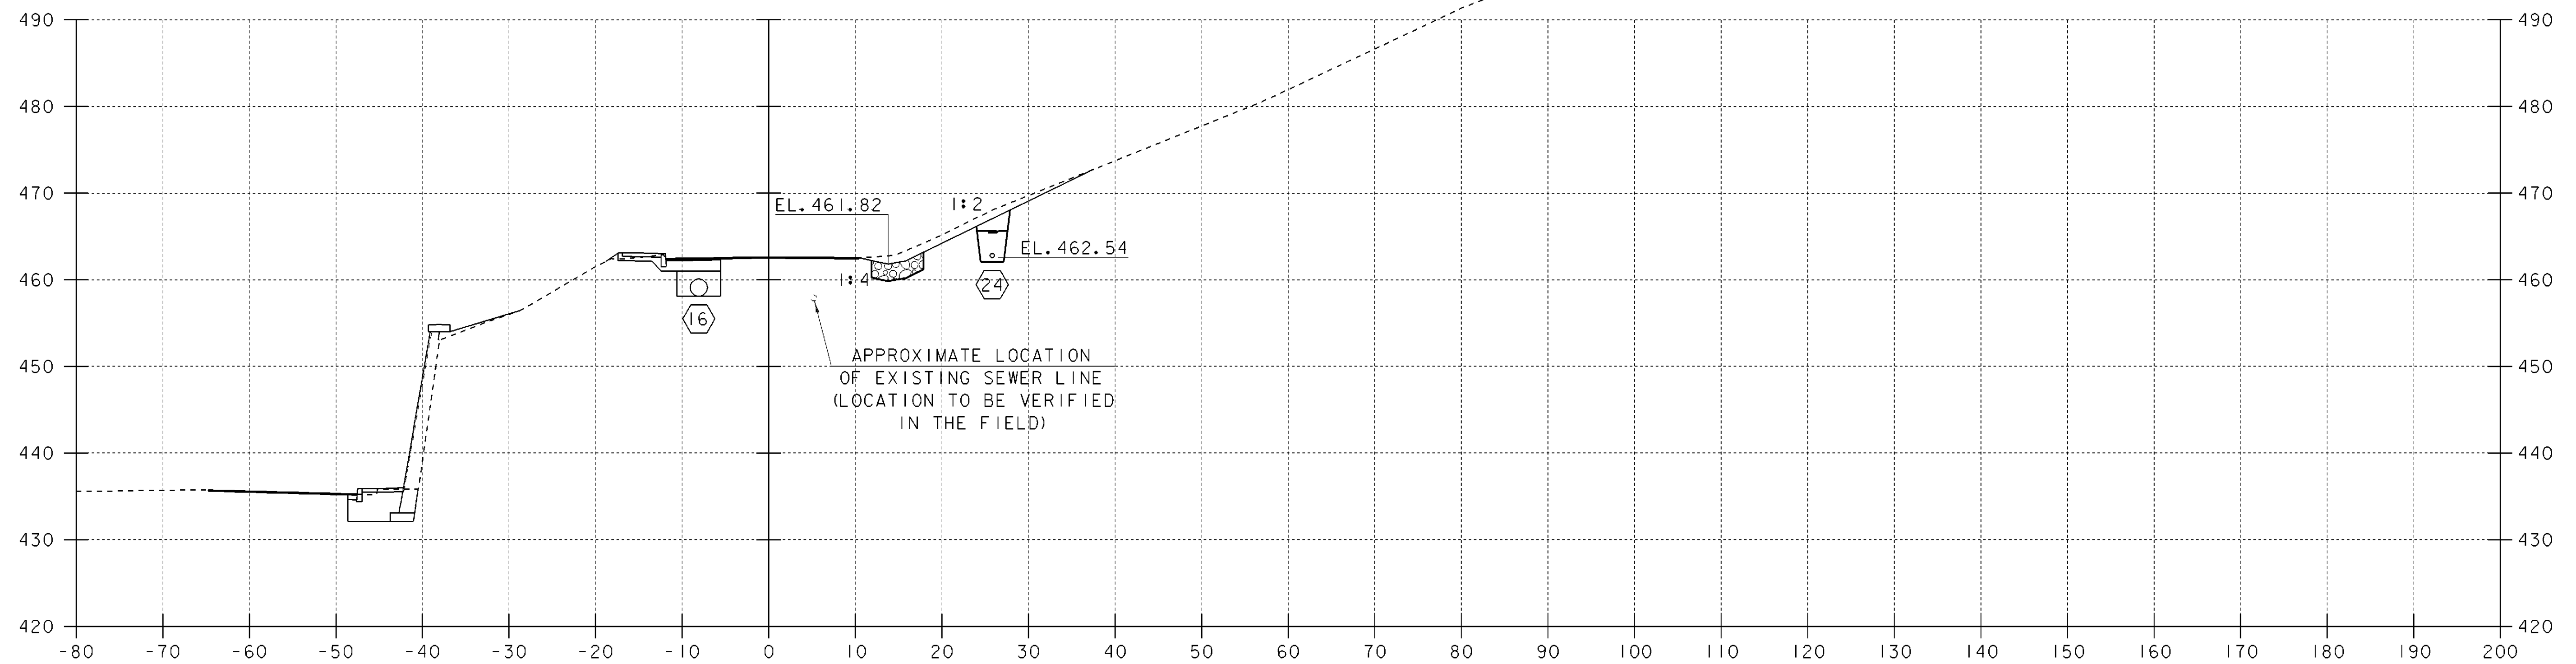

21+75

T.H. 325 CROSS SECTIONS (4)

SCALE: 1" = 10'-0"

PROJECT NAME:	SPRINGFIELD	FILE NAME:	00b124/Structures/sbl24s04.i	PLOT DATE:	17-AUG-2004
PROJECT NUMBER:	STP 016-2 (10)S	PROJECT MANAGER:	R. WHITCOMB	DRAWN BY:	G. ROY
		DESIGNED BY:	G. ROY	CHECKED BY:	R. WHITCOMB
				SHEET	65 OF 72