


PLAN	APPROVED
DATE	10/15/96
BY	W. J. BROWN
CHECKED	
DATE	
BY	
CHECKED	
DATE	
BY	

DATE	10/15/96
BY	W. J. BROWN
CHECKED	
DATE	
BY	
CHECKED	
DATE	
BY	

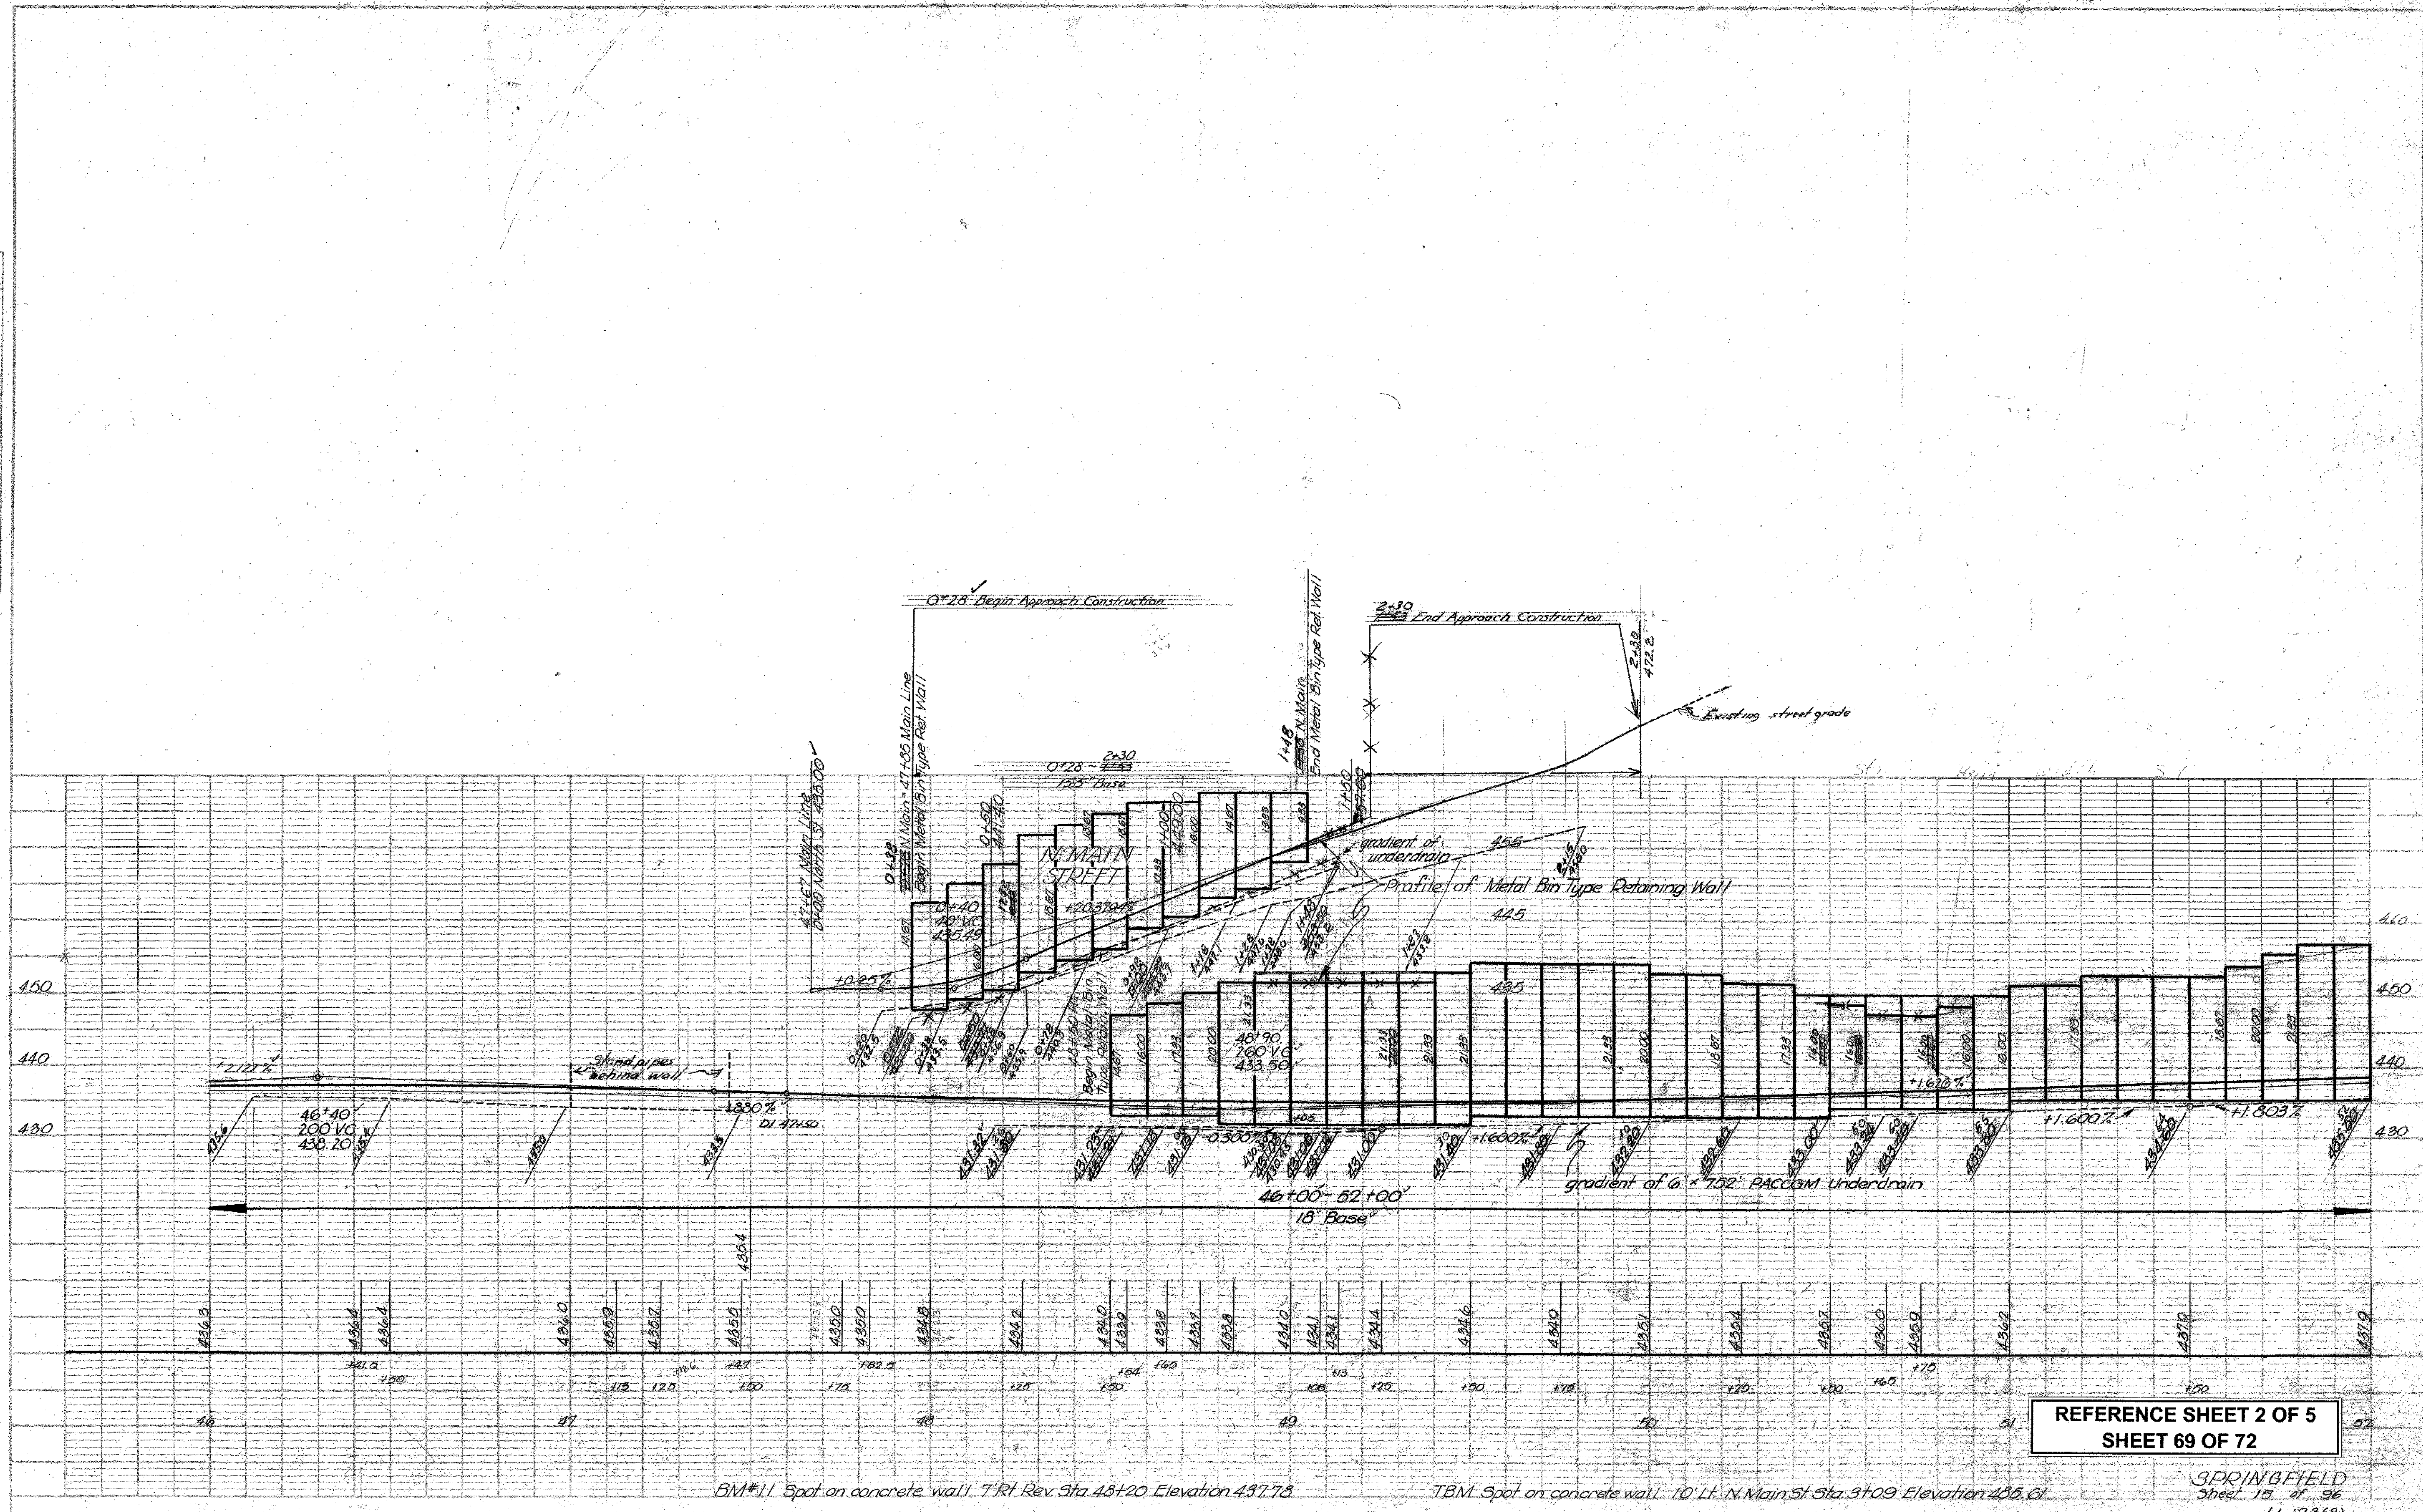

REFERENCE SHEET 2 OF 5
SHEET 69 OF 72

BM#11 Spot on concrete wall, T.Rt. Rev. Sta. 48+20 Elevation 437.78

TBM Spot on concrete wall, 10' Lt. N. Main St. Sta. 51+09 Elevation 405.61

SPRINGFIELD
Sheet 15 of 96
U-123(8)