


PLAN SURVEYED
 PLOTTED
 NOTE BOOK ALIGNMENT CHECKED
 NO. OF PAGES CHECKED

DATE 2-29-88
 DRAWN BY CHRISTIE
 CHECKED BY
 DATE 2-28-88

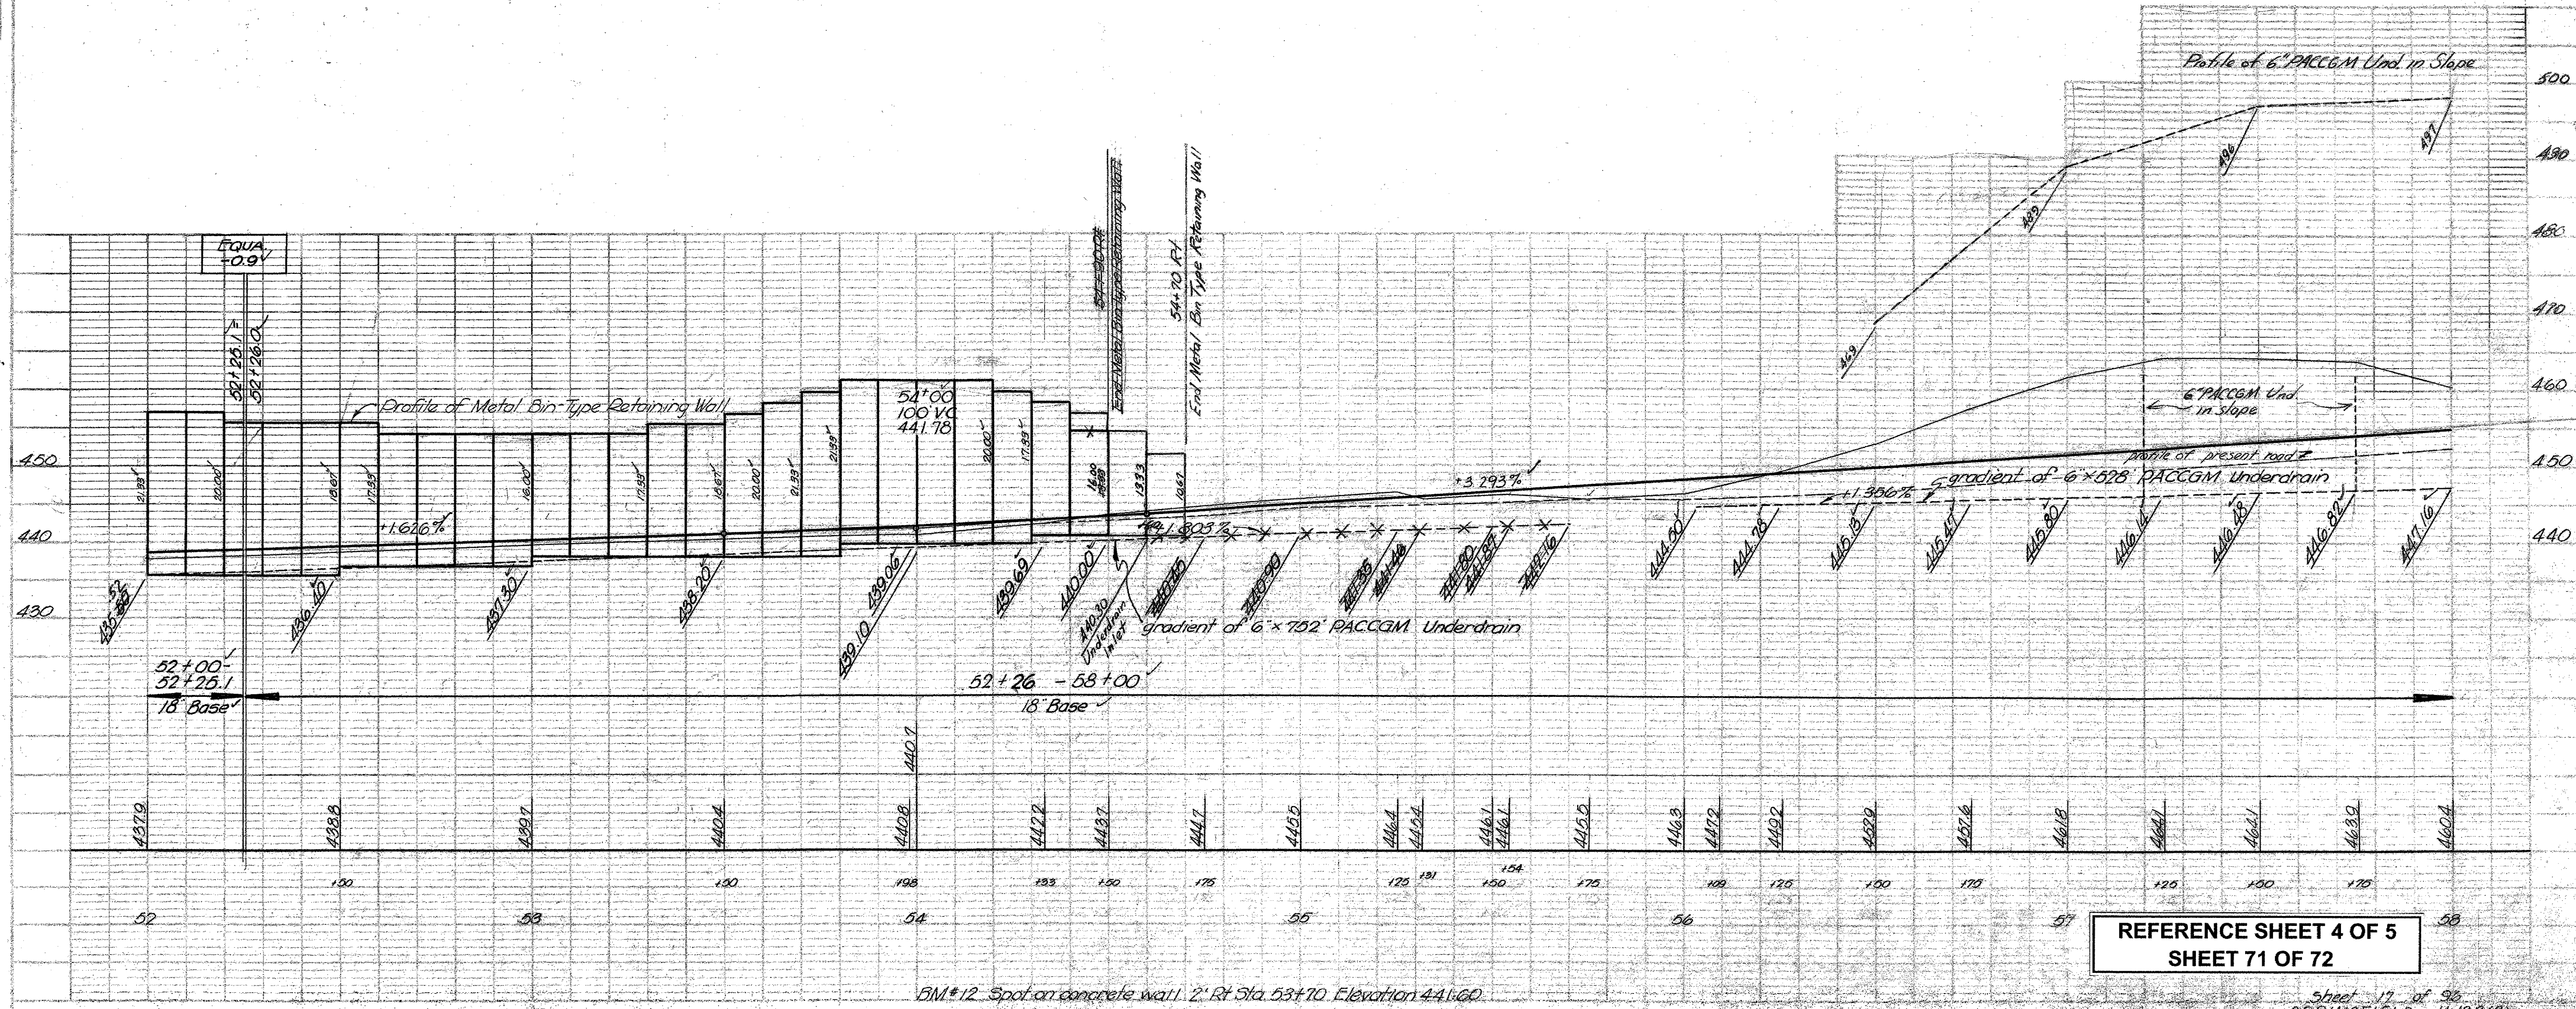

REFERENCE SHEET 4 OF 5
 SHEET 71 OF 72

BM#12 Spot on concrete wall. 2' Rt. Sta. 53+70 Elevation 441.60

Sheet 17 of 96
 SPRINGFIELD U-123(8)