

THICKNESS TOLERANCES

PAVEMENT (TOTAL DEPTH) = 1/4"
 SUBBASE = 1"
 SAND BORROW = 1"




TYPICAL SECTION

1 1/4" BITUMINOUS CONCRETE PAVEMENT ,TYPE III, SINGLE LIFT
 5 " BITUMINOUS CONCRETE PAVEMENT ,TYPE I , BASE COURSE (2-2 1/2" LIFTS)
 18" DENSE GRADED CRUSHED STONE (2-9" LIFTS)
 6" SAND
 NOTE: ALL BITUMINOUS CONCRETE PAVEMENT TO BE PG 58-28

SEEDING FORMULA , ITEM 651.15 URBAN AREAS

% WT.	LBS./A.	NAME	PUR %	GERM %
37.5	30	CREeping RED FESCUE	98	85
31.25	25	KENTUCKY BLUE GRASS	85	75
31.25	25	PERENIAL RYE GRASS	95	90
100.00	80			

THE SEED MIXTURE SHALL NOT HAVE A WEED CONTENT EXCEEDING 0.40% BY WEIGHT AND SHALL BE FREE OF ALL NOXIOUS WEED SEED.
 SEED- TO BE APPLIED PER SEEDING FORMULAS DIRECTED BY THE ENGINEER.
 FERTILIZER- FORMULA 10-20-10 TO BE USED WITH SEED, APPLIED AT THE RATE OF 500 LBS./ACRE.
 AGRICULTURAL LIMESTONE- TO BE APPLIED AT THE RATE OF 2 TONS/ACRE OR AS DIRECTED BY THE ENGINEER.
 HAY MULCH- TO BE PLACED ON EARTH SLOPES AT THE RATE OF 2 TONS/ACRE, OR AS DIRECTED BY THE ENGINEER.
 TOPSOIL- TO BE USED WITH SEED AS INDICATED ON THE PLANS, OR AS DIRECTED BY THE ENGINEER.
 MARKER POSTS- TO BE PLACED AS DIRECTED BY THE ENGINEER.
 SLOPE ROUNDING- ALL CUT SLOPES TO BE ROUNDED IN ACCORDANCE WITH STANDARD SHEET B-5.

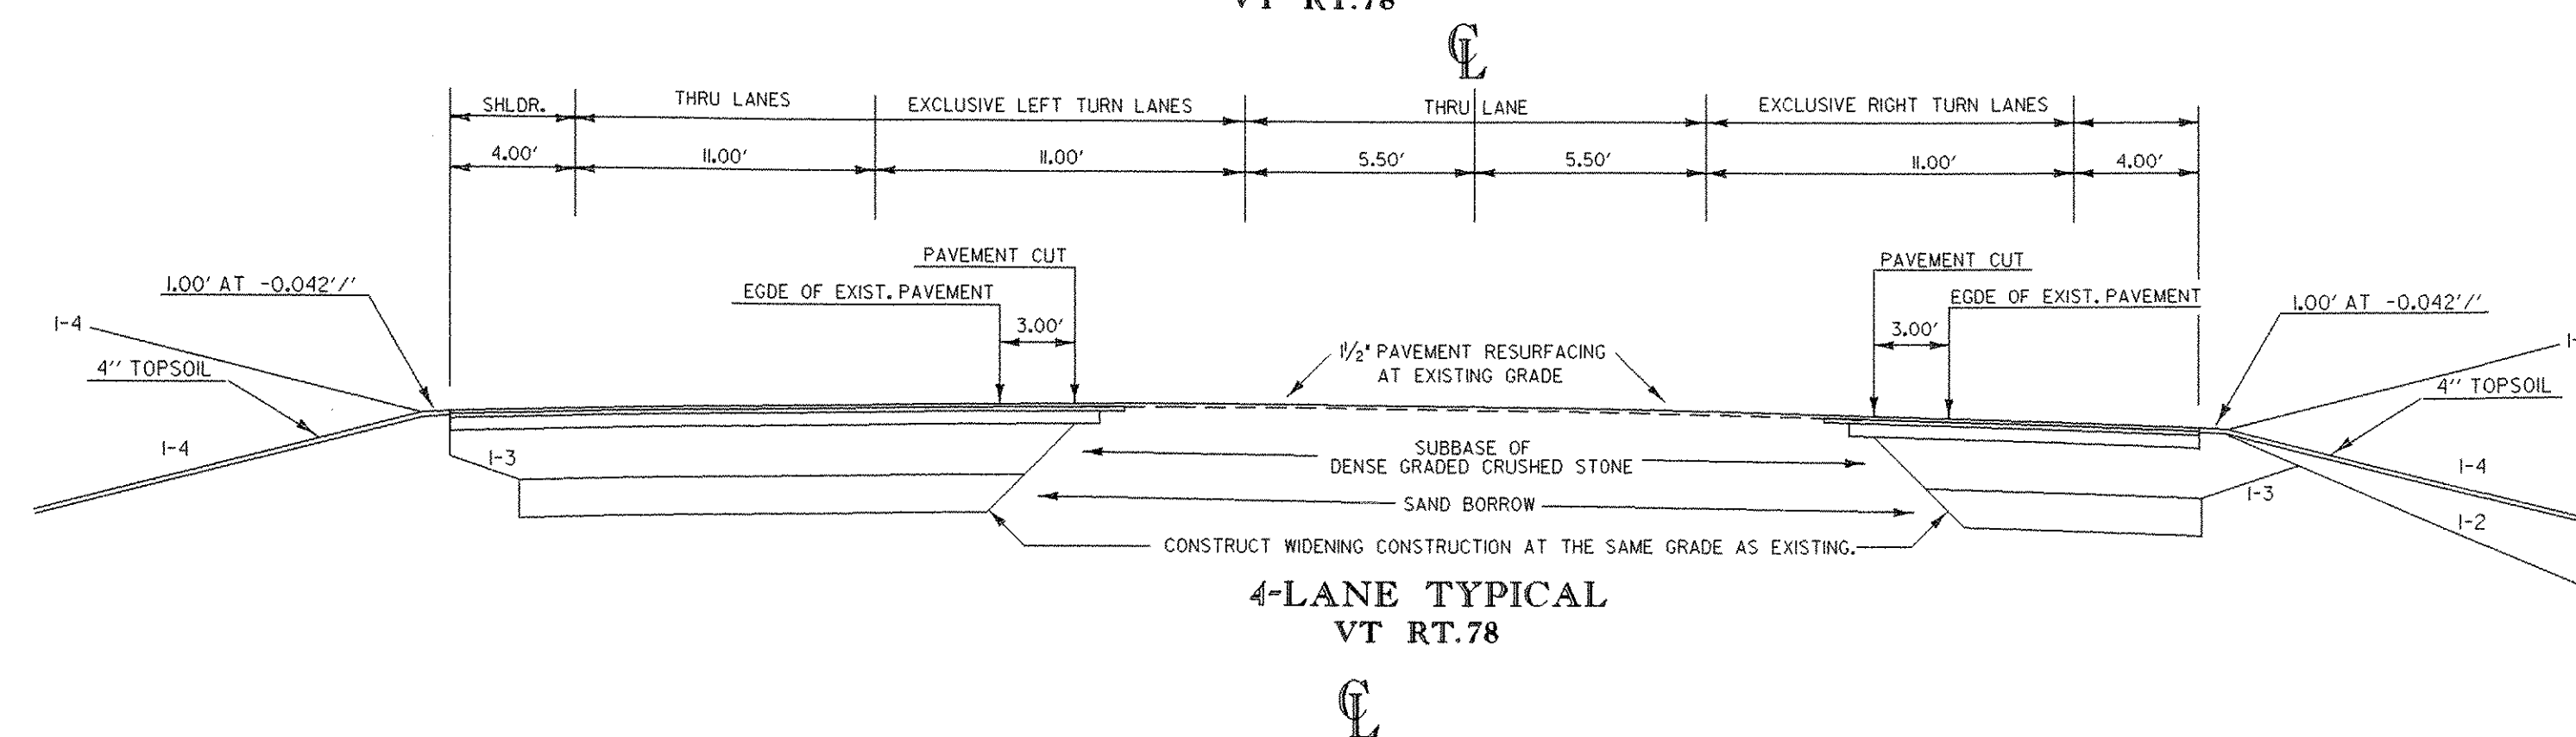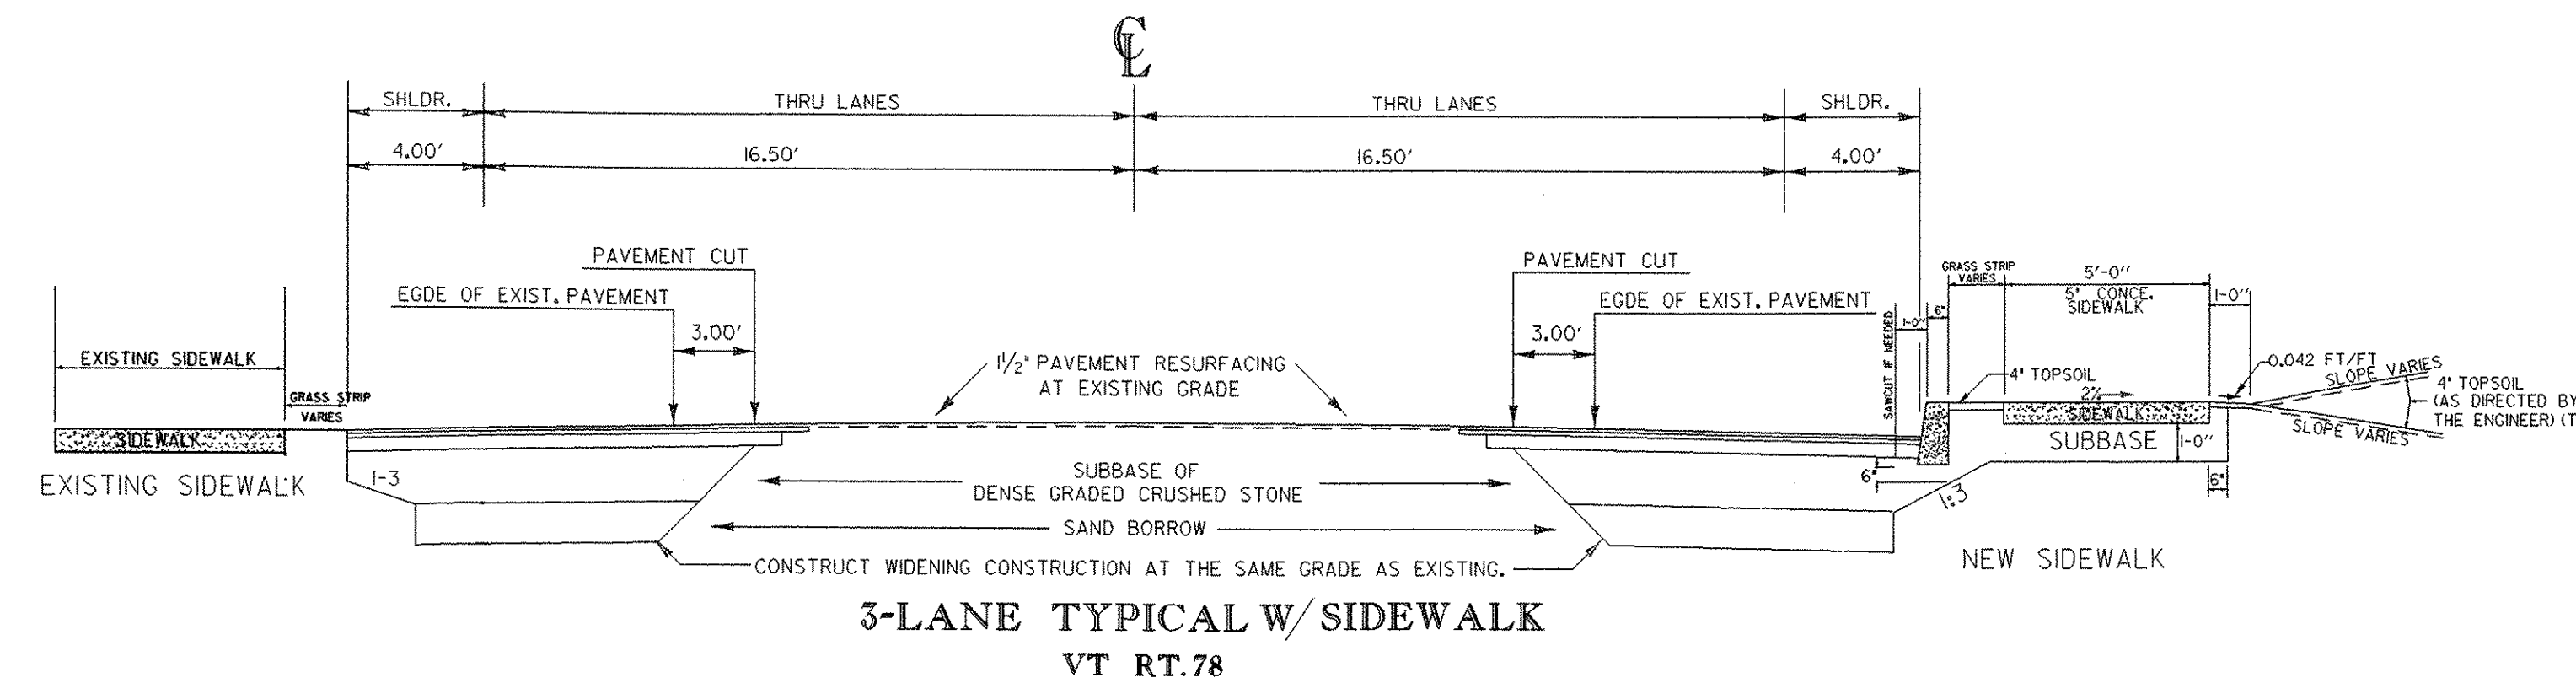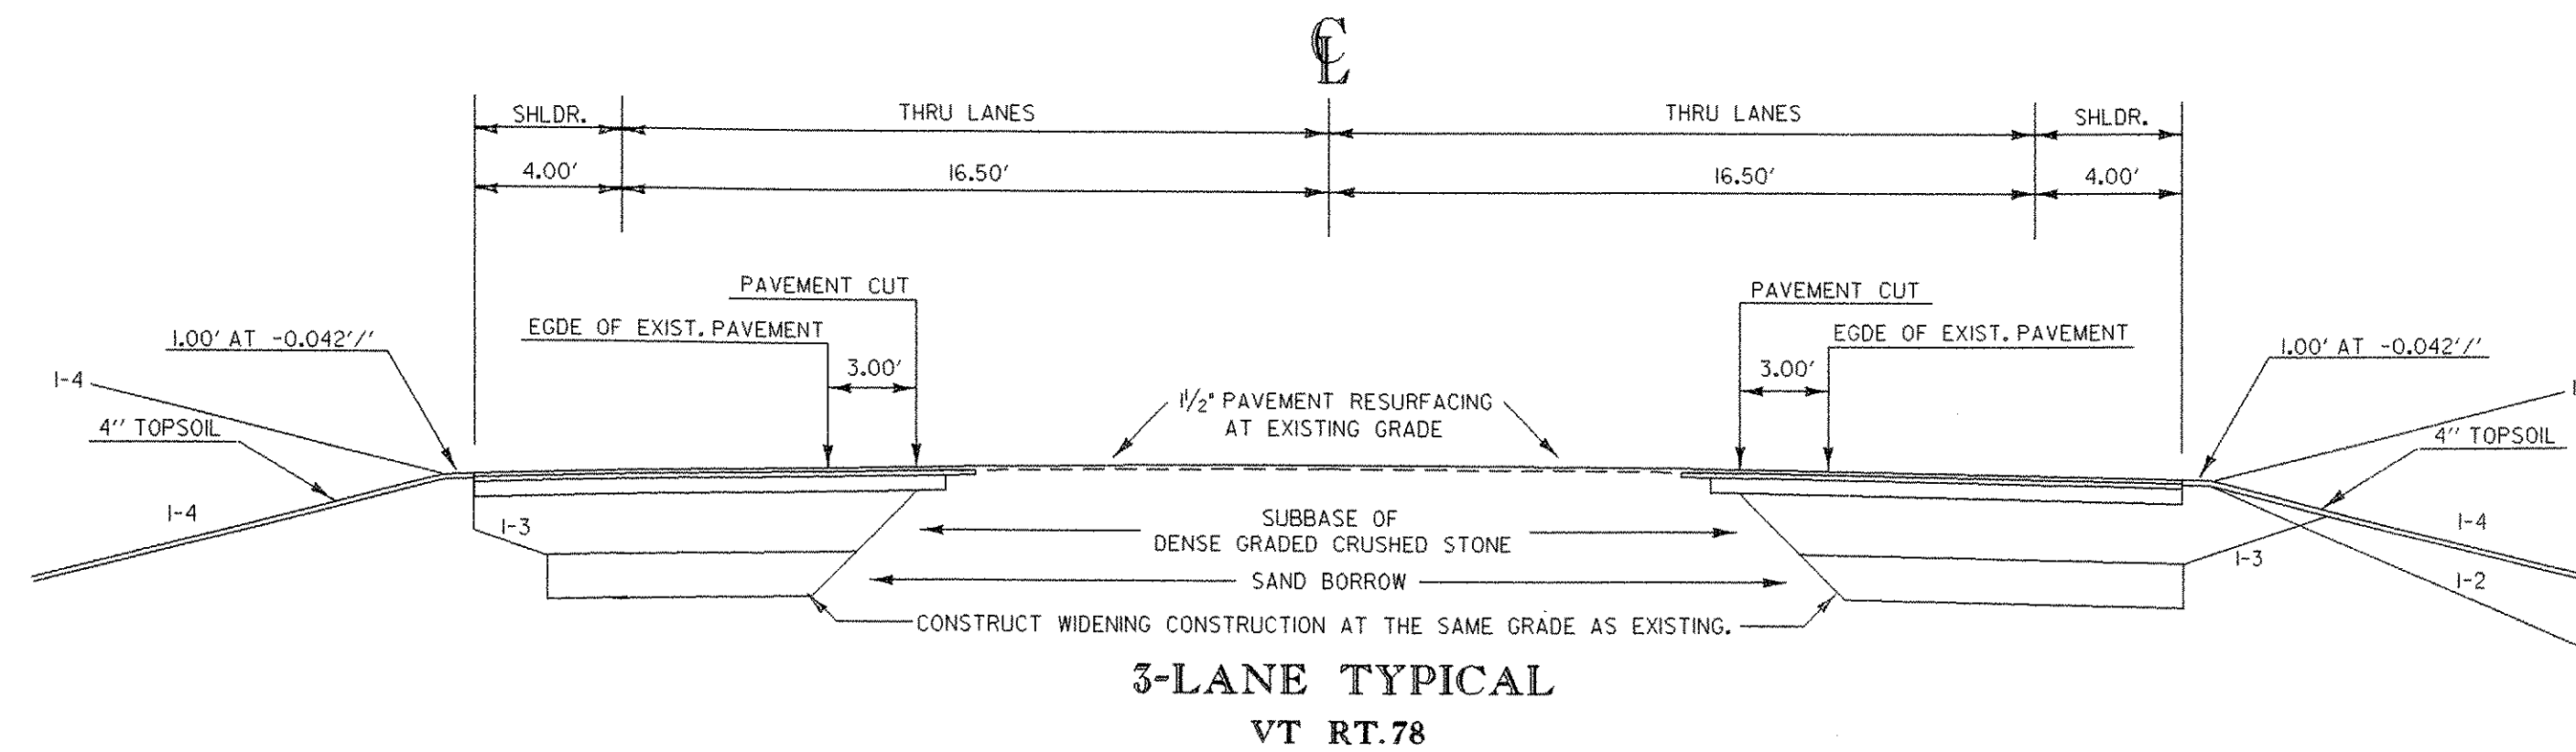

DATUM
 VERTICAL _____
 HORIZONTAL _____

NOT TO SCALE

TYPICAL SECTIONS SHEETS

PROJECT NAME:	SWANTON
PROJECT NUMBER:	STPG ST 036-1(11)
FILE NAME:	PW:\traffic_des\00b501\tp501t1.dgn
PROJECT LEADER:	B. NYQUIST
DESIGNED BY:	TRAFFIC DESIGN
PLOT DATE:	19-APR-2006
DRAWN BY:	TRAFFIC DESIGN
CHECKED BY:	TRAFFIC DESIGN
	SHEET 3 OF 45