


PORTLAND CEMENT CONCRETE SIDEWALK .5 INCH.
 M/L 13+09 RT. ~ 14+38.5 RT. (130')
 M/L 14+30 LT. ~ 14+63 LT. (40')

CAST IN PLACE CONCRETE CURB TYPE B
 M/L 13+09 RT. ~ 14+38.5 RT. (130')
 ELM ST. (55')

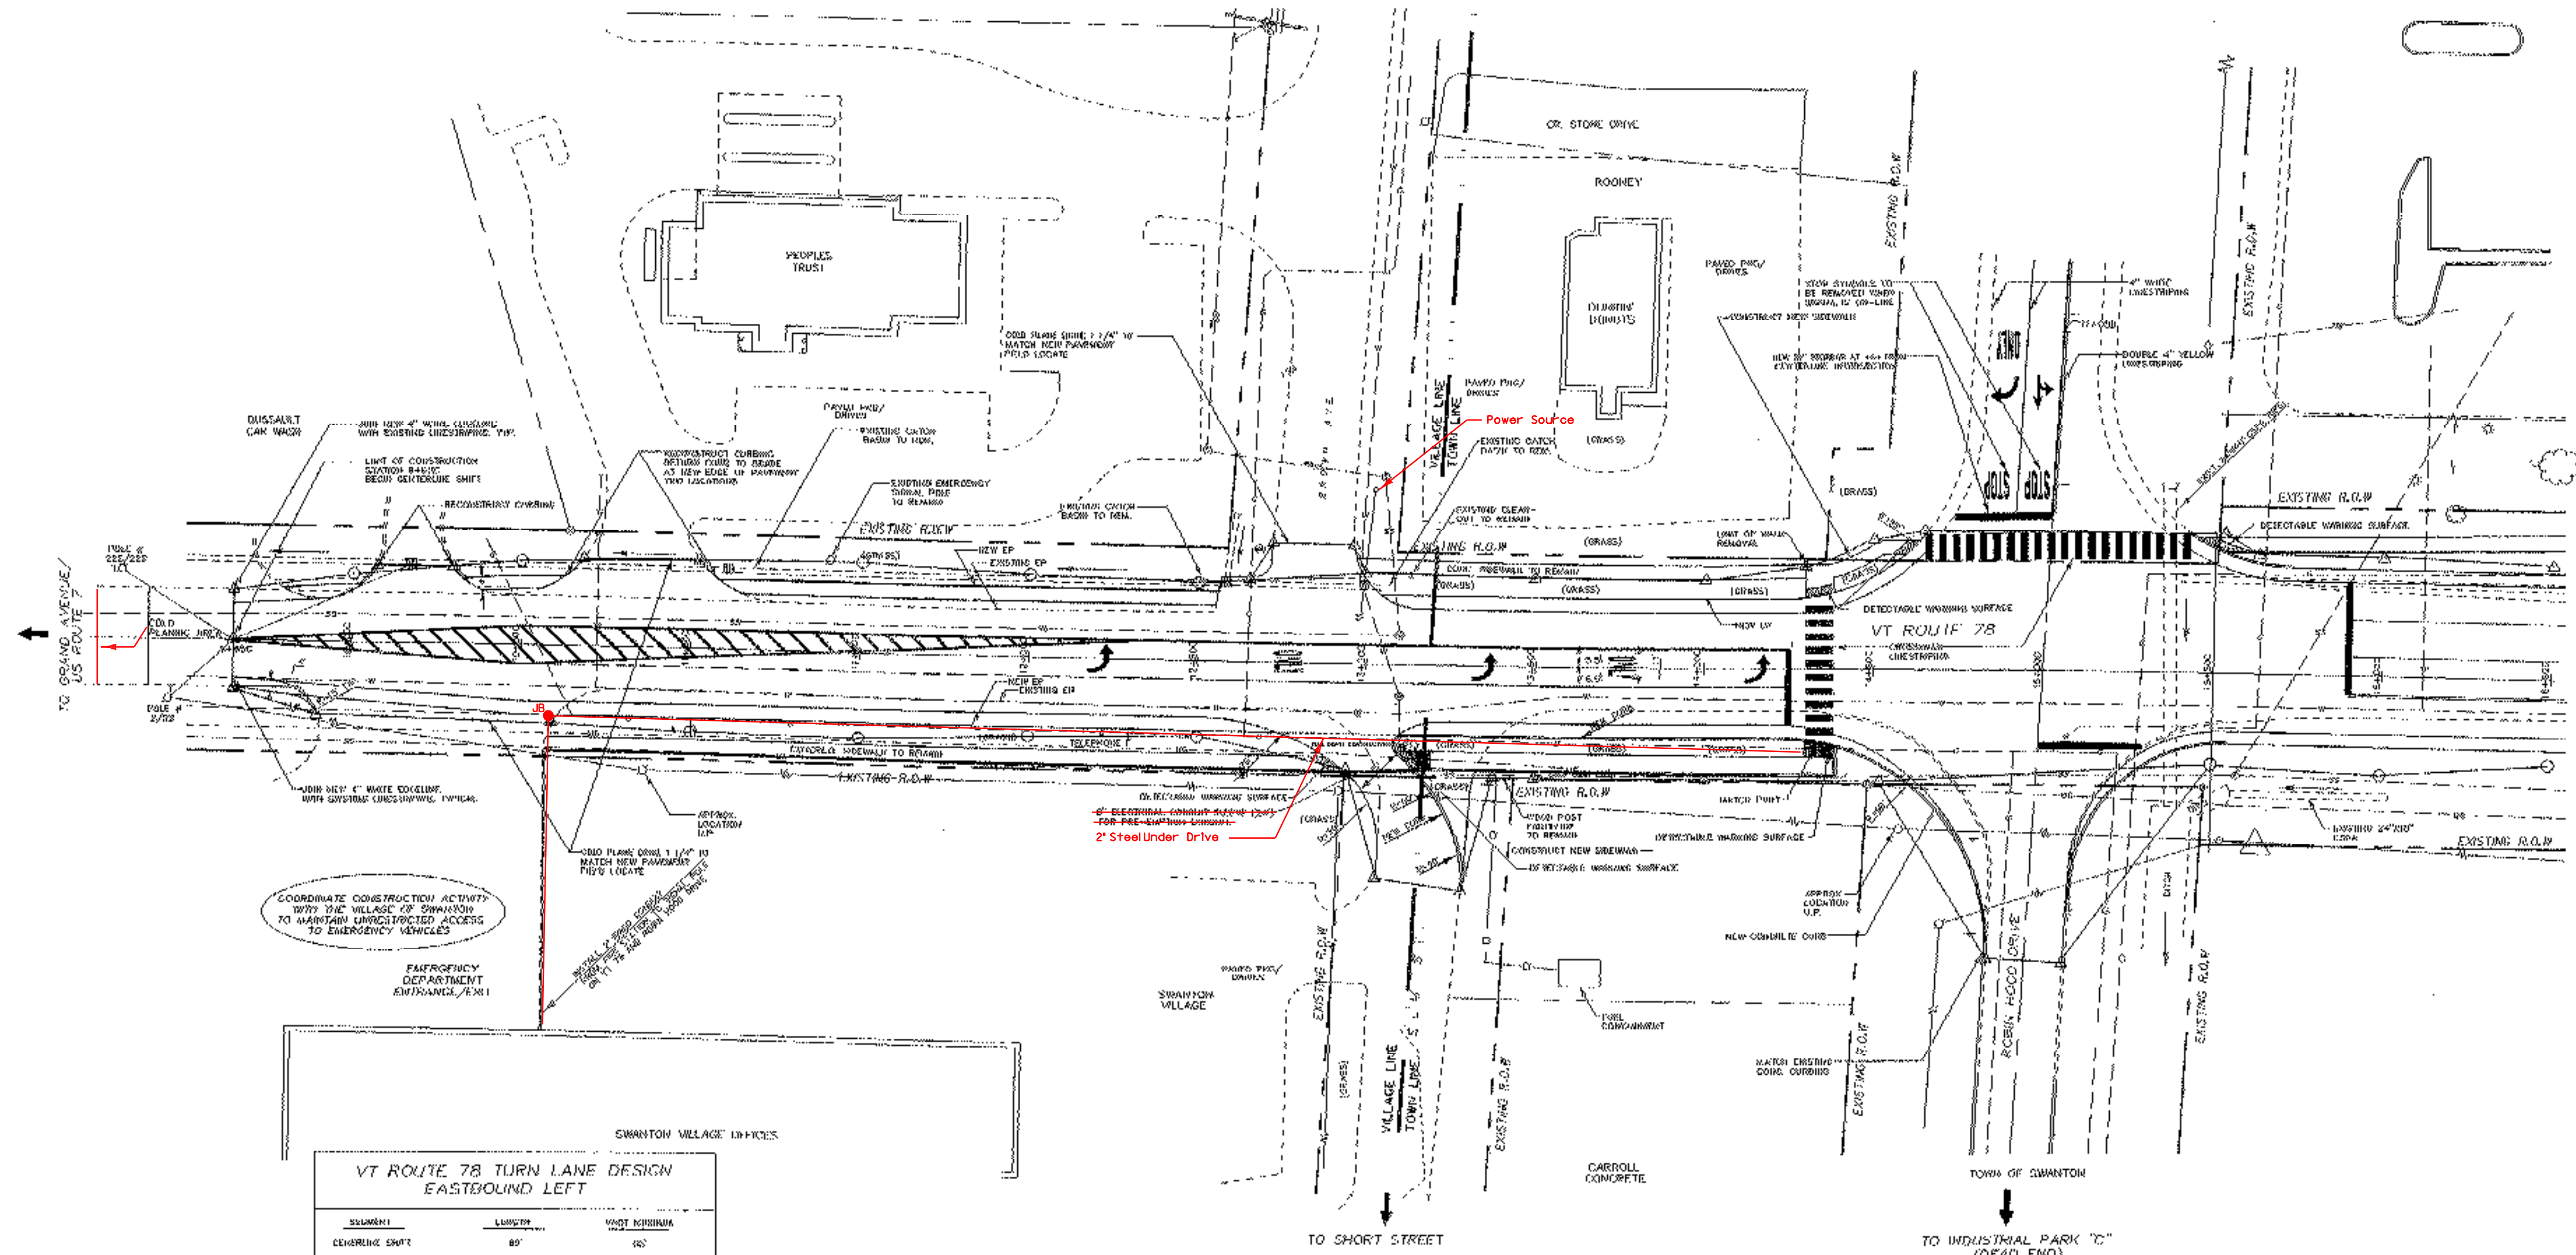

COORDINATE CONSTRUCTION ACTIVITY WITH THE VILLAGE OF SWANTON TO MAINTAIN UNRESTRICTED ACCESS TO EMERGENCY VEHICLES
 EMERGENCY DEPARTMENT ENTRANCE (R/W)

SWANTON VILLAGE OFFICES

VT ROUTE 78 TURN LANE DESIGN EASTBOUND LEFT

ELEMENT	LENGTH	WAST RESERVE
ENTERING CURVE	80'	60'
TAPER	100'	100'
SECURE LANEWAY	70'	70' PER SIGNAL 'D'
ADDITIONAL STICKAGE FOR DECELERATION	125'	125'
TOTAL LENGTH	380'	400'

SCALE 1" = 30'-0"
 30 0 30

PLAN SHEET

PROJECT NAME:	SWANTON		
PROJECT NUMBER:	STPG ST 036-1011		
FILE NAME:	FW-TRAFFIC_DES-100250\101101.DGN	DATE:	19-APR-2006
PROJECT LEADER:	B. NYQUIST	DRAWN BY:	TRAFFIC DESIGN
DESIGNED BY:	TRAFFIC DESIGN	CHECKED BY:	TRAFFIC DESIGN
		SHEET	6 OF 25