


15+47.00 RT.
~~15+42.60 RT.~~
 MAST ARM #4 VT. 78 LOOKING EAST

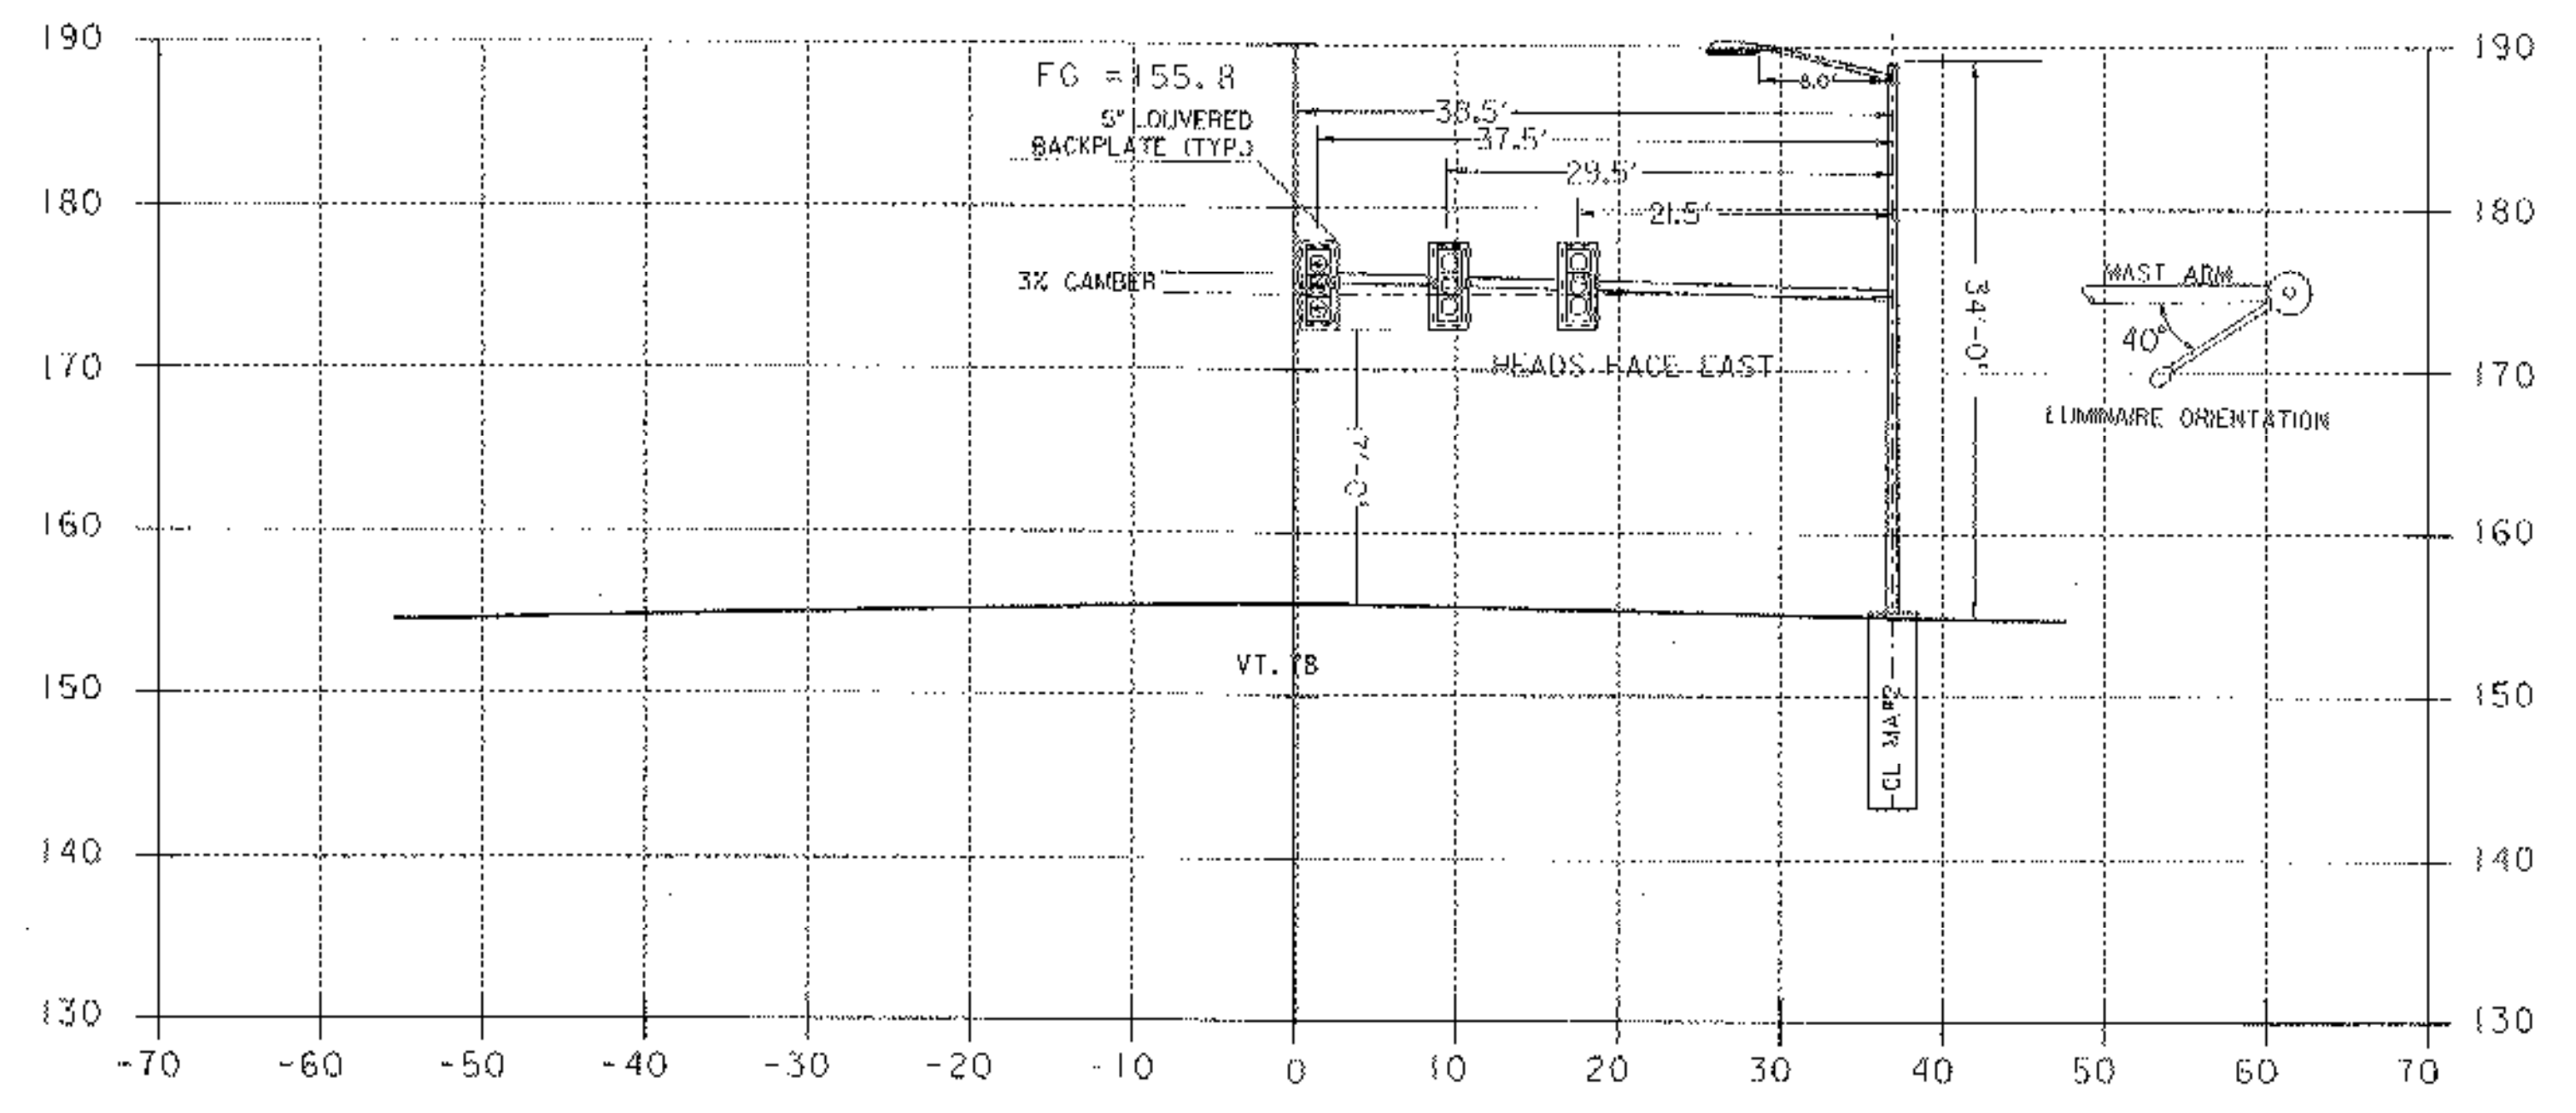

14+42 LT.
 MAST ARM #2 VT. 78 LOOKING WEST

TRAFFIC SHEET

PROJECT NAME:	SWANTON		
PROJECT NUMBER:	STPG ST 036-101		
FILE NAME:	d:\2006\stpg\trf\trf036-101.dgn	PLOT DATE:	19-APR-2006
PROJECT LEADER:	D. NYQUIST	DRAWN BY:	TRAFFIC DESIGN
DESIGNED BY:	TRAFFIC DESIGN	CHECKED BY:	TRAFFIC DESIGN
	N:\501\gs2.i	SHEET	18 OF 45