



FINAL CONDITION LAYOUT

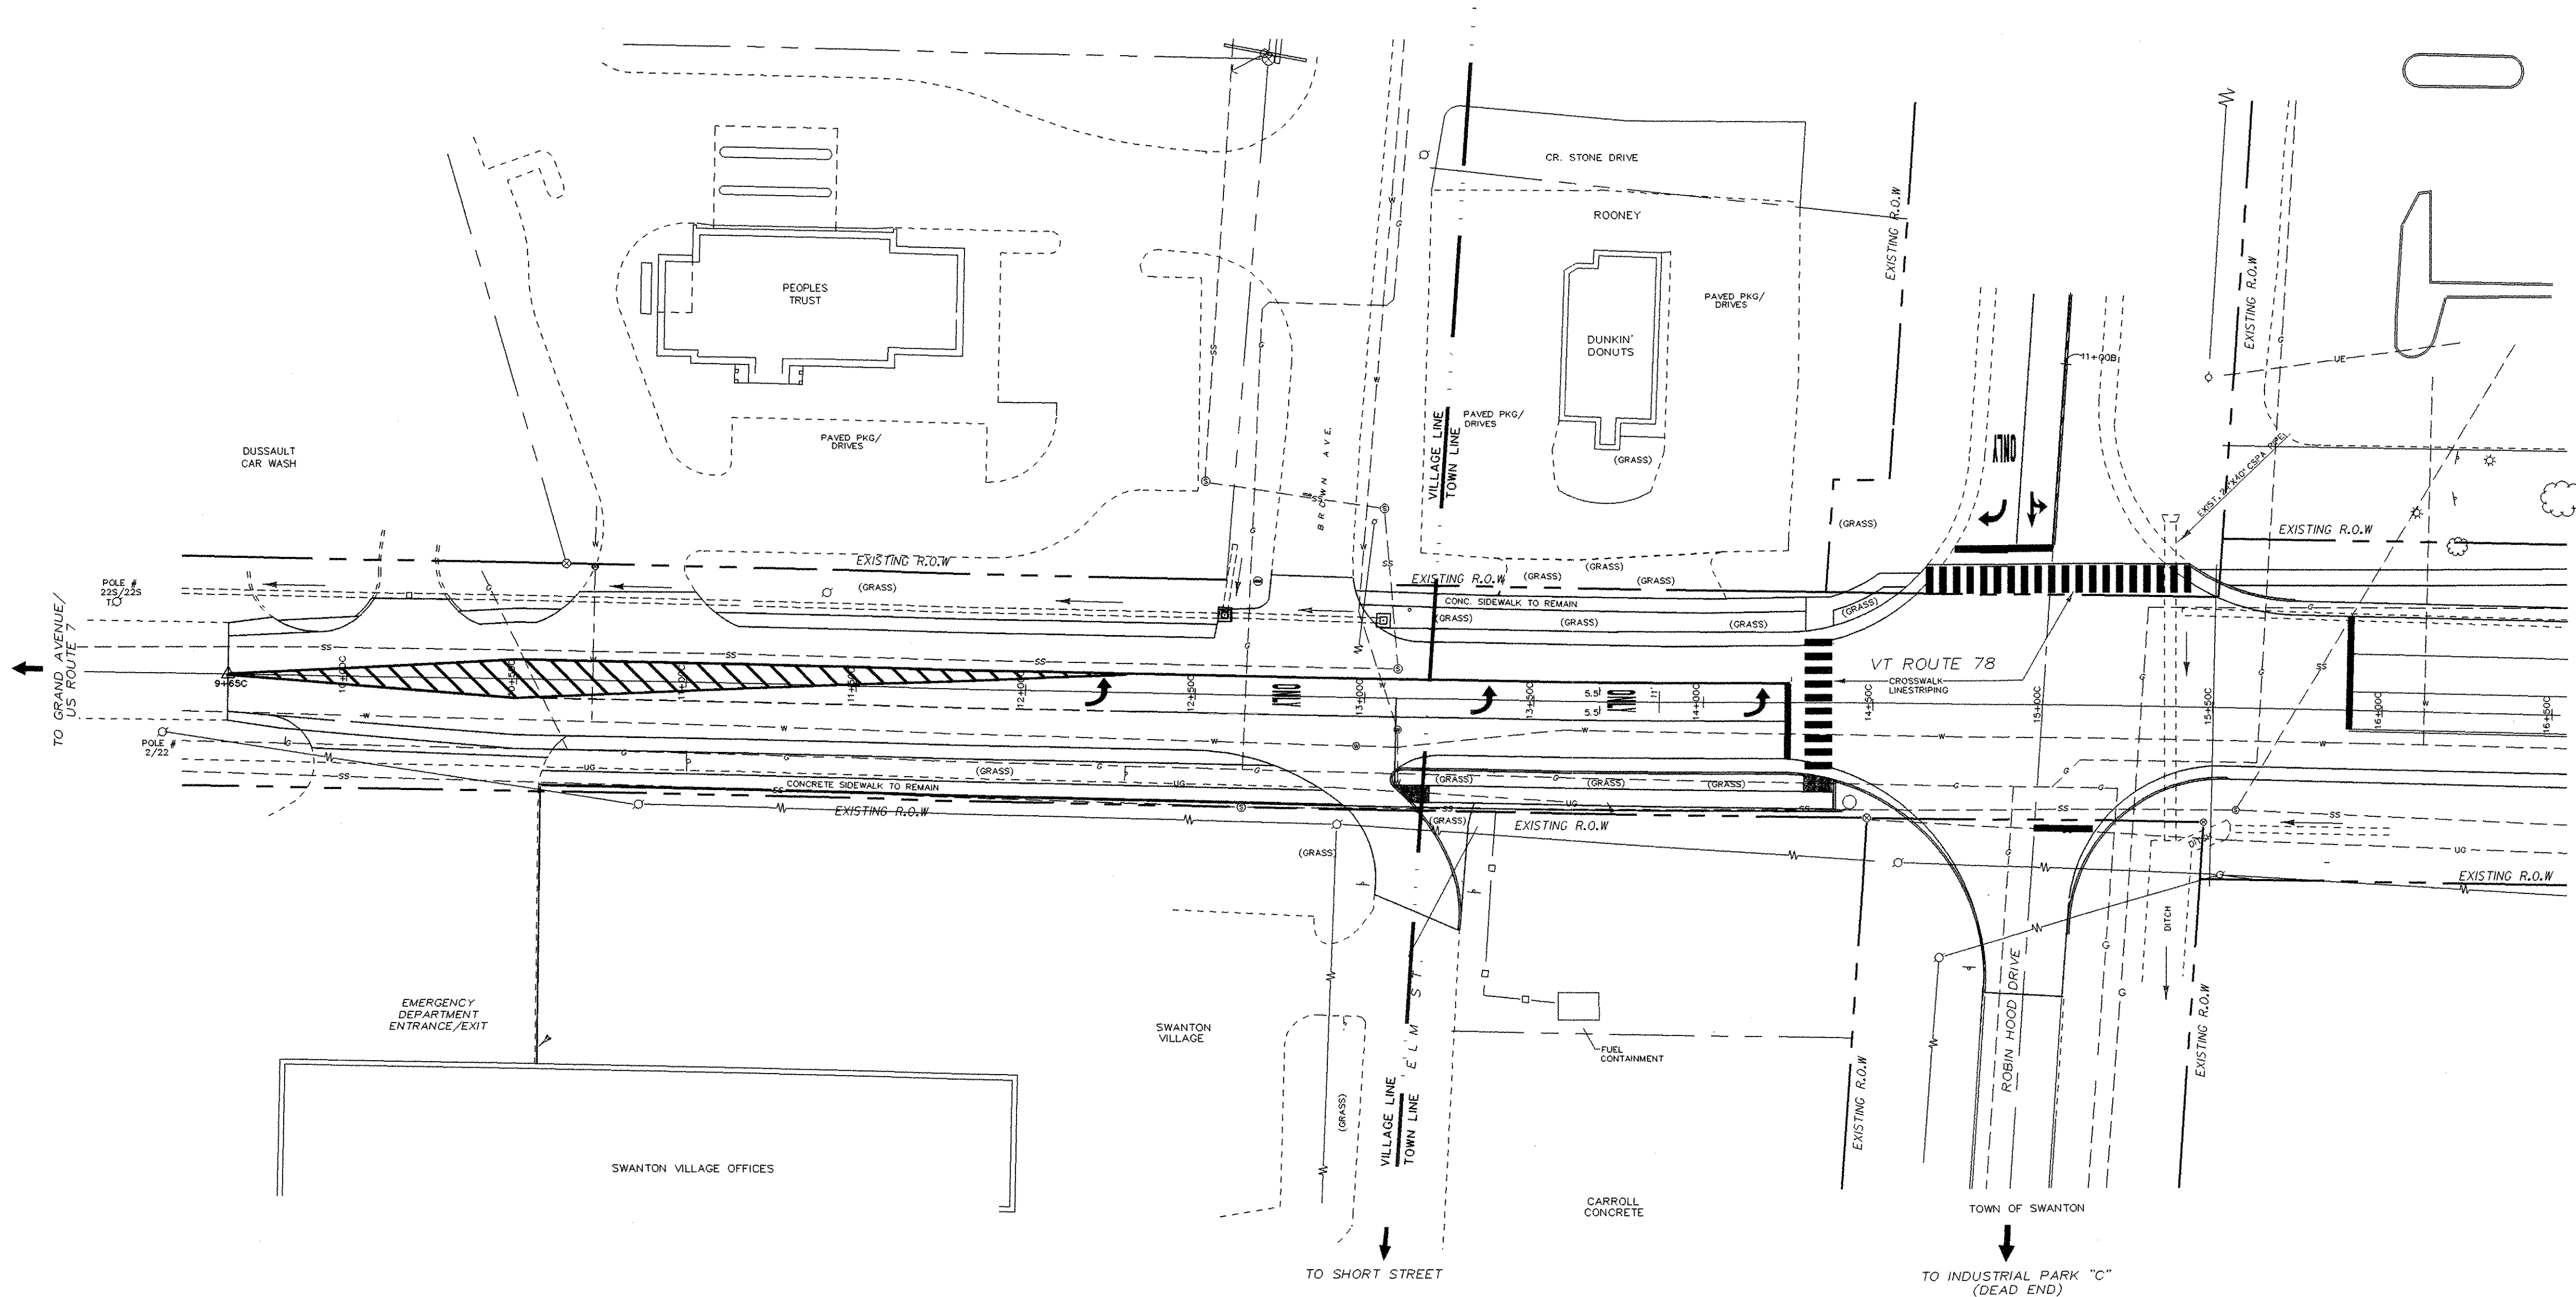

FINAL CONDITIONS SHEET

PROJECT NAME:	SWANTON		
PROJECT NUMBER:	STPG ST 036-1(1)		
FILE NAME:	P:\TRAFFIC_DES\006150\101501.DGN		
PLOT DATE:	19-APR-2006		
PROJECT LEADER:	B. NYQUIST	DRAWN BY:	TRAFFIC DESIGN
DESIGNED BY:	TRAFFIC DESIGN	CHECKED BY:	TRAFFIC DESIGN
		SHEET	29 OF 48

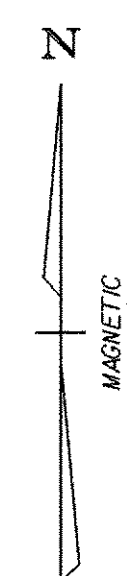