
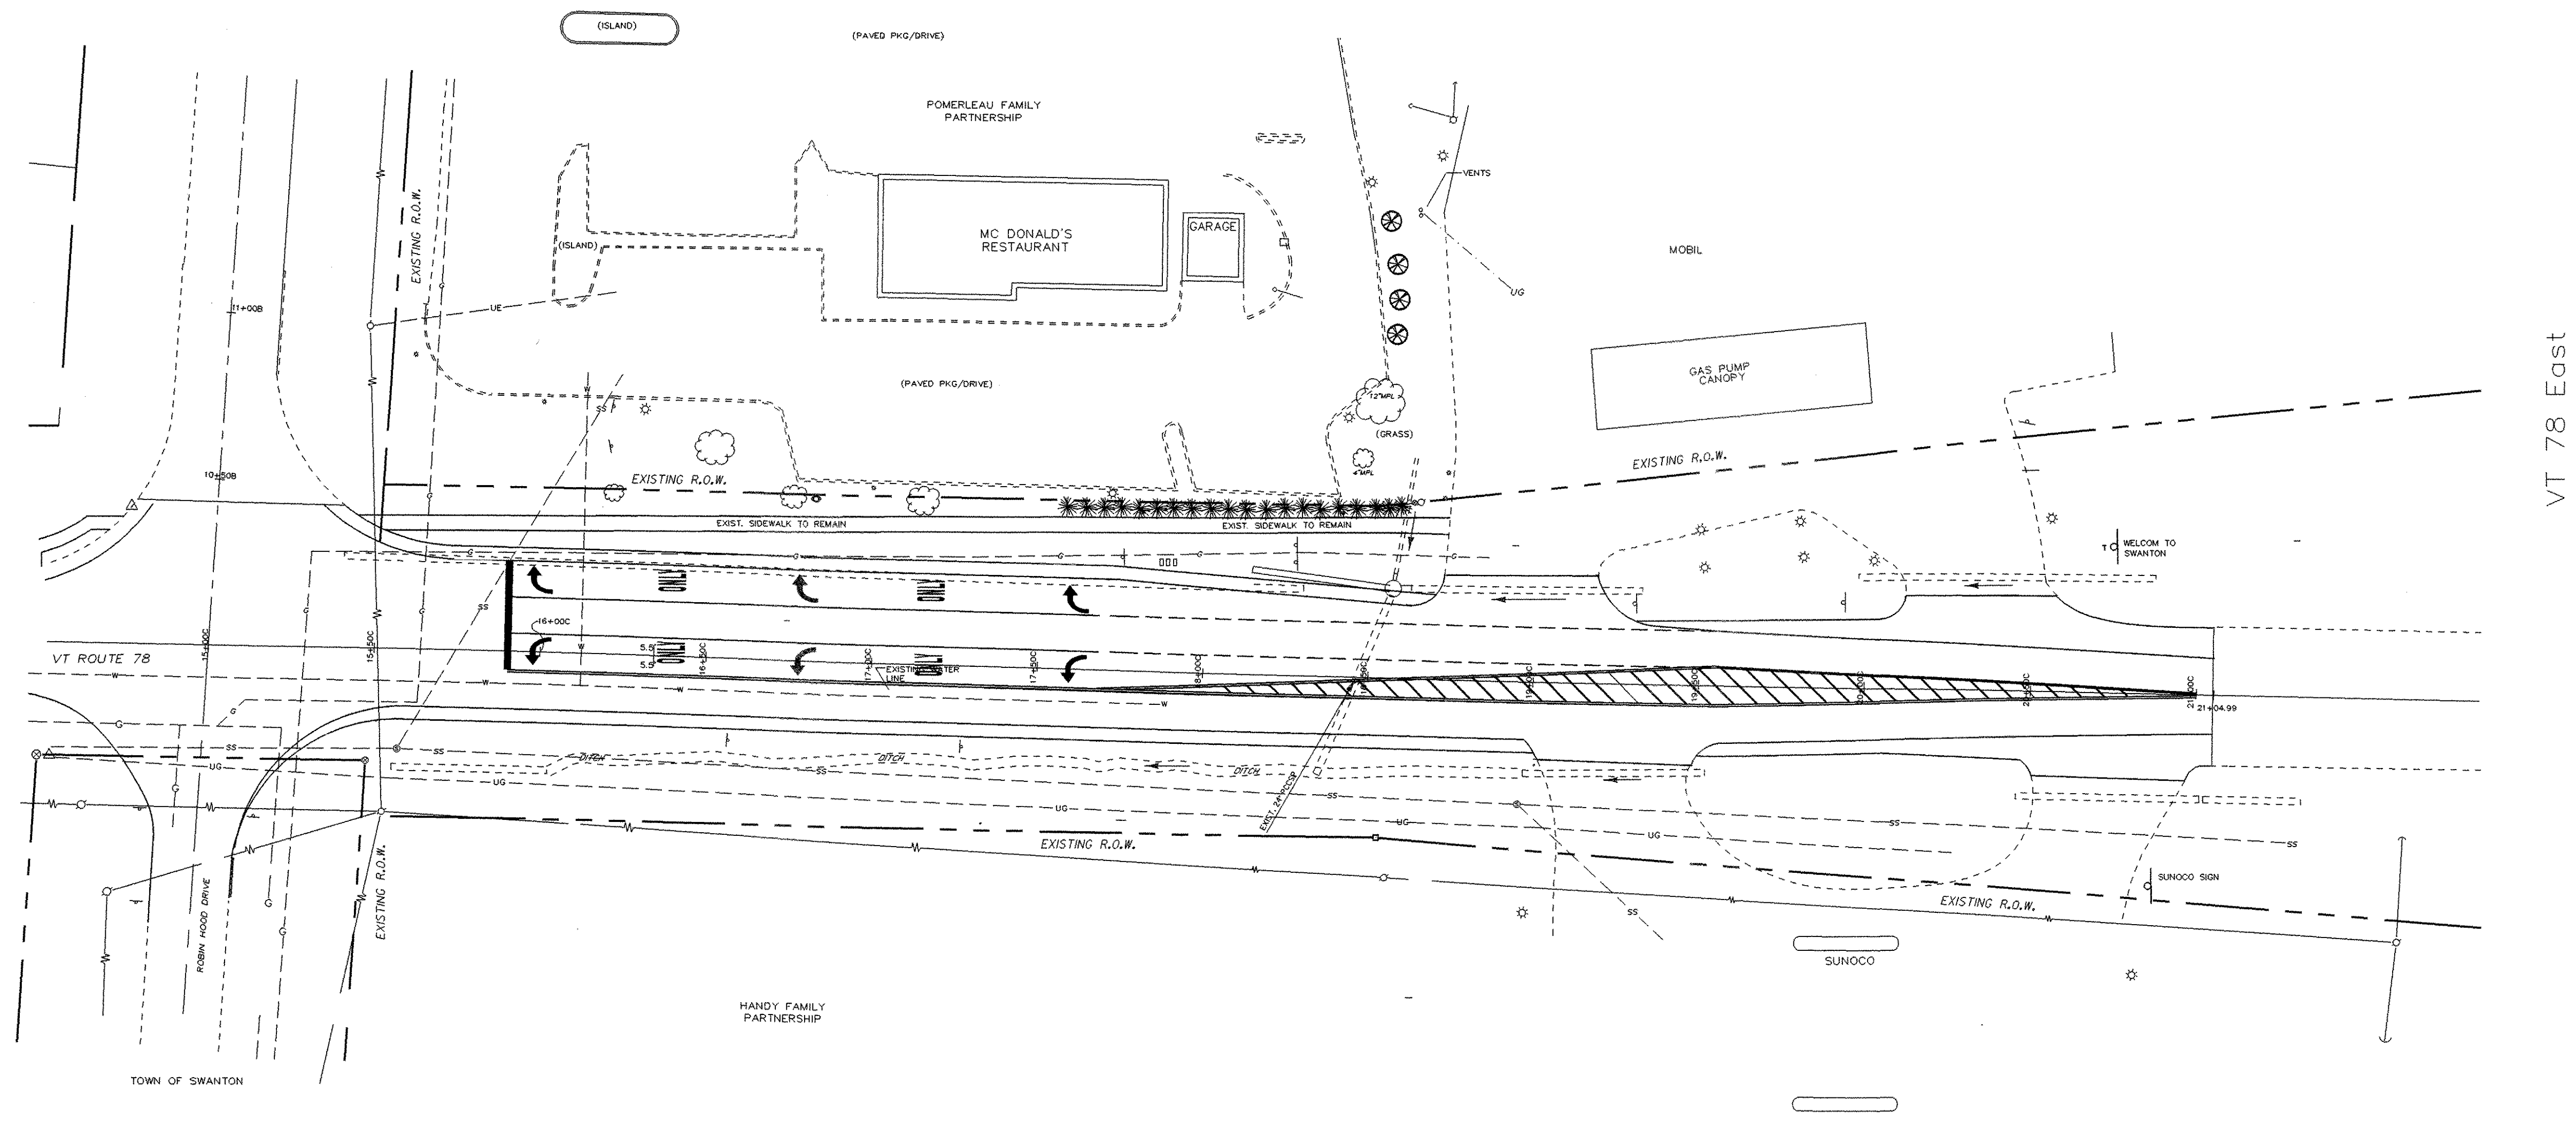


FINAL CONDITION LAYOUT

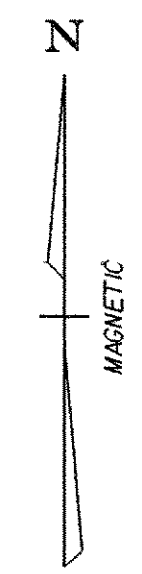

VT 78 East

FINAL CONDITIONS SHEET

PROJECT NAME:	SWANTON	FILE NAME:	P:\00b150\traffic\layout2.dgn	PLOT DATE:	19-APR-2006
PROJECT NUMBER:	STPG ST 036-1(11)	PROJECT LEADER:	B. NYQUIST	DRAWN BY:	TRAFFIC DESIGN
		DESIGNED BY:	TRAFFIC DESIGN	CHECKED BY:	TRAFFIC DESIGN
			tbl50ec08.l1	SHEET	32 OF 45

