




STATION 16+50C

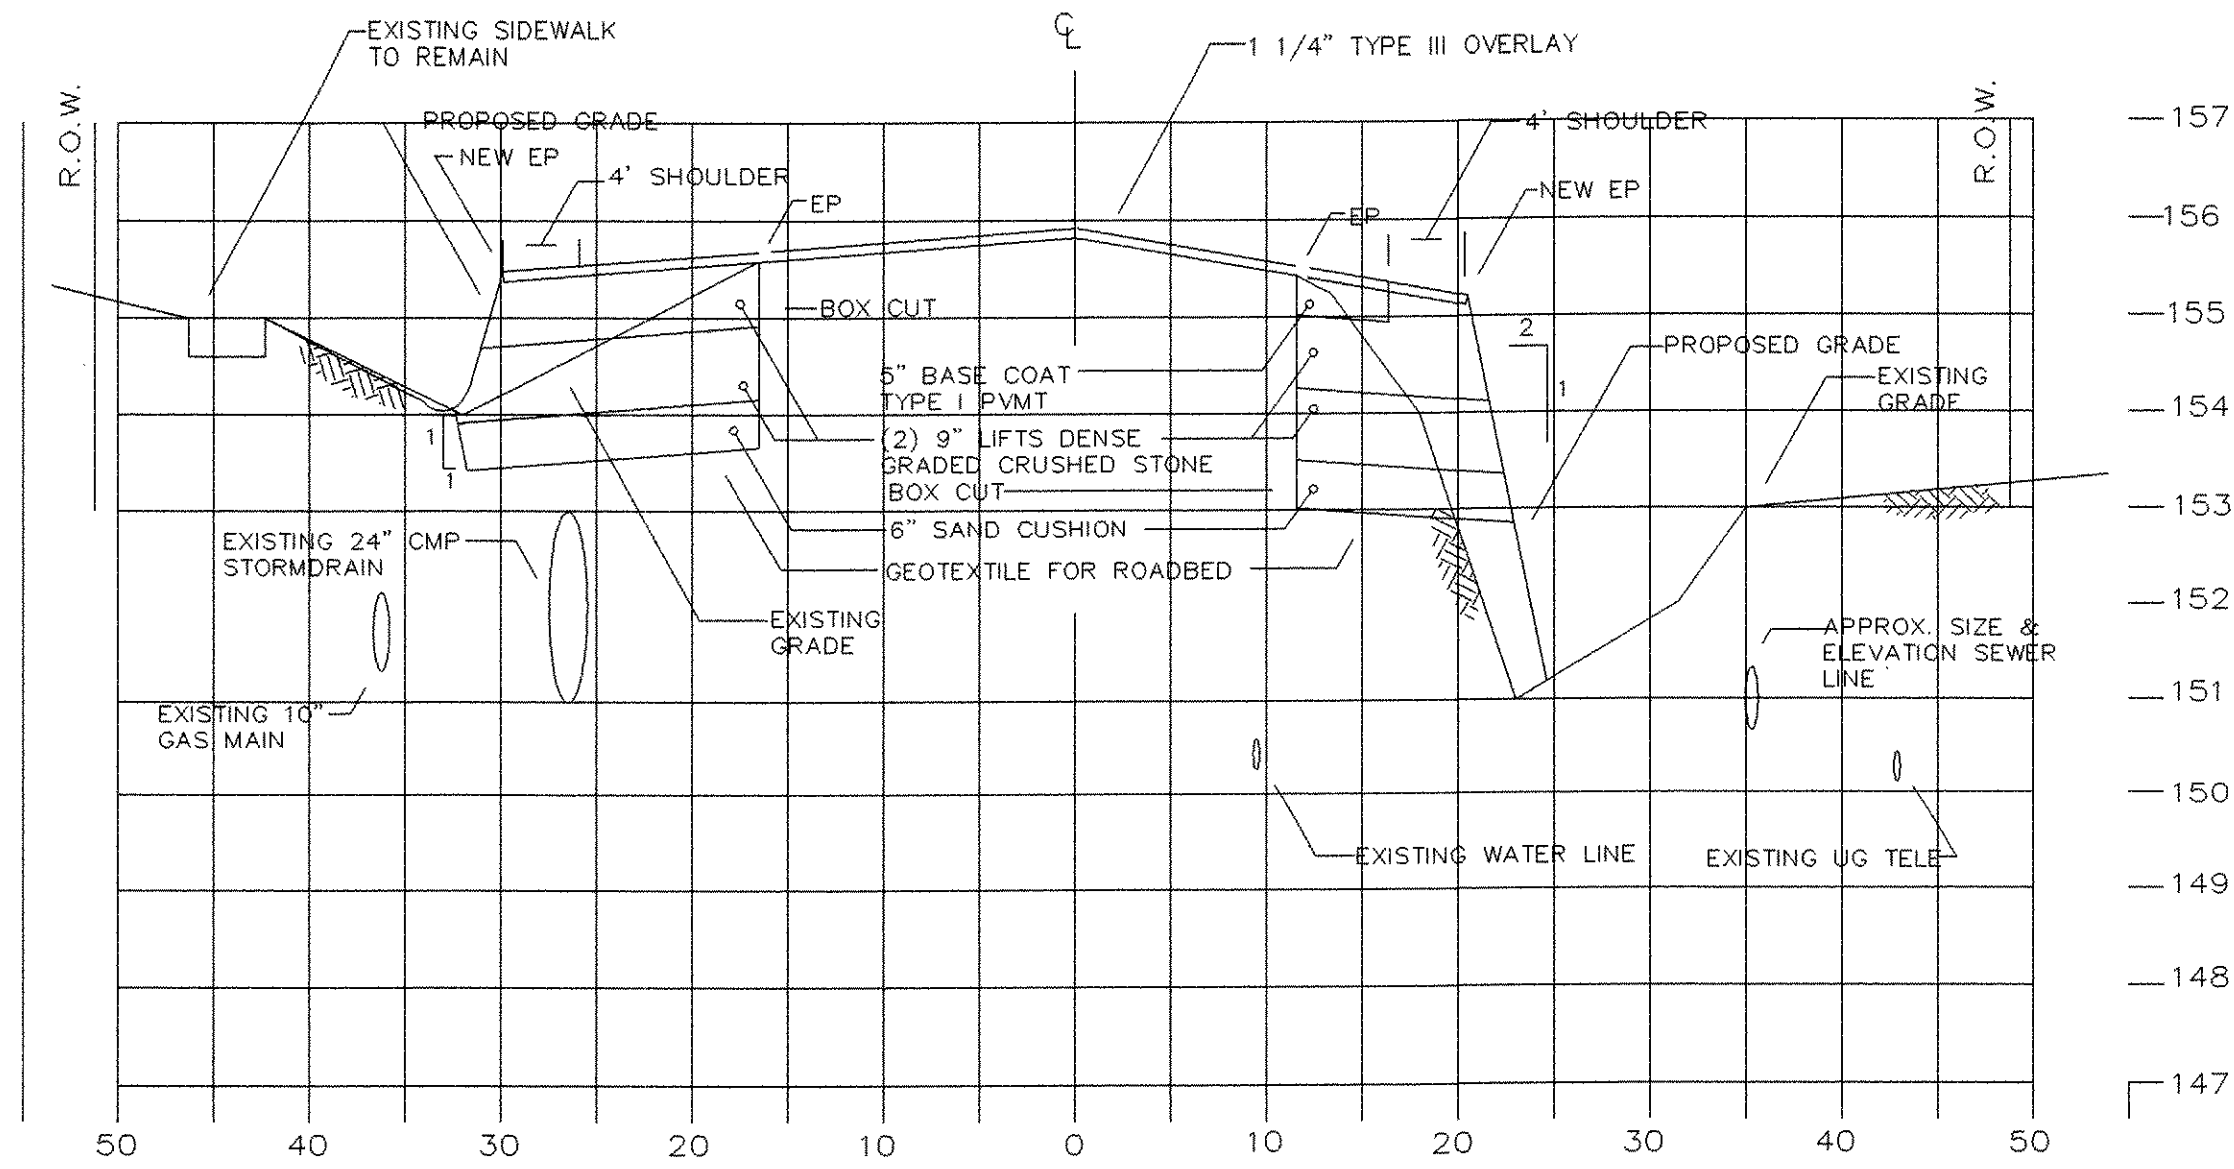


STATION 18+00C

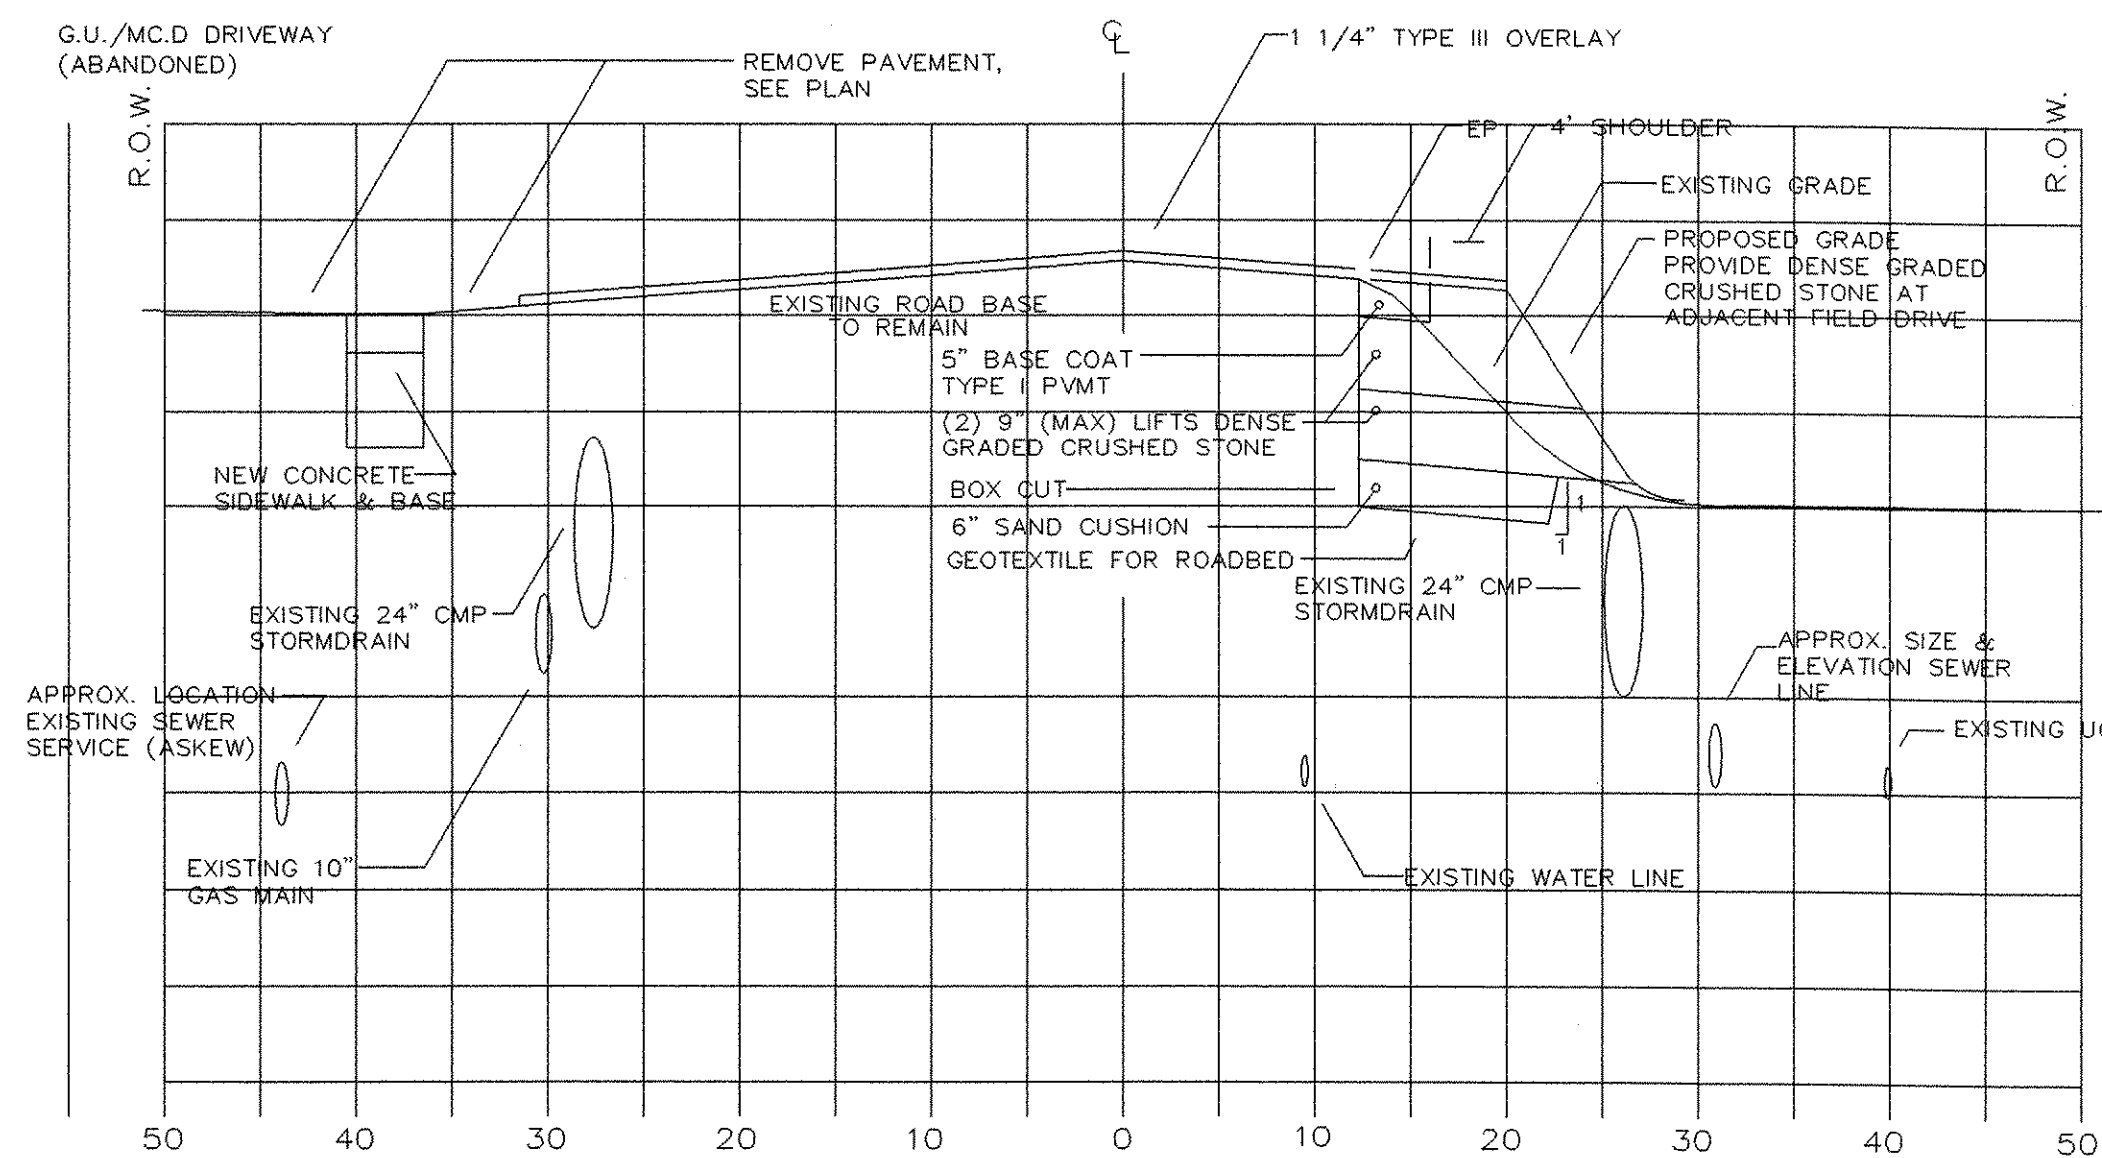


STATION 16+00C

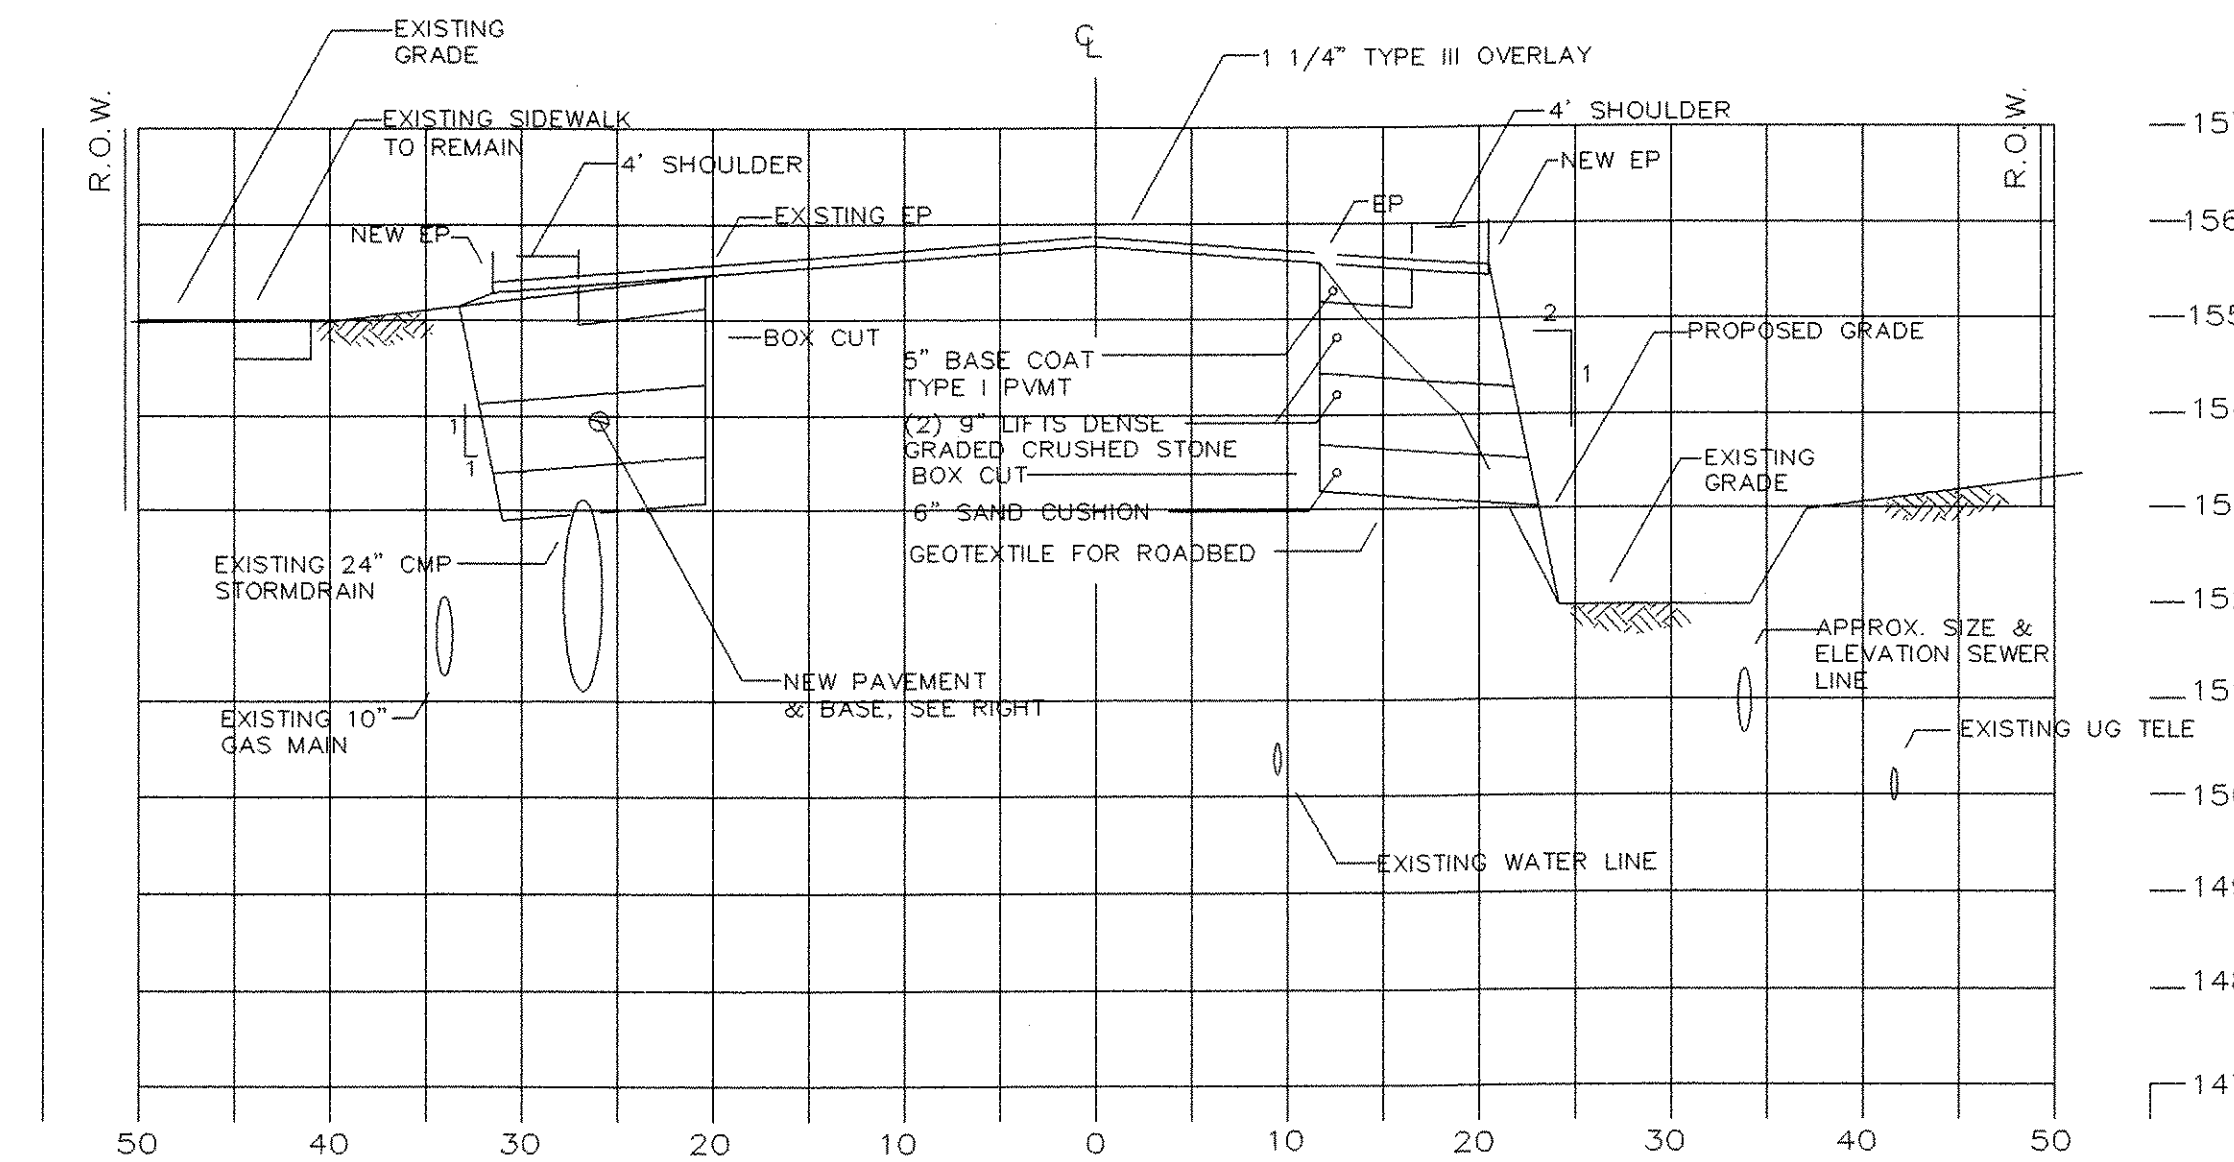


STATION 17+50C

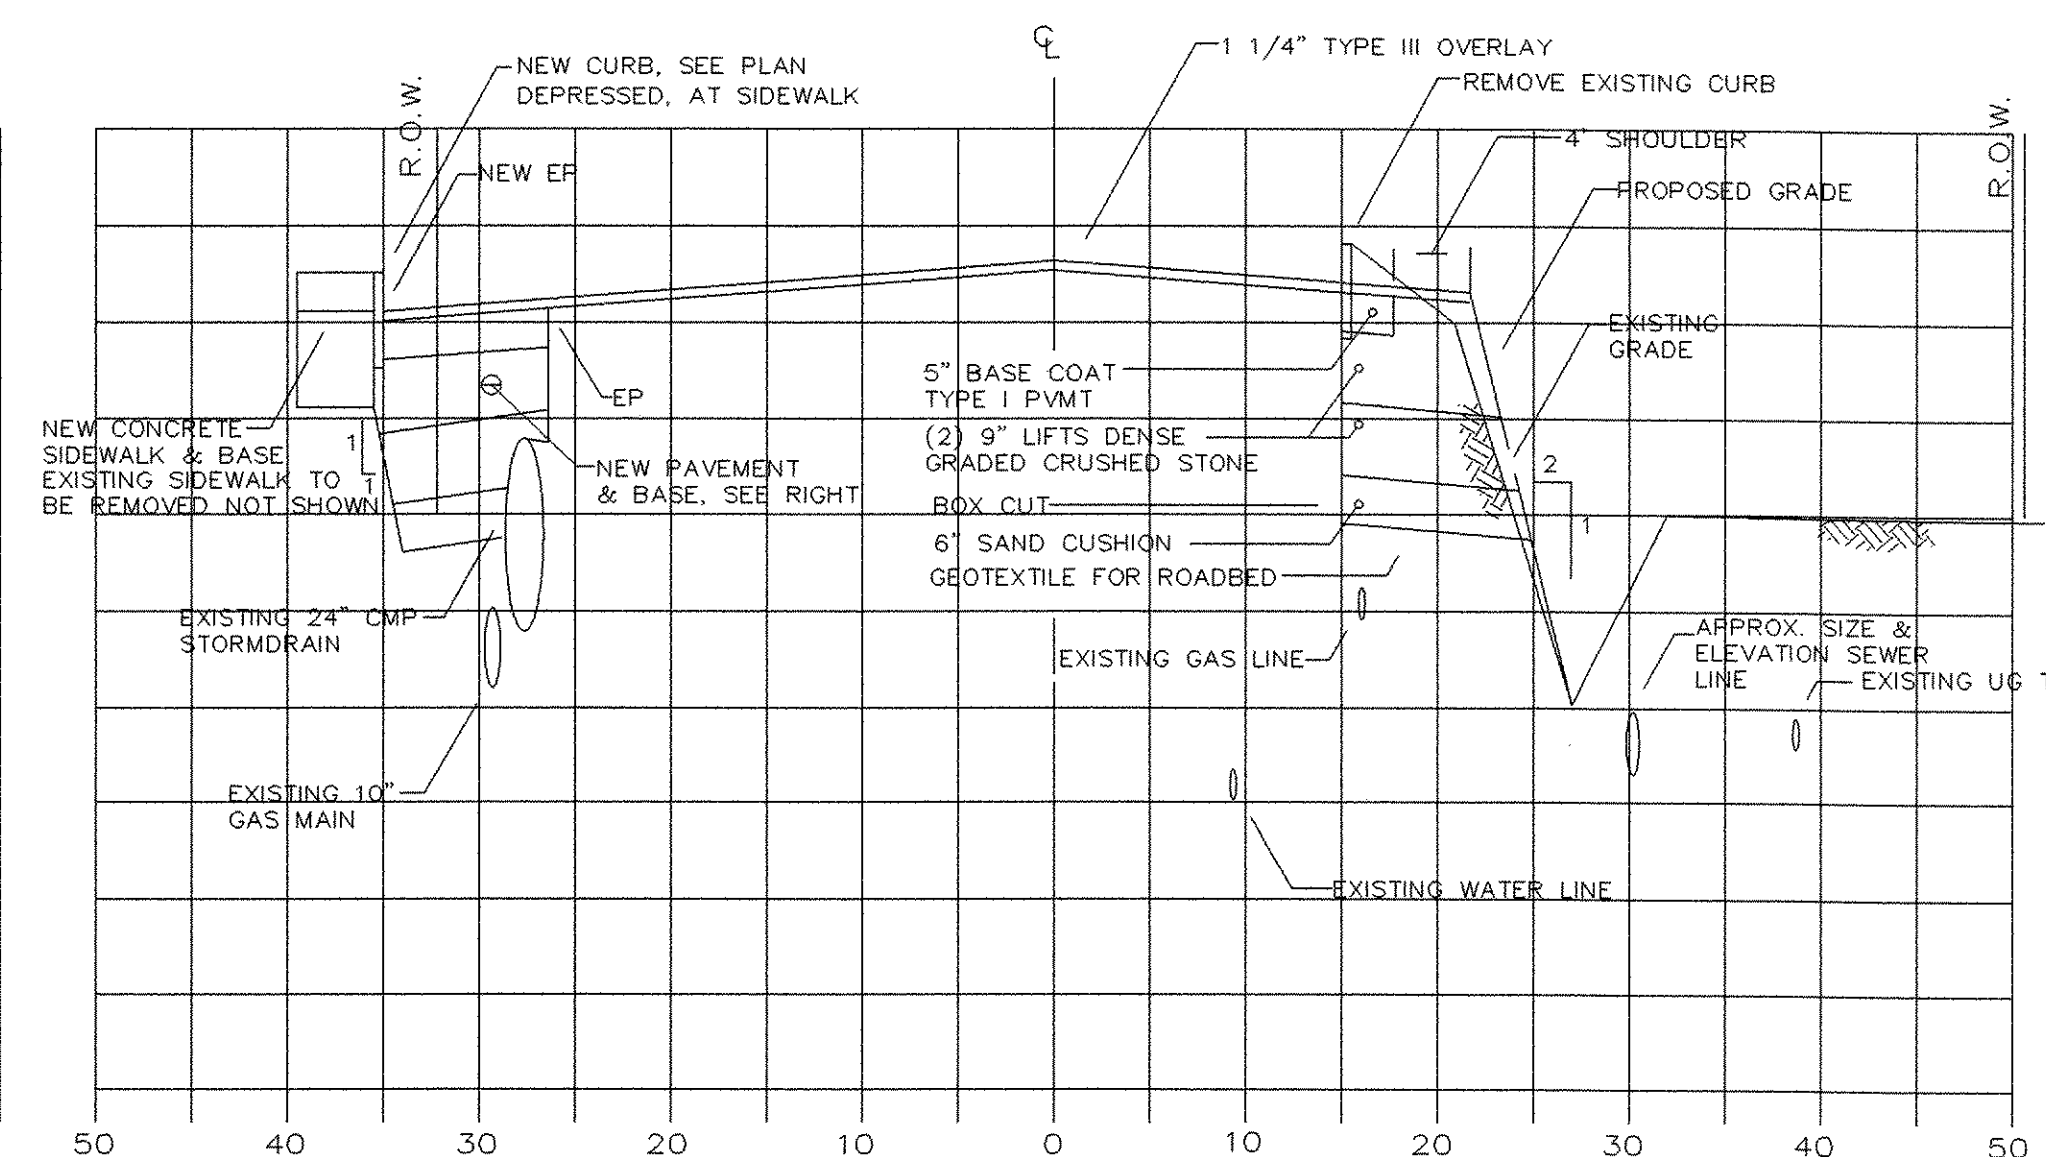

STATION 15+50C

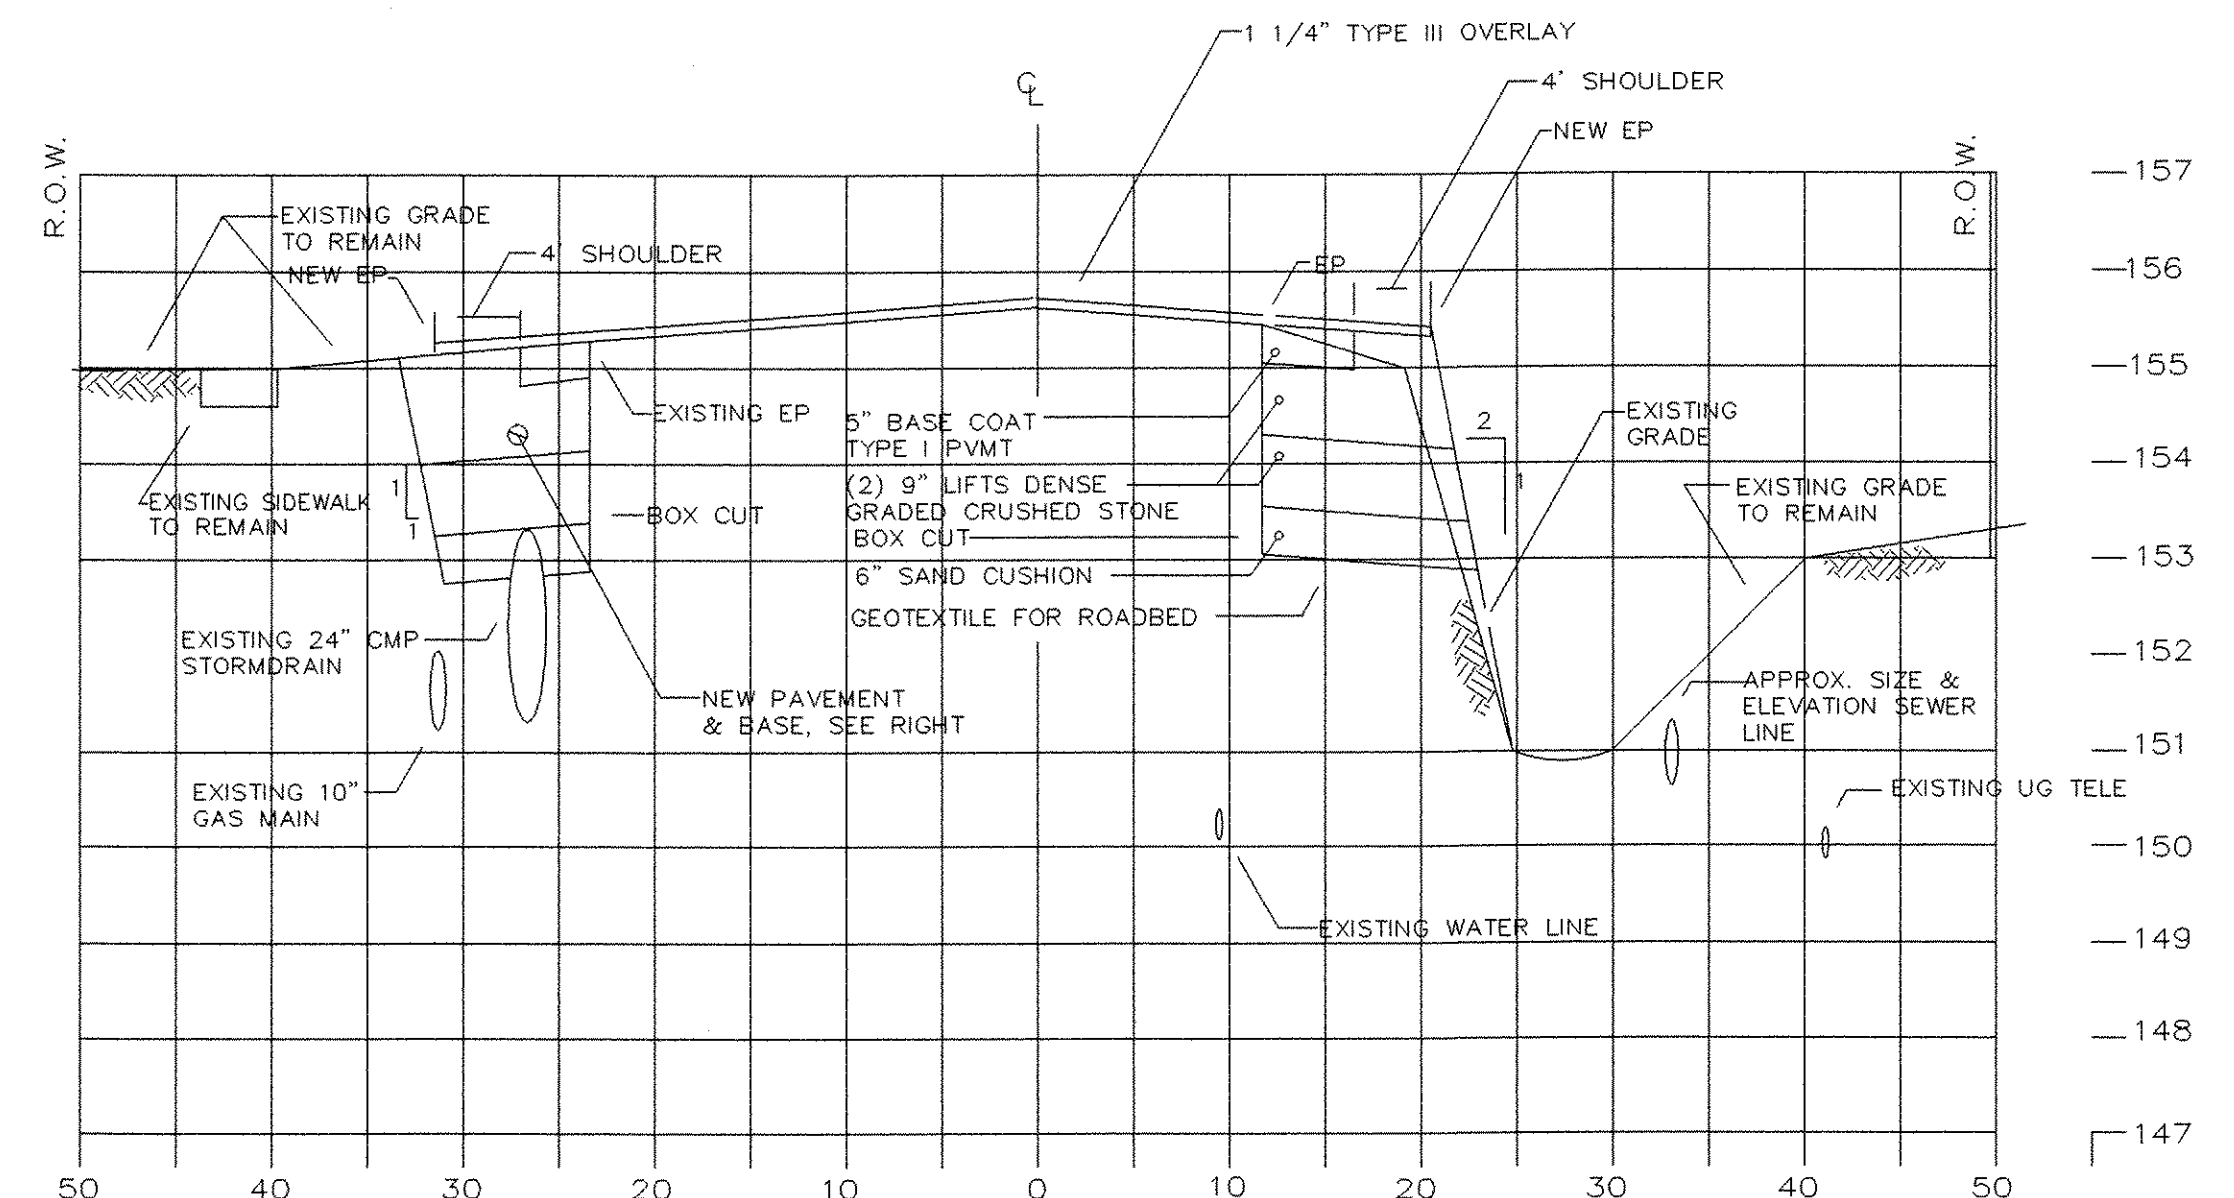

STATION 17+00C

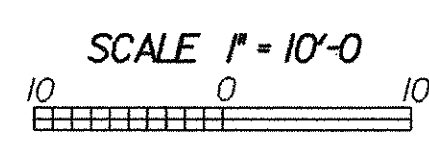

**VT.78 CROSS SECTION SHEET 15+50~18+00**

PROJECT NAME: **SWANTON**  
 PROJECT NUMBER: **STPG ST 036-1(11)**

FILE NAME: PMS /00b105/TRAFFIC DES./tbi50xs.dgn PLOT DATE: 19-APR-2006  
 PROJECT LEADER: **B. NYQUIST** DRAWN BY: TRAFFIC DESIGN  
 DESIGNED BY: TRAFFIC DESIGN CHECKED BY: TRAFFIC DESIGN  
 SHEET 44 OF 45