



STATION 19+00C

NO ROADWAY WIDENING REQUIRED,  
SEE PLAN FOR WORK IN THIS AREA.


STATION 20+00C THRU 21+05C

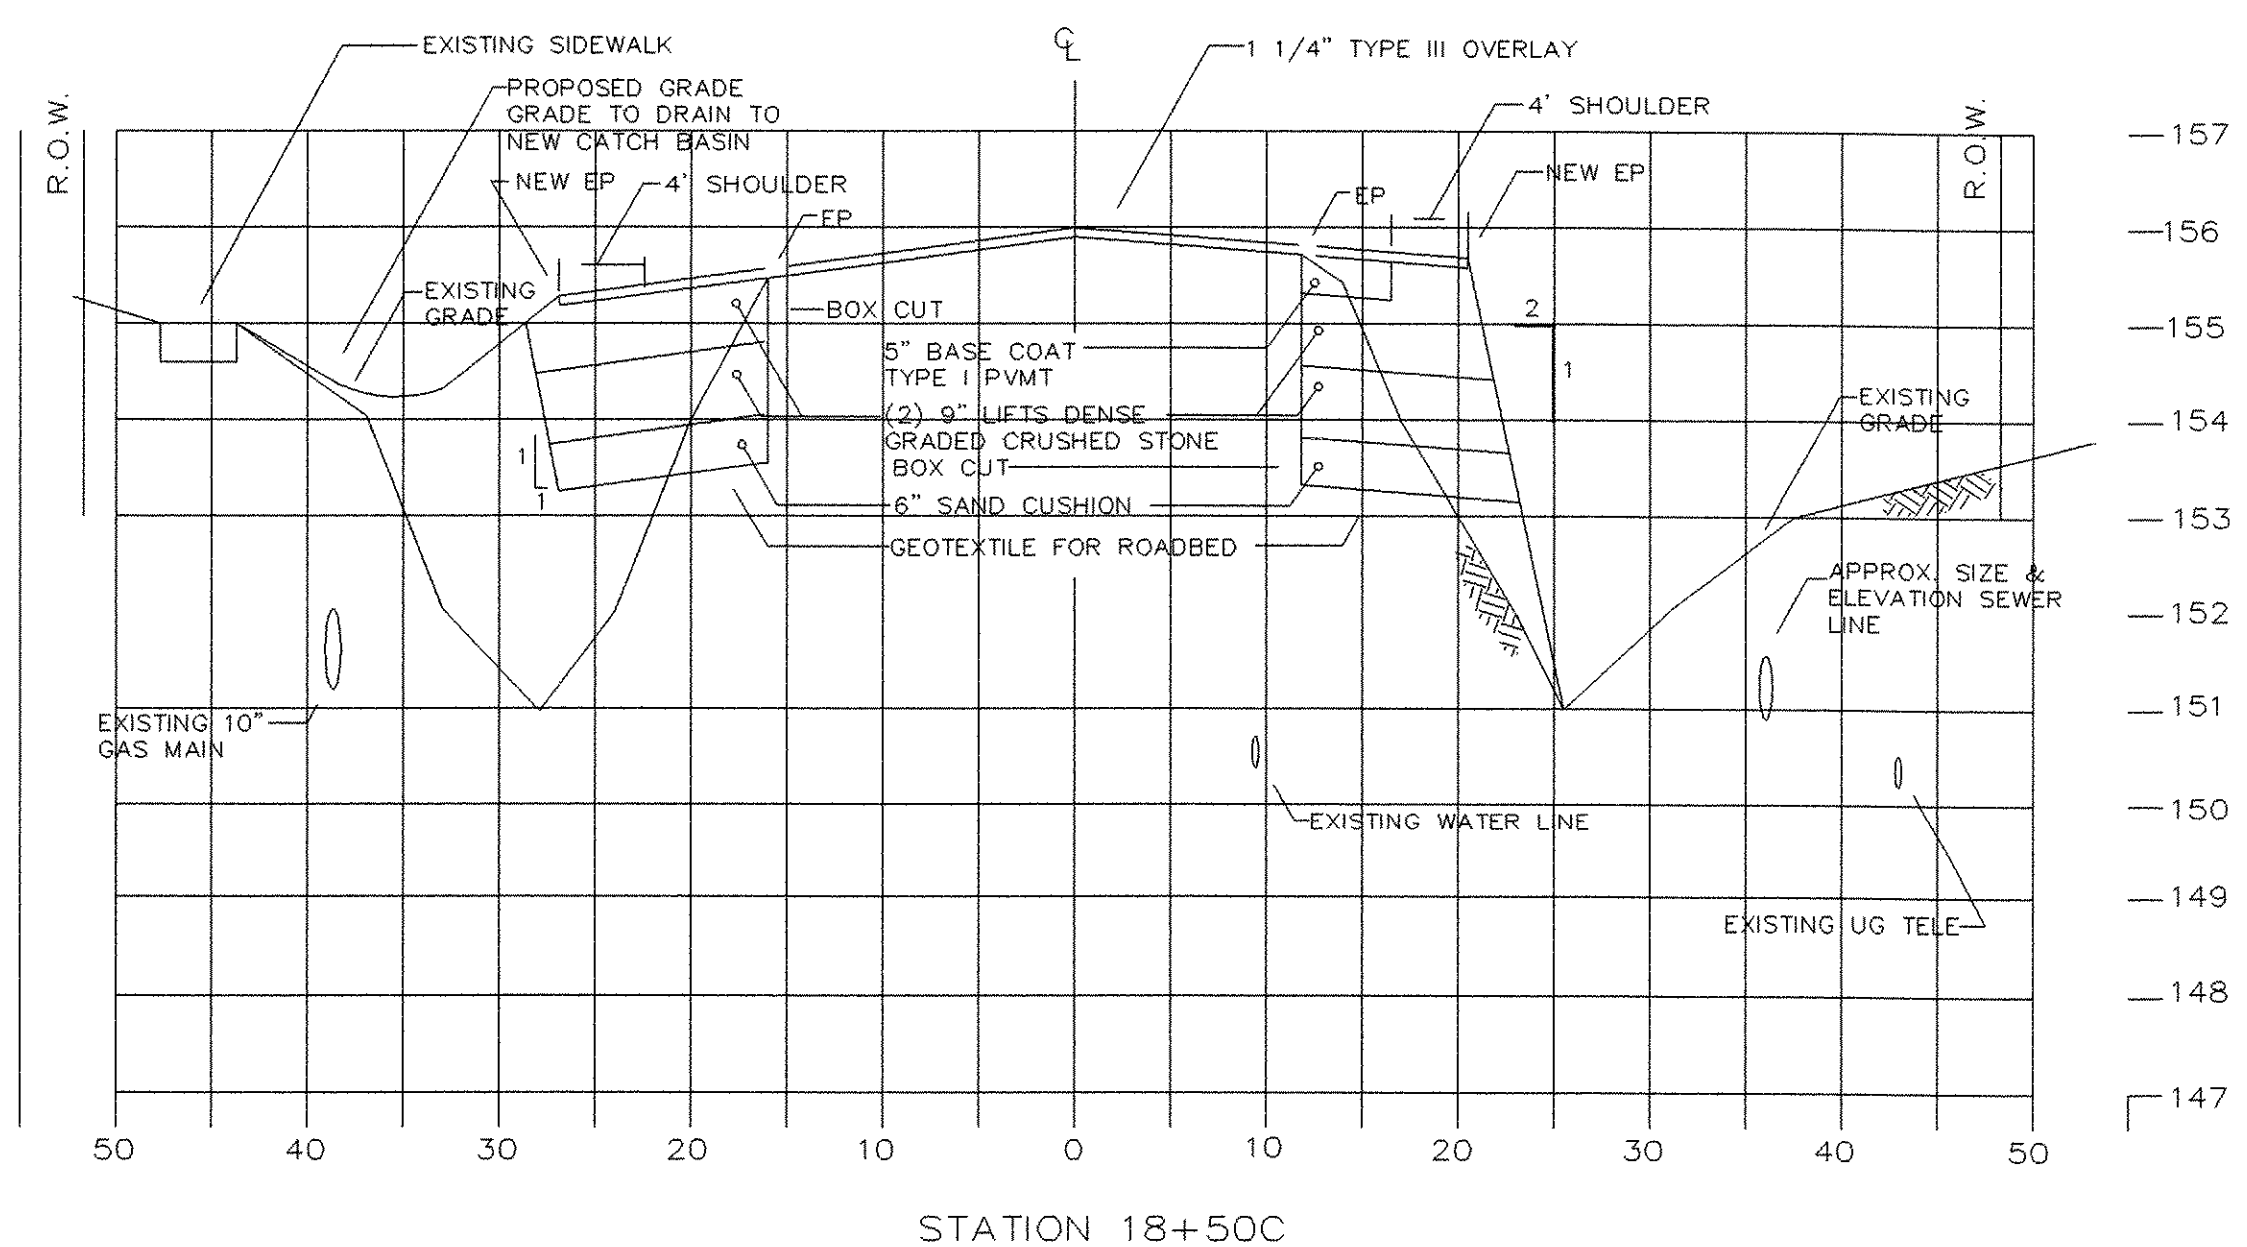

STATION 18+50C

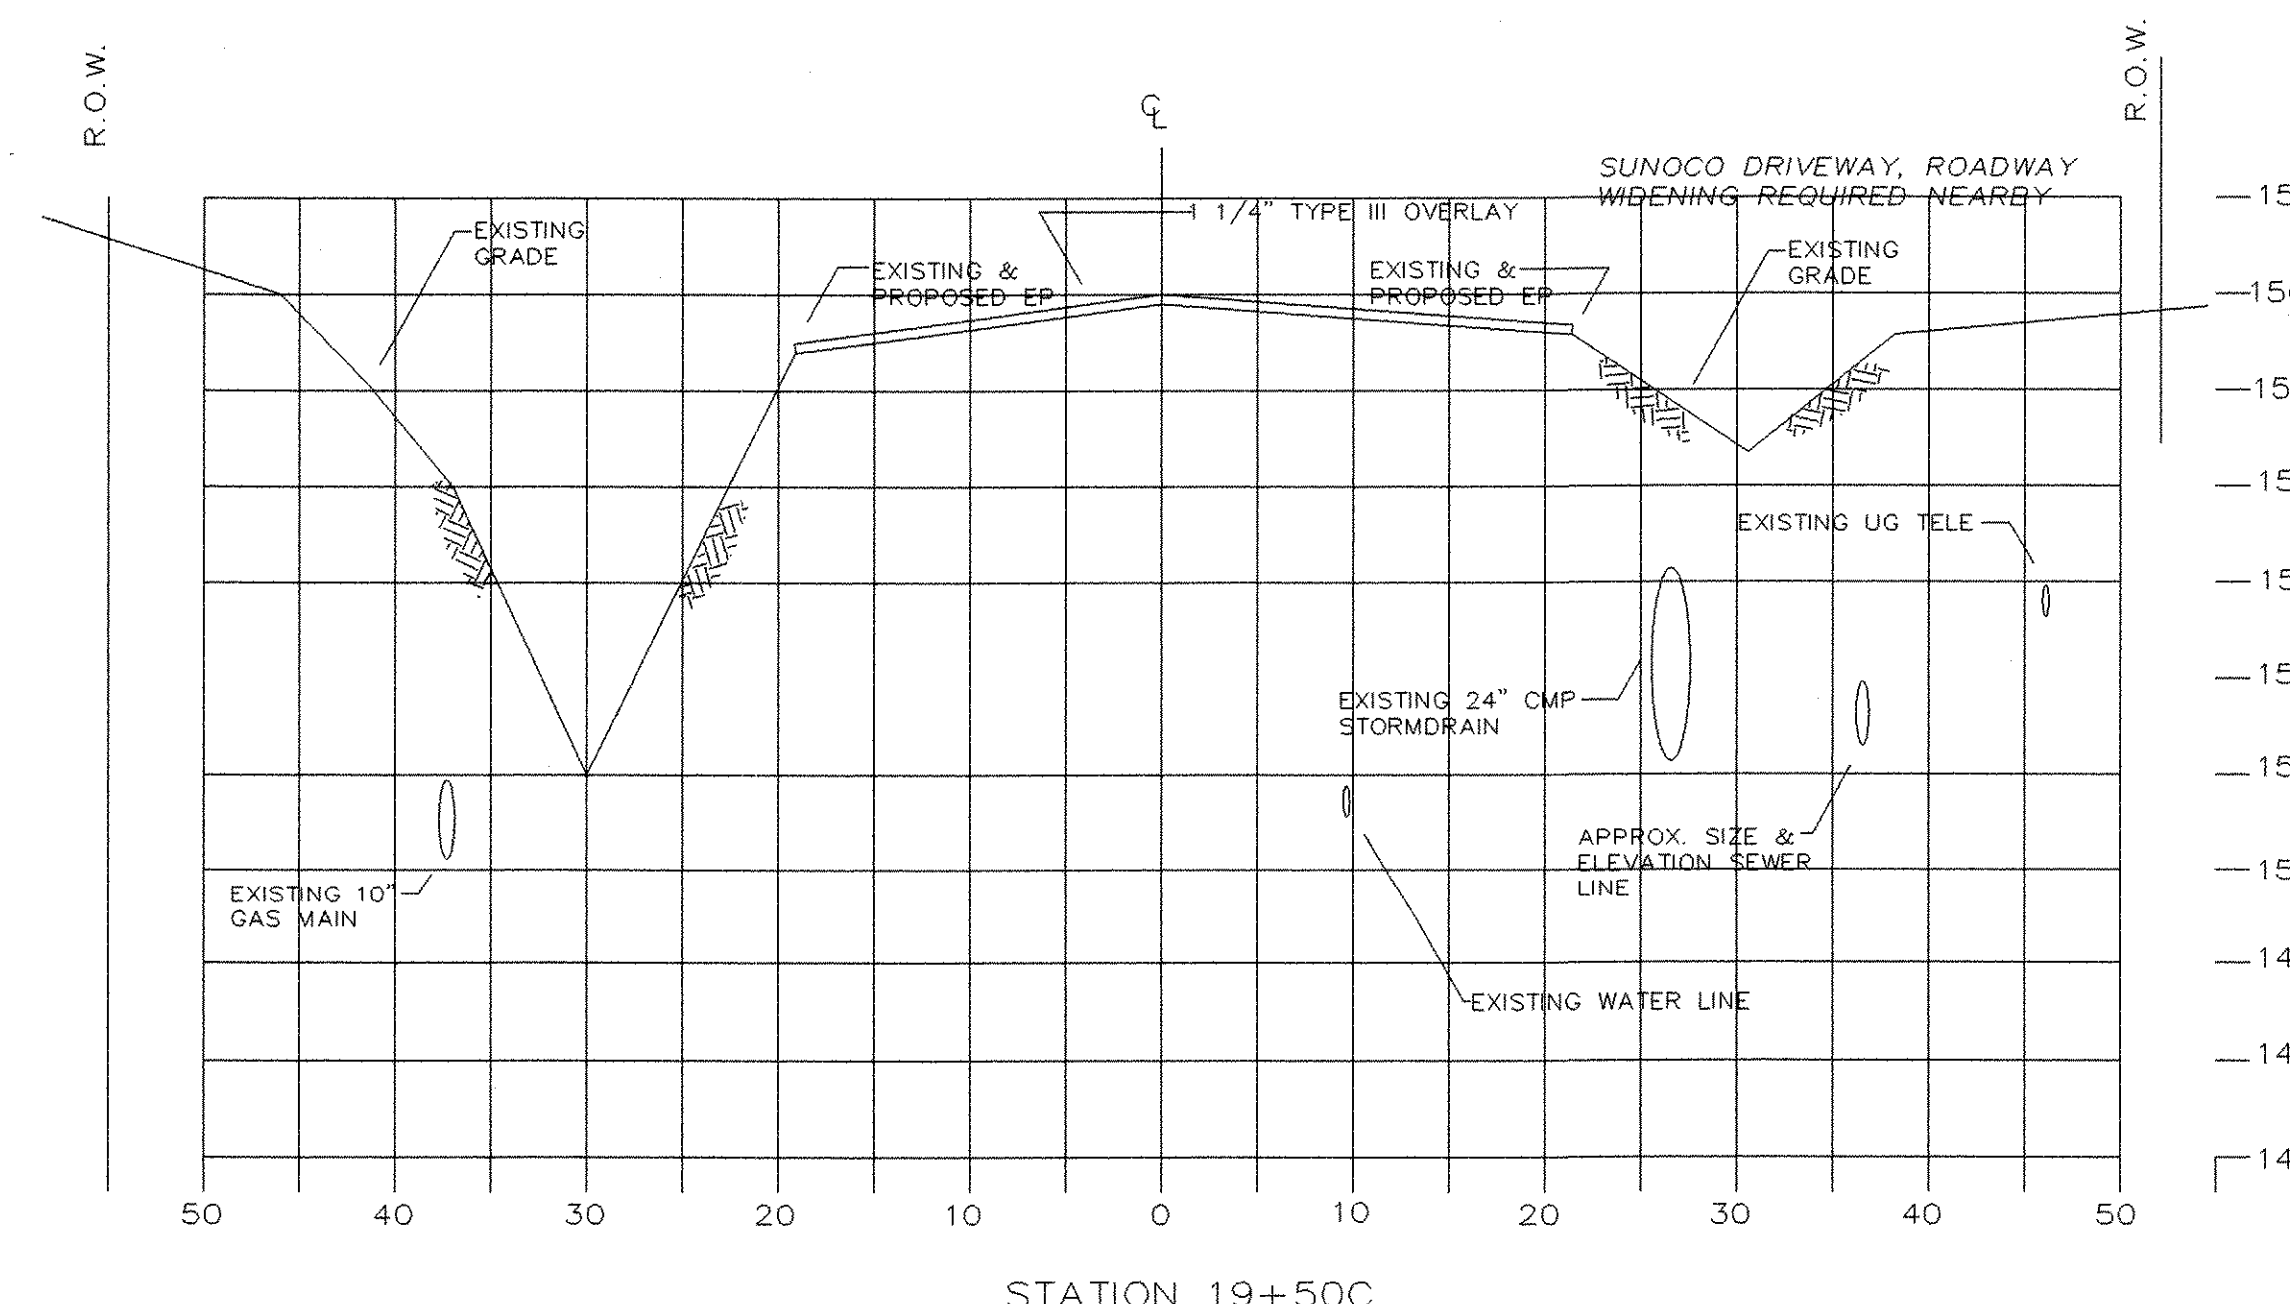

STATION 19+50C

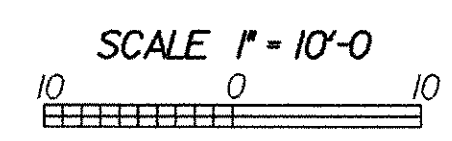

**VT.78 CROSS SECTION SHEET 18+50~19+50**

PROJECT NAME: **SWANTON**  
PROJECT NUMBER: **STPG ST 036-1(11)**

FILE NAME: PMS /00b105/TRAFFIC DES.\tbl50xs.dgn PLOT DATE: 19-APR-2006  
PROJECT LEADER: **B. NYQUIST** DRAWN BY: TRAFFIC DESIGN  
DESIGNED BY: TRAFFIC DESIGN CHECKED BY: TRAFFIC DESIGN  
SHEET 45 OF 45  
tbl50xs4.1