



STATE OF VERMONT AGENCY OF TRANSPORTATION

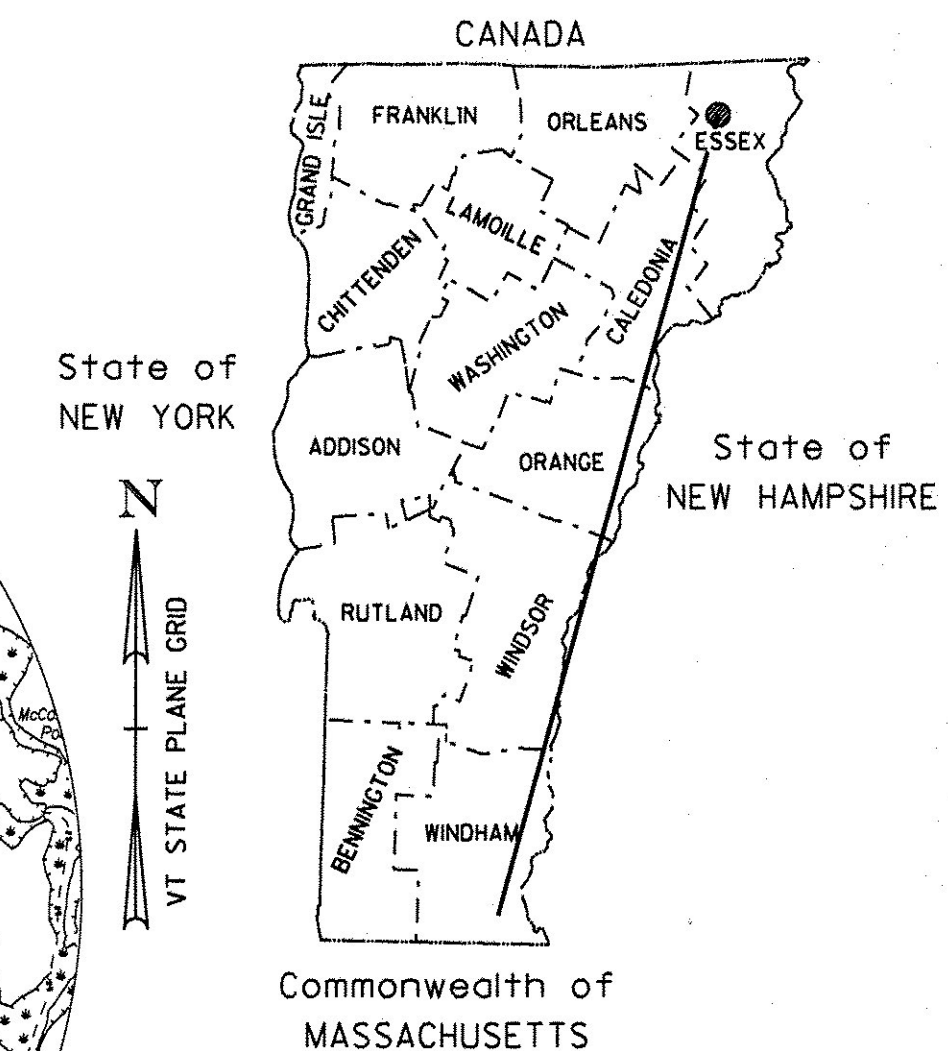

PROPOSED IMPROVEMENT BRIDGE PROJECT TOWN OF BRIGHTON COUNTY OF ESSEX ROUTE NO.: VT 105 BRIDGE NO. 88

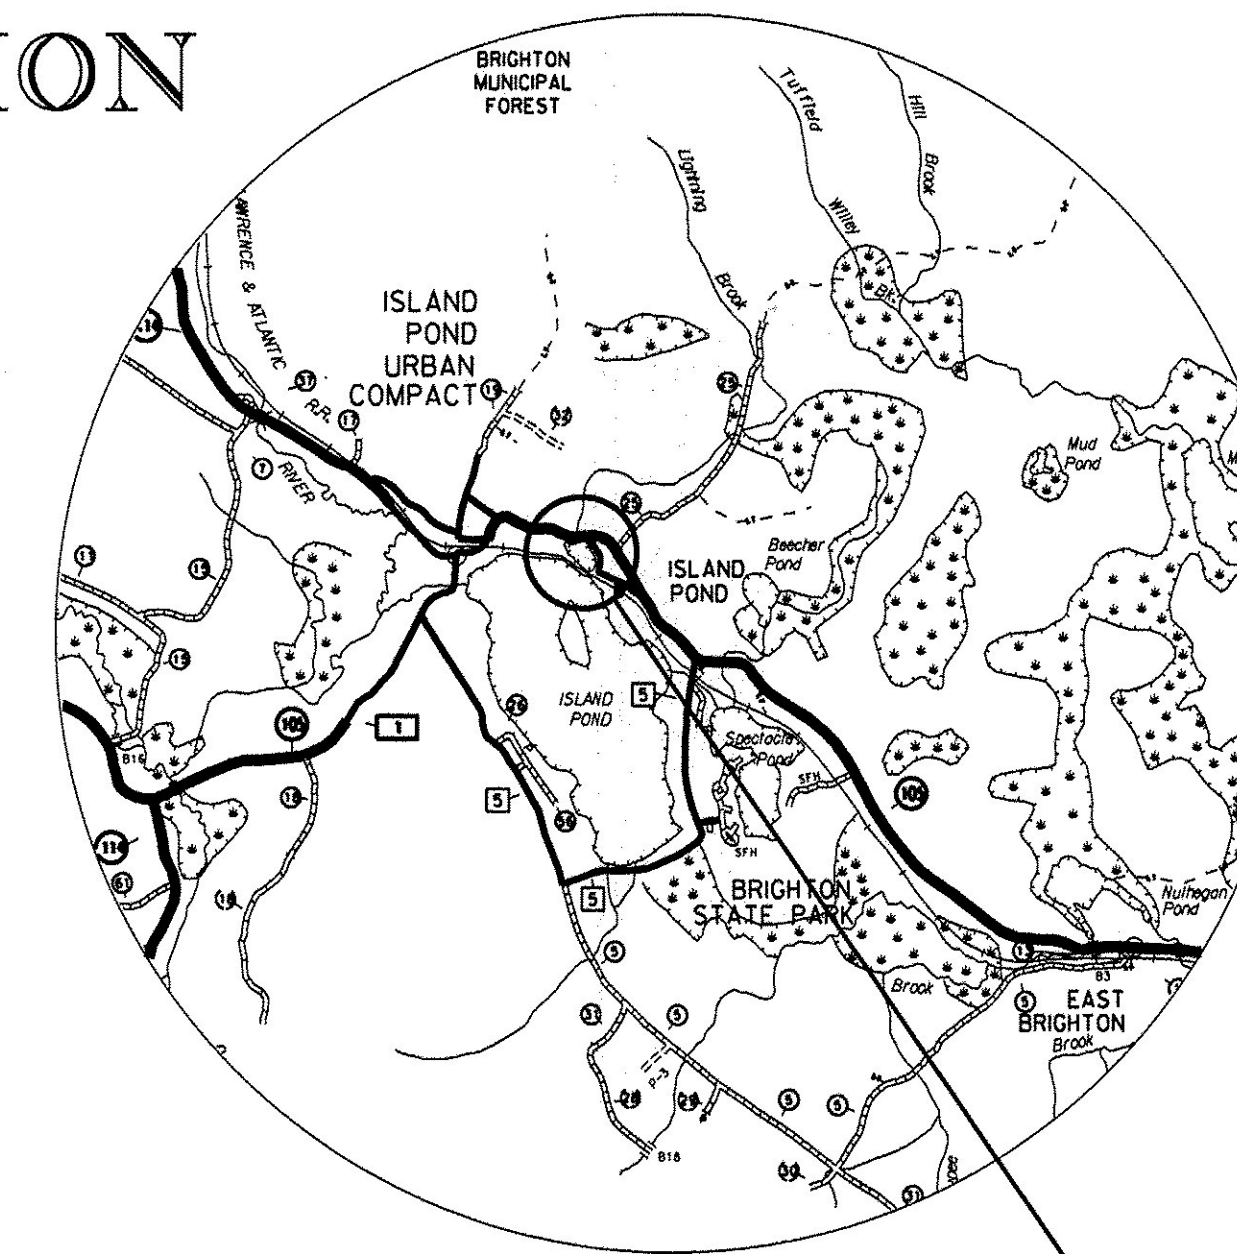


RECORD PLANS	
CONTRACTOR:	MORRILL CONSTRUCTION INC. - NORTH HAVERHILL, NH
RESIDENT ENGINEER:	DOUG BUMPS
CONSTRUCTION BEGAN:	AUGUST 28, 2012
CONSTRUCTION COMPLETE:	NOVEMBER 7, 2012
RECORD PLANS BY:	DOUG BUMPS
I HEREBY CERTIFY THAT ALL THE CONSTRUCTION REQUIRED BY THIS SET OF DRAWINGS HAS BEEN ACCOMPLISHED AS INDICATED HEREIN.	
BY:	<i>Doug Bumps</i> RESIDENT ENGINEER
DATE:	6/18/13
NOTE: Any further information concerning final quantities, amounts or other details relative to this project may be found at Central Files in the electronic archives.	

PROJECT LOCATION: BEGINNING AT A POINT ON VT ROUTE 105 APPROXIMATELY 0.5 MILES EAST OF THE INTERSECTION WITH VT ROUTE 114 TO MM 5.00 (STA 264+00) AND EXTENDING EASTERLY 0.03 MILES TO MM 5.03 (STA 265+50).

PROJECT DESCRIPTION: THIS PROJECT SHALL CONSIST OF THE REPLACEMENT OF THE EXISTING CORRUGATED METAL PLATE PIPE ARCH STRUCTURE WITH A NEW 14' x 7' REINFORCED PRECAST CONCRETE BOX CULVERT WITH RELATED APPROACH AND CHANNEL WORK.

LENGTH OF BRIDGE: 16.00 FEET
 LENGTH OF ROADWAY: 134.00 FEET
 LENGTH OF PROJECT: 150.00 FEET

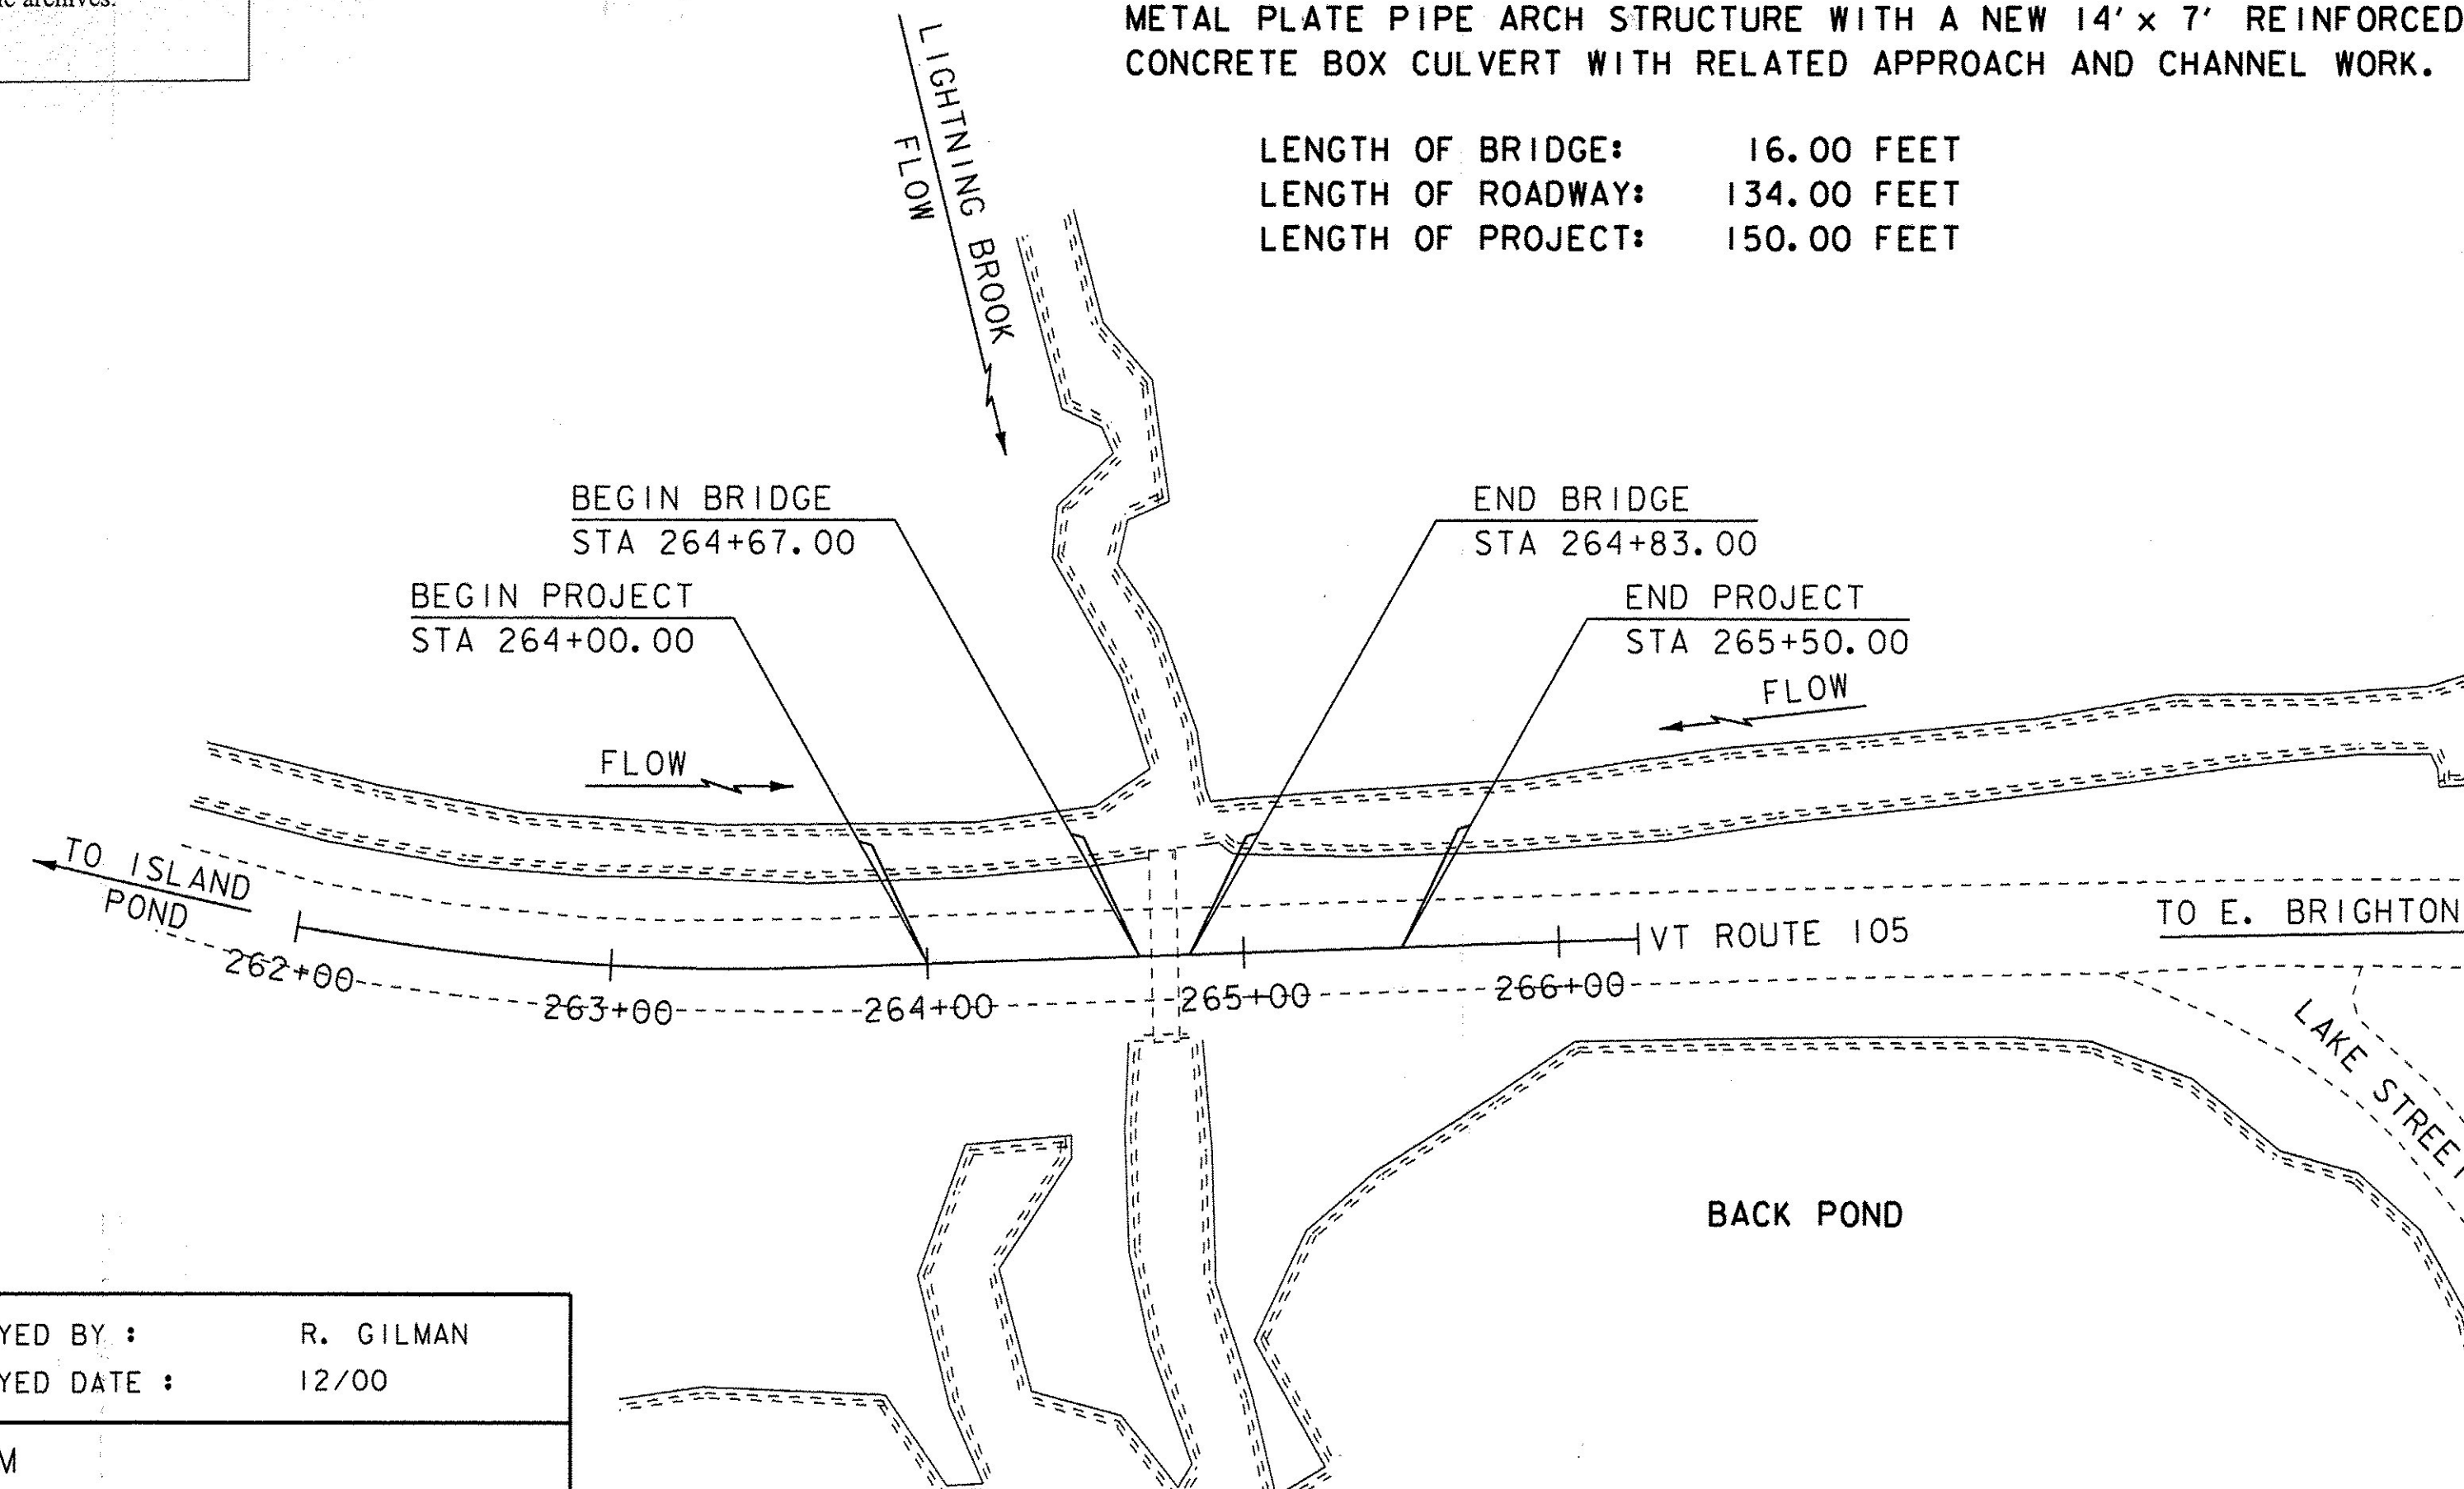

QUALITY ASSURANCE PROGRAM: LEVEL 2

CONVENTIONAL SYMBOLS	
COUNTY LINE	
TOWN LINE	
LIMITS OF ACCESS	
POINT OF ACCESS	
FENCE LINE	
STONE WALL	
TRAVELED WAY	
GUARD RAIL	
RAILROAD	
SURVEY LINE	
CULVERT	
POWER POLE	
TELEPHONE POLE	
TREES	
CONTROL OF ACCESS	
PROPERTY LINE	
R.O.W. TAKING LINE	
SLOPE RIGHTS	
TOP OF CUT	
TOE OF SLOPE	

SURVEYED BY : R. GILMAN
 SURVEYED DATE : 12/00
 DATUM
 VERTICAL : NAVD 88
 HORIZONTAL : NAD 83 (96)

SCALE 1" = 50'-0"

THESE PLANS ARE SUBJECT TO SUCH ENGINEERING CHANGES AS MAY BE REQUIRED BY THE FEDERAL HIGHWAY ADMINISTRATION OR THE DIRECTOR OF PROGRAM DEVELOPMENT.
 CONSTRUCTION IS TO BE CARRIED ON IN ACCORDANCE WITH THESE PLANS AND THE STANDARD SPECIFICATIONS FOR CONSTRUCTION DATED 2011, AS APPROVED BY THE FEDERAL HIGHWAY ADMINISTRATION ON JULY 20, 2011 FOR USE ON THIS PROJECT, INCLUDING ALL SUBSEQUENT REVISIONS AND SUCH REVISED SPECIFICATIONS AND SPECIAL PROVISIONS AS ARE INCORPORATED IN THESE PLANS.

BUILT AS DESIGNED

DIRECTOR OF PROGRAM DEVELOPMENT	
APPROVED <i>Rochelle Stewart</i>	DATE 6-12-12
PROJECT MANAGER : KRISTIN HIGGINS	
PROJECT NAME :	BRIGHTON
PROJECT NUMBER :	STP 034-3 (21)
SHEET 1 OF 30 SHEETS	