
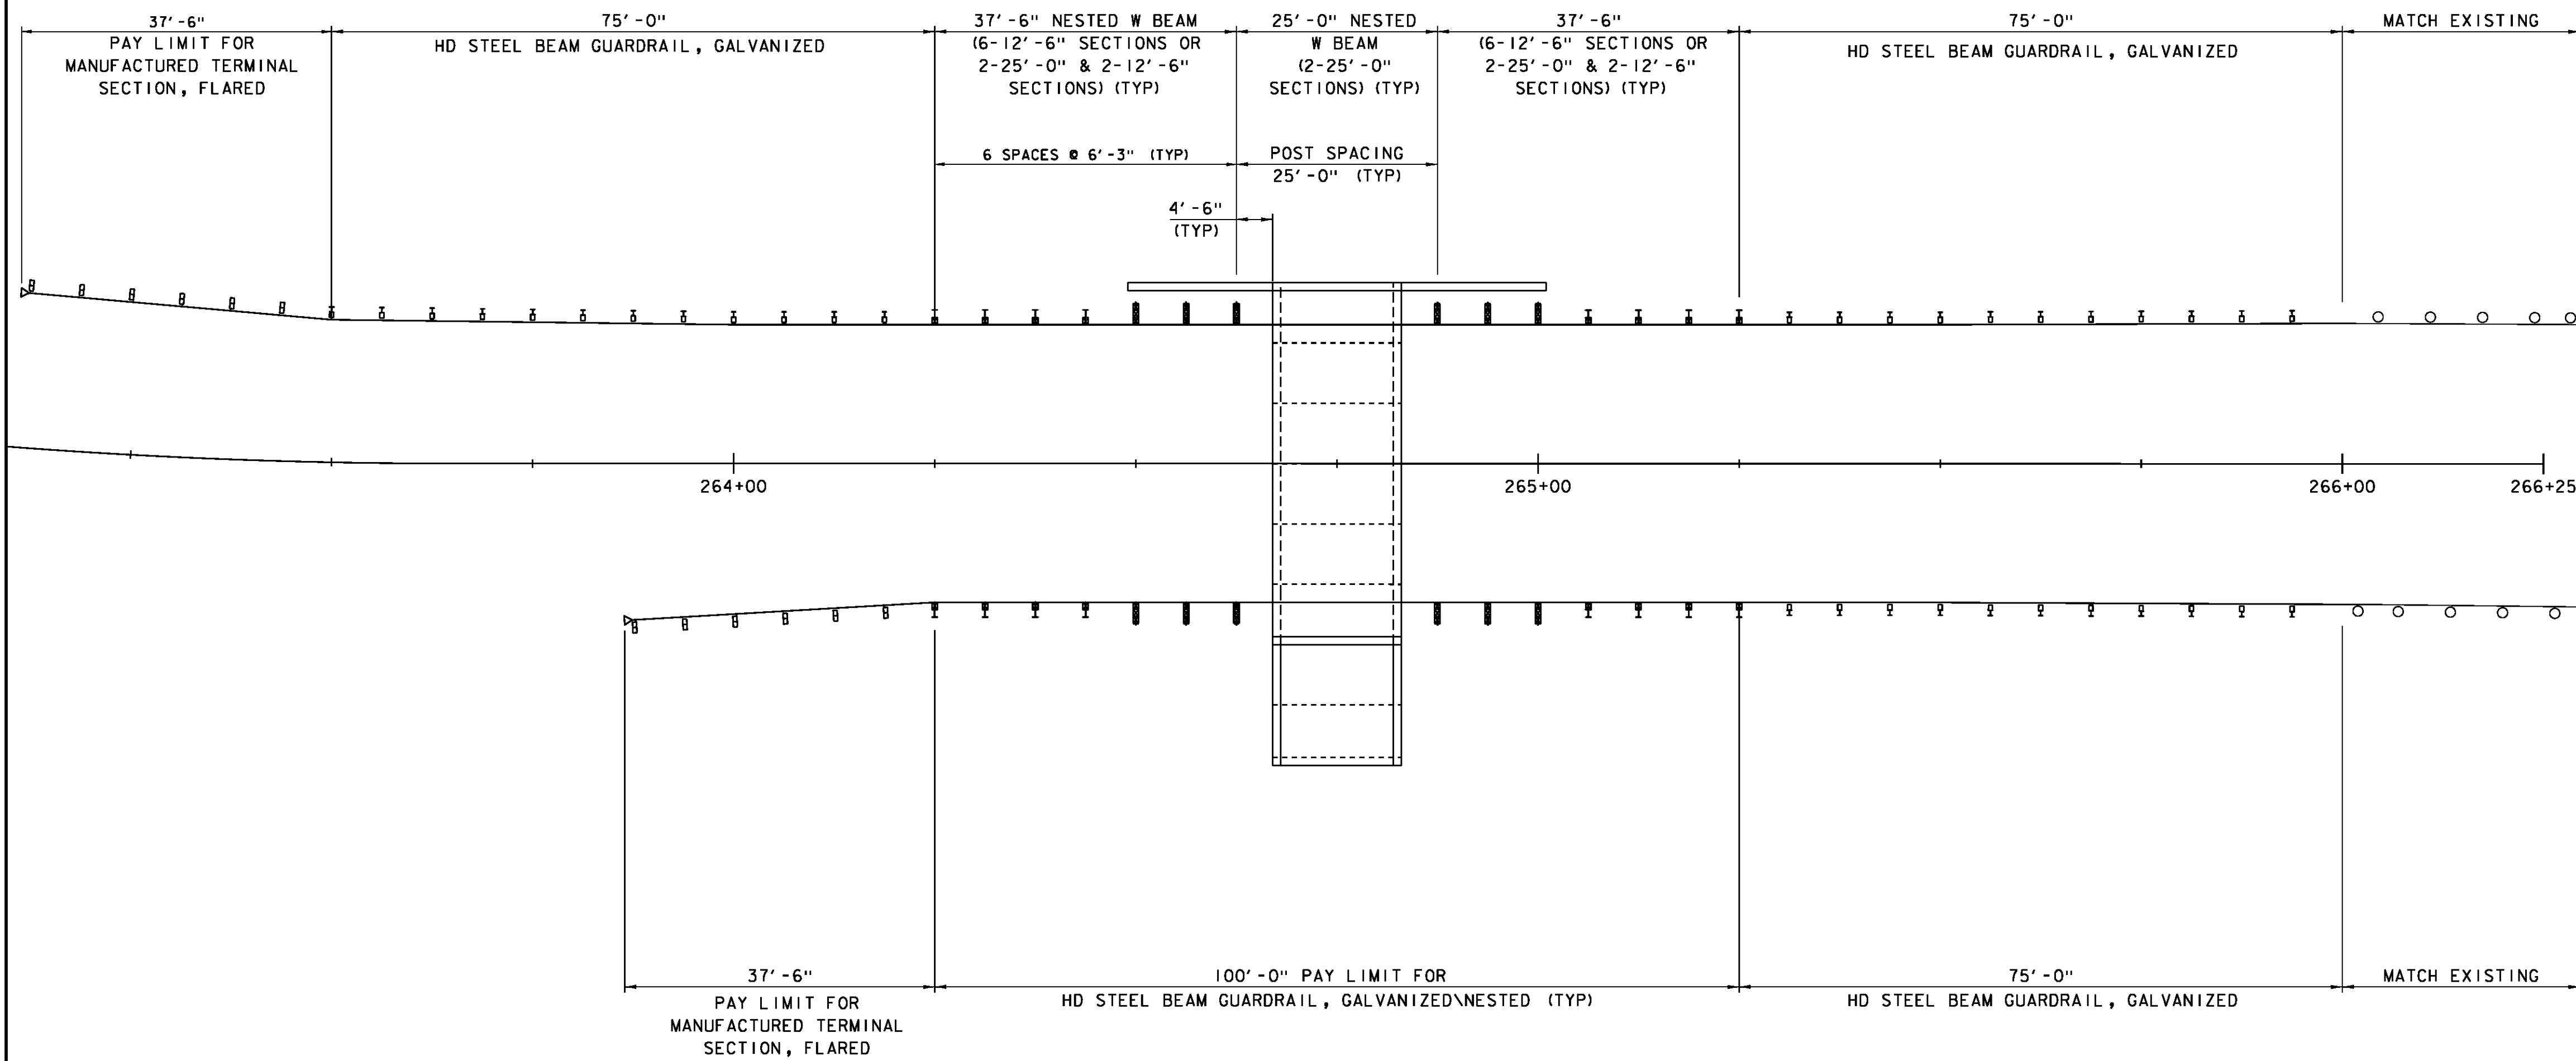


MANUFACTURED TERMINAL SECTION, FLARED
 STA 263+12.50 - STA 263+50.00 LT
 STA 263+87.50 - STA 264+25.00 RT

HD STEEL BEAM GUARDRAIL, GALVANIZED/NESTED
 W/8 FEET STEEL POSTS
 STA 264+25.00 - 265+25.00 LT/RT

HD STEEL BEAM GUARDRAIL, GALVANIZED
 STA 263+50.00 - STA 264+25.00 LT
 STA 265+25.00 - STA 266+00.00 LT/RT

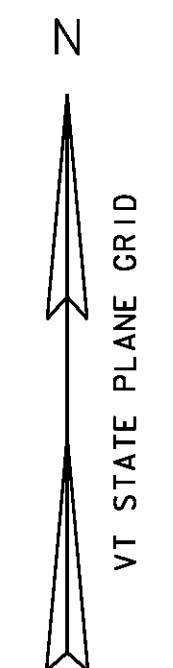

RAIL LAYOUT SHEET

SCALE 1" = 10'-0"
 10 0 10

PROJECT NAME: BRIGHTON
 PROJECT NUMBER: STP 034-3(2)

FILE NAME: s00b246rail.dgn
 PROJECT LEADER: K. HIGGINS
 DESIGNED BY: J. SALVATORI
 RAIL LAYOUT SHEET

PLOT DATE: 12-JUN-2012
 DRAWN BY: J. SALVATORI
 CHECKED BY: W. LAMMER
 SHEET 13 OF 30