


51+60

51+80

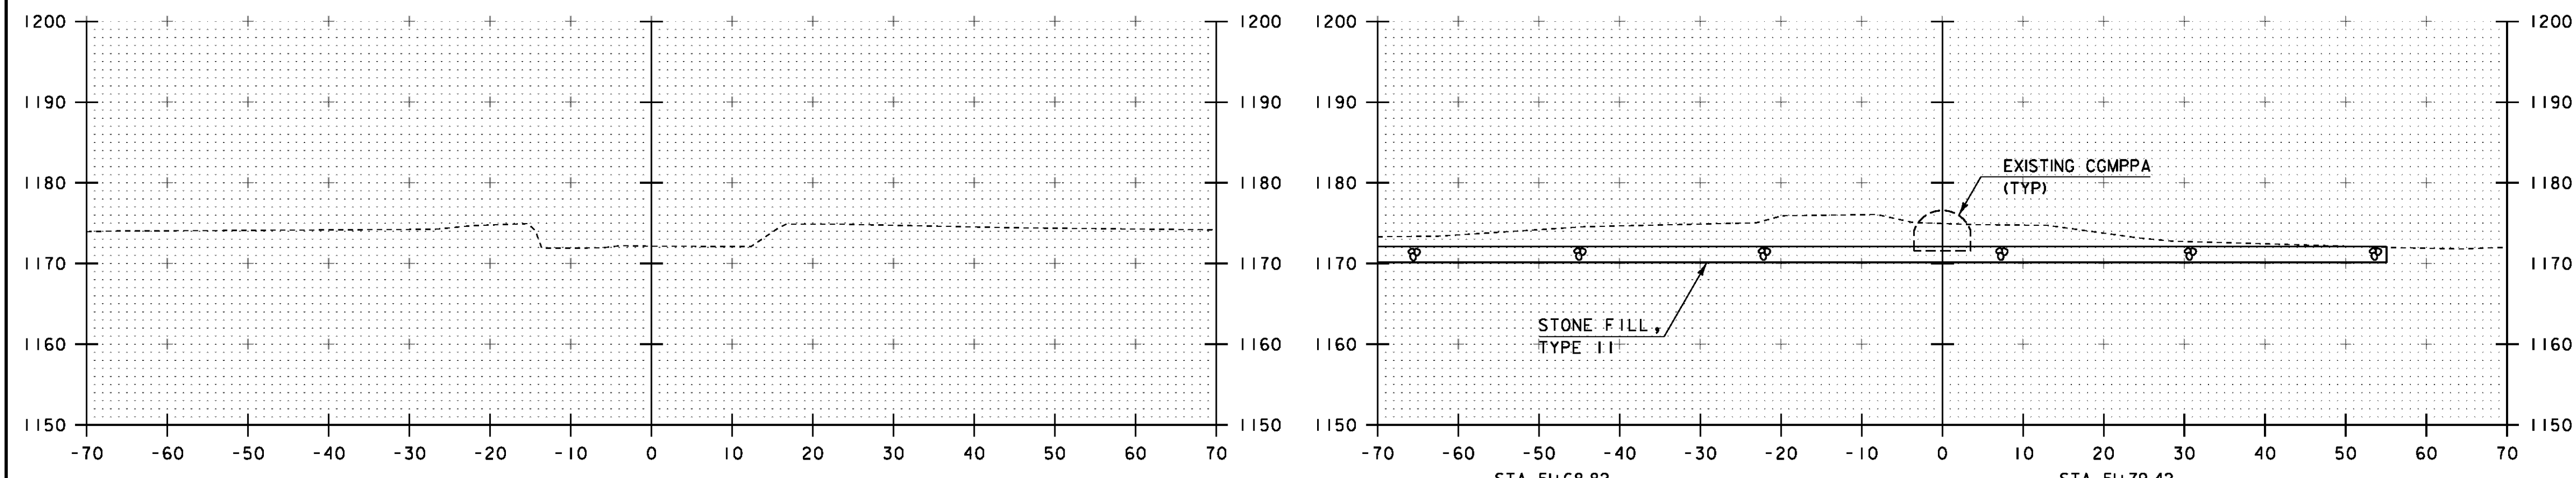

51+50

51+70

STA. 51+68.82
 BEGIN UNCLASSIFIED CHANNEL EXCAVATION
 BEGIN GEOTEXTILE UNDER STONE FILL
 BEGIN STONE FILL TYPE II

STA. 51+79.42
 END UNCLASSIFIED CHANNEL EXCAVATION
 END GEOTEXTILE UNDER STONE FILL
 END STONE FILL TYPE II

STA. 51+50 TO STA. 51+80

PROJECT NAME: BRIGHTON	PLOT DATE: 12-JUN-2012
PROJECT NUMBER: STP 034-3(21)	DRAWN BY: J. SALVATORI
FILE NAME: s00b246xs.dgn	CHECKED BY: W. LAMMER
PROJECT LEADER: K. HIGGINS	SHEET 26 OF 30
DESIGNED BY: J. SALVATORI	CHANNEL SECTIONS 1