




STA. 52+33.00  
 BEGIN UNCLASSIFIED CHANNEL EXCAVATION  
 BEGIN GEOTEXTILE UNDER STONE FILL  
 BEGIN STONE FILL TYPE II

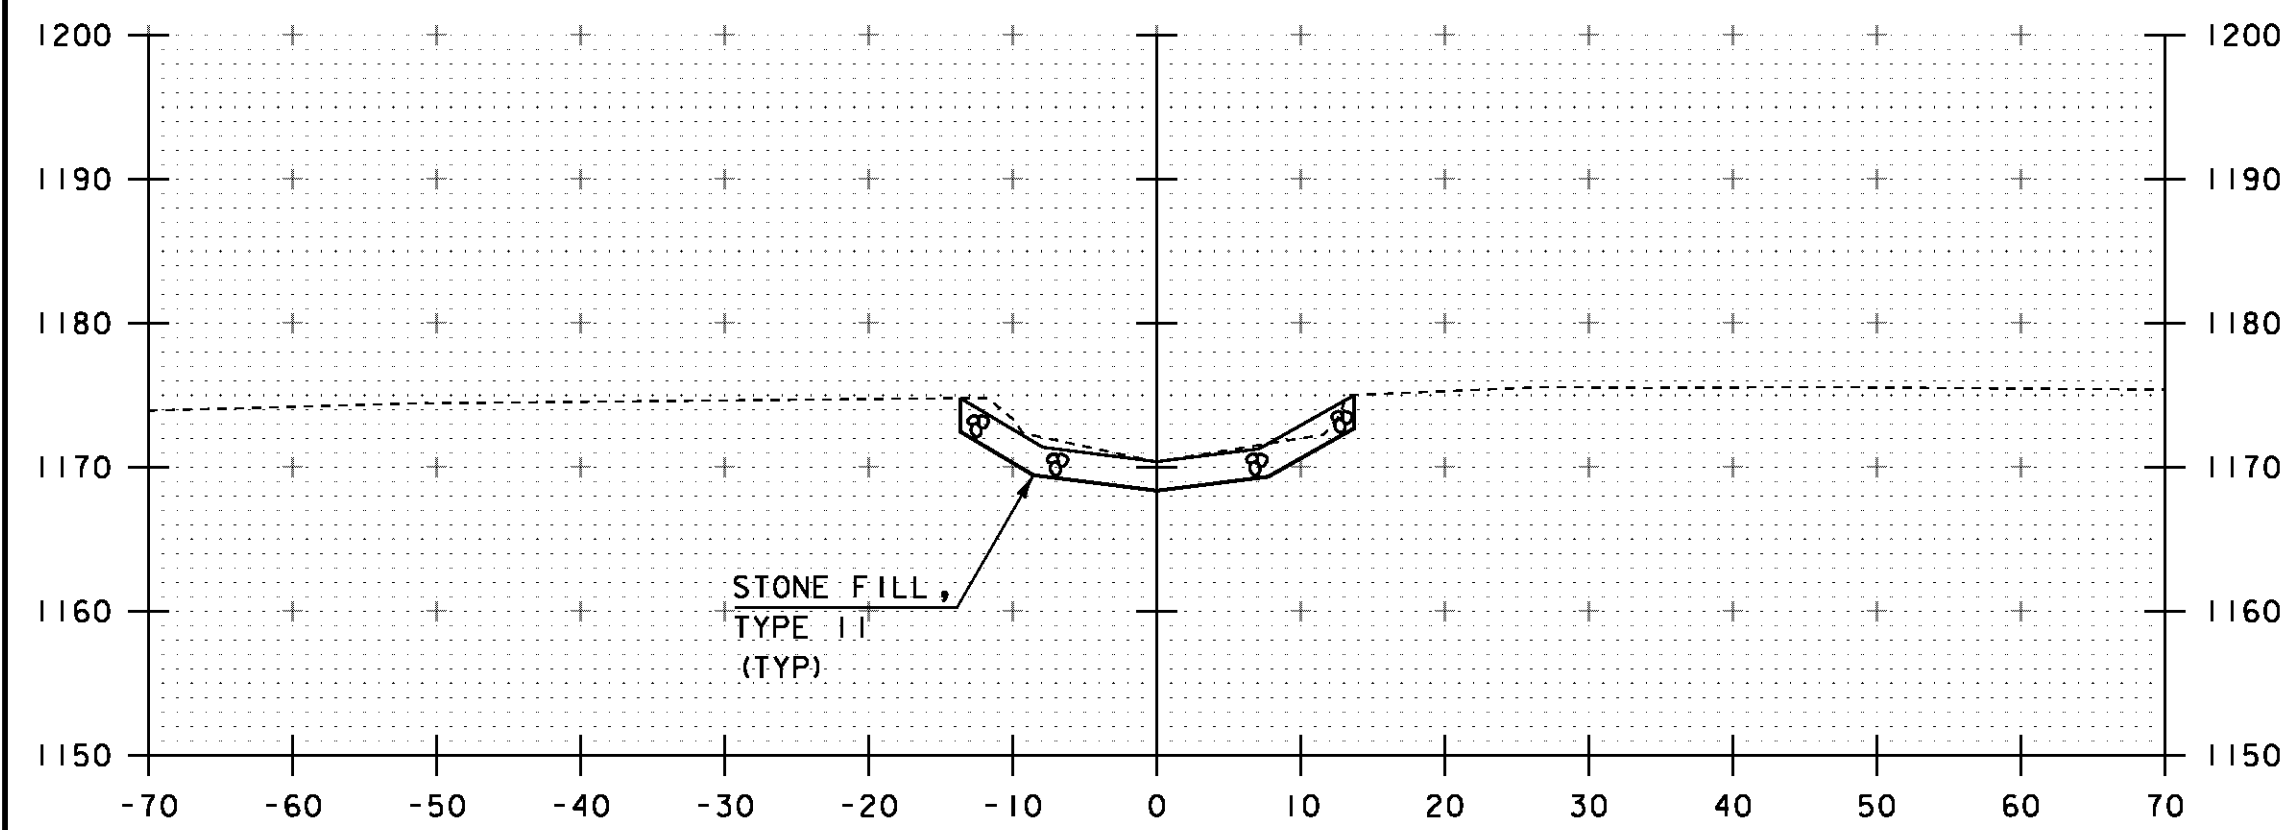

52+40

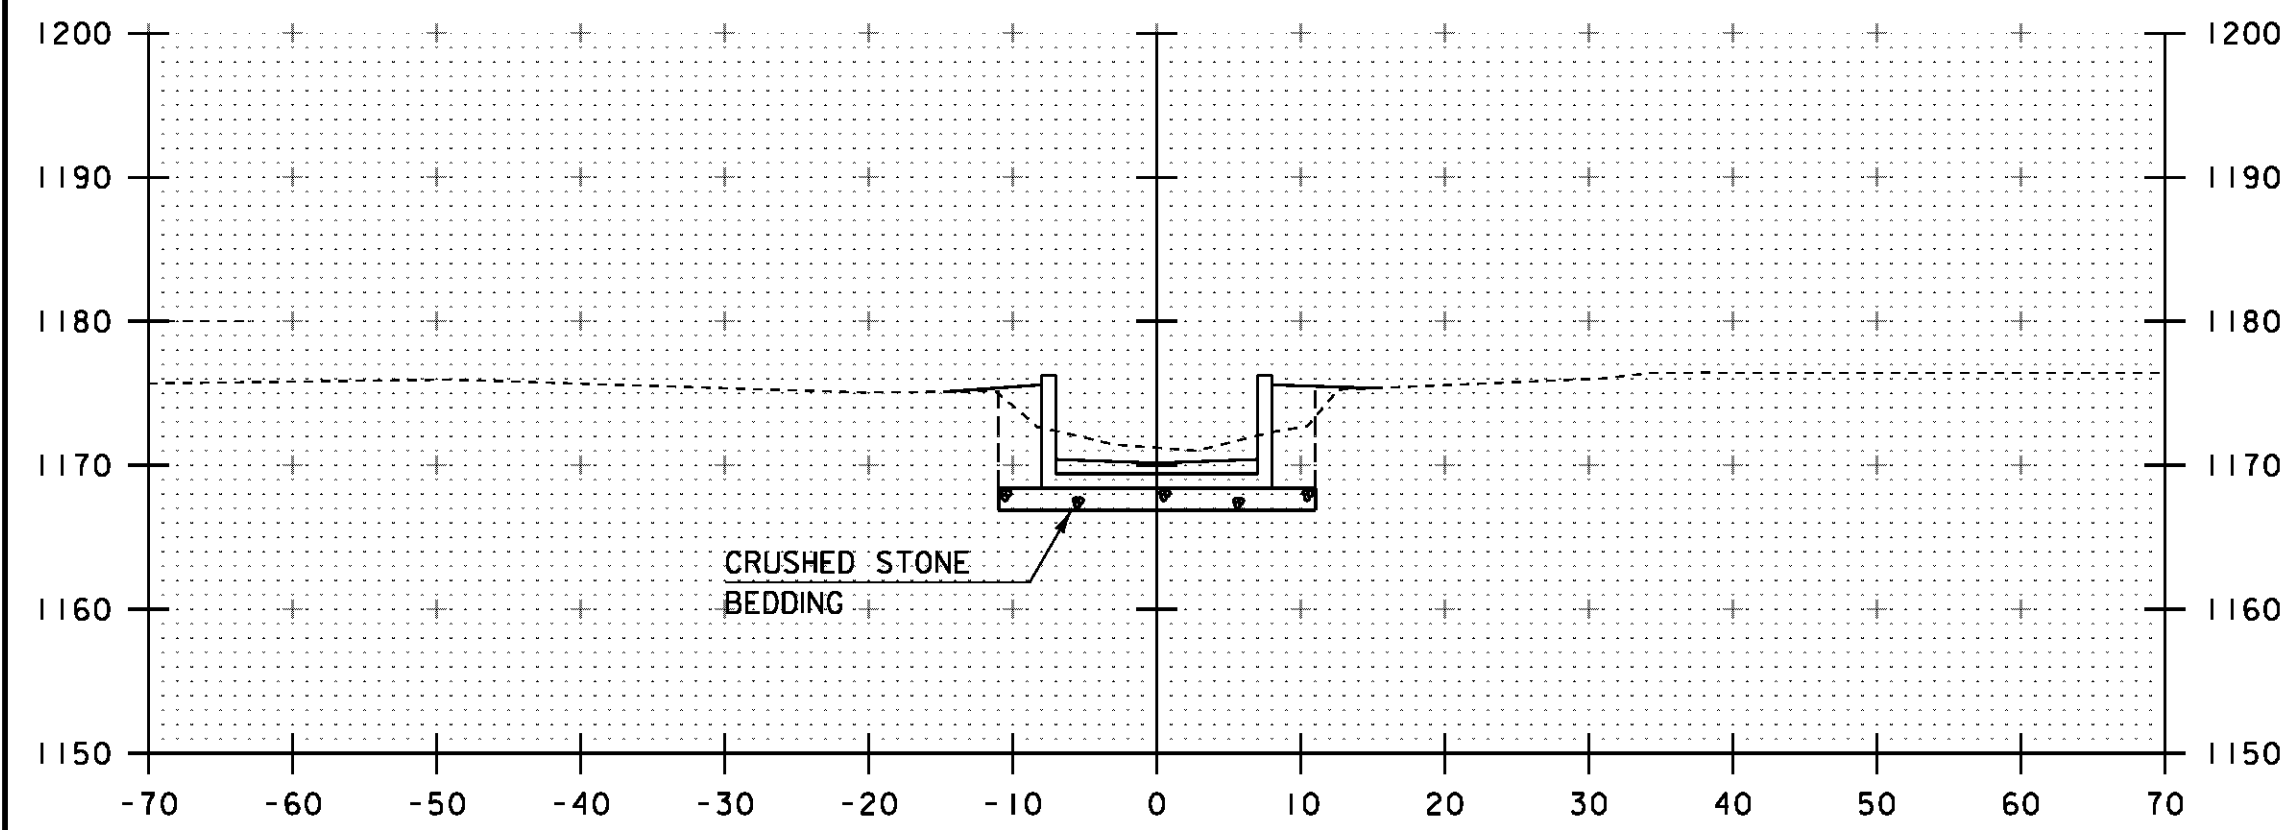

52+30

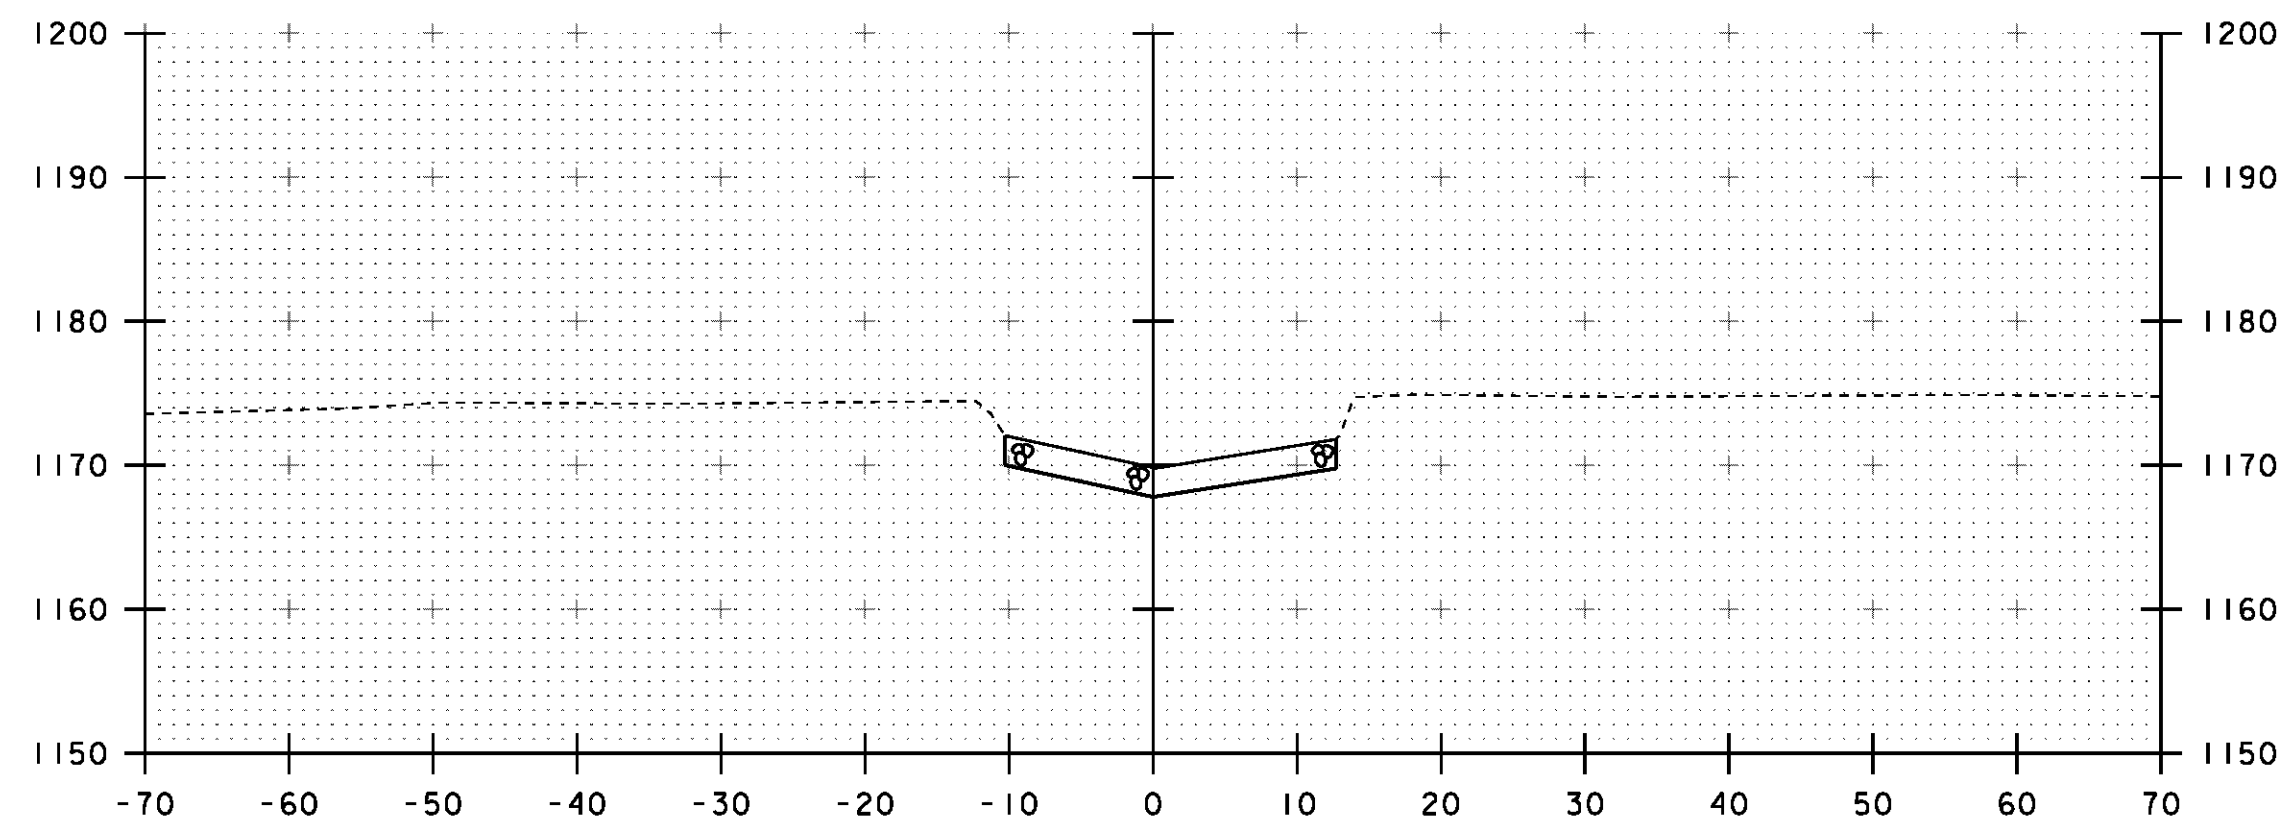

52+50

STA. 52+50.00  
 END UNCLASSIFIED CHANNEL EXCAVATION  
 END GEOTEXTILE UNDER STONE FILL  
 END STONE FILL TYPE II

PROJECT NAME: BRIGHTON  
 PROJECT NUMBER: STP 034-3(21)

FILE NAME: s00b246xs.dgn  
 PROJECT LEADER: K. HIGGINS  
 DESIGNED BY: J. SALVATORI  
 CHANNEL SECTIONS 3

PLOT DATE: 12-JUN-2012  
 DRAWN BY: J. SALVATORI  
 CHECKED BY: W. LAMMER  
 SHEET 28 OF 30

STA. 52+30 TO STA. 52+50