


**BANKING DIAGRAM**

HOR. SCALE 1" = 20'-0"  
NO VER. SCALE

THE GRADES SHOWN TO THE NEAREST TENTH ARE THE ORIGINAL GROUND ELEVATIONS ALONG THE PROPOSED ALIGNMENT.

THE GRADES SHOWN TO THE NEAREST HUNDREDTH ARE THE FINISH GRADES ALONG THE PROPOSED ALIGNMENT.

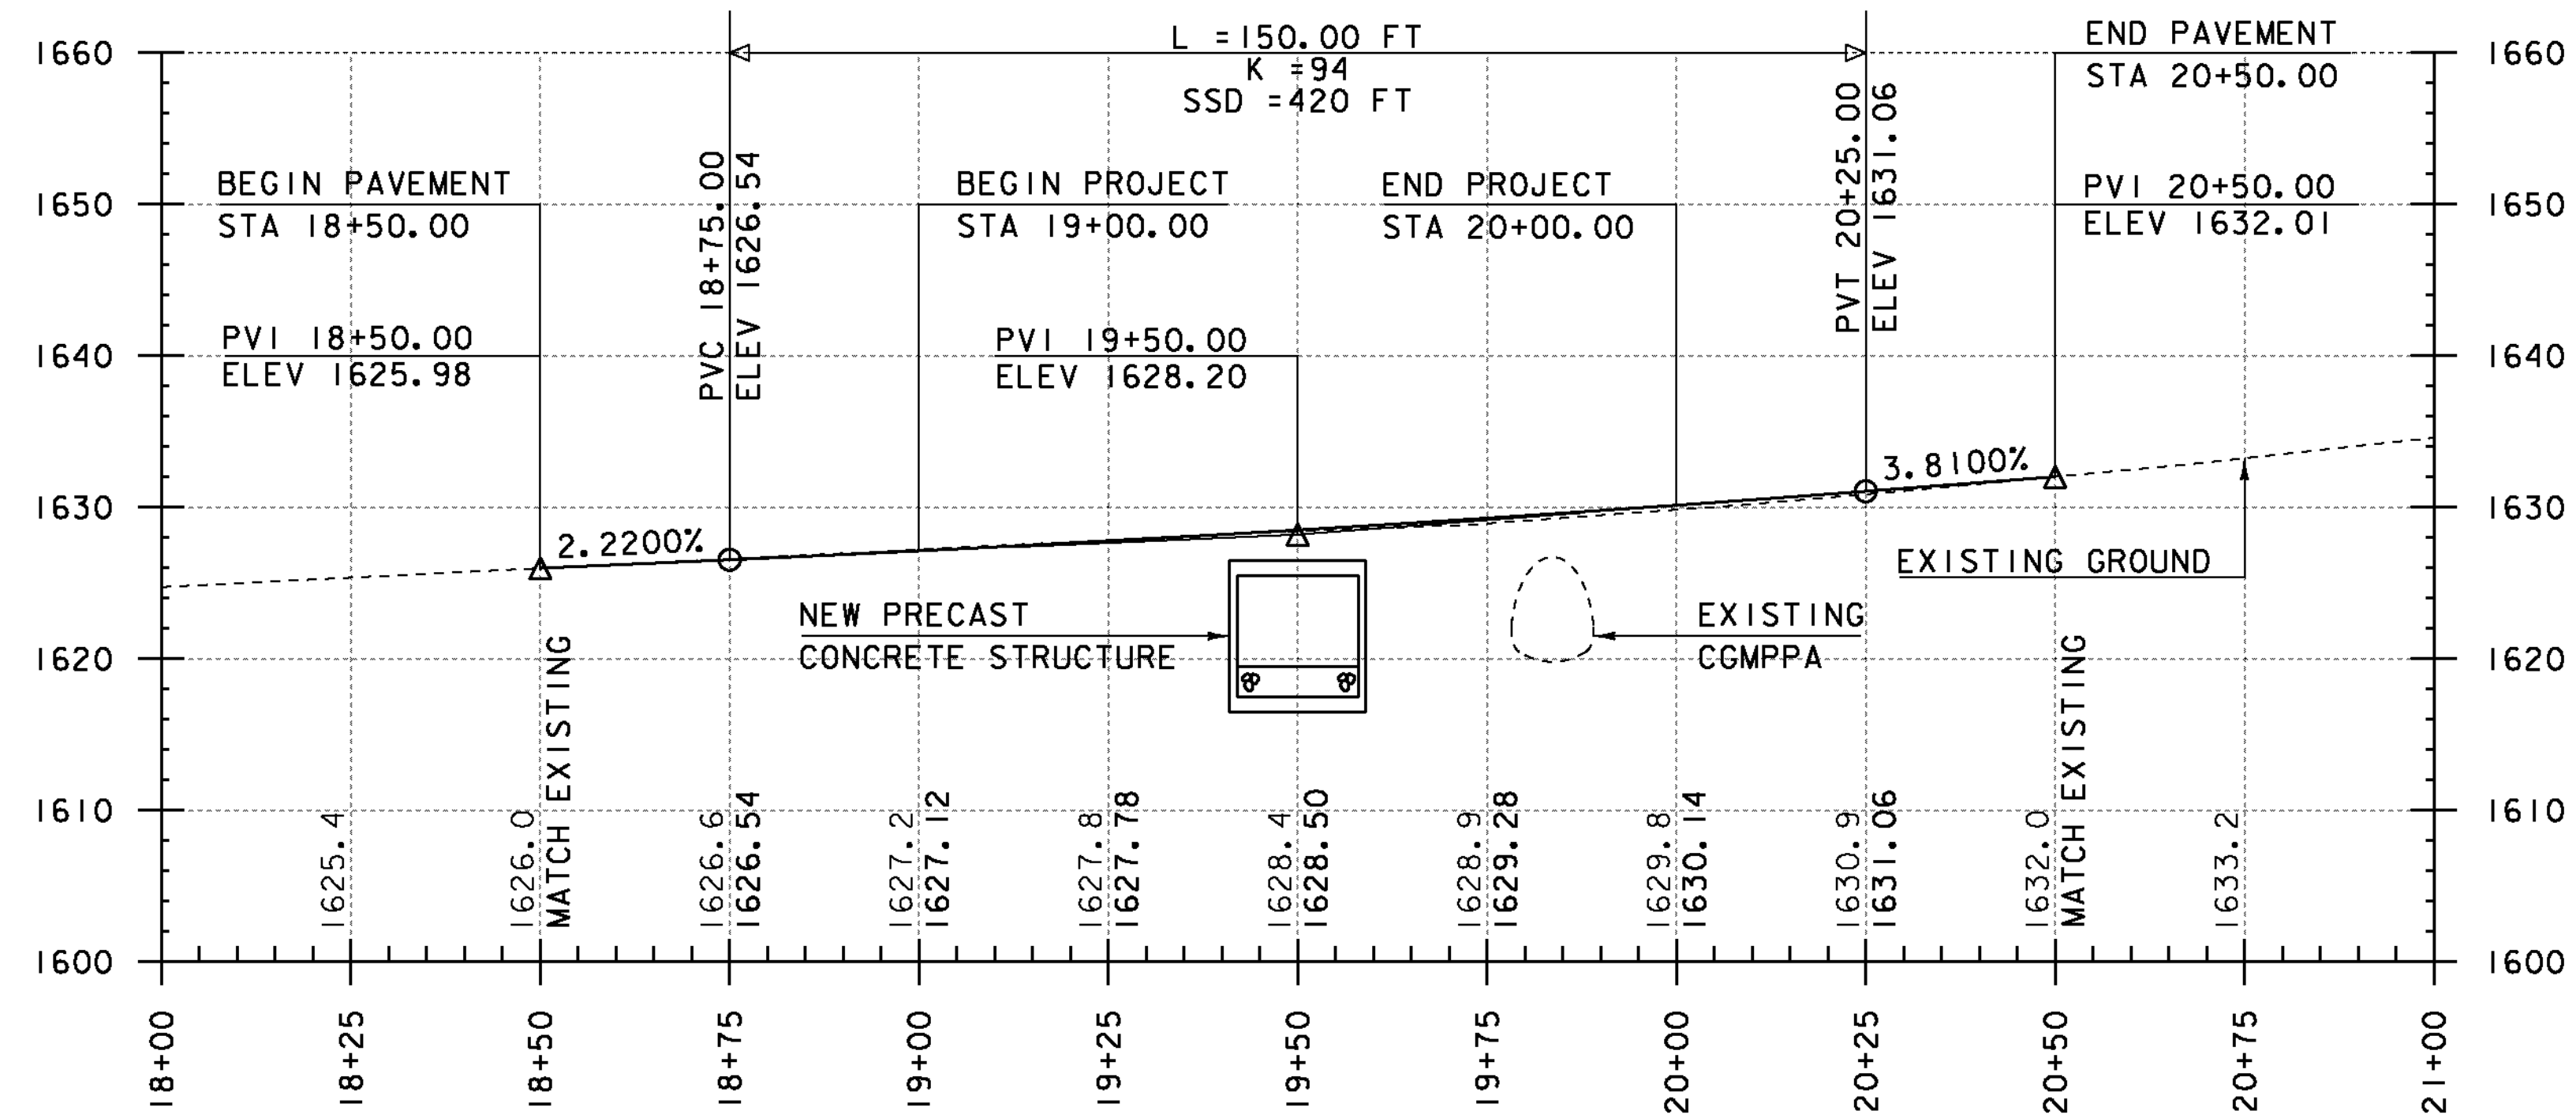

**MAINLINE PROFILE**

HOR. SCALE 1" = 20'-0"  
VER. SCALE 1" = 10'-0"

PROJECT NAME:	WILMINGTON	PLOT DATE:	02-JAN-2014
PROJECT NUMBER:	STP 013-1(I4)	DRAWN BY:	J. SALVATORI
FILE NAME:	00b252\00b252profile.dgn	CHECKED BY:	G. LAROCHE
PROJECT LEADER:	K. HIGGINS	SHEET	II OF 31
DESIGNED BY:	J. SALVATORI		
MAINLINE PROFILE			