


**MATERIAL TRANSITION**

HOR. SCALE 1" = 20'-0"  
NO VER. SCALE

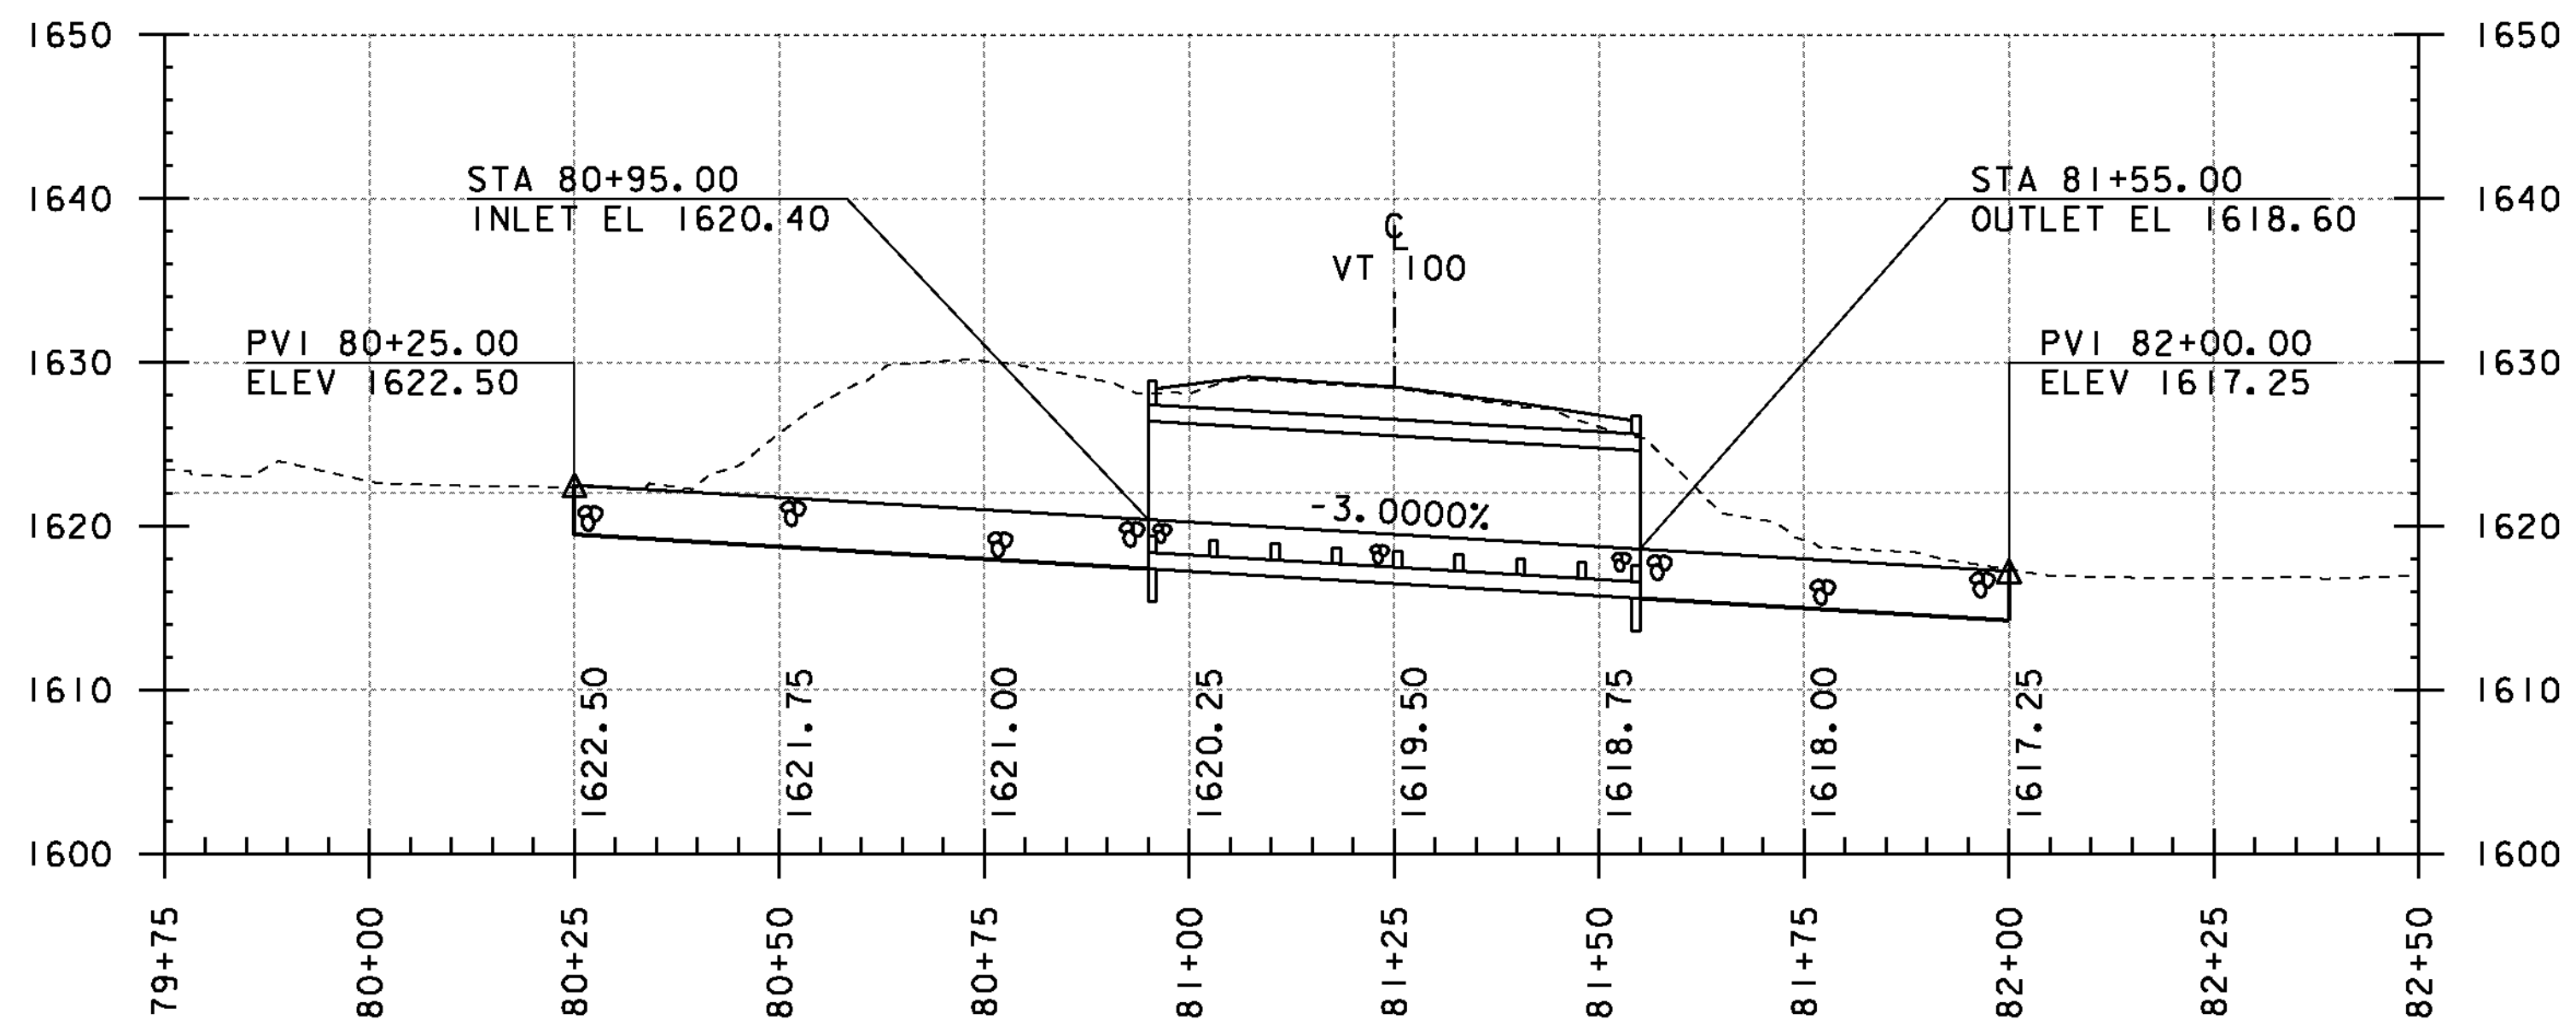

**BOX CULVERT PROFILE**

HOR. SCALE 1" = 20'-0"  
VER. SCALE 1" = 10'-0"

PROJECT NAME: WILMINGTON  
PROJECT NUMBER: STP 013-1(14)

FILE NAME: 00b252\00b252profile.dgn PLOT DATE: 02-JAN-2014  
PROJECT LEADER: K. HIGGINS DRAWN BY: J. SALVATORI  
DESIGNED BY: J. SALVATORI CHECKED BY: G. LAROCHE  
BOX CULVERT PROFILE SHEET 12 OF 31