



OUTLET ELEVATION

SCALE 1/4" = 1'-0"

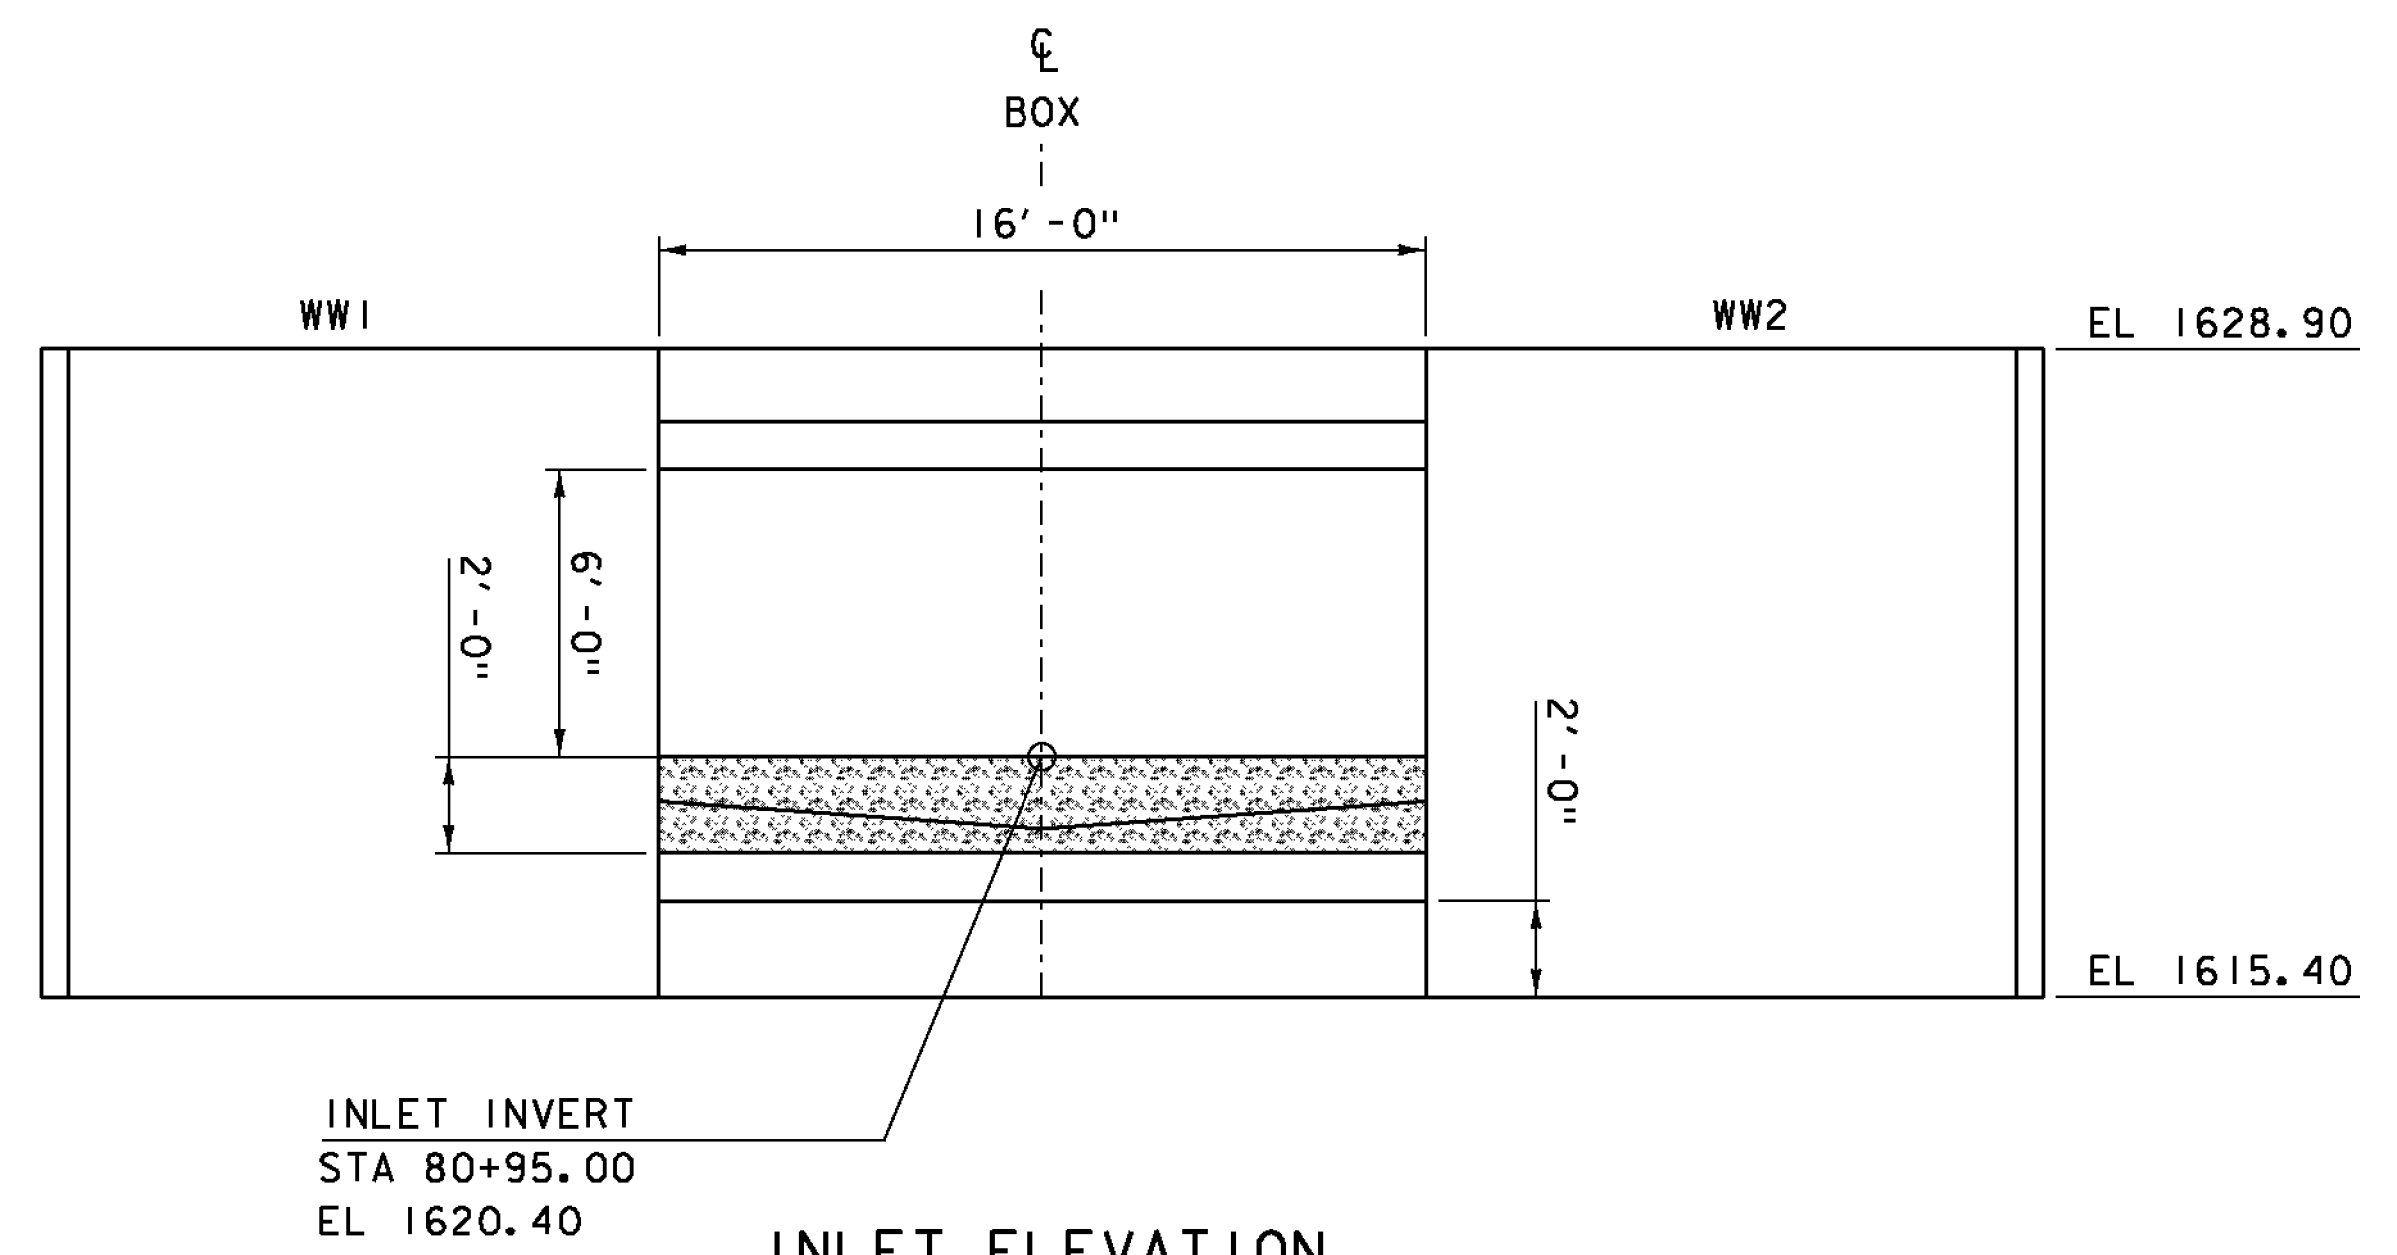

INLET ELEVATION

SCALE 1/4" = 1'-0"

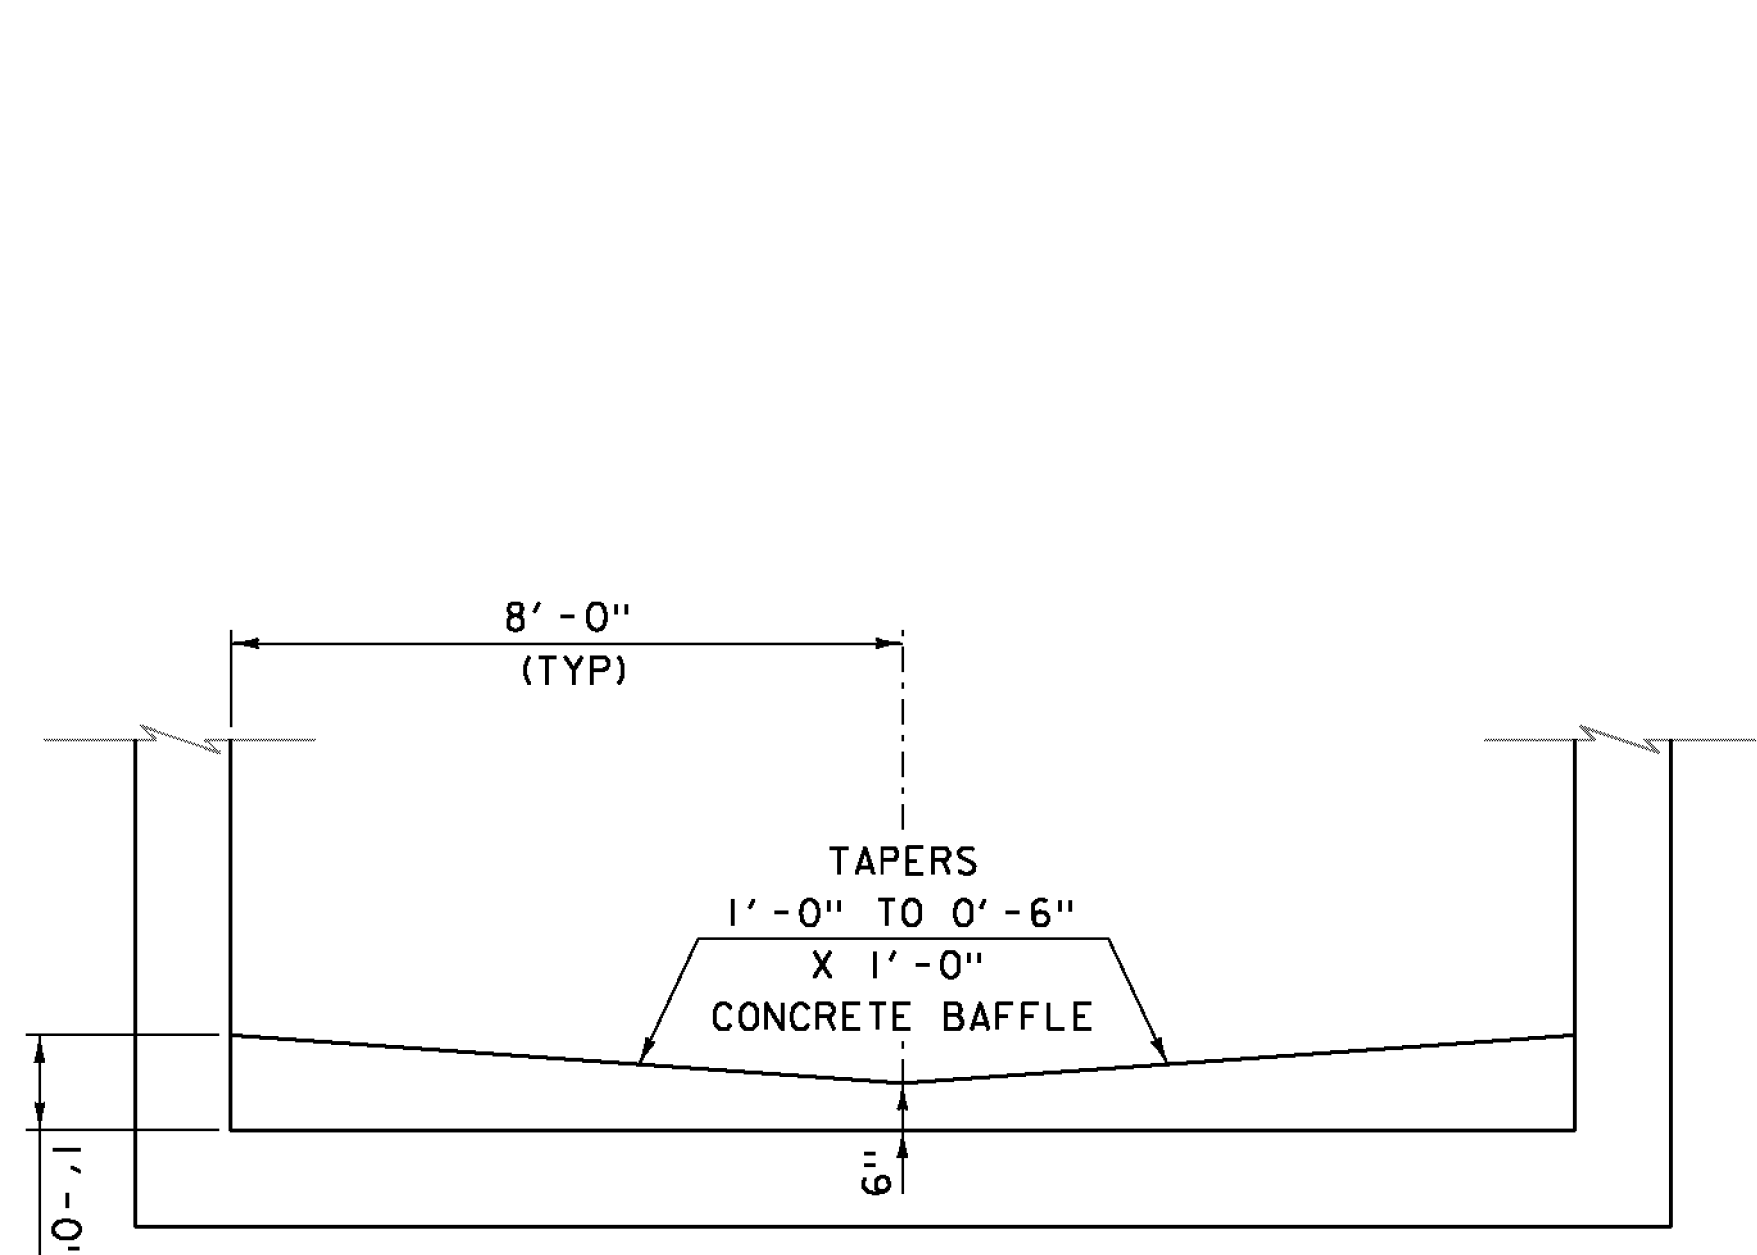


NOTES:

1. BAFFLES TO BE SPACED A MAXIMUM OF EVERY 8'-0" AND AT THE INLET AND OUTLET.
2. FABRICATOR TO DETAIL BAFFLE CONNECTION.

LOW FLOW BAFFLE DETAIL

NOT TO SCALE

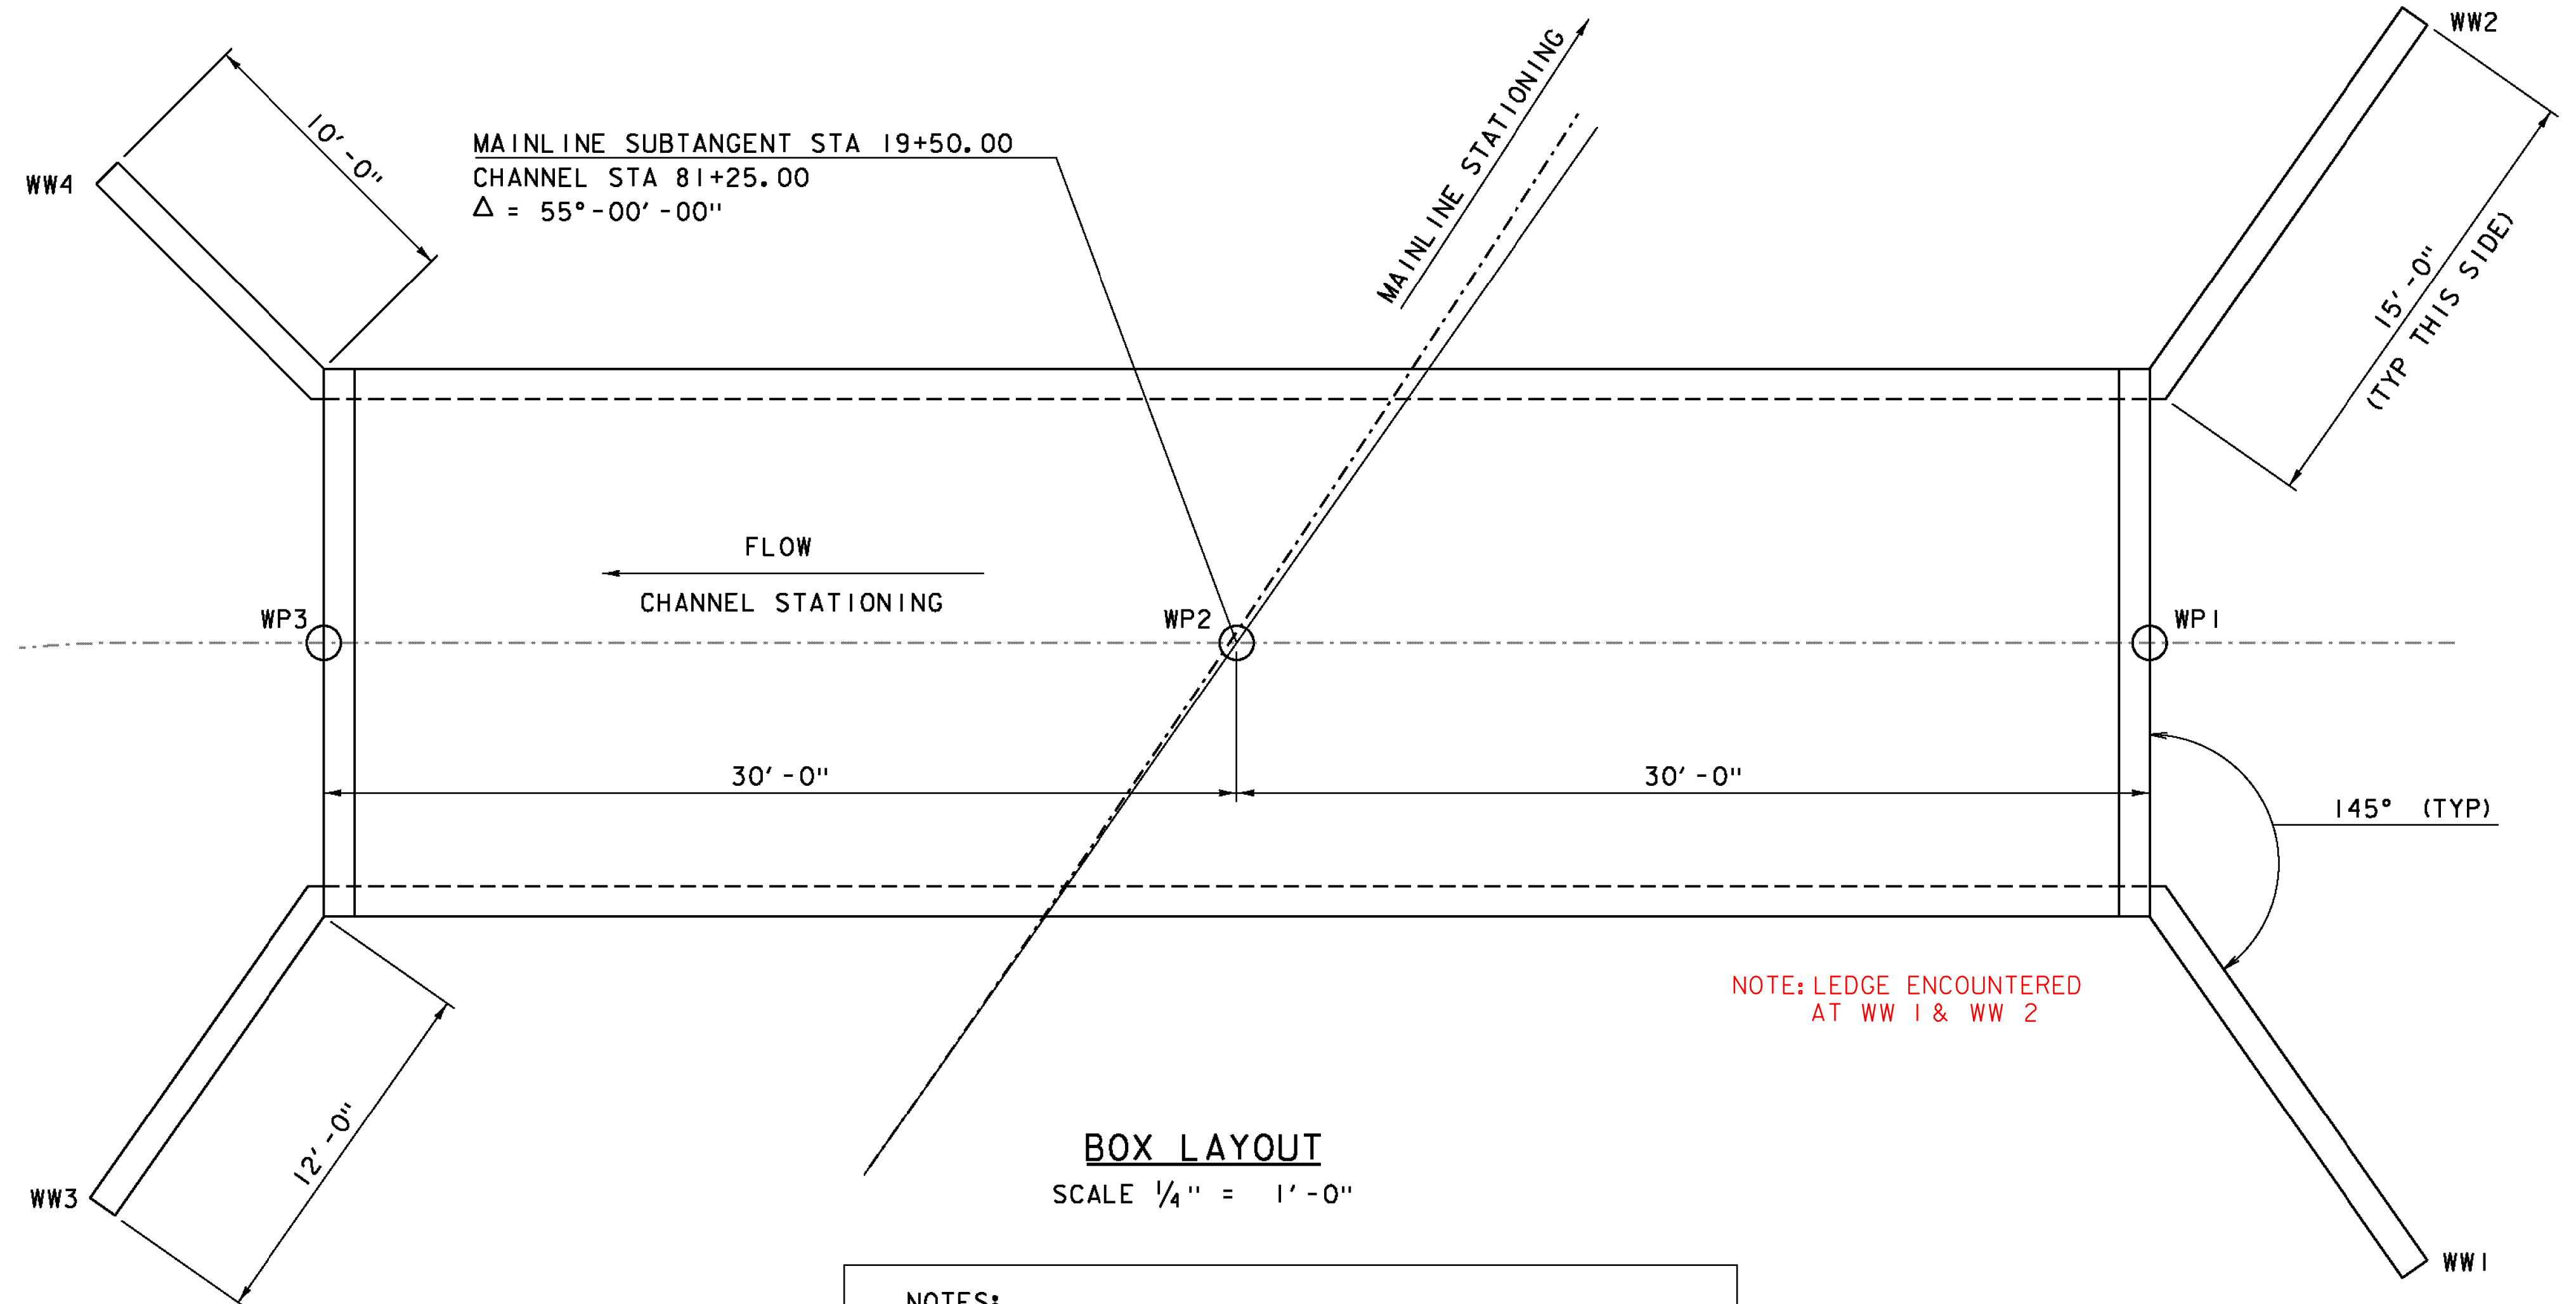

BOX LAYOUT

SCALE 1/4" = 1'-0"

NOTES:

1. DIMENSIONS SHOWN ARE BASED ON AN ASSUMED WALL THICKNESS OF 1'-0"
2. THE PRECAST BOX SECTIONS ARE SHOWN FOR REFERENCE ONLY. THE ACTUAL DIMENSIONS AND SHAPE WILL BE DEPENDENT ON THE FABRICATOR.

NOTE: LEDGE ENCOUNTERED AT WW 1 & WW 2

PROJECT NAME: WILMINGTON
PROJECT NUMBER: STP 013-1(14)

FILE NAME: s00b252box.dgn
PROJECT LEADER: K. HIGGINS
DESIGNED BY: J. SALVATORI
BOX LAYOUT

PLOT DATE: 02-JAN-2014
DRAWN BY: J. SALVATORI
CHECKED BY: G. LAROCHE
SHEET 19 OF 31