



18D WORDEN LOAM  
 WITH 15% TO 25% SLOPES  
 "K" FACTOR = 0.49  
 VERY BOULDERY

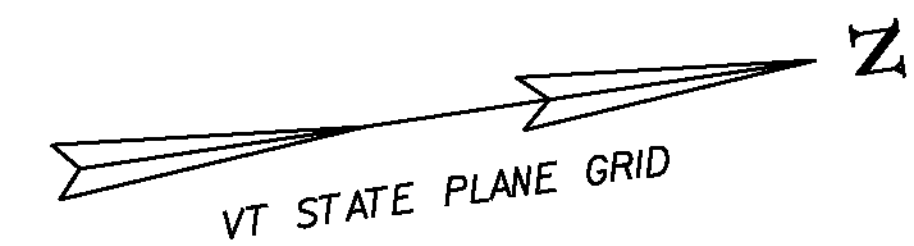

18C WORDEN LOAM  
 WITH 8% TO 15% SLOPES  
 "K" FACTOR = 0.49  
 VERY BOULDERY

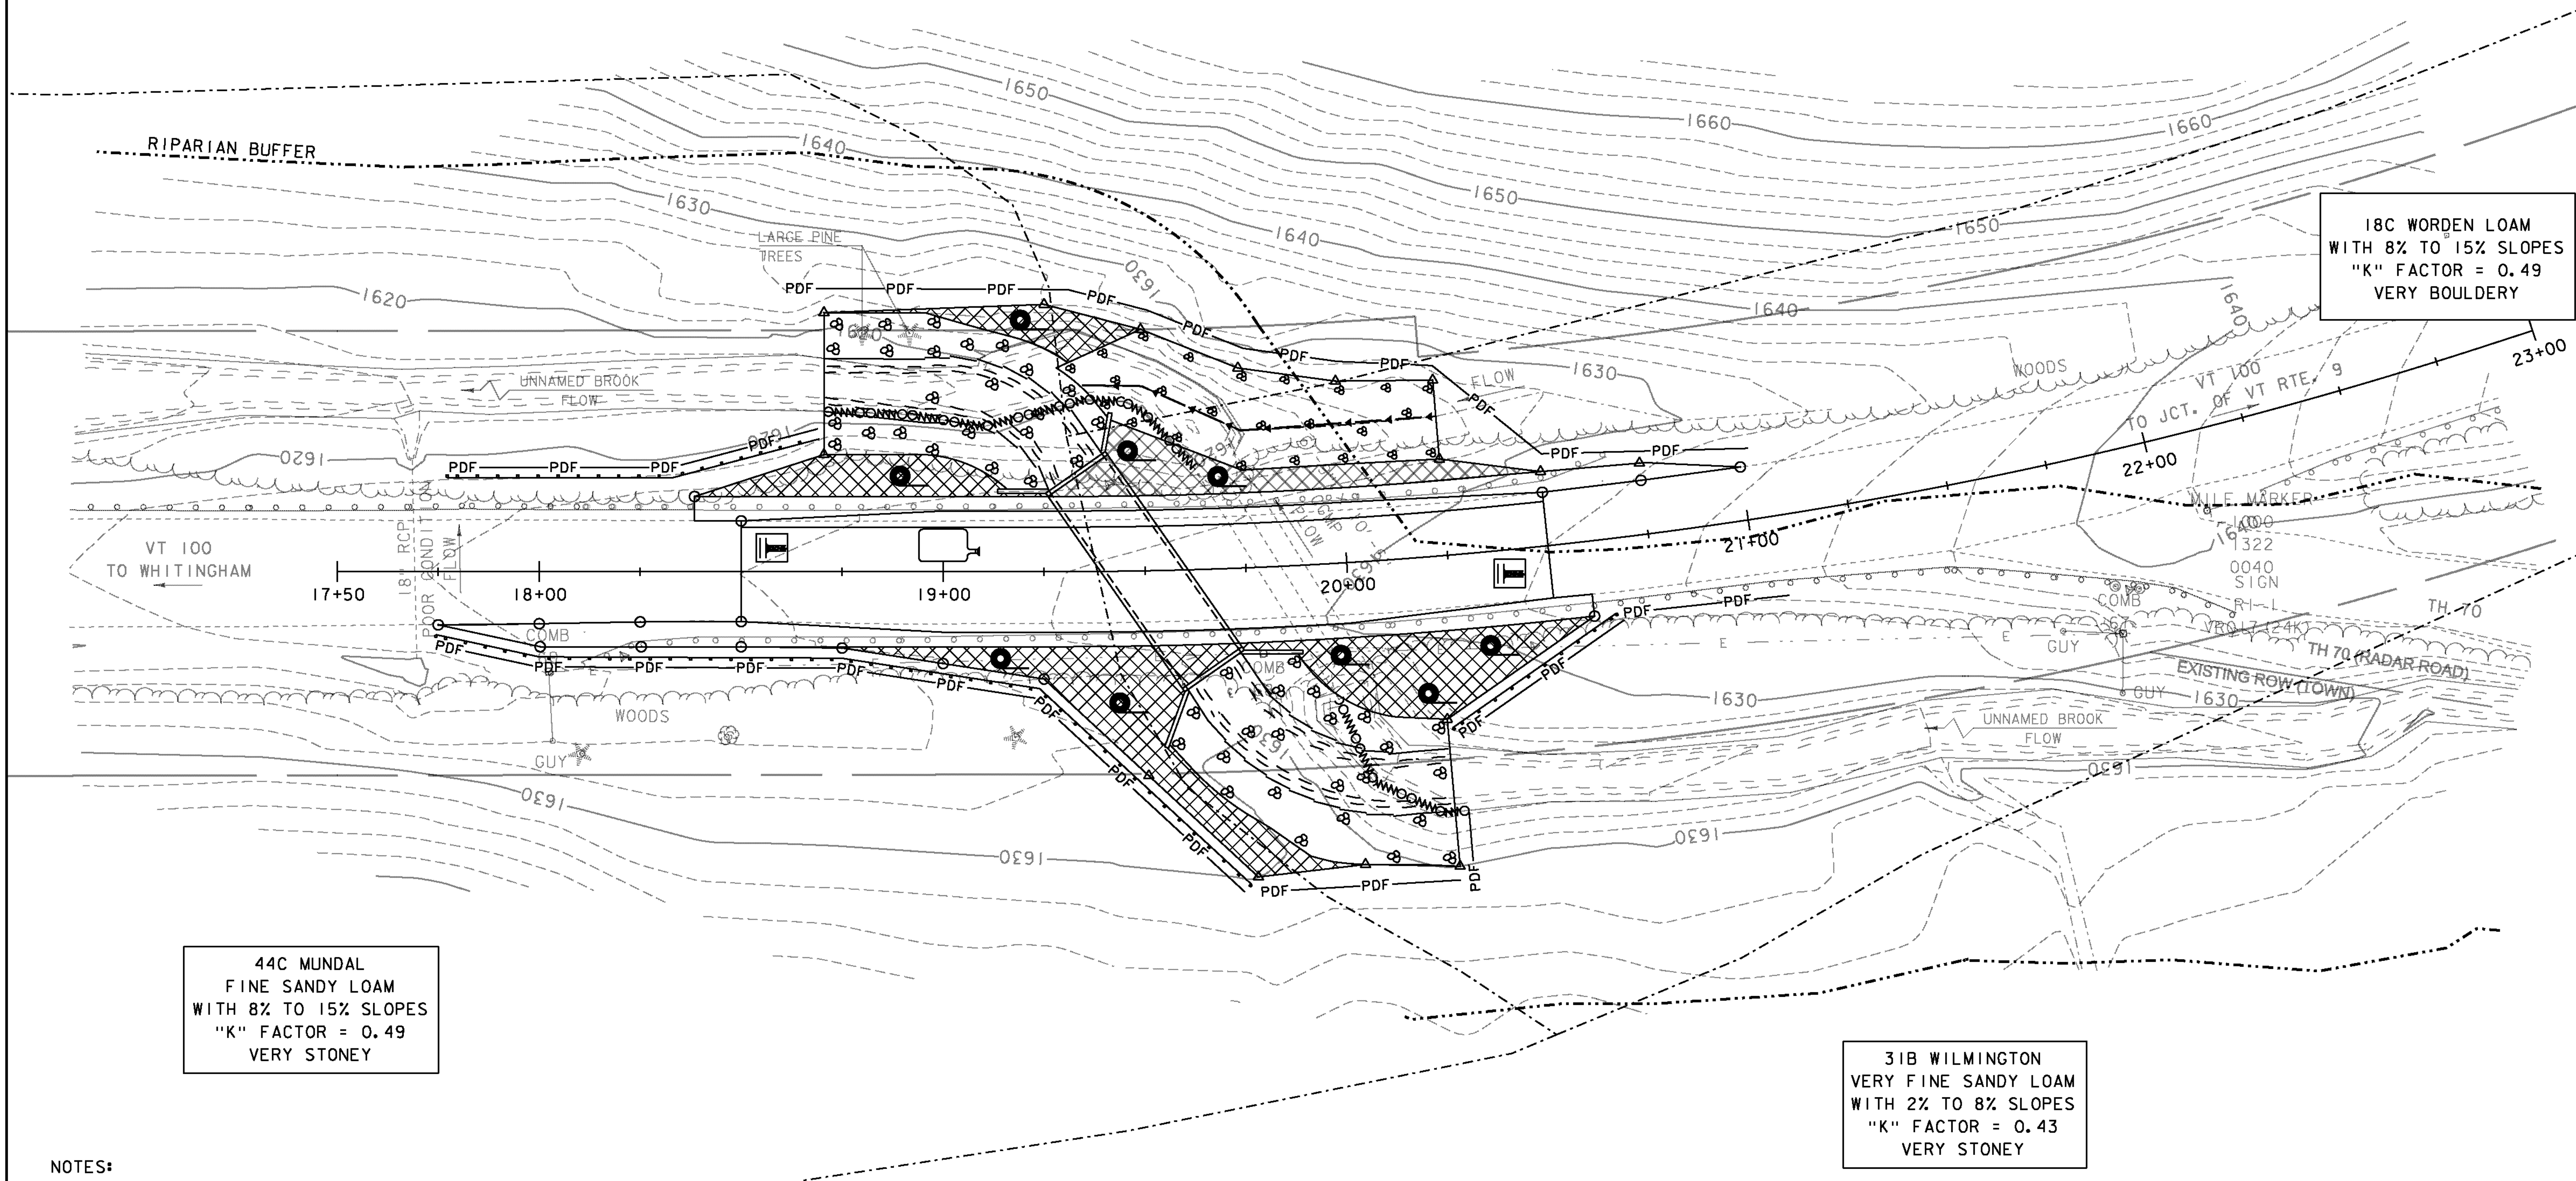

44C MUNDAL  
 FINE SANDY LOAM  
 WITH 8% TO 15% SLOPES  
 "K" FACTOR = 0.49  
 VERY STONEY

31B WILMINGTON  
 VERY FINE SANDY LOAM  
 WITH 2% TO 8% SLOPES  
 "K" FACTOR = 0.43  
 VERY STONEY

NOTES:

- EXISTING CONTOURS SHOWN. SEE CROSS SECTIONS FOR FINAL CONDITIONS.
- FOR CLARITY, AREAS TO BE SEEDED AND MULCHED HAVE NOT BEEN INDICATED. ALL DISTURBED AREAS SHALL BE SEEDED AND MULCHED AS APPLICABLE.

EPSC PLAN  
 SCALE 1" = 20'-0"  
 20 0 20

PROJECT NAME:	WILMINGTON	PLOT DATE:	02-JAN-2014
PROJECT NUMBER:	STP 013-1(14)	DRAWN BY:	J. SALVATORI
FILE NAME:	s00b252epsc.dgn	CHECKED BY:	G. LAROCHE
PROJECT LEADER:	K. HIGGINS	SHEET	21 OF 31
DESIGNED BY:	J. SALVATORI		
EPSC PLAN			