




18+00

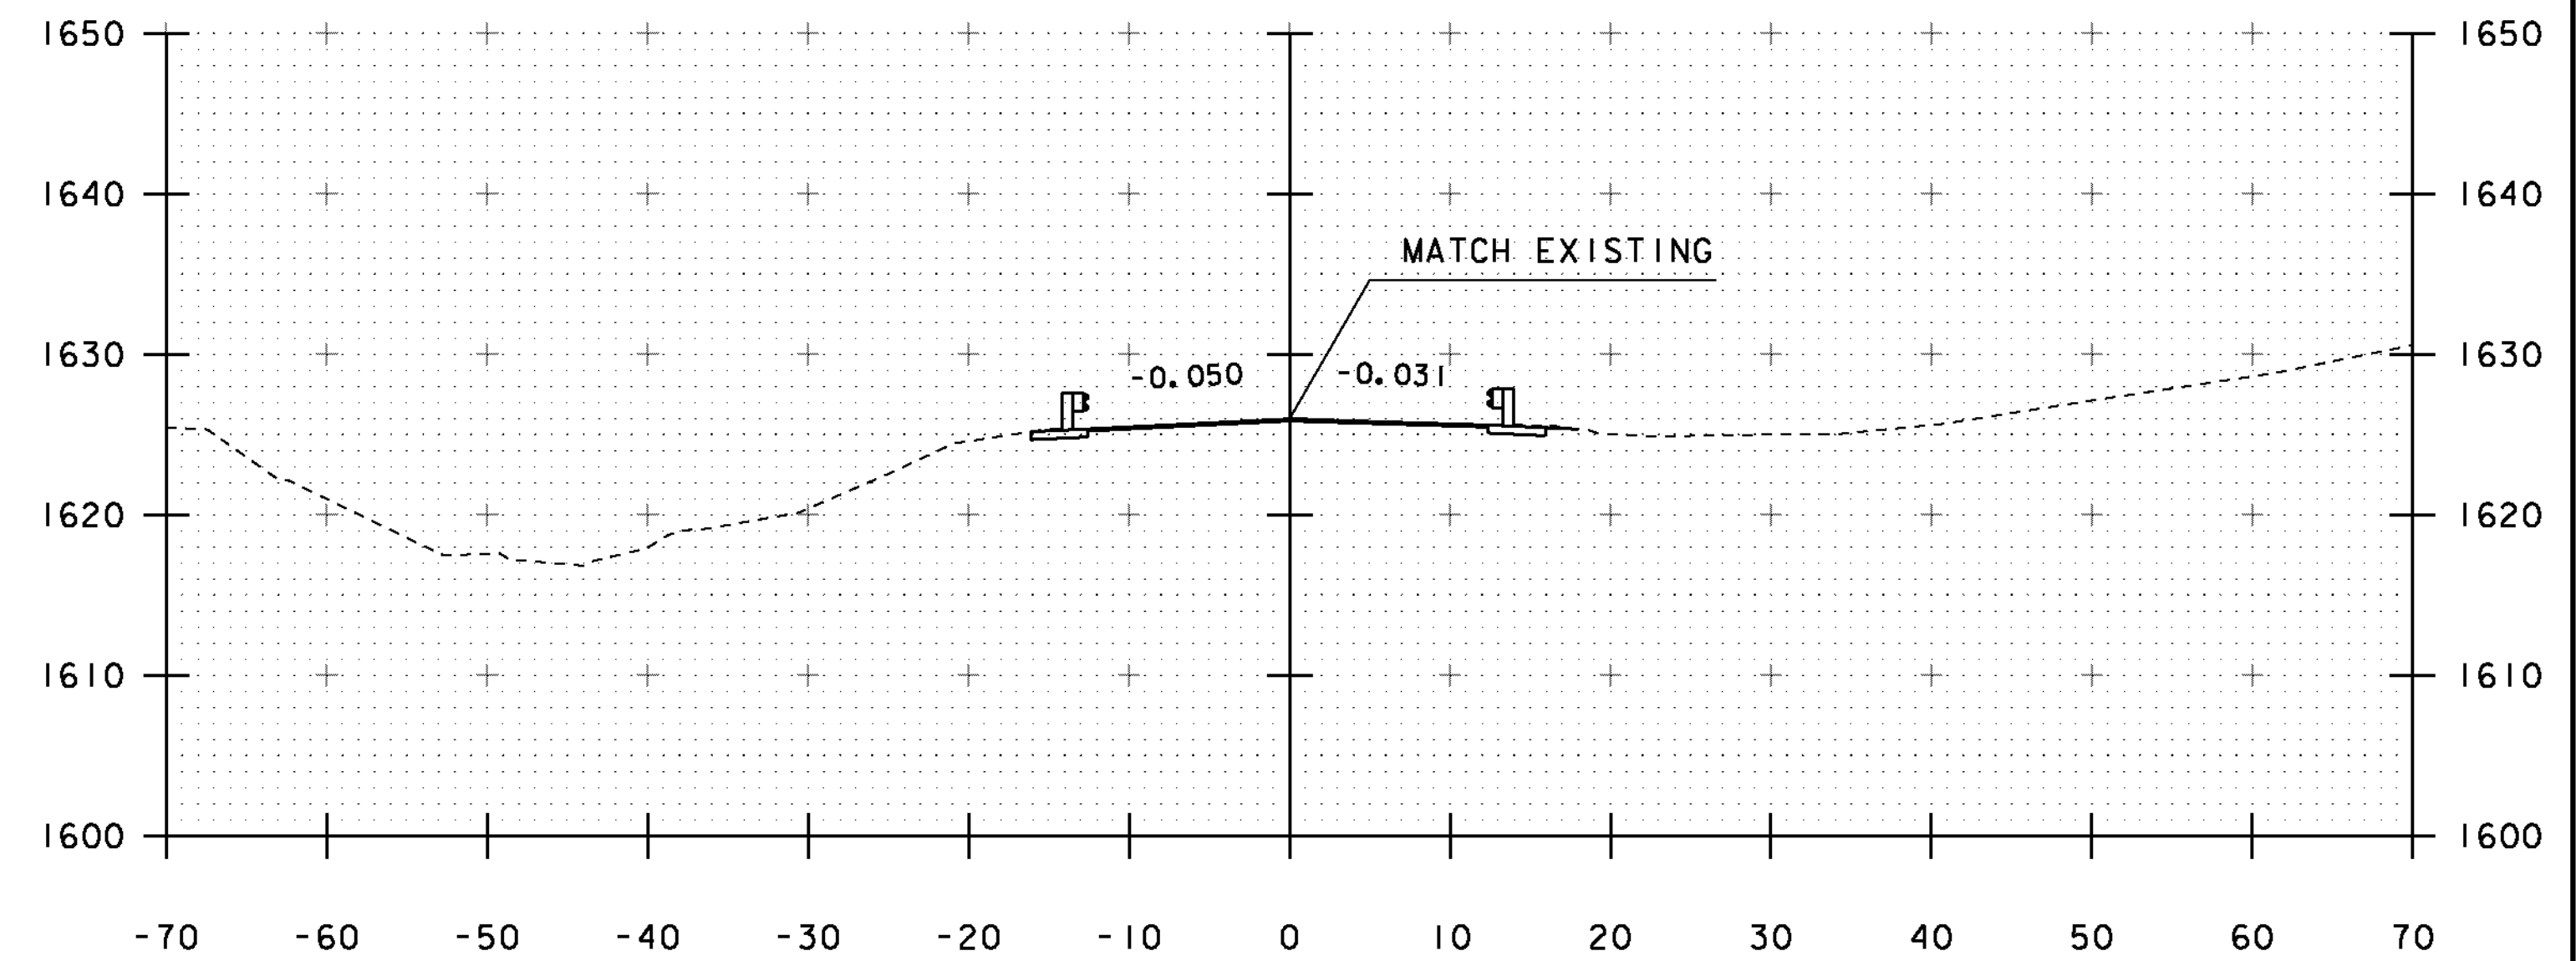

18+50
BEGIN PAVEMENT

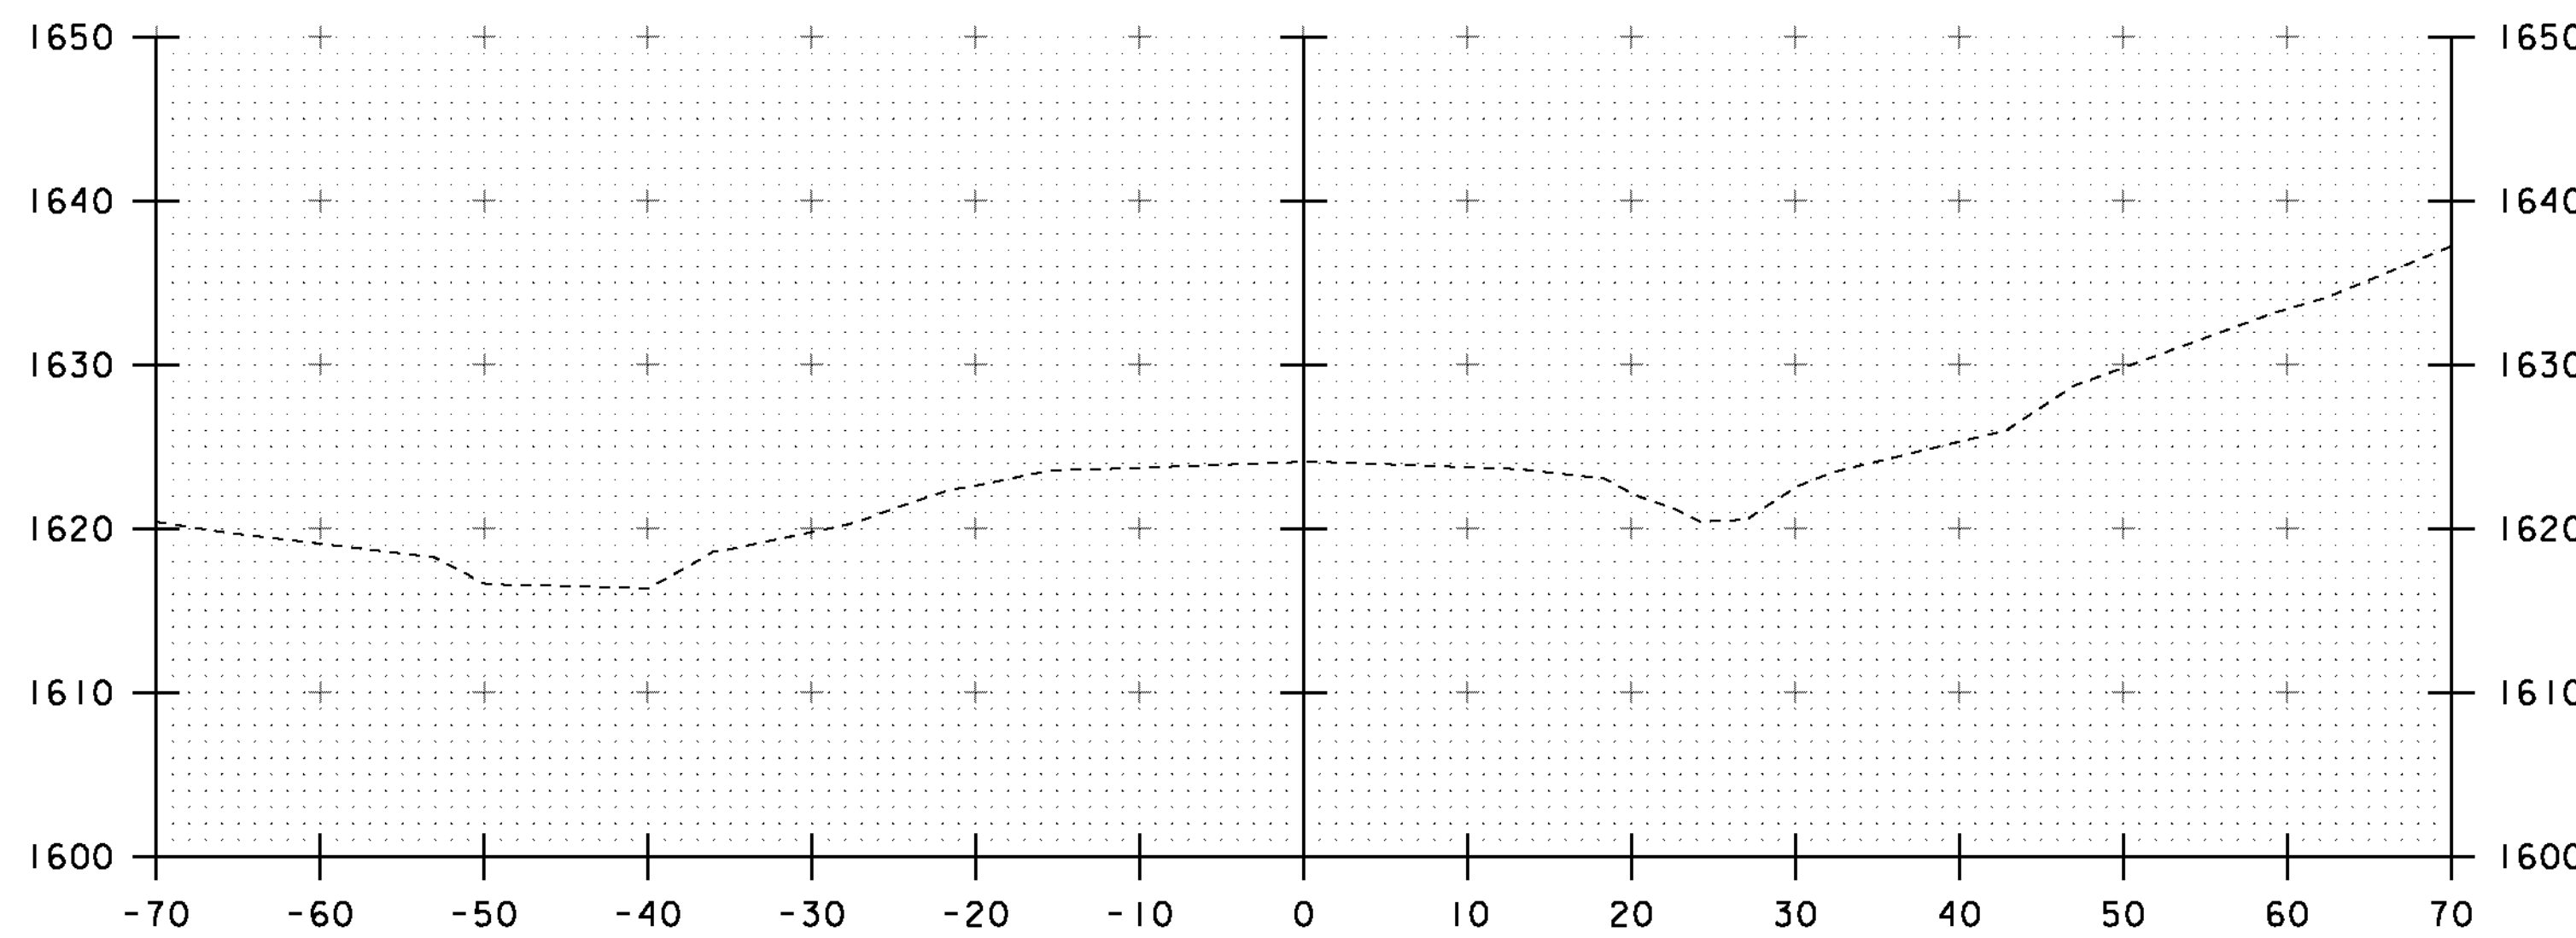

17+75
BEGIN APPROACH

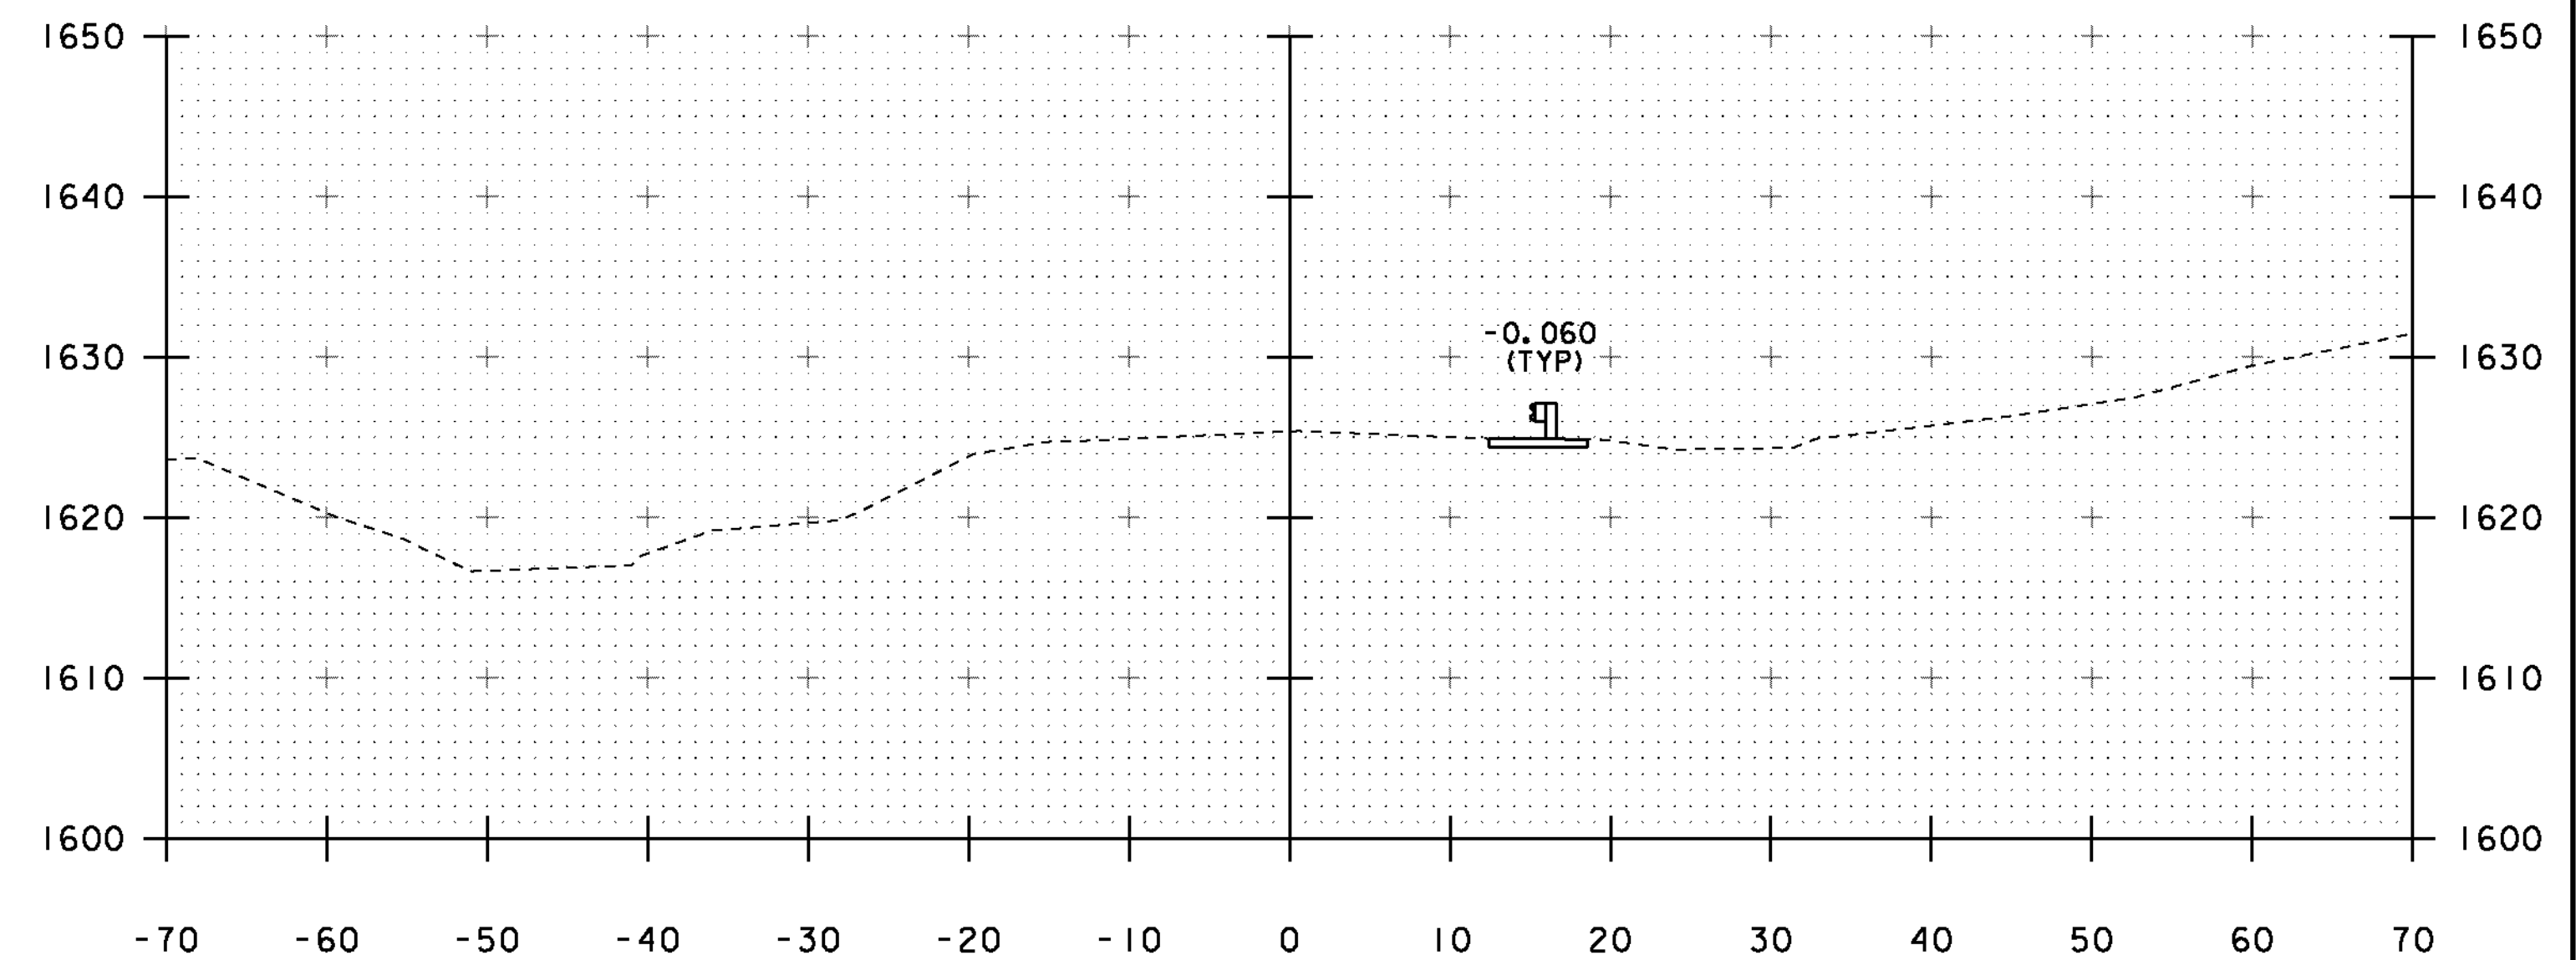

18+25

STA. 17+75 TO STA. 18+50

PROJECT NAME: WILMINGTON	
PROJECT NUMBER: STP 013-1(14)	
FILE NAME: s00b252xs.dgn	PLOT DATE: 02-JAN-2014
PROJECT LEADER: K. HIGGINS	DRAWN BY: J. SALVATORI
DESIGNED BY: J. SALVATORI	CHECKED BY: G. LAROCHE
MAINLINE SECTIONS 1	SHEET 23 OF 31