




19+00  
BEGIN PROJECT

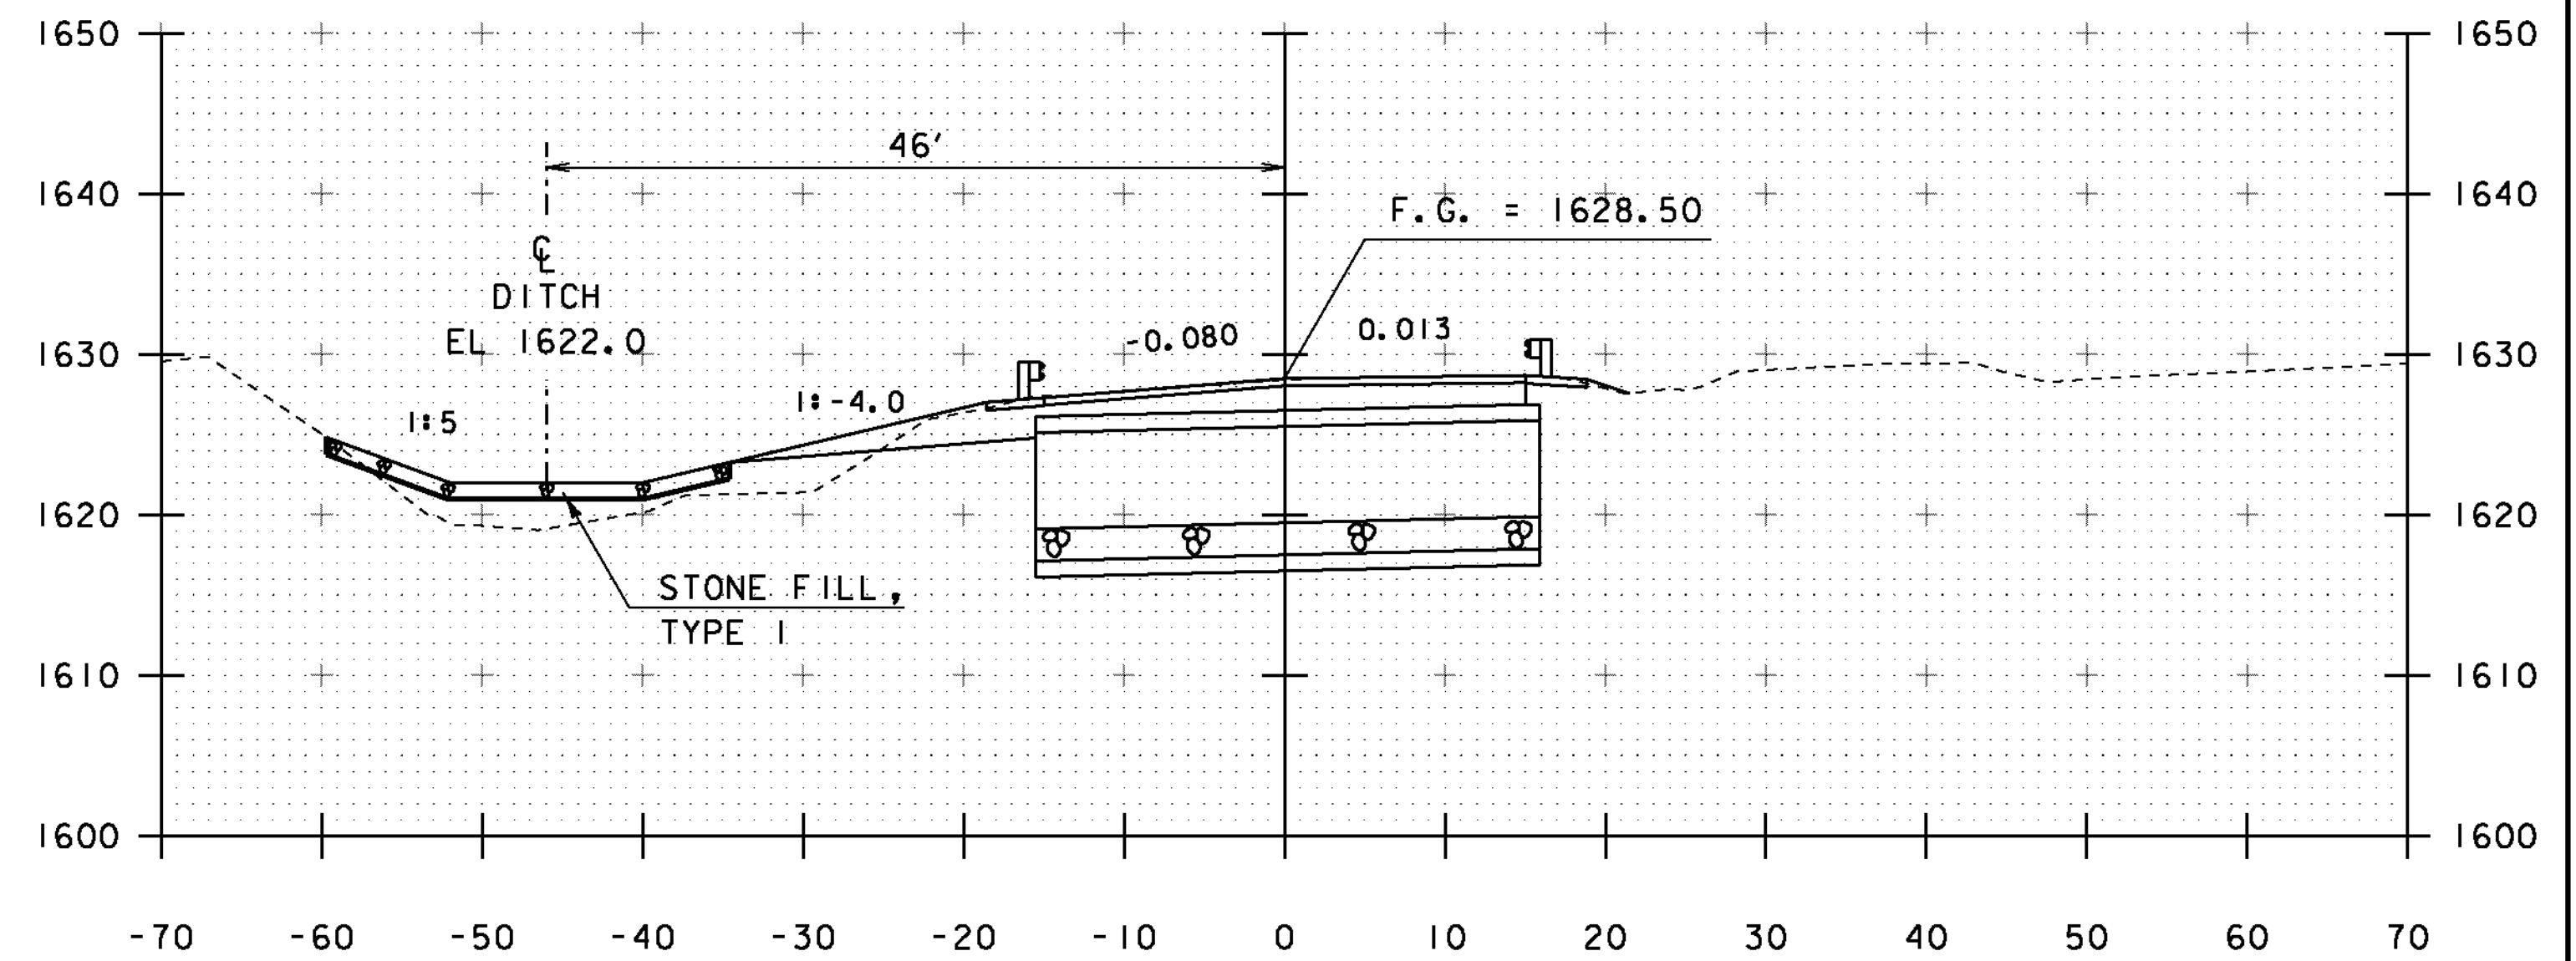

19+50

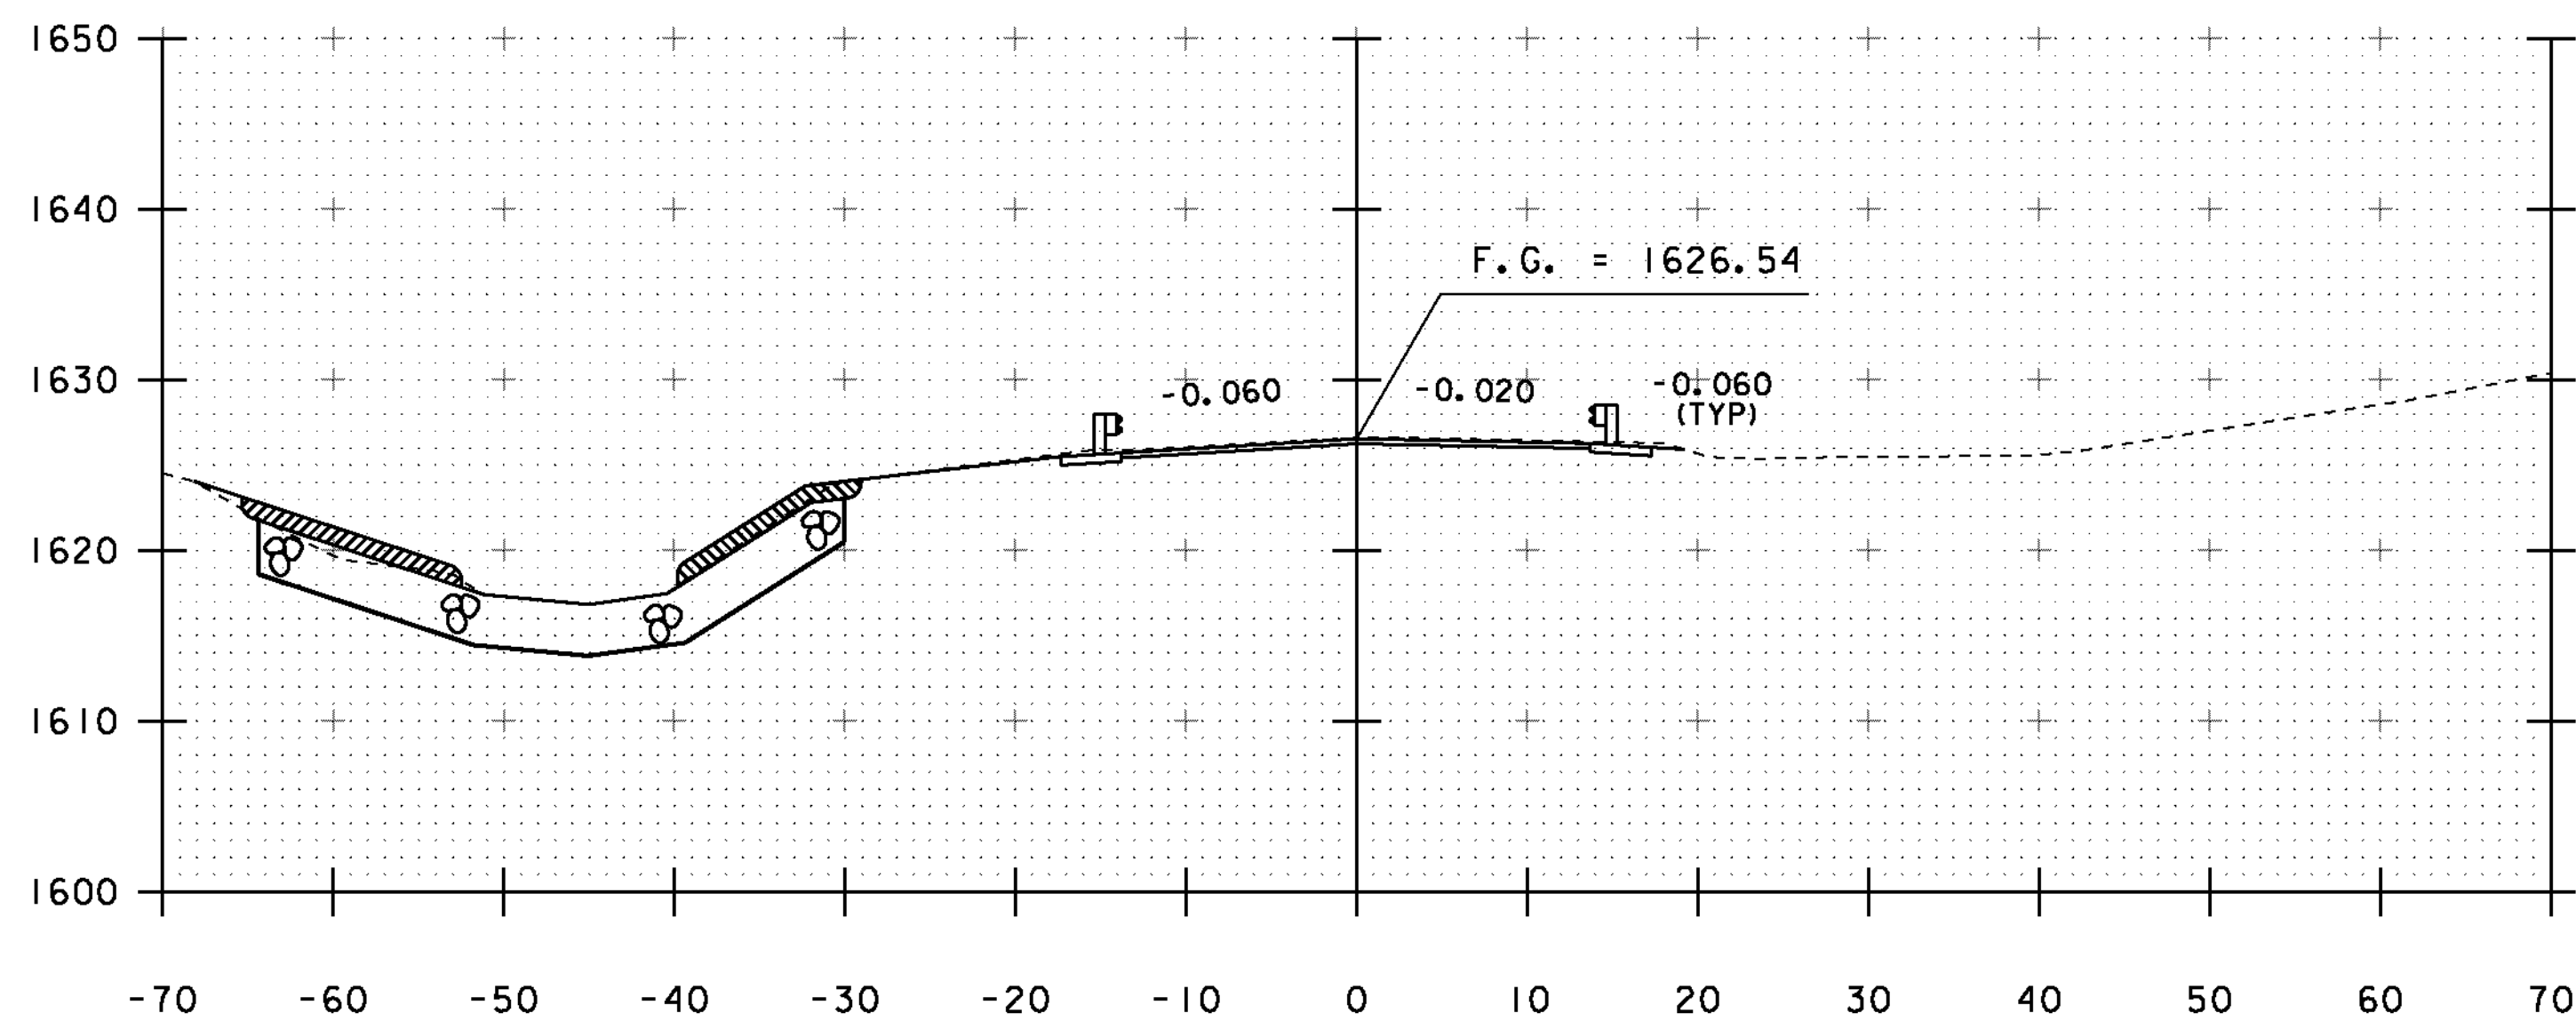

18+75

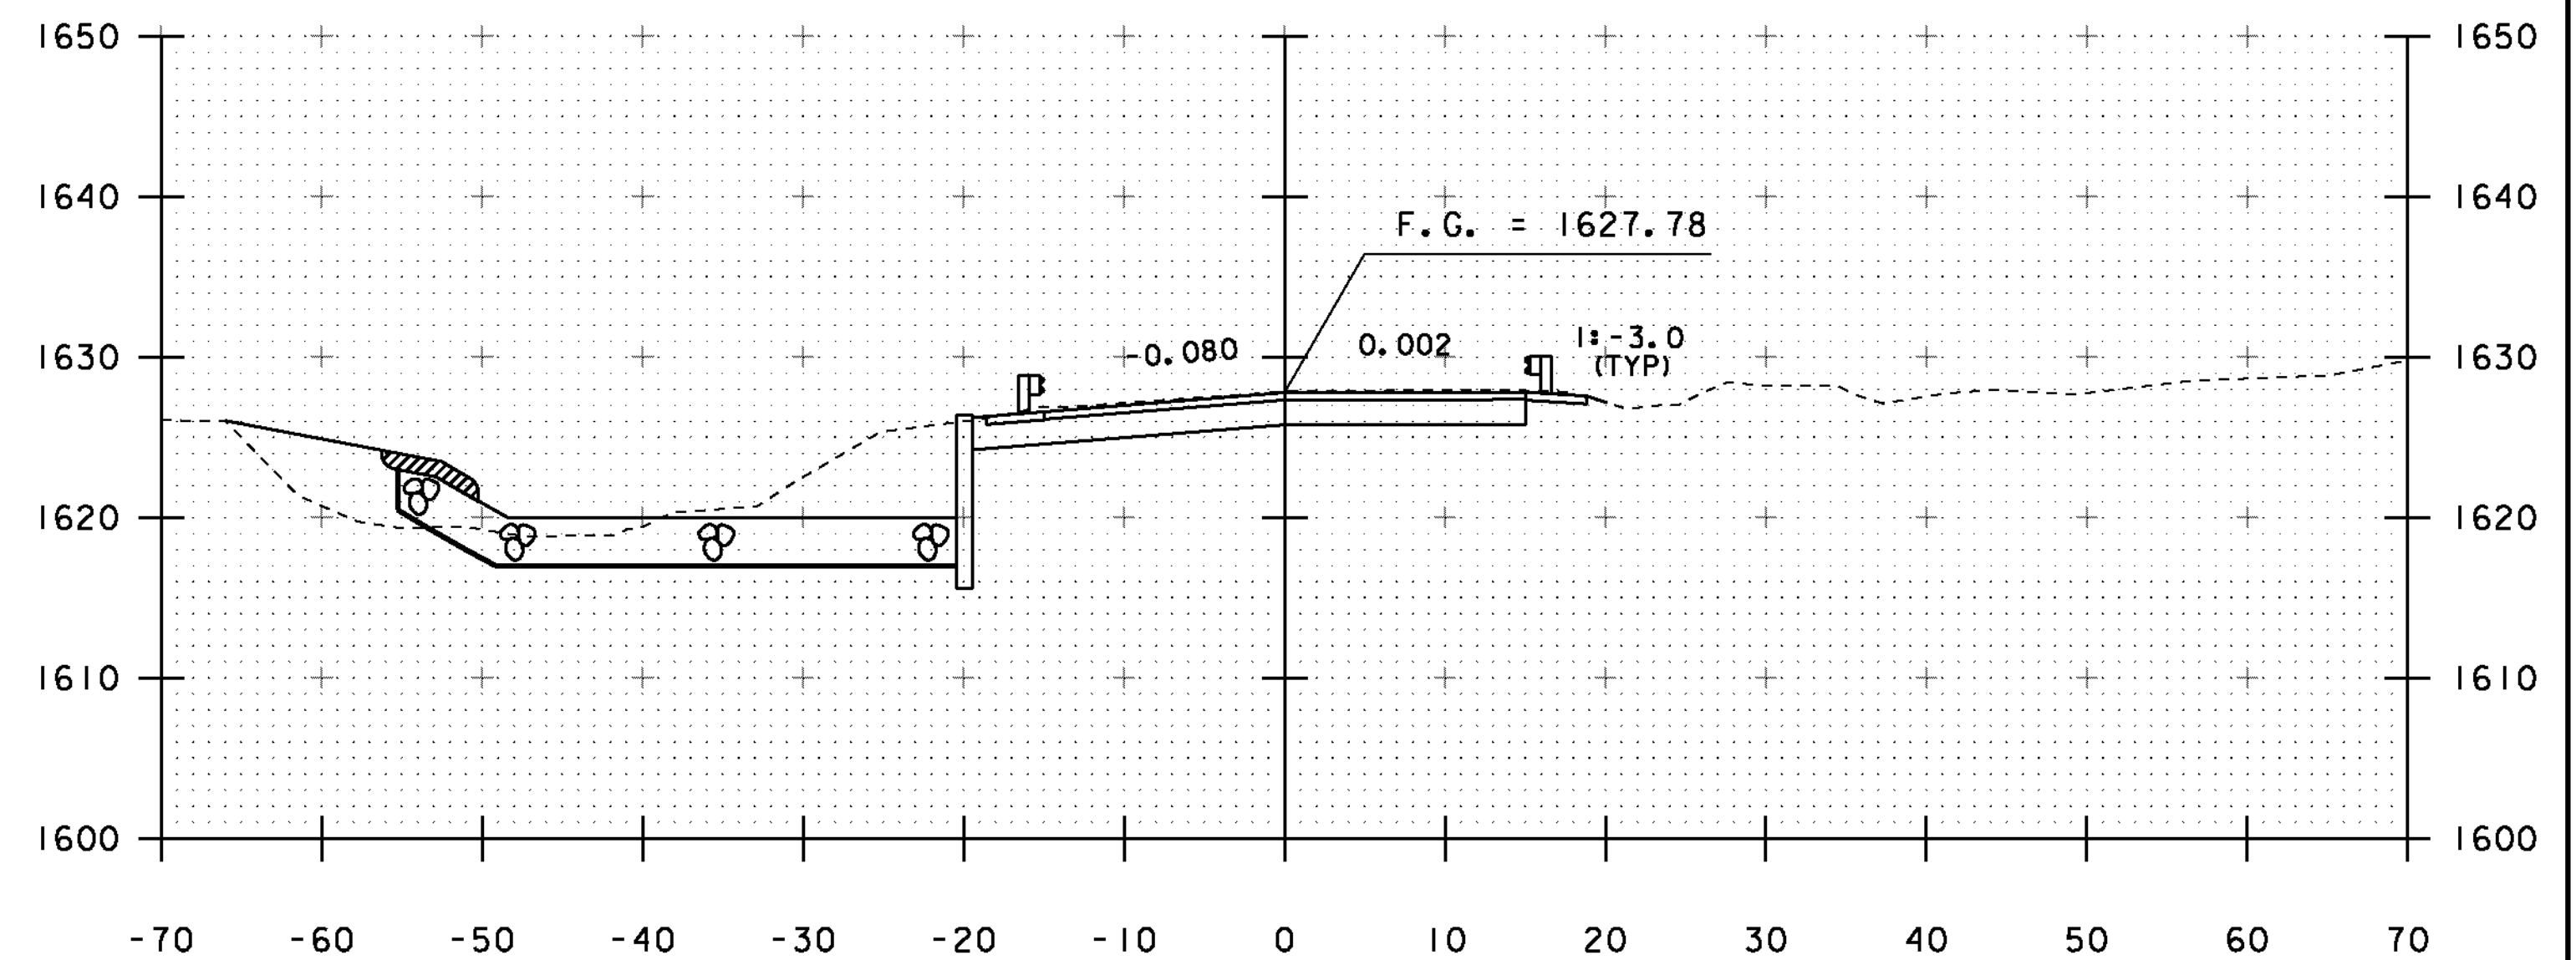

19+25

STA. 18+75 TO STA. 19+50

PROJECT NAME: WILMINGTON	
PROJECT NUMBER: STP 013-1(14)	
FILE NAME: s00b252xs.dgn	PLOT DATE: 02-JAN-2014
PROJECT LEADER: K. HIGGINS	DRAWN BY: J. SALVATORI
DESIGNED BY: J. SALVATORI	CHECKED BY: G. LAROCHE
MAINLINE SECTIONS 2	SHEET 24 OF 31