




20+00  
END PROJECT

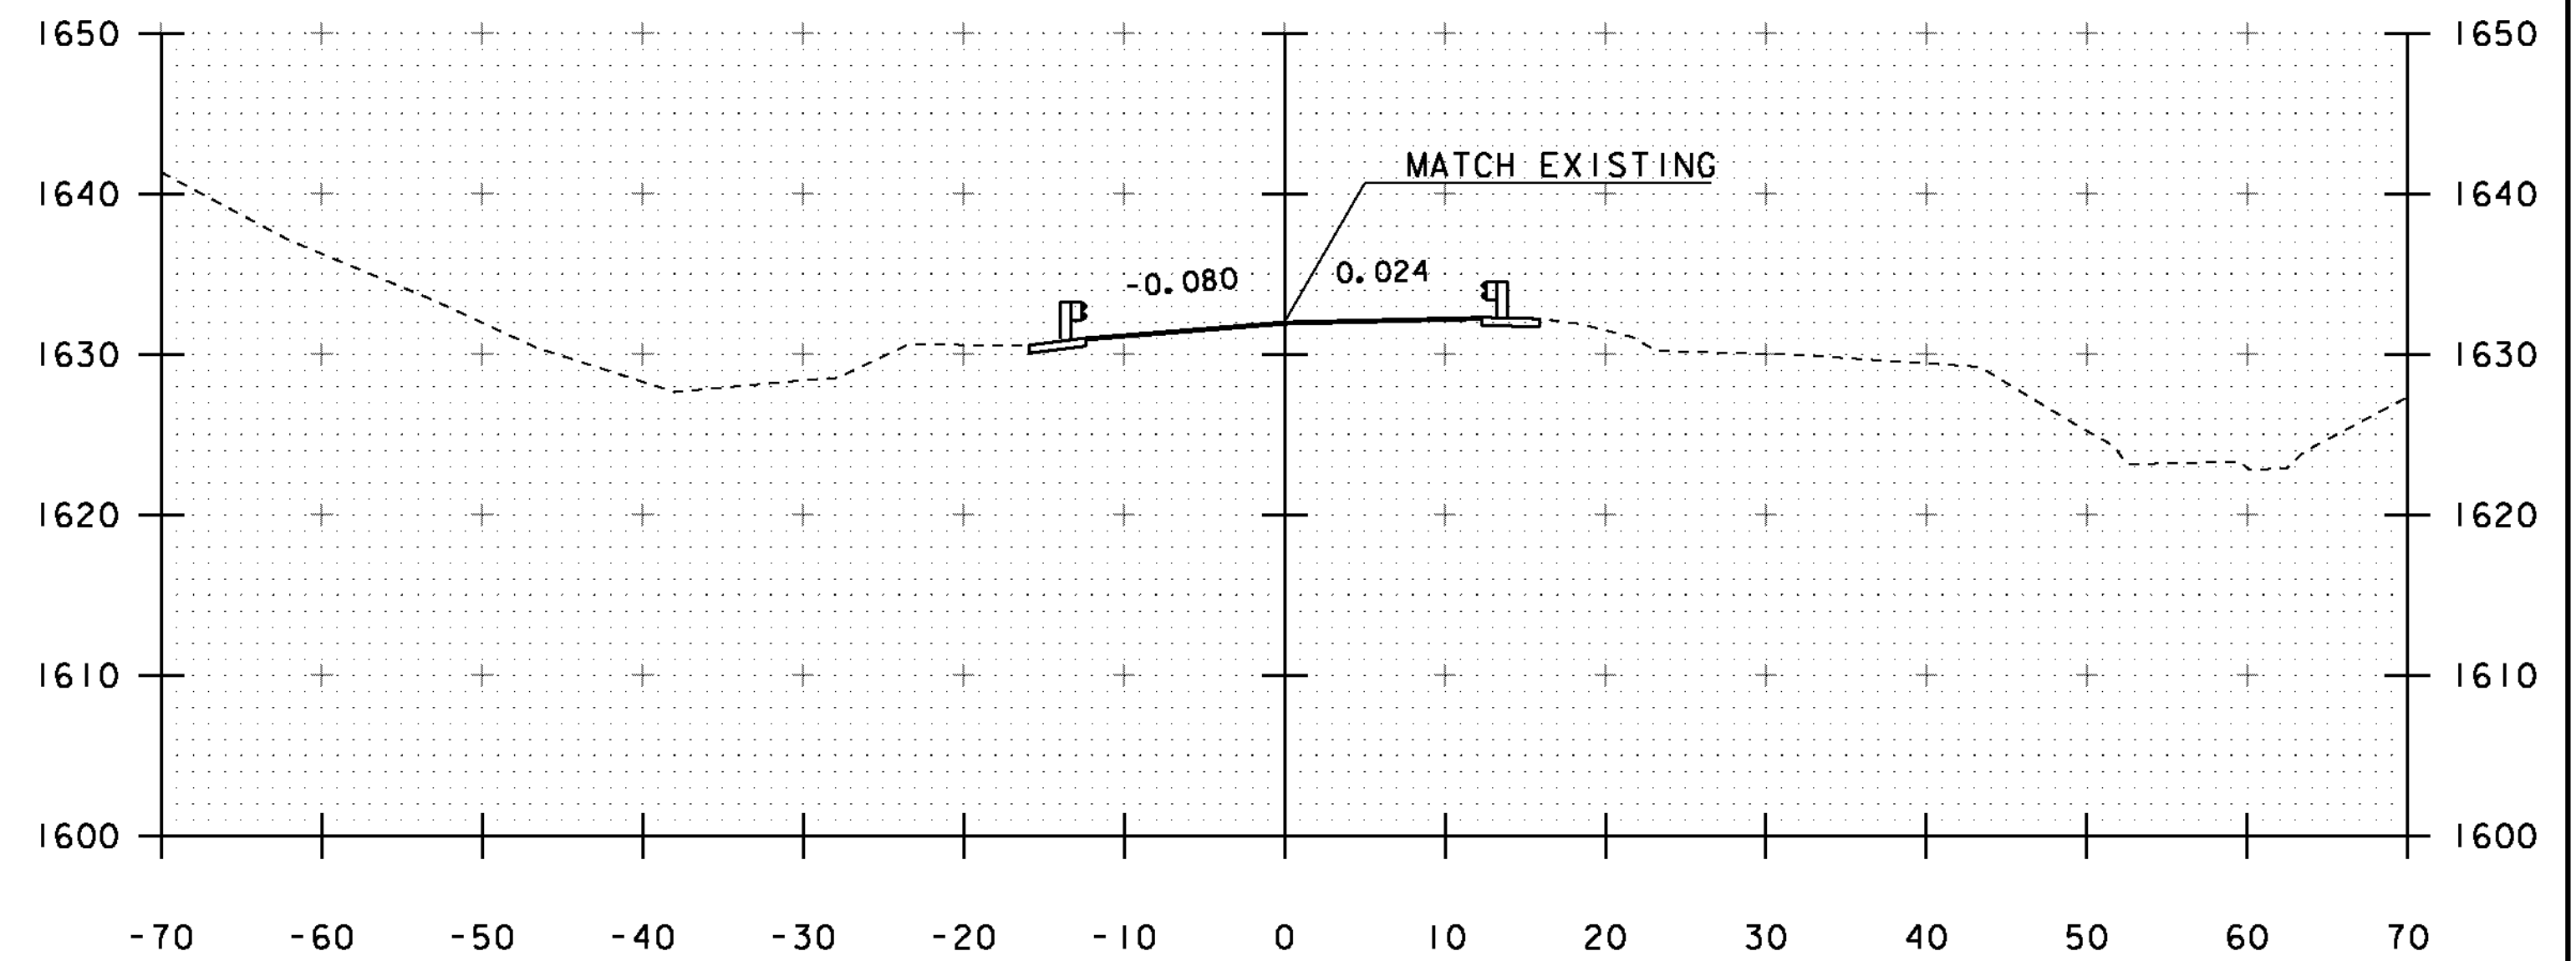

20+50  
END PAVEMENT

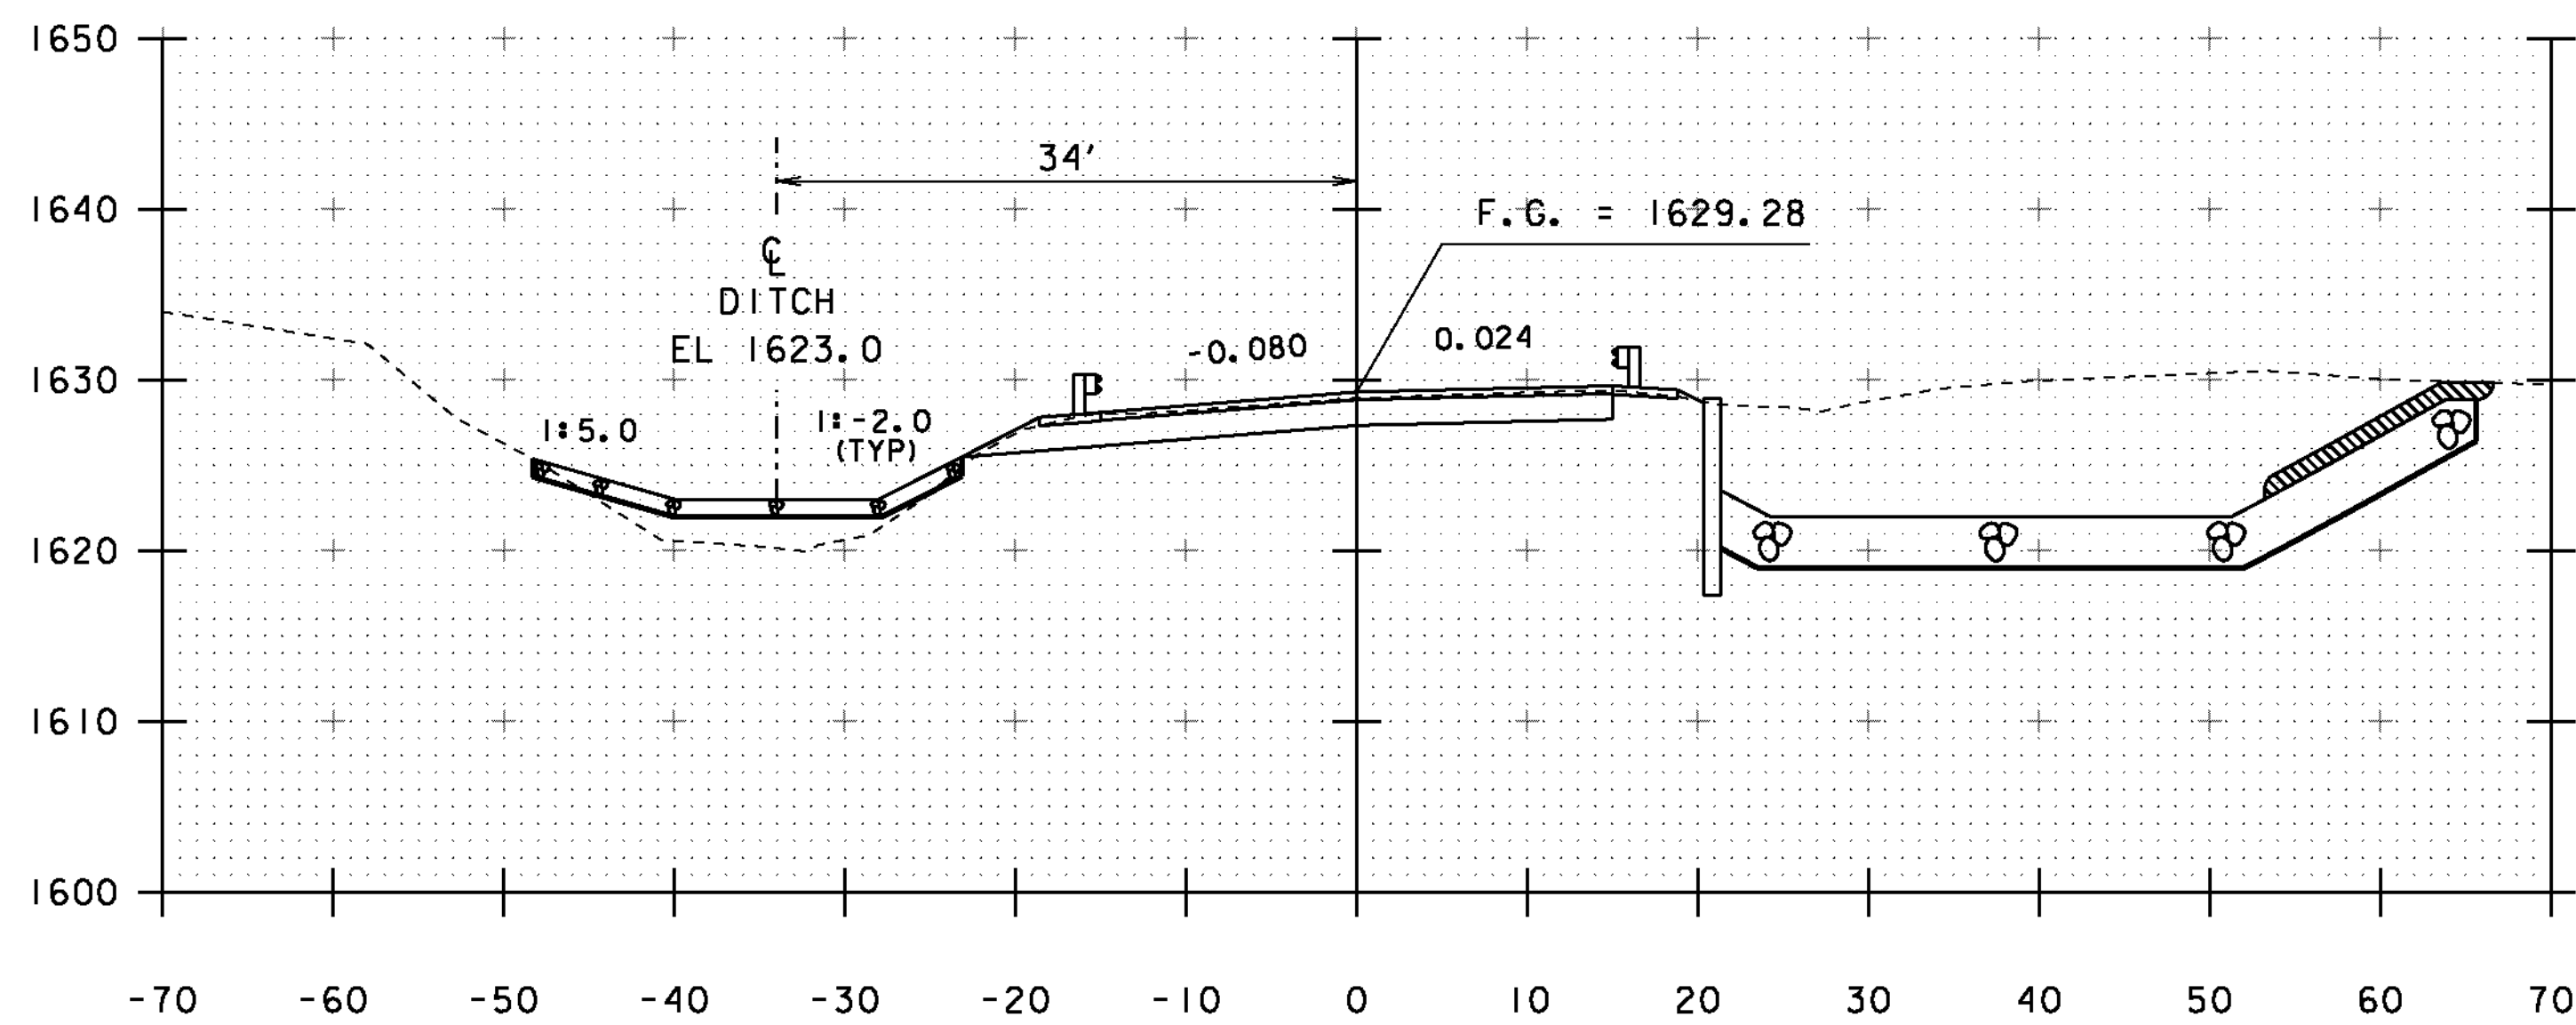

19+75

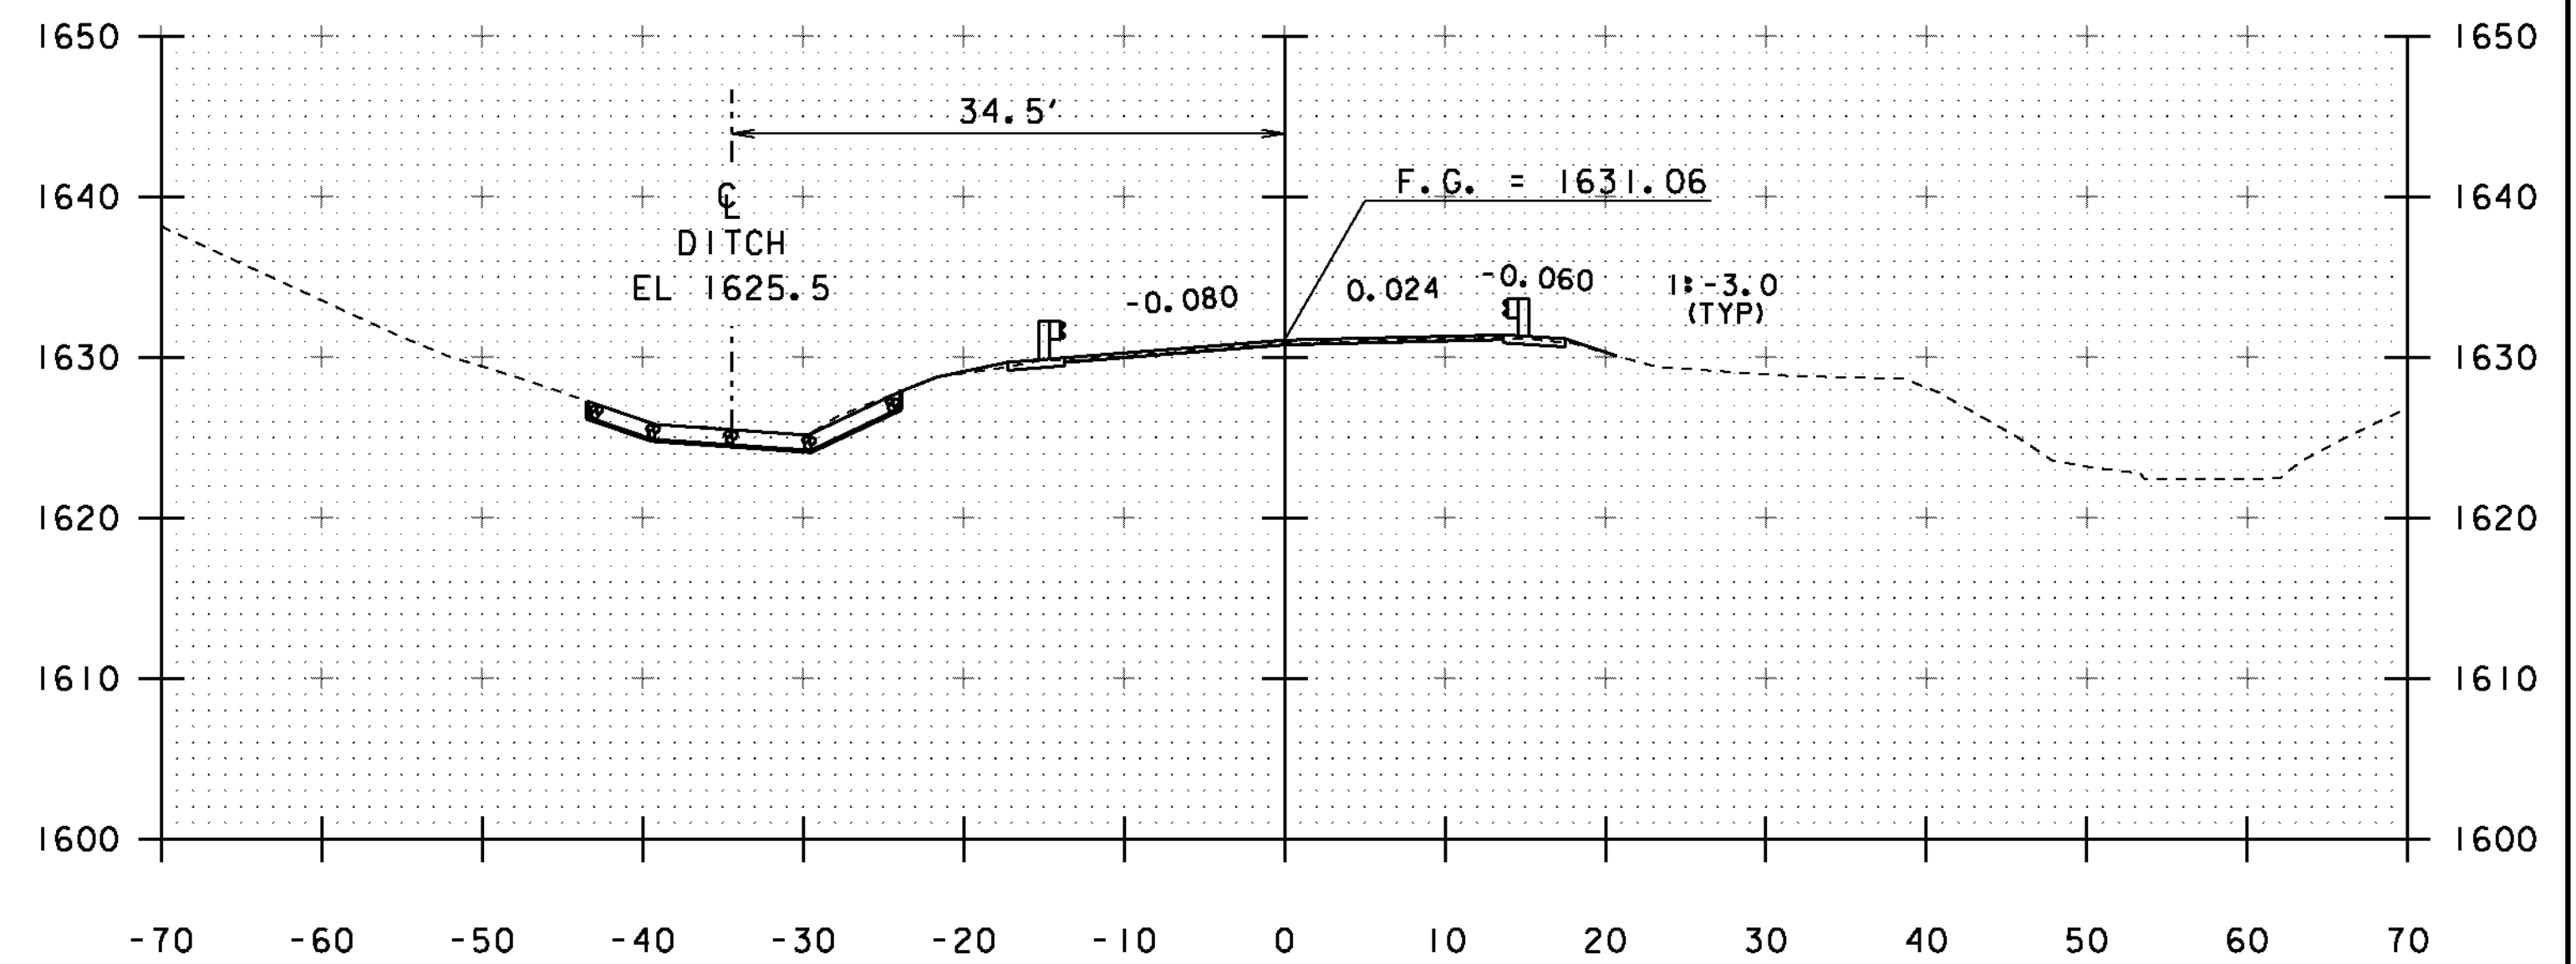

20+25

STA. 19+75 TO STA. 20+50

PROJECT NAME: WILMINGTON  
PROJECT NUMBER: STP 013-1(14)

FILE NAME: s00b252xs.dgn  
PROJECT LEADER: K. HIGGINS  
DESIGNED BY: J. SALVATORI  
MAINLINE SECTIONS 3

PLOT DATE: 02-JAN-2014  
DRAWN BY: J. SALVATORI  
CHECKED BY: G. LAROCHE  
SHEET 25 OF 31