


21+00
END APPROACH

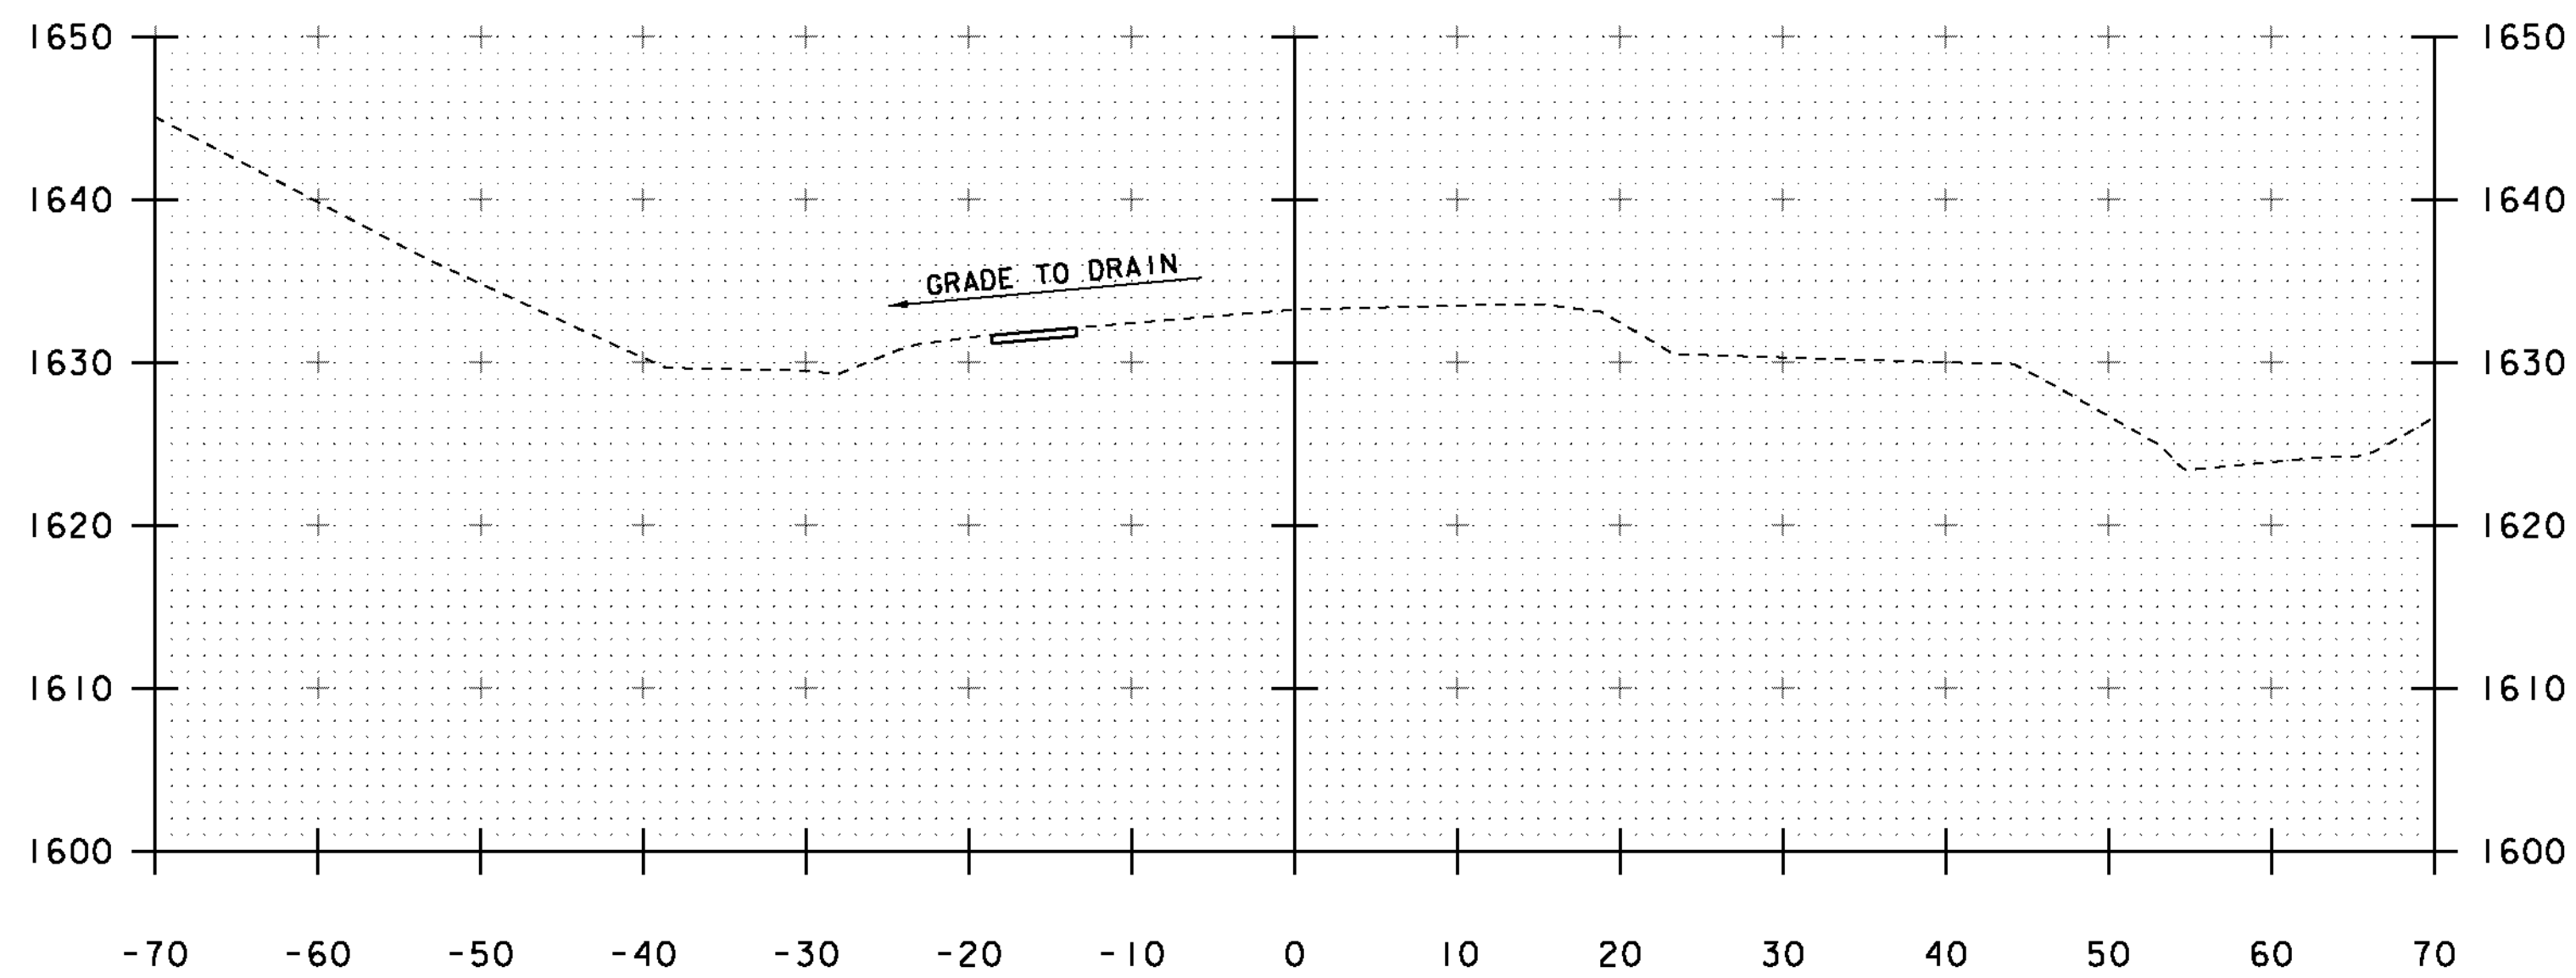

20+75

STA. 20+75 TO STA. 21+00

PROJECT NAME: WILMINGTON
PROJECT NUMBER: STP 013-1(14)

FILE NAME: s00b252xs.dgn
PROJECT LEADER: K. HIGGINS
DESIGNED BY: J. SALVATORI
MAINLINE SECTIONS 4

PLOT DATE: 02-JAN-2014
DRAWN BY: J. SALVATORI
CHECKED BY: G. LAROCHE
SHEET 26 OF 31