

TEMPORARY AND DURABLE 100mm YELLOW LINE
 STA 0+400 TO 0+475 DOUBLE SOLID LT&RT
 STA 0+475 TO 0+800 SOLID LT, DASHED RT
 STA 0+475 TO 0+800 SOLID RT, DASHED RT
 STA 0+566 LT DOUBLE SOLID LT
 STA 0+684 RT DOUBLE SOLID RT
 (WITH CENTERLINE BREAKS FOR TOWN HIGHWAYS)

TEMPORARY AND DURABLE 200mm YELLOW LINE
 STA 0+400 TO 0+475 C.L.

TEMPORARY AND DURABLE 600mm STOP BAR
 STA 0+566 LT SHATTUCK HILL RD
 STA 0+684 RT CRAWFORD RD

TEMPORARY AND DURABLE 100mm WHITE LINE
 STA 0+400 TO 0+800 SOLID LT&RT
 (WITH EDGELINE BREAKS FOR TOWN HIGHWAYS)


TEMPORARY AND DURABLE LETTER OR SYMBOL
 STA 0+475 C.L.
 STA 0+550 C.L.
 STA 0+566 LT
 STA 0+575 C.L.
 STA 0+663 C.L.
 STA 0+684 RT
 STA 0+689 C.L.
 STA 0+793 C.L.

REMOVING SIGNS
 12

CHANGING ELEVATION OF D.I.'S, C.B.'S OR M.H.'S
 STA 0+723 RT
 STA 0+766 RT

ADJUST ELEVATION OF VALVE BOX
 STA 0+475 RT

REHABILITATION OF D.I./CB OR MH
 0 + 576 RT
 0 + 729 RT
 0 + 776 RT
 0 + 777 LT

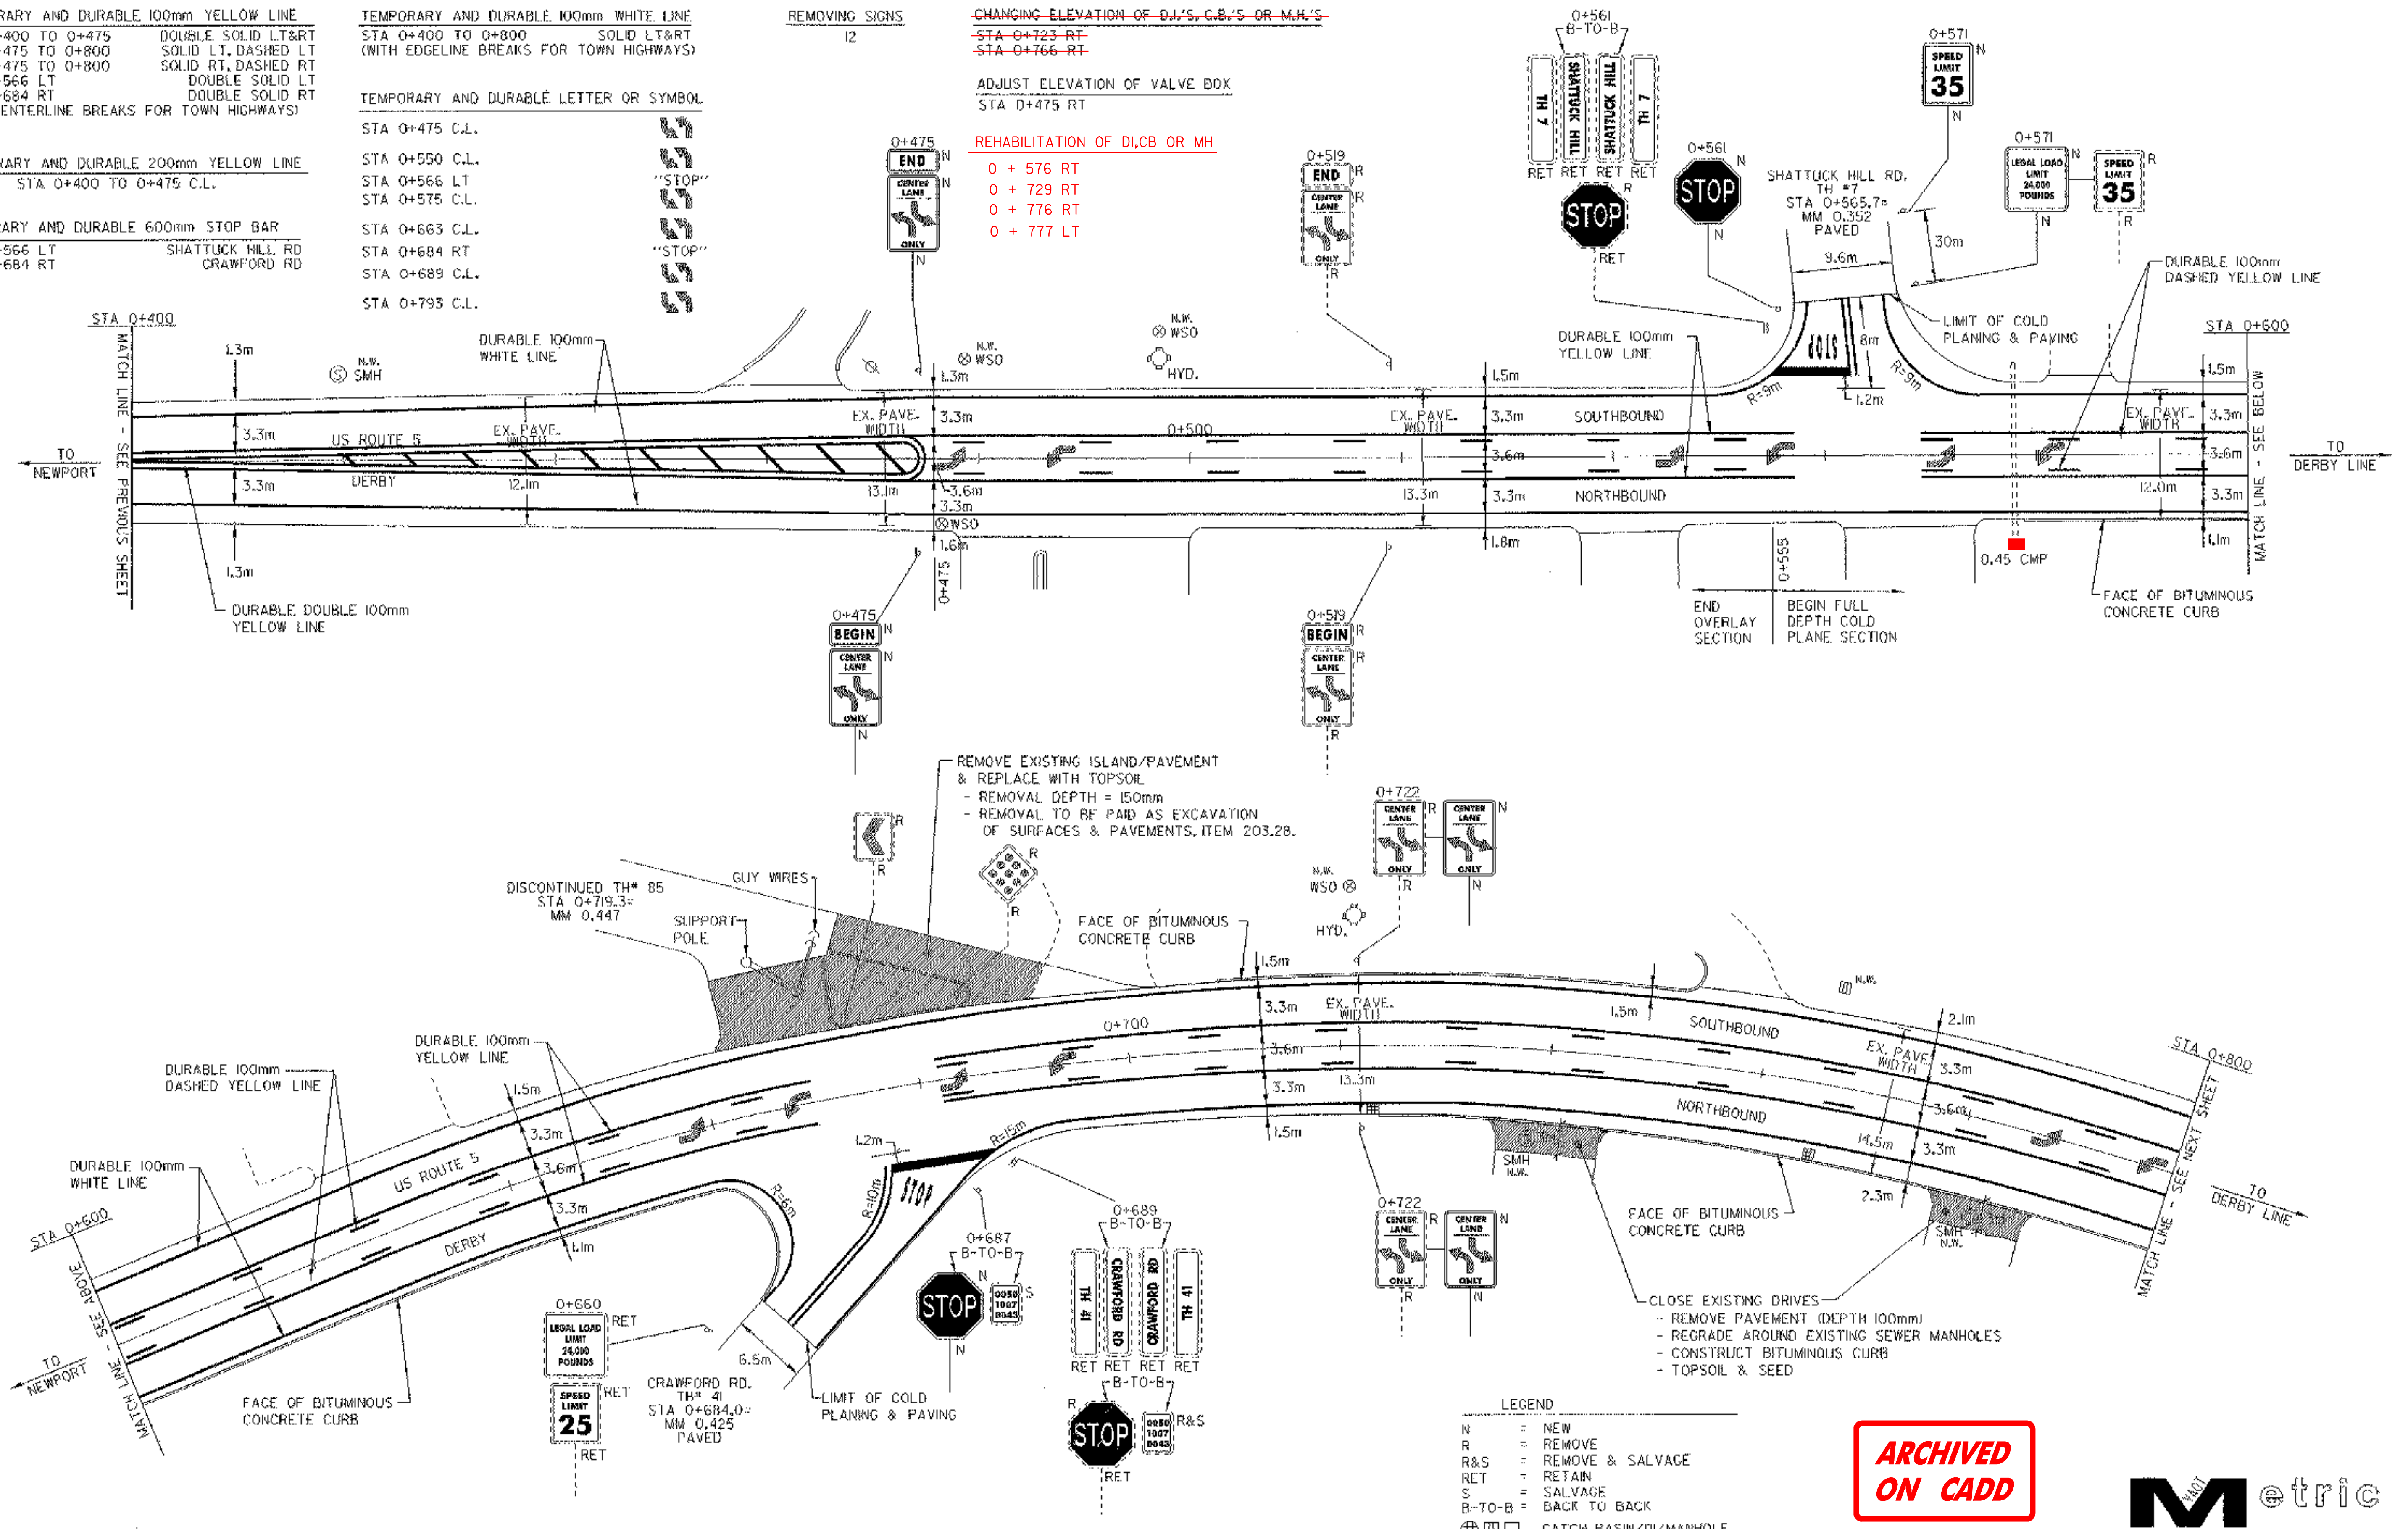

- LEGEND
- N = NEW
 - R = REMOVE
 - R&S = REMOVE & SALVAGE
 - RET = RETAIN
 - S = SALVAGE
 - B-T-O-B = BACK TO BACK
 - ⊕ □ CATCH BASIN/DI/MANHOLE
 - N.W. ⊕ EXISTING CB/DI (NO WORK REQUIRED)
 - ⊙ SEWER MANHOLE
 - I MARKER POST
 - ⊙ UTILITY POLE
 - U/E ⊙ UTIL. POLE W/UNDERGROUND UTIL.
 - ⊙ VALVE/CURB STOP
 - DRIVE

ARCHIVED ON CADD



PAVING PROJECT LAYOUT #2	DESIGNED BY	BCE/PJM	DATE	12-00
	DRAWN BY	C.E.A., INC.	DATE	12-00
	DESIGN FILE NO.	/pave/00c052/p0052a.dgn		
	PRF FILE	p0052a.p02.1	DATE	12-00
			PLOTTED	05-JUN-2003
PROJ. NAME	DERBY			
PROJ. NO.	STP 2224(1)5			
SHEET	8	OF	27	SHEETS