

TEMPORARY AND DURABLE 100mm YELLOW LINE

STA 0+800 TO 1+160 SOLID LT, DASHED LT
 STA 0+800 TO 1+160 SOLID RT, DASHED RT
 STA 0+871 DOUBLE SOLID LT
 STA 1+160 TO 1+200 DOUBLE SOLID LT
 (WITH CENTERLINE BREAKS FOR TOWN HIGHWAYS)

TEMPORARY AND DURABLE 100mm WHITE LINE

STA 0+800 TO 1+200 SOLID LT&RT
 STA 1+195 TO 1+200 SOLID RT
 (WITH EDGE LINE BREAKS FOR TOWN HIGHWAYS)

TEMPORARY AND DURABLE 600mm STOP BAR

STA 0+871LT QUARRY RD

CHANGING ELEVATION OF D.I.'S, C.B.'S OR M.H.'S
~~STA 0+810 RT~~
~~STA 0+820 LT~~
~~STA 0+874 RT~~
~~STA 0+880 LT~~
~~STA 0+995 RT~~
~~STA 1+001 LT~~
~~STA 1+102 LT&RT~~

CHANGING ELEVATION OF SEWER MANHOLE

STA 0+867 LT 1+020 RT
 1+100 RT

REMOVING SIGNS
 14

DURABLE LETTER OR SYMBOL

STA 0+856 C.L.
 STA 0+871LT
 STA 0+884 C.L.
 STA 0+990 C.L.
 STA 1+070 C.L.
 STA 1+160 C.L.
 STA 1+197 C.L.

"STOP"
 "ONLY"


TEMPORARY LETTER OR SYMBOL

STA 0+856 C.L.
 STA 0+871LT
 STA 0+884 C.L.
 STA 0+990 C.L.
 STA 1+070 C.L.
 STA 1+160 C.L.
 STA 1+197 C.L.

"STOP"
 "ONLY"

REHABILITATION OF D.I.C.B OR MH

0 + 818 RT 1 + 004 RT
 0 + 828 LT 1 + 012 LT
 0 + 882 RT 1 + 110 LT
 0 + 890 LT 1 + 110 RT

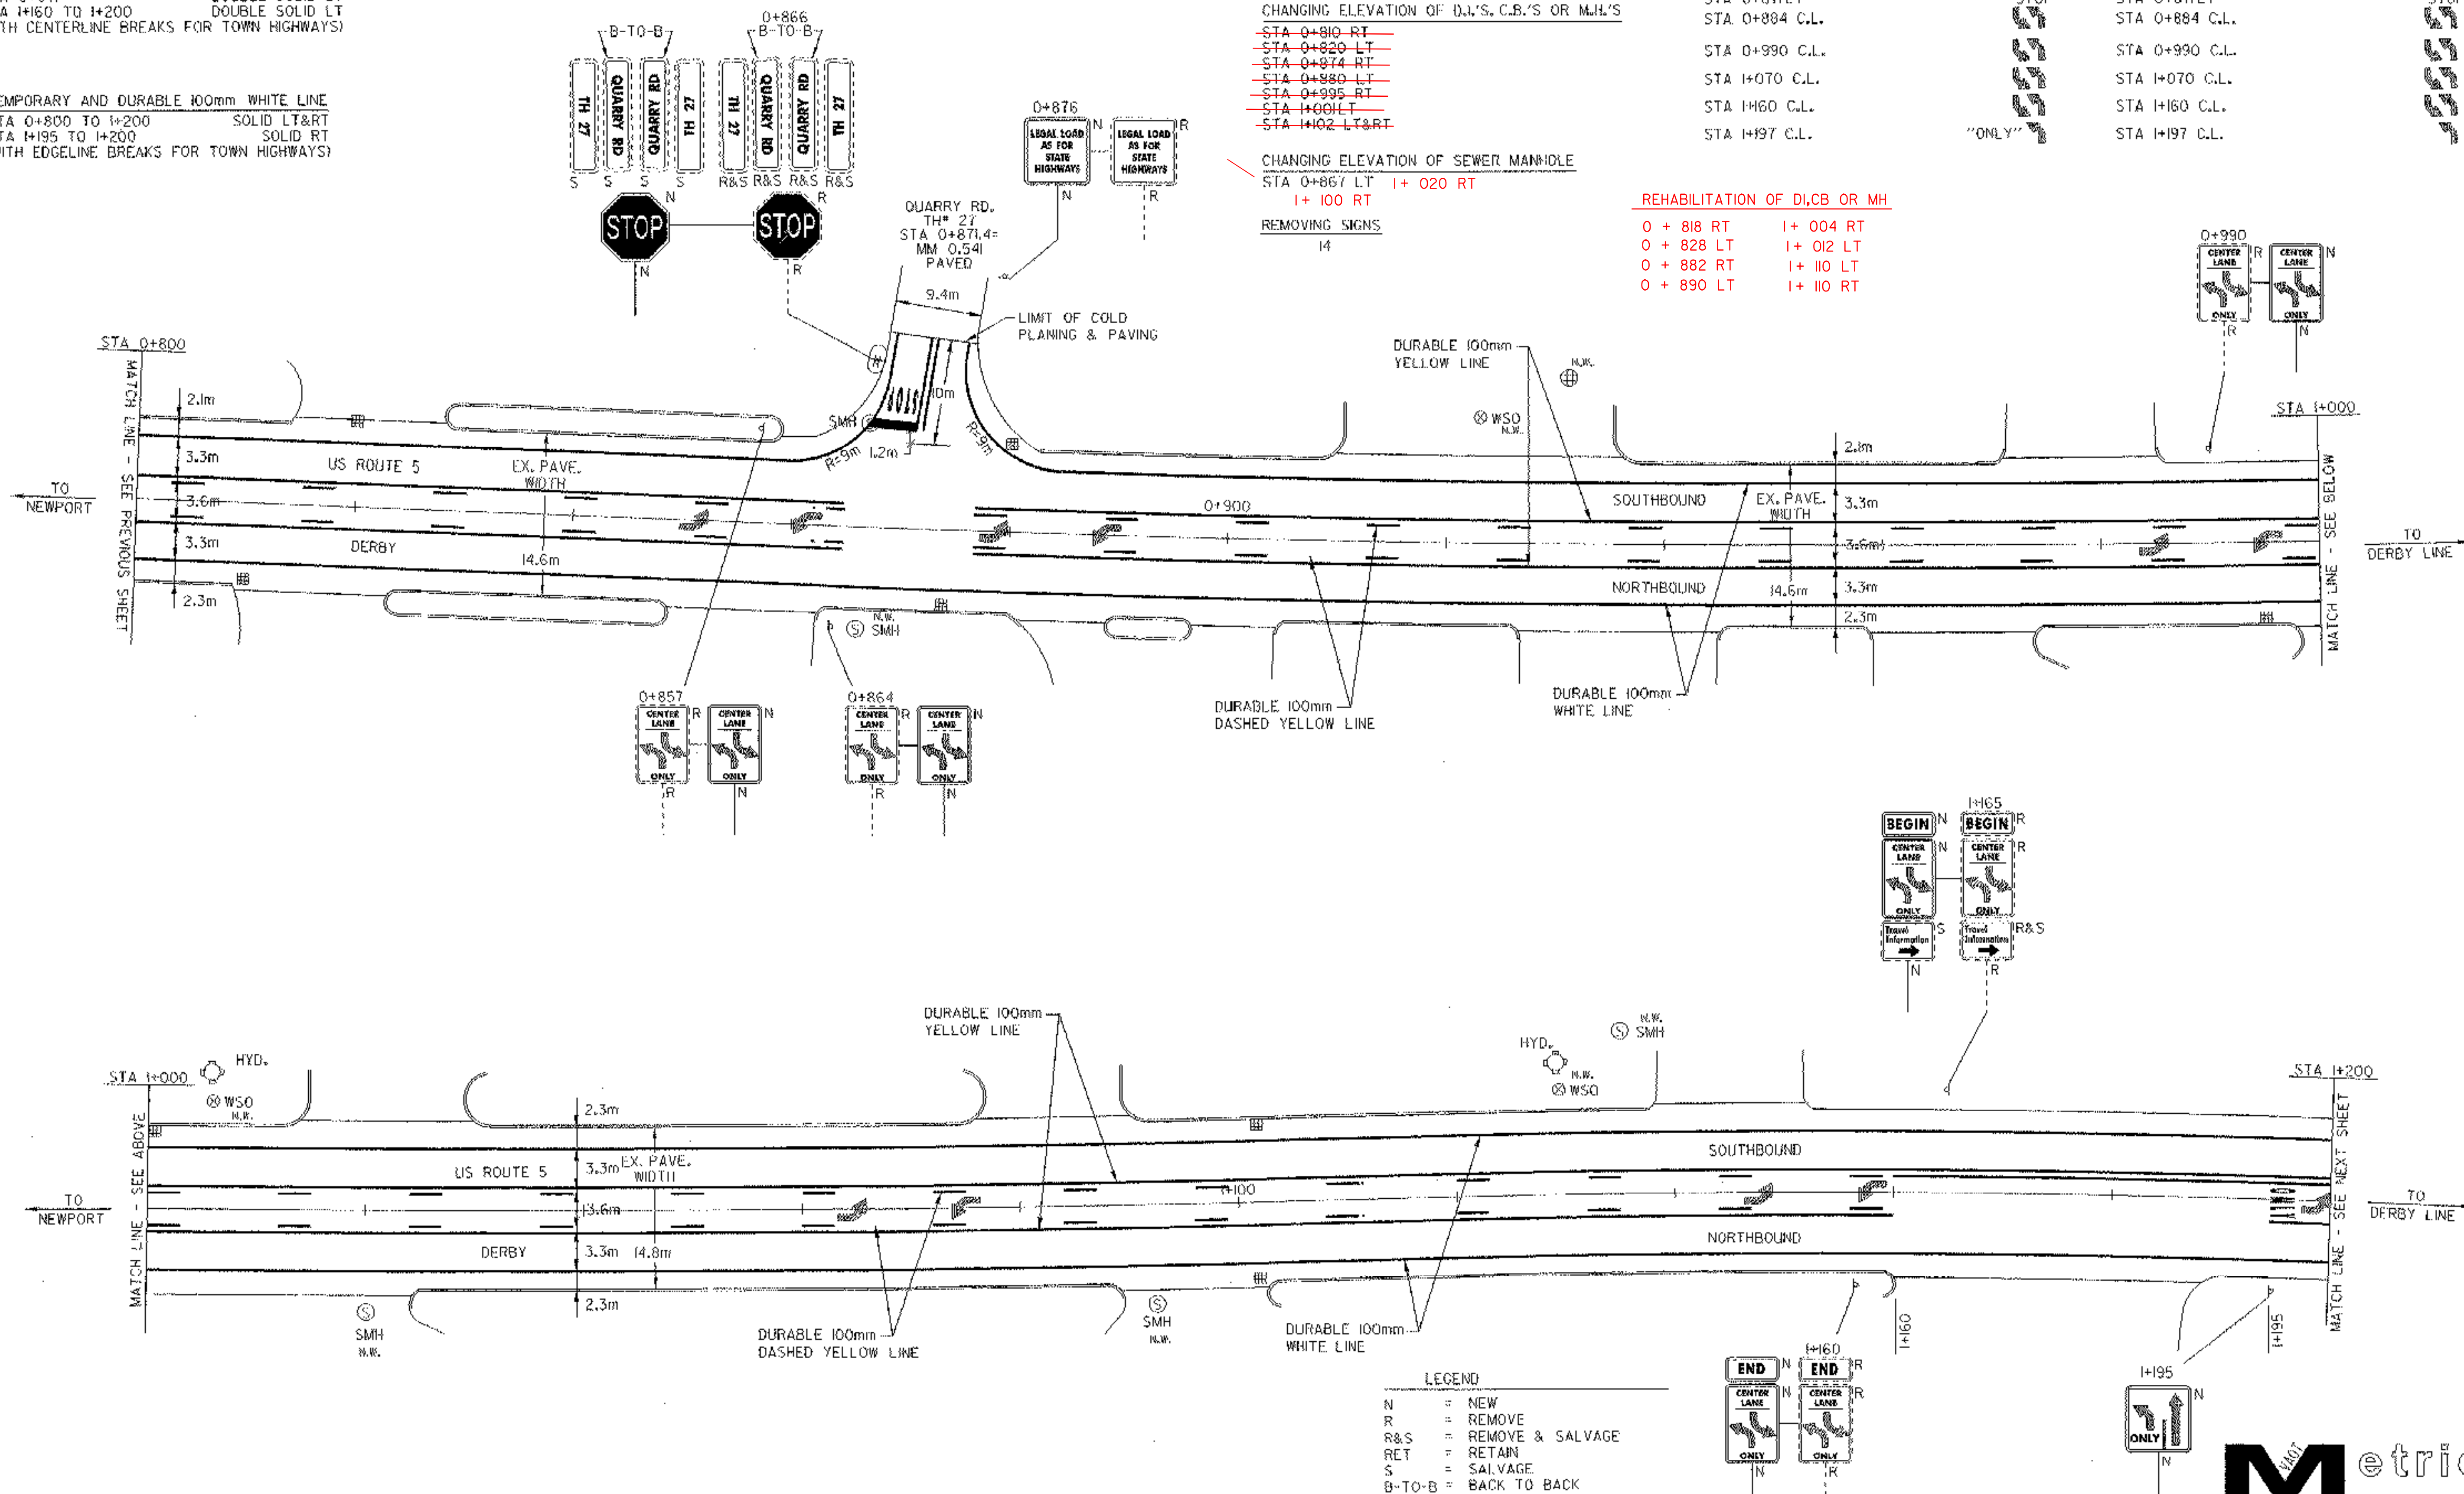

- LEGEND**
- N = NEW
 - R = REMOVE
 - R&S = REMOVE & SALVAGE
 - RET = RETAIN
 - S = SALVAGE
 - B-TO-B = BACK TO BACK
 - [Symbol] CATCH BASIN/DI/MANKHOLE
 - [Symbol] EXISTING CB/DI (NO WORK REQUIRED)
 - [Symbol] SEWER MANHOLE
 - [Symbol] MARKER POST
 - [Symbol] UTILITY POLE
 - [Symbol] UTIL. POLE W/UNDERGROUND UTIL.
 - [Symbol] VALVE/CURB STOP
 - [Symbol] DRIVE

ARCHIVED
ON CADD

PAVING
PROJECT
LAYOUT #3

DESIGNED BY	BCE/PJM	DATE	12-00
DRAWN BY	C.E.A., INC.	DATE	12-00
DESIGN FILE NO.	/pave/00c052/pc052a.dgn		
PRF FILE	pc052ap03.1	DATE PLOTTED	05-JUN-2003
PROJ. NAME	DERBY		
PROJ. NO.	STP 2224(1)S		
SHEET	9	OF	27 SHEETS

