

TEMPORARY AND DURABLE 100mm YELLOW LINE
 STA 2+400 TO 2+800 SOLID LT&RT
 STA 2+561 DOUBLE SOLID LT
 (WITH CENTERLINE BREAKS FOR TOWN HIGHWAYS)


TEMPORARY AND DURABLE 100mm WHITE LINE
 STA 2+400 TO 2+800 SOLID LT&RT
 (WITH EDGELINE BREAKS FOR TOWN HIGHWAYS)

REMOVING SIGNS
 3

~~CHANGING ELEVATION OF SEWER MANHOLE~~
~~STA 2+732 RT~~
 ADJUST ELEVATION OF VALVE BOX
 STA 2+733 LT

TEMPORARY AND DURABLE LETTER OR SYMBOL
 STA 2+561LT "STOP"

TEMPORARY AND DURABLE 600mm STOP BAR
 STA 2+561LT ROY ST

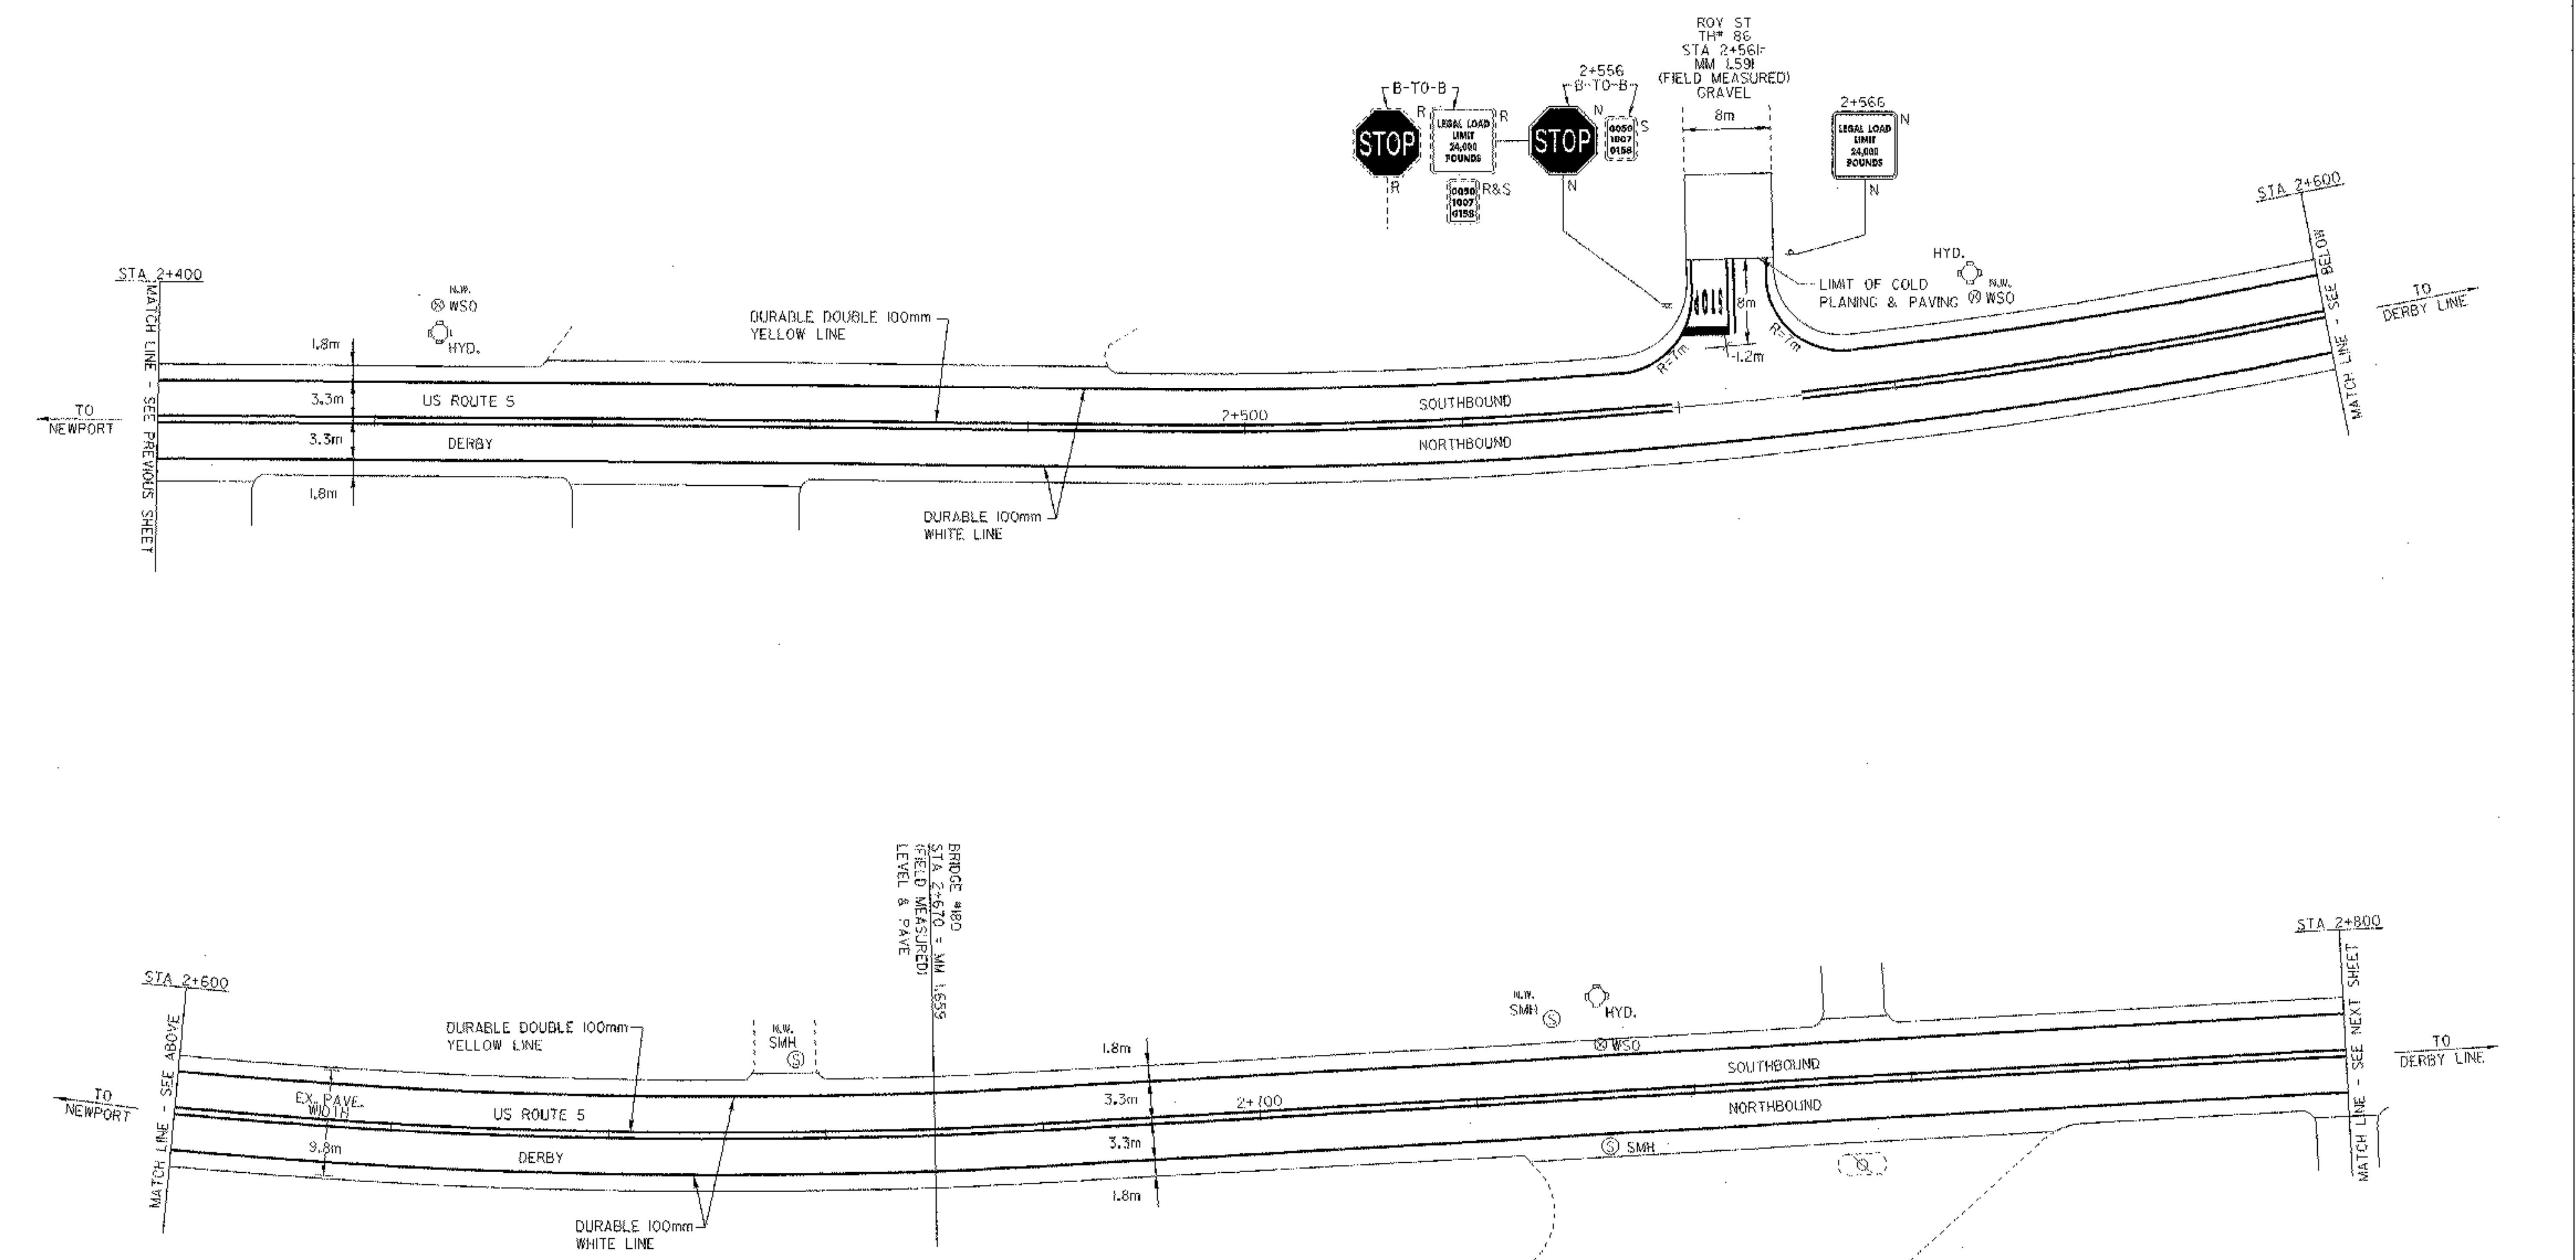

- LEGEND**
- N = NEW
 - R = REMOVE
 - R&S = REMOVE & SALVAGE
 - RET = RETAIN
 - S = SALVAGE
 - B-TQ-B = BACK TO BACK
 - ⊕ [] = CATCH BASIN/DI/MANHOLE
 - N.W. [] = EXISTING CB/DI (NO WORK REQUIRED)
 - ⊙ = SEWER MANHOLE
 - I = MARKER POST
 - ⊗ = UTILITY POLE
 - ⊗/⊗ = UTL. POLE W/UNDERGROUND UTIL.
 - ⊙ = VALVE/CURB STOP
 - ⊗ = DRIVE

**ARCHIVED
ON CADD**



PAVING PROJECT LAYOUT #7	DESIGNED BY	BCE/PJM	DATE	12-00
	DRAWN BY	C.E.A., INC.	DATE	12-00
	DESIGN FILE NO.	/pave/00c052/pc052a.dgn		
	PRF FILE	pc052ap07.1	DATE PLOTTED	05-JUN-2003
	PROJ. NAME	DERBY		
PROJ. NO.	STP 2224(1)S			
SHEET	13	OF	27	SHEETS