

TEMPORARY AND DURABLE 100mm YELLOW LINE
 STA 2+000 TO 3+190
 (WITH CENTERLINE BREAKS FOR TOWN HIGHWAYS)

TEMPORARY AND DURABLE 100mm WHITE LINE
 STA 2+800 TO 3+190
 (WITH EDGELINE BREAKS FOR TOWN HIGHWAYS)

REMOVING SIGNS
 5

BITUMINOUS CONCRETE GUTTER
 STA 3+165 TO 3+177 RT



CHANGING ELEVATION OF SEWER MANHOLE
~~STA 2+835 RT~~
~~STA 2+960 RT~~
~~STA 3+086 RT~~
~~STA 3+156 RT~~

TEMPORARY AND DURABLE LETTER OR SYMBOL
 STA 2+962 RT "STOP AHEAD"

REHABILITATION OF D.I.'S, C.B.'S OR M.H.'S
~~STA 2+837 RT~~
~~STA 3+065 RT~~ 2 + 829 RT

ADJUST ELEVATION OF VALVE BOX
 STA 3+048 LT

CHANGING ELEVATION OF D.I.'S, C.B.'S OR M.H.'S
~~STA 3+122 RT~~ 2 + 801LT 3 + 175 LT
~~STA 3+123 LT~~ 2 + 801RT
~~STA 3+167 RT~~ 3 + 058 RT
~~STA 3+178 LT~~ 3 + 120 RT
 3 + 121LT
 3 + 164 RT

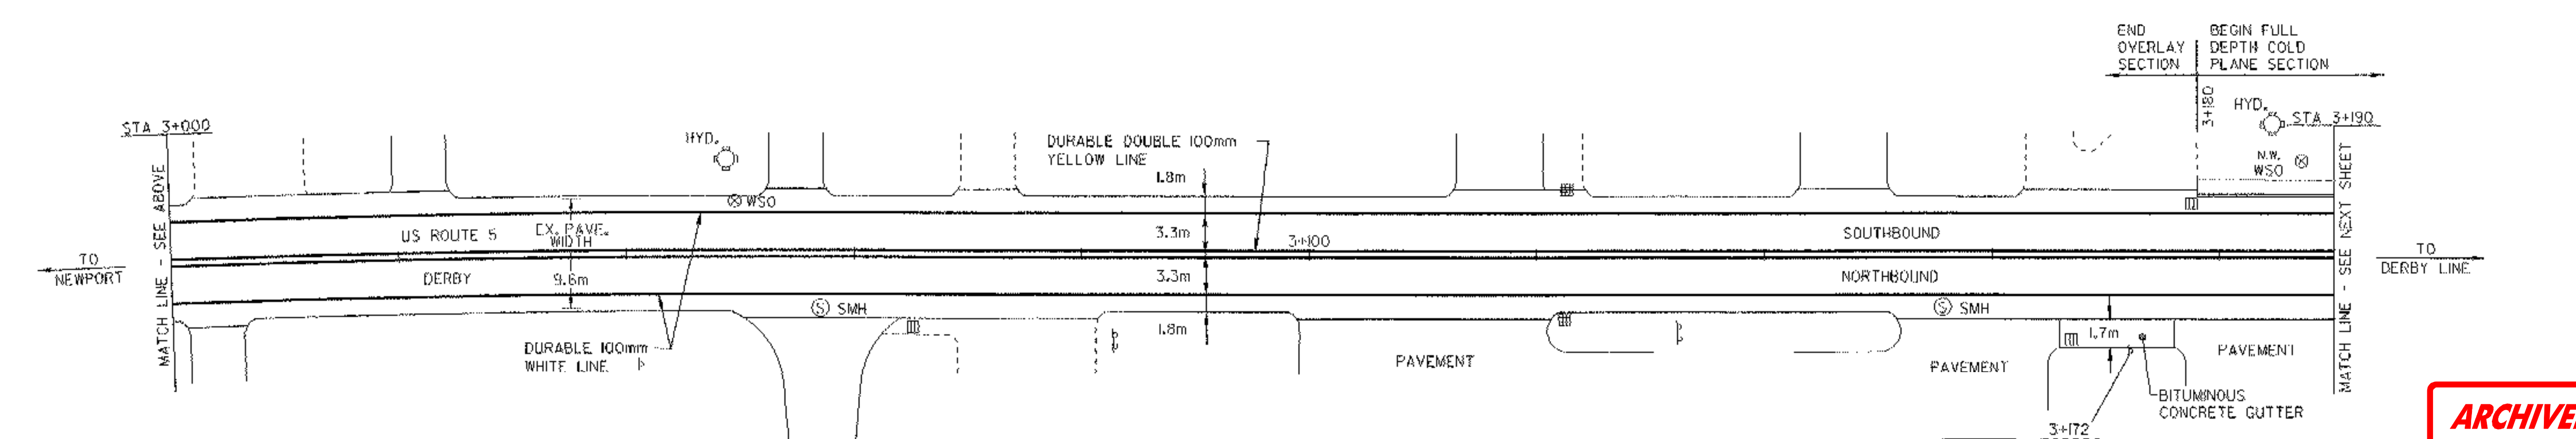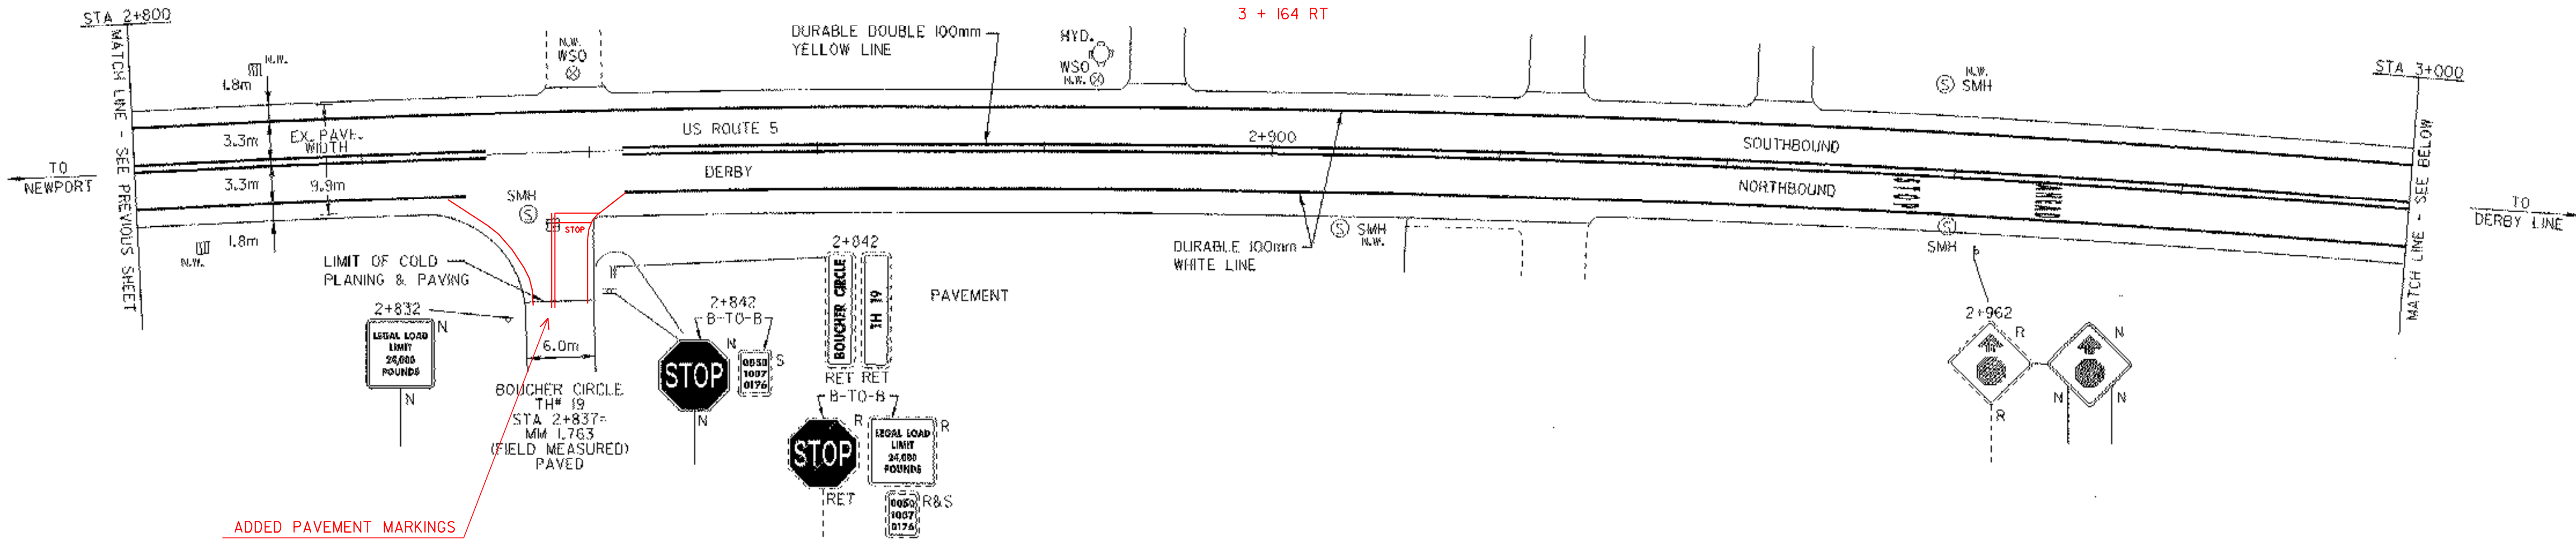

- LEGEND
- N = NEW
 - R = REMOVE
 - R&S = REMOVE & SALVAGE
 - RET = RETAIN
 - S = SALVAGE
 - B-TO-B = BACK TO BACK
 - ⊕ □ CATCH BASIN/DI/MANHOLE
 - N.W. □ EXISTING CB/DI (NO WORK REQUIRED)
 - ⊙ SEWER MANHOLE
 - I MARKER POST
 - ⊙ UTILITY POLE
 - U.E./T. □ UTIL. POLE W/UNDERGROUND UTIL.
 - ⊙ VALVE/CURB STOP
 - DRIVE

**ARCHIVED
ON CADD**



PAVING PROJECT LAYOUT #8

DESIGNED BY BCE/PJM DATE 12-00
 DRAWN BY C.E.A., INC. DATE 12-00
 DESIGN FILE NO. /pave/00c052/pc052a.dgn
 PRF FILE pc052op08.l DATE PLOTTED 05-JUN-2003
 PROJ. NAME DERBY
 PROJ. NO. STP 2224(1)5
 SHEET 14 OF 27 SHEETS