


TEMPORARY AND DURABLE 100mm YELLOW LINE	TEMPORARY AND DURABLE 100mm WHITE LINE	REMOVING SIGNS
STA 3+190 TO 3+600 SOLID LT&RT	STA 3+190 TO 3+600 SOLID LT&RT	4
STA 3+234 DOUBLE SOLID RT	STA 3+209 TO 3+323 DOTTED RT	
STA 3+515 DOUBLE SOLID LT	(WITH EDGELINE BREAKS FOR TOWN HIGHWAYS)	
DURABLE LETTER OR SYMBOL	TEMPORARY AND DURABLE 600mm STOP BAR	CHANGING ELEVATION OF SEWER MANHOLE
STA 3+223 RT 2 - "ONLY"	STA 3+240 RT US ROUTE 5	STA 3+238 RT
STA 3+240 RT 2 - "STOP"	STA 3+515 LT PALIN FARM RD	<del>STA 3+333 LT</del>
STA 3+515 LT "STOP"		<del>STA 3+404 LT</del>
TEMPORARY LETTER OR SYMBOL	TEMPORARY AND DURABLE 200mm WHITE LINE	REHABILITATION OF D.I.'s, C.B.'s OR M.H.'s
STA 3+223 RT 2 - "	STA 3+223 TO 3+240 SOLID RT	<del>STA 3+308 RT</del>
STA 3+240 RT 2 - "STOP"		ADJUST ELEVATION OF VALVE BOX
STA 3+515 LT "STOP"		STA 3+255 RT
		STA 3+295 LT

CHANGING ELEVATION OF D.I./CB OR MH's  
 3 + 308 RT  
 3 + 331RT

NOTE! INSTALLED NEW GRANITE (SLOPED) ISLAND (5' x 10')  
 PLACED NEW STOP SIGN IN NEW ISLAND

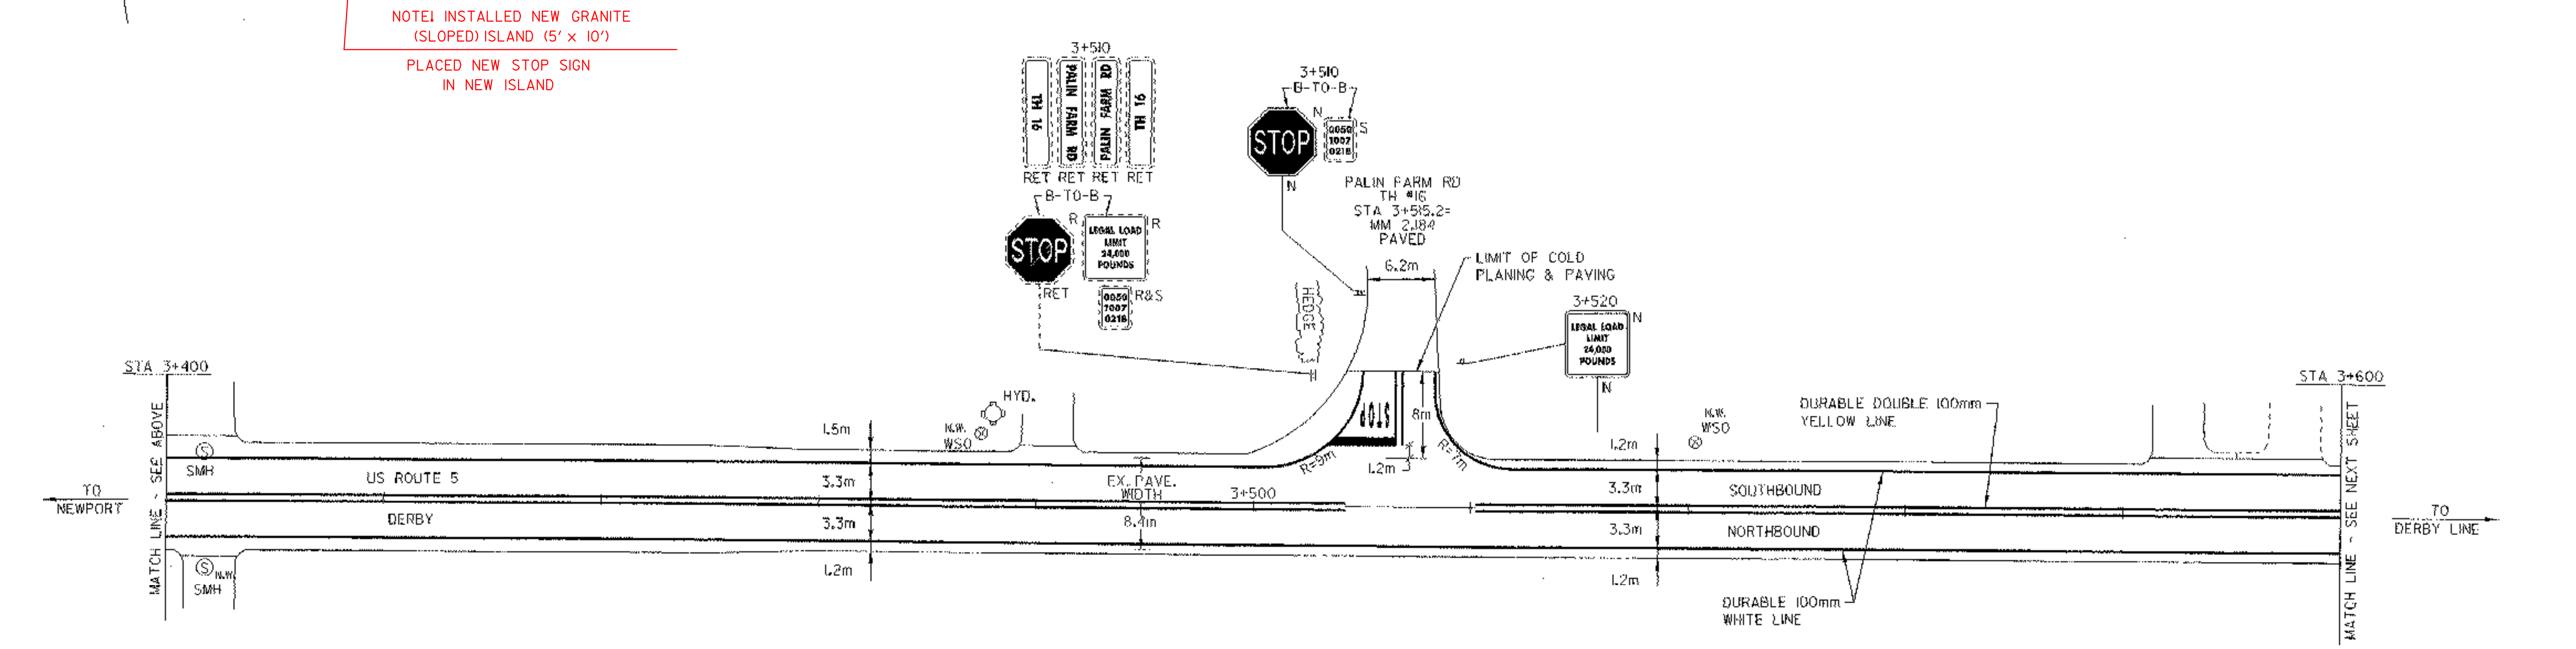

LEGEND

N	= NEW
R	= REMOVE
R&S	= REMOVE & SALVAGE
RET	= RETAIN
S	= SALVAGE
B-T-O-B	= BACK TO BACK
⊕	CATCH BASIN/DI/MANHOLE
N.W. ⊕	EXISTING CB/DI (NO WORK REQUIRED)
⊙	SEWER MANHOLE
I	MARKER POST
⊙	UTILITY POLE
⊙/⊙	UTIL. POLE W/UNDERGROUND UTIL.
⊙	VALVE/CURB STOP
⊙	DRIVE

**ARCHIVED ON CADD**



<b>PAVING PROJECT LAYOUT #9</b>	DESIGNED BY <u>BCE/PJM</u> DATE <u>12-00</u>
	DRAWN BY <u>C.E.A., INC.</u> DATE <u>12-00</u>
	DESIGN FILE NO. <u>./pave/00c052/pc052a.dgn</u>
	PRF FILE <u>pc052ap09.1</u> DATE PLOTTED <u>08-JUN-2003</u>
	PROJ. NAME <b>DERBY</b>
PROJ. NO. <b>STP 2224(1)S</b>	
SHEET <b>15</b> OF <b>27</b> SHEETS	