

TEMPORARY AND DURABLE 100mm YELLOW LINE
 STA 5+400 TO 5+681 SOLID LT & RT
 STA 5+681 TO 5+906 SOLID LT & DASHED RT
 STA 5+906 TO 5+922 SOLID LT & RT
 STA 5+922 TO 6+415 DASHED LT & SOLID RT
 STA 6+415 TO 6+800 SOLID LT & RT



TEMPORARY AND DURABLE 100mm WHITE LINE
 STA 5+400 TO 6+800 SOLID LT & RT

BITUMINOUS CONCRETE CUTTER
 STA 6+645 TO 6+800 RT
 YIELDING MARKER POST
 STA 5+426 RT

REMOVAL AND DISPOSAL OF GUARD RAIL
 STA 5+491 TO 5+669 LT
 STA 5+639 TO 5+878 RT
 STA 5+734 TO 5+815 LT
 STA 5+995 TO 6+081 LT

STEEL BEAM GUARD RAIL W/2.4m POSTS (MOD.)
 STA 5+502 TO 5+658 LT
 STA 5+650 TO 5+867 RT
 STA 5+732 TO 5+743 LT
 STA 6+006 TO 6+070 LT

MANUFACTURED TERMINAL SECTION
 STA 5+491 TO 5+602 LT (FLARED)
 STA 5+658 TO 5+669 LT (FLARED)
 STA 5+639 TO 5+650 RT (FLARED)
 STA 5+867 TO 5+878 RT (FLARED)
 STA 5+732 TO 5+743 LT (FLARED)
 STA 5+804 TO 5+815 LT (FLARED)
 STA 5+995 TO 6+006 LT (FLARED)
 STA 6+070 TO 6+081 LT (FLARED)

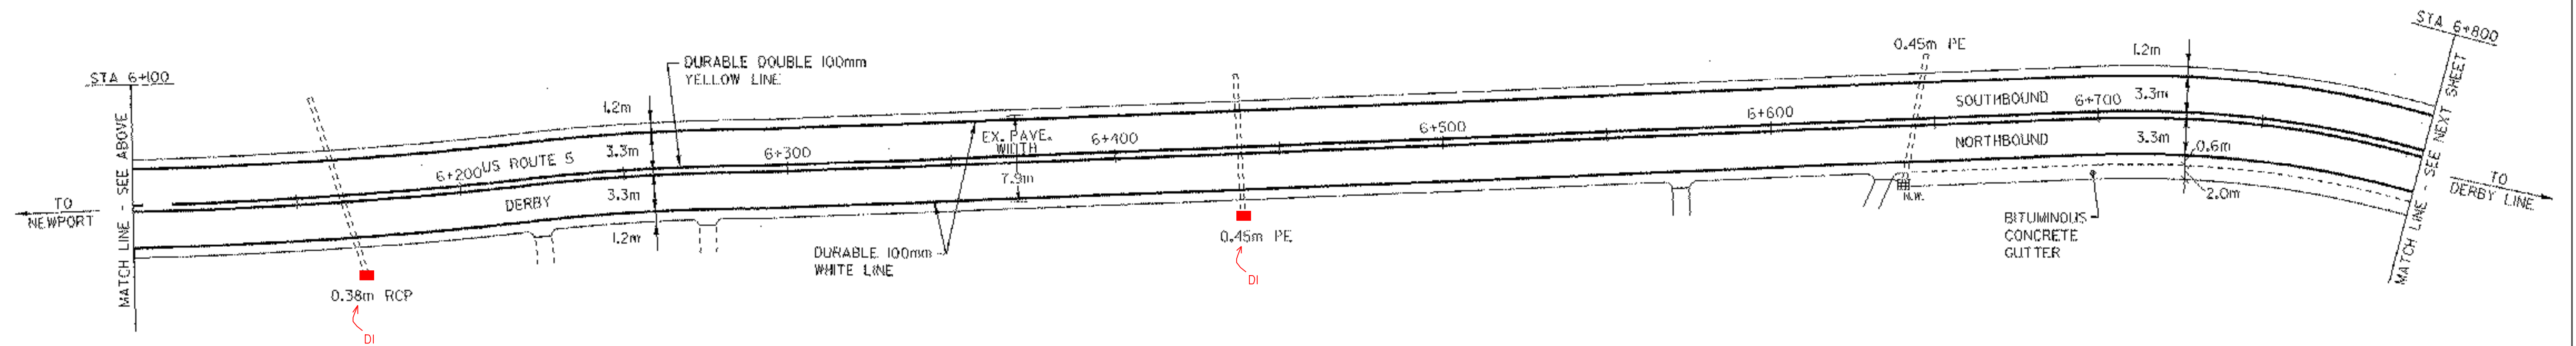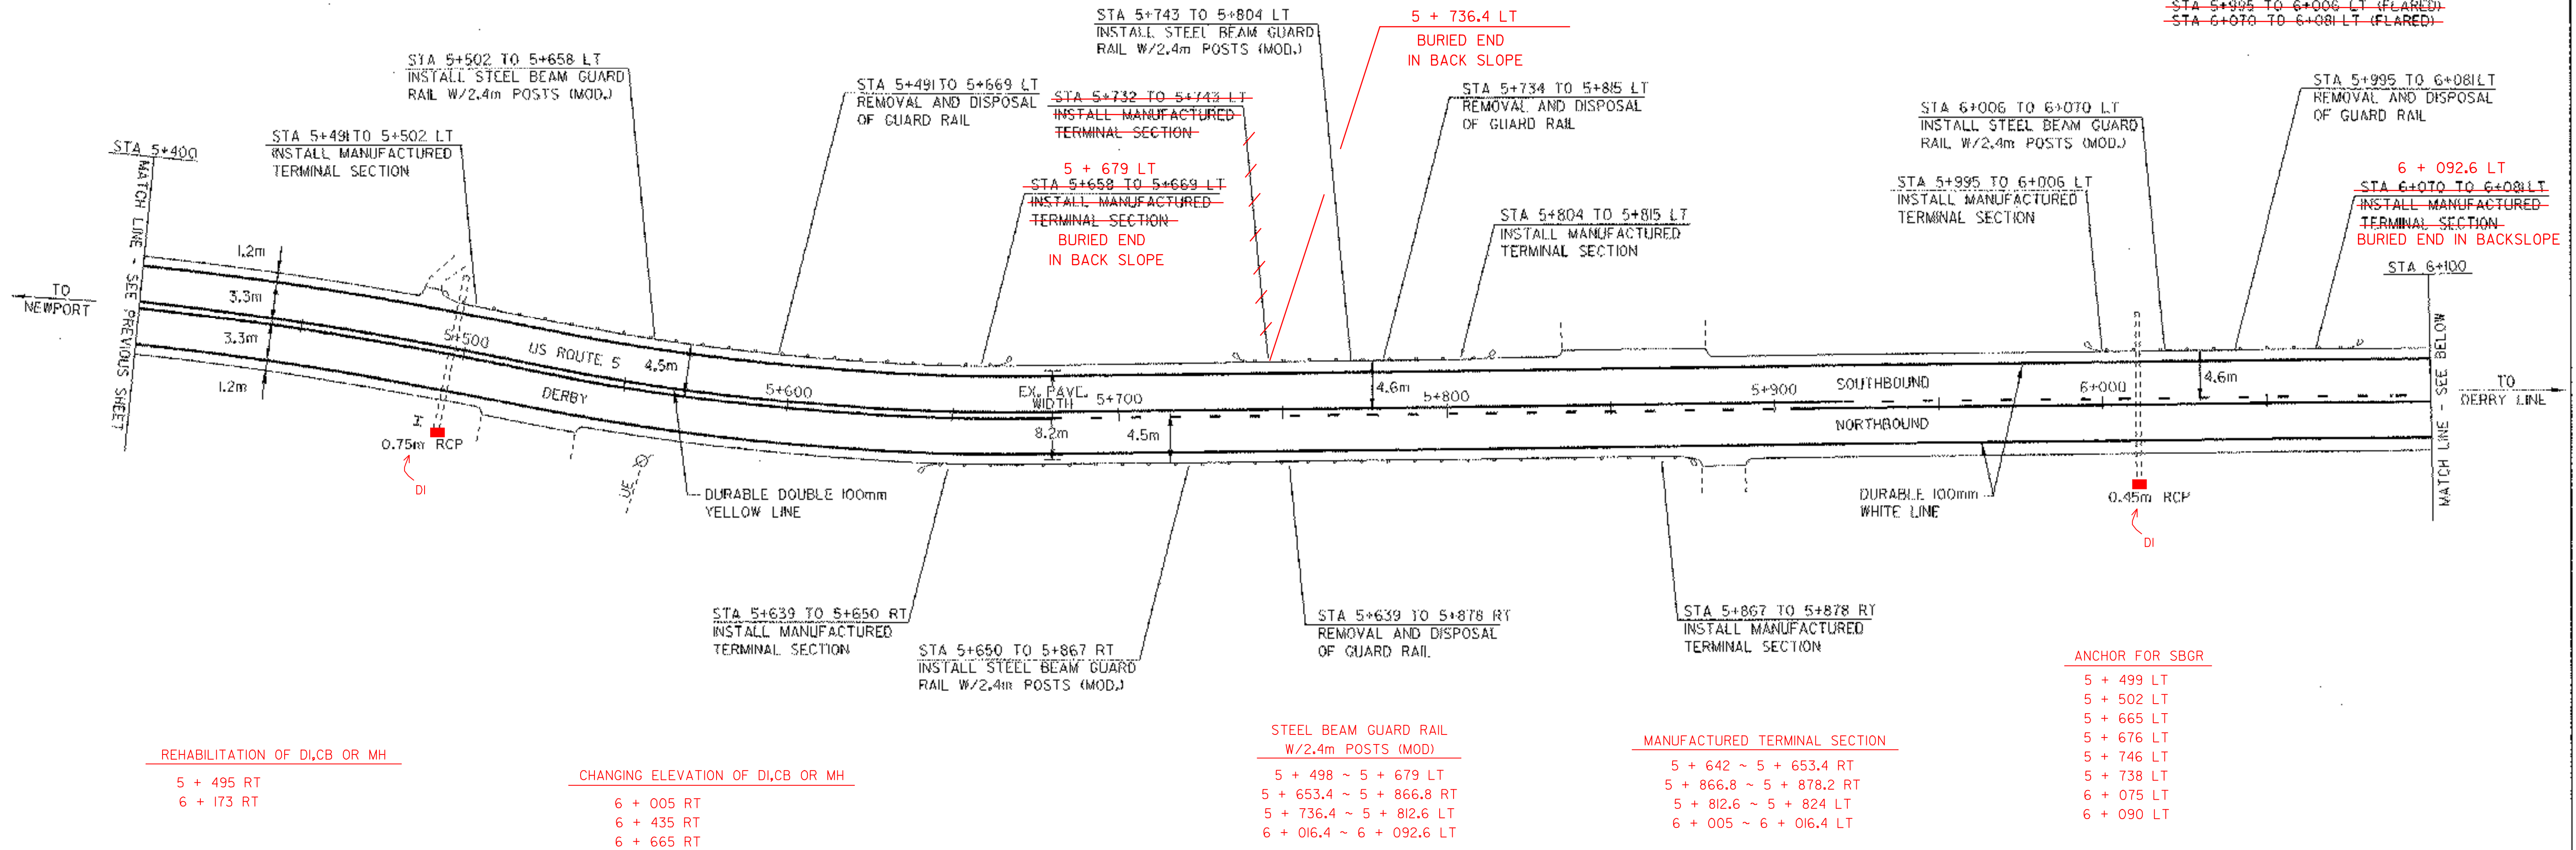

- LEGEND
- N = NEW
 - R = REMOVE
 - R&S = REMOVE & SALVAGE
 - RET = RETAIN
 - S = SALVAGE
 - B-T-O-B = BACK TO BACK
 - ☐ = CATCH BASIN/DI/MANHOLE
 - n.w. ☐ = EXISTING CB/DI (NO WORK REQUIRED)
 - ⊙ = SEWER MANHOLE
 - I = MARKER POST
 - ⊙ = UTILITY POLE
 - ⊙ = UTIL. POLE W/UNDERGROUND UTIL.
 - ⊙ = VALVE/CURB STOP
 - = DRIVE

ARCHIVED ON CADD



PAVING PROJECT LAYOUT #12

DESIGNED BY BCE/PJM DATE 12-00
 DRAWN BY C.E.A., INC. DATE 12-00
 DESIGN FILE NO. /pave/00c052/pc052a.dgn
 PRF FILE pc052apl2.i DATE PLOTTED 05-JUN-2003

PROJ. NAME **DERBY**
 PROJ. NO. **STP 2224(1)S**
 SHEET **18** OF **27** SHEETS