
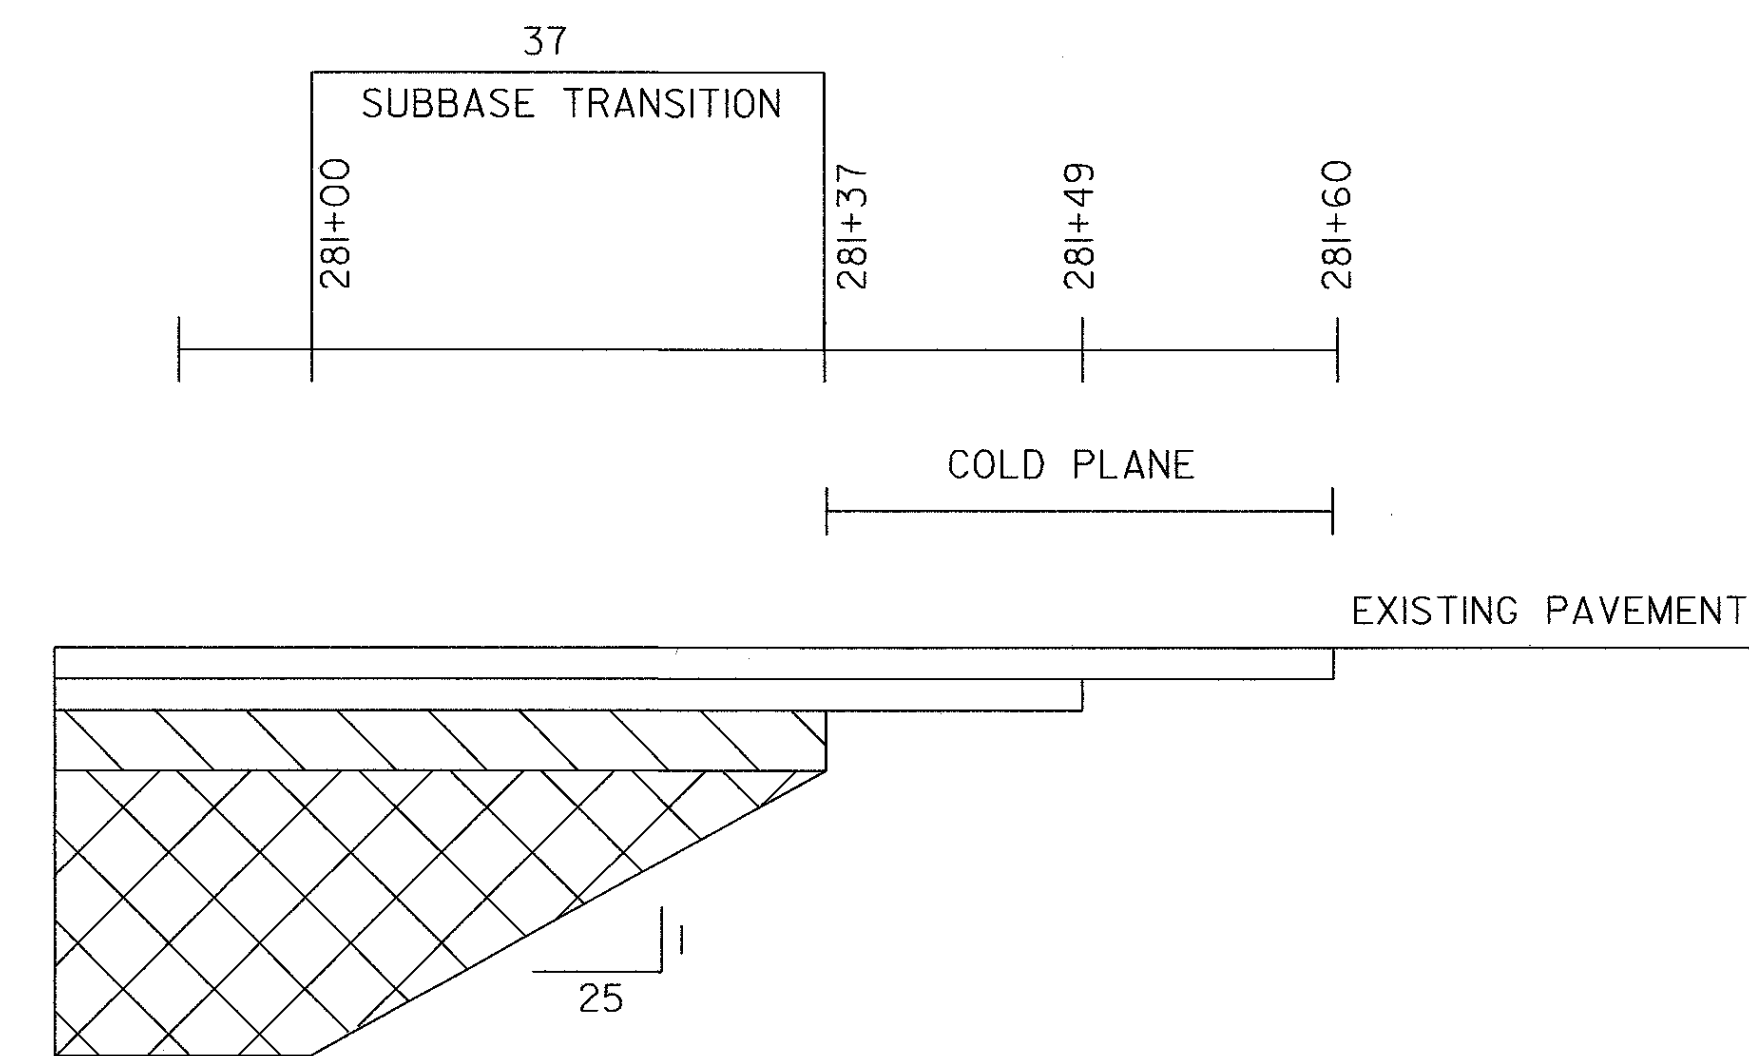


# MATERIAL TRANSITION DIAGRAM

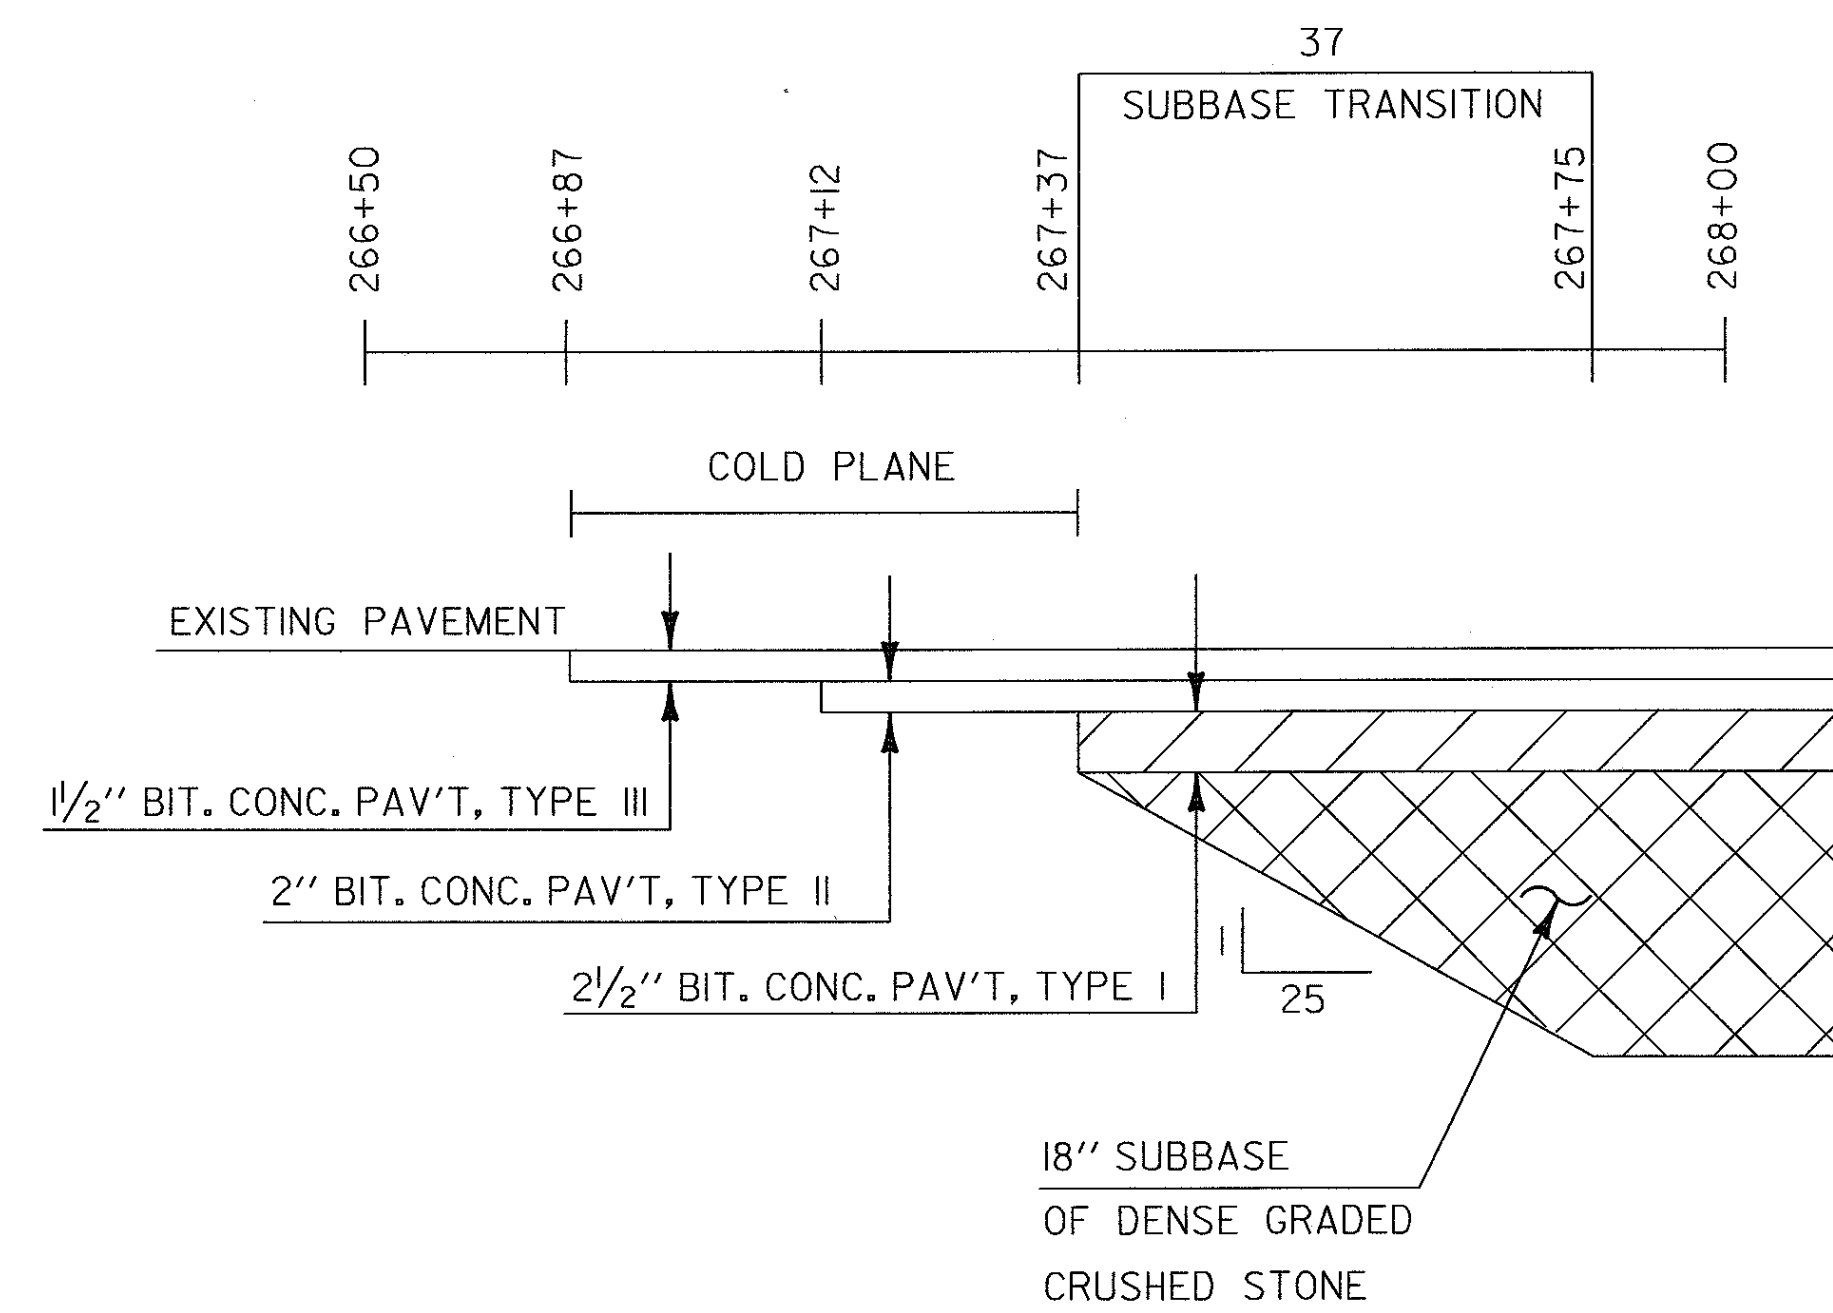

NOT TO SCALE

<b>DATUM</b>	
VERTICAL	_____
HORIZONTAL	_____

PROJECT NAME: SUDBURY	PLOT DATE: 19-DEC-2001
PROJECT NUMBER: ST 0161(10)	DRAWN BY: R. Kehne
FILE NAME: /sqda/00c62/dc062frm.dgn	CHECKED BY:
PROJECT LEADER: Kreis	SHEET 22 OF 34
DESIGNED BY:	
dc062mtd.l	