


DATUM
 VERTICAL NAVD88
 HORIZONTAL NAD83 (92)

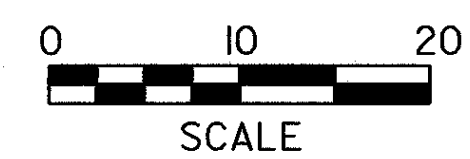

PROJECT NAME: SUDBURY
 PROJECT NUMBER: ST 0161(10)
 FILE NAME: /sqda/00c062/dc062xsl.dgn
 PROJECT LEADER: BOMBARDIER
 DESIGNED BY: MEUNIER
 dc062x02.1
 PLOT DATE: 19-DEC-2001
 DRAWN BY: MEUNIER
 CHECKED BY:
 SHEET 29 OF 34