


DATUM	
VERTICAL	NAVD88
HORIZONTAL	NAD83 (92)

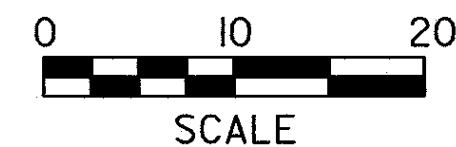

PROJECT NAME: SUDBURY	
PROJECT NUMBER: ST 0161(10)	
FILE NAME: /sqda/00c062/dc062xsl.dgn	PLOT DATE: 19-DEC-2001
PROJECT LEADER: BOMBARDIER	DRAWN BY: MEUNIER
DESIGNED BY: MEUNIER	CHECKED BY:
dc062x04.1	SHEET 31 OF 34